


CITY OF SUPERIOR SEWER PLAN

HORIZONTAL SCALE 1" = 60'
 VERTICAL SCALE 1" = 6'
 JOB STARTED JAN. 1938
 JOB COMPLETED MAR. 1938
 W.P.A. LABOR
 H.DANN INSPECTOR
 T.M.BASTERASH CITY ENGINEER

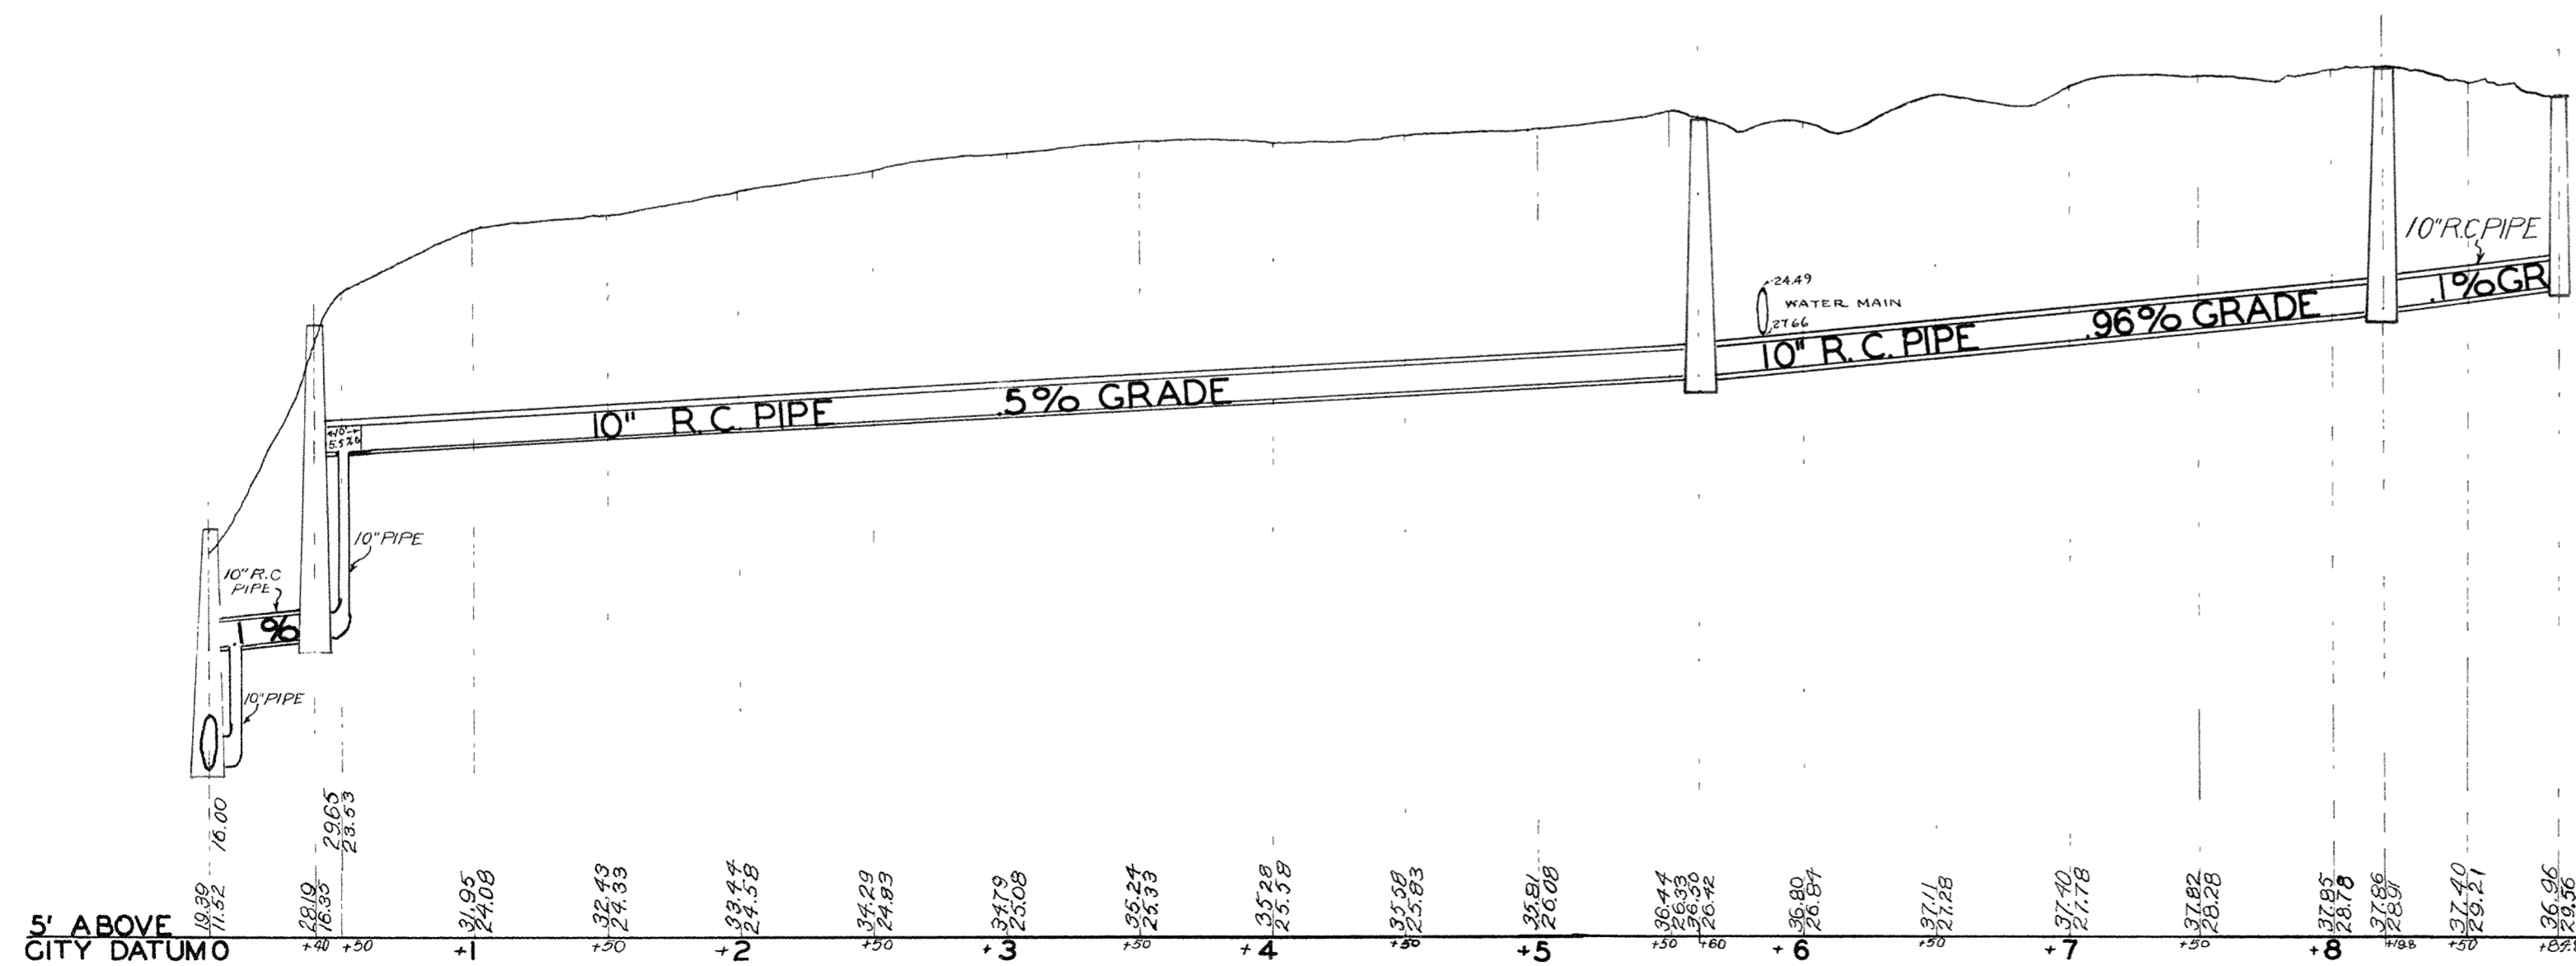

3A-33