




CITY OF SUPERIOR

SEWER PLAN


Contract let June 1, 1892  
 completed Aug 15, 1892  
 Anderson & Kennedy, Contractor  
 Jos. P. Duff, Inspector  
 A. S. Cooper, City Engineer.

1893


Scale: { Horizontal 1" = 60'  
 Vertical 1" = 4'  
 Section 1" = 2'

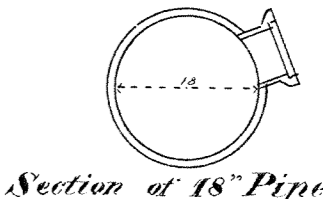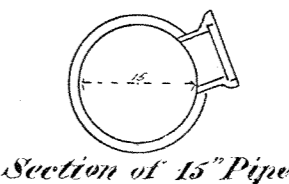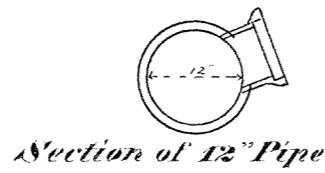

Base line 10' above datum

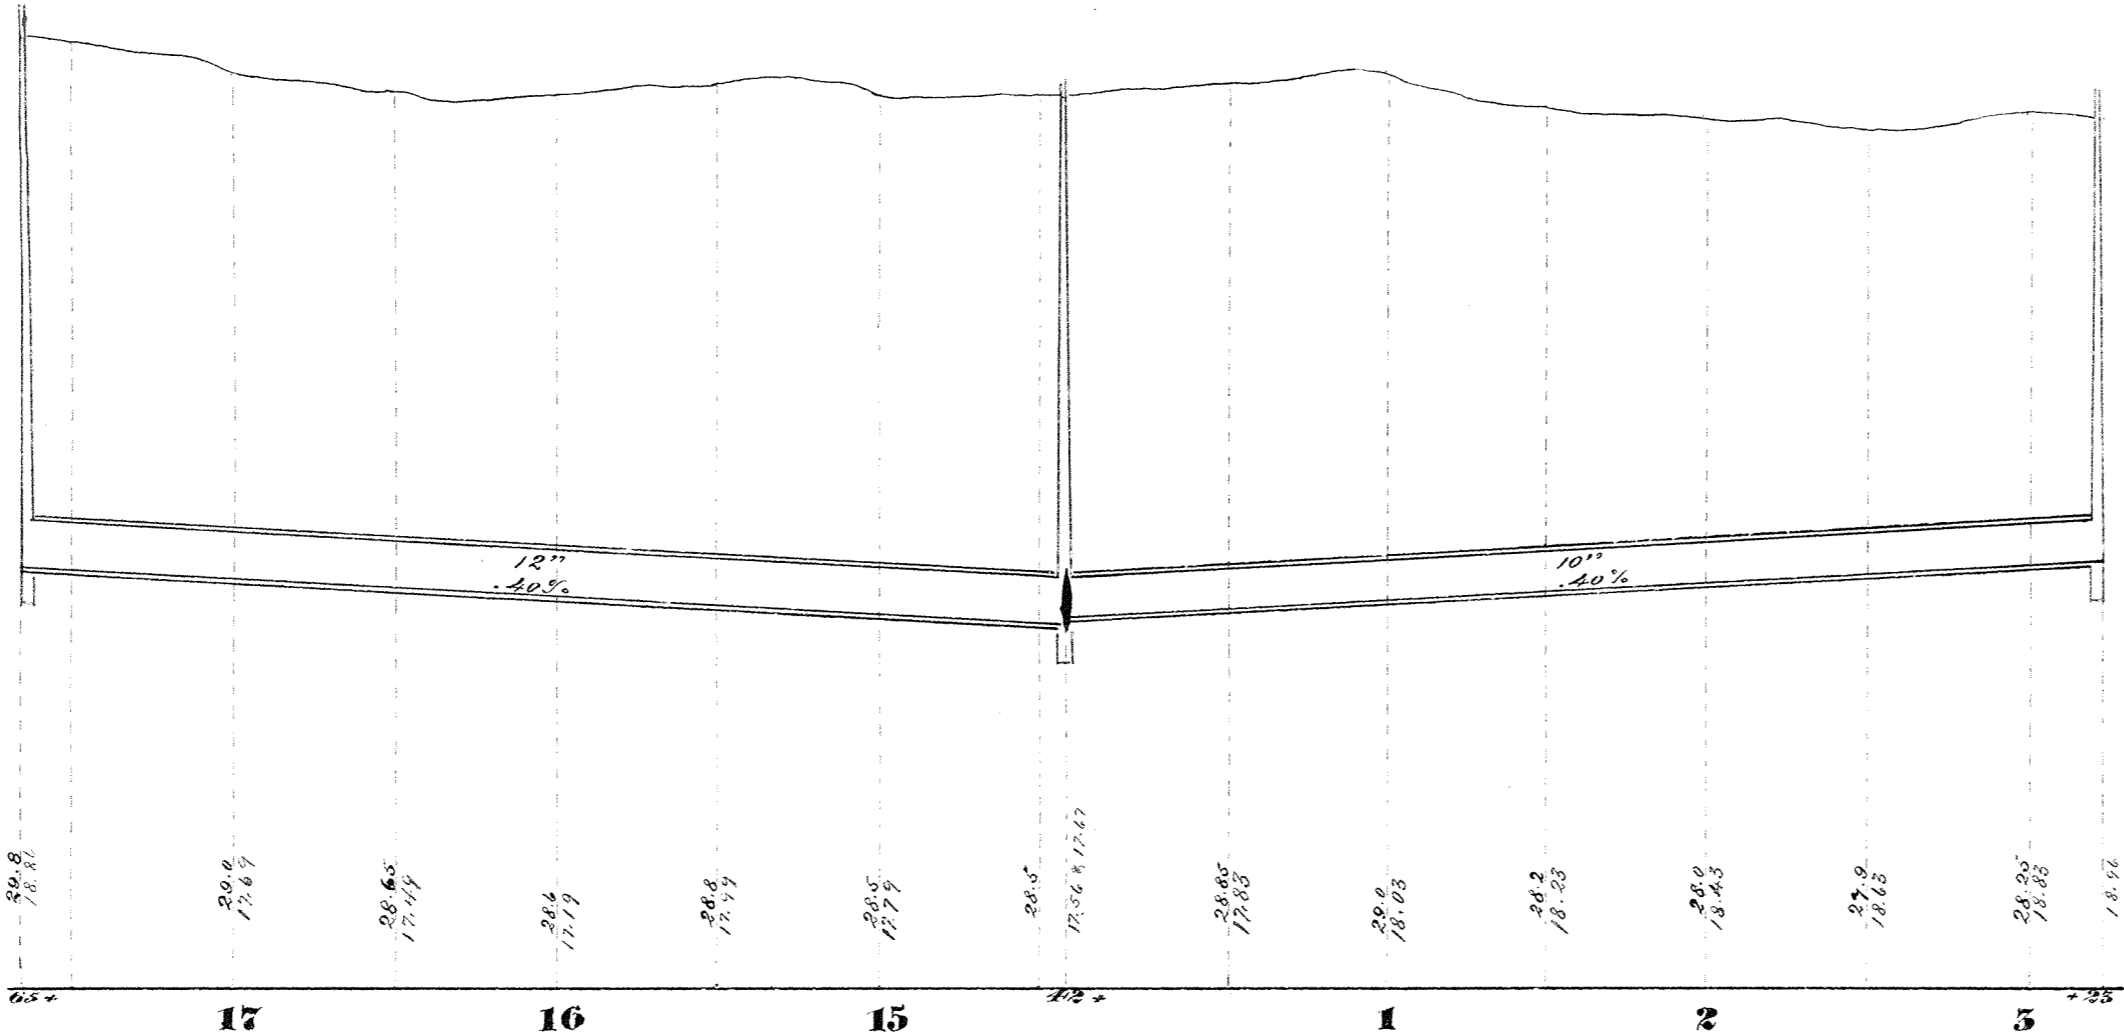

Plan of Profile of Sewer in Alley betw. W. Seventh & Eighth Sts. from I to G St.

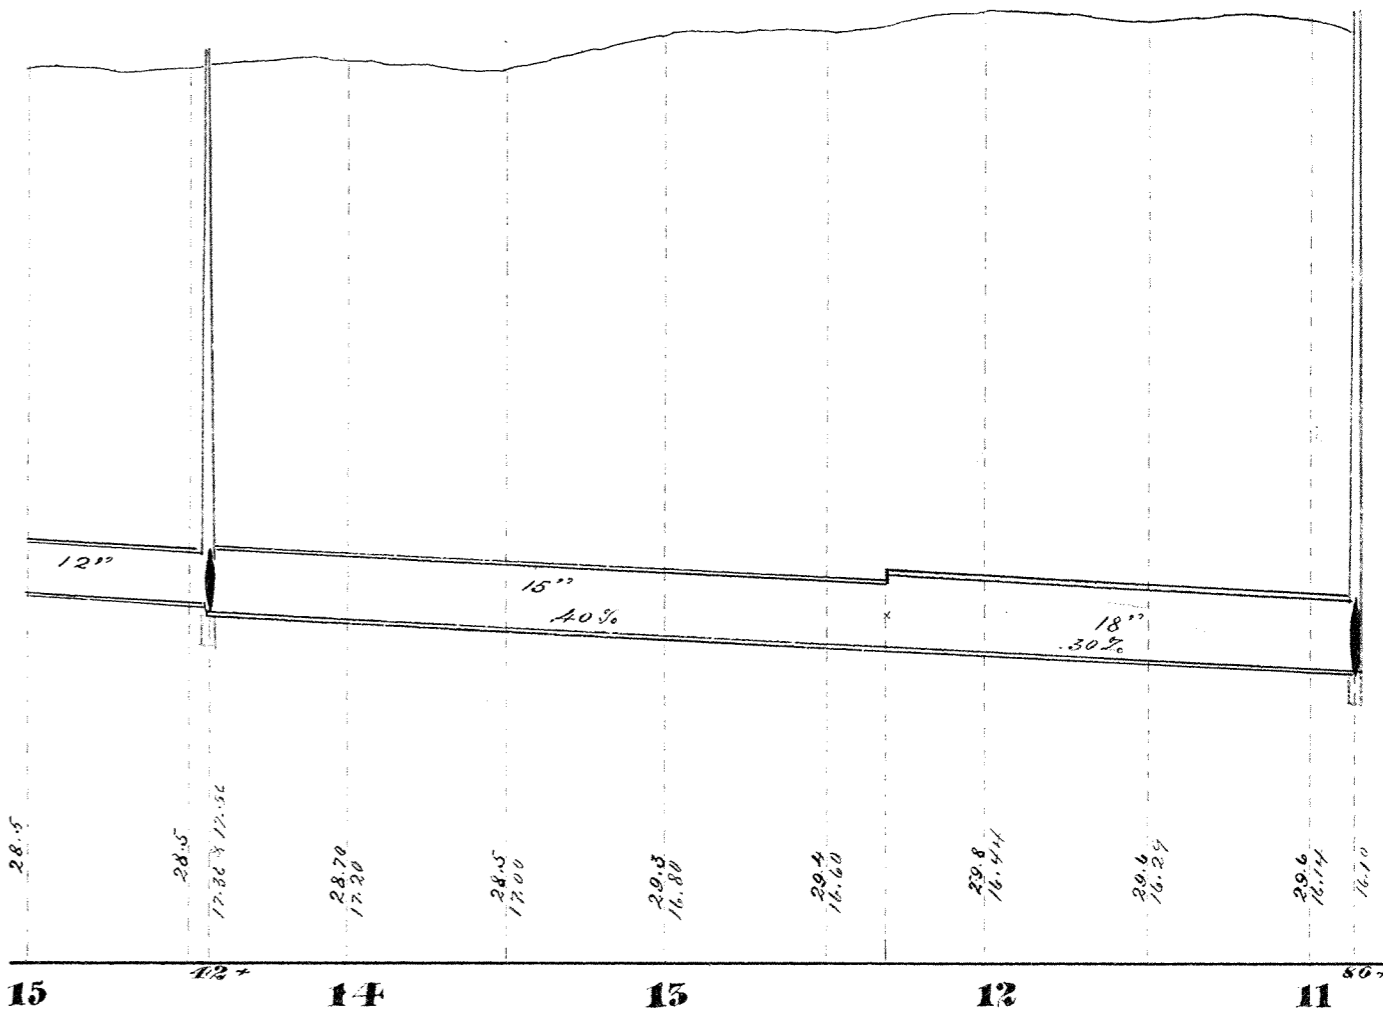

Profile of Sewer in H St. from Alley so. Eighth st. to Alley no. 3A-4