


**CITY OF SUPERIOR
SEWER PLAN**

Contract let June 1, 1892
 Completed Aug. 15, 1892
 Anderson & Kennedy, Contractor
 Jos. P. Duff, Inspector
 A. S. Cooper City Engineer


1893

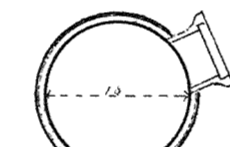

Section of 18" Pipe




Section of 21" Pipe

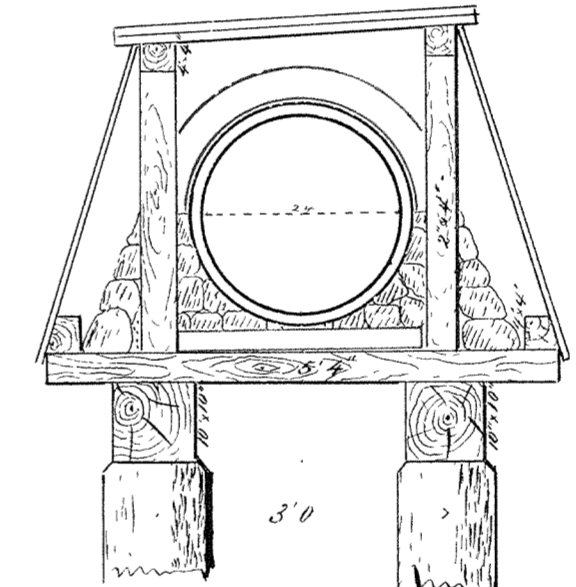

Section of 21" Pipe on Piles

Scale: { Horizontal 1" = 60'
 Vertical 1" = 4'
 Section 1" = 2'

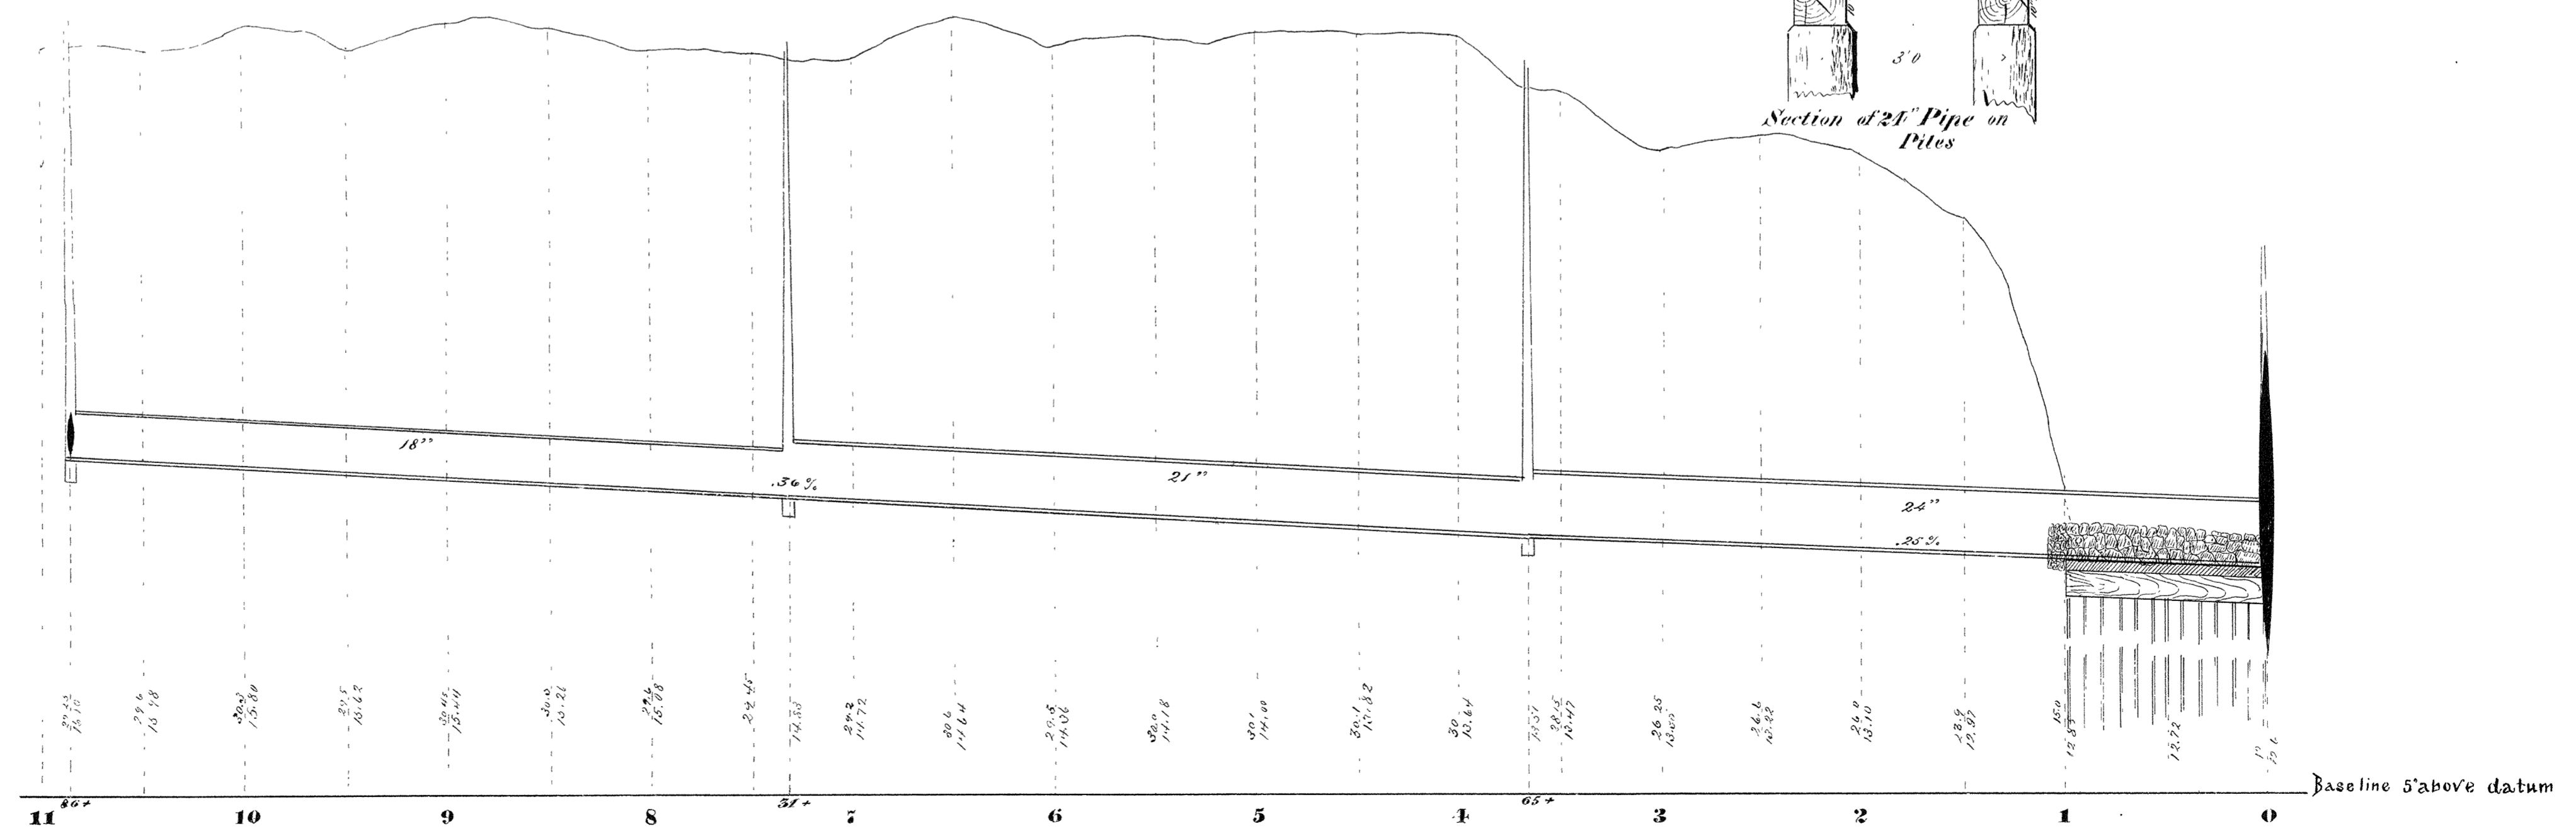

Plan & Profile of Sewer in Alley betw. W. Eighth & Ninth St. from K to H St.

3A-5