
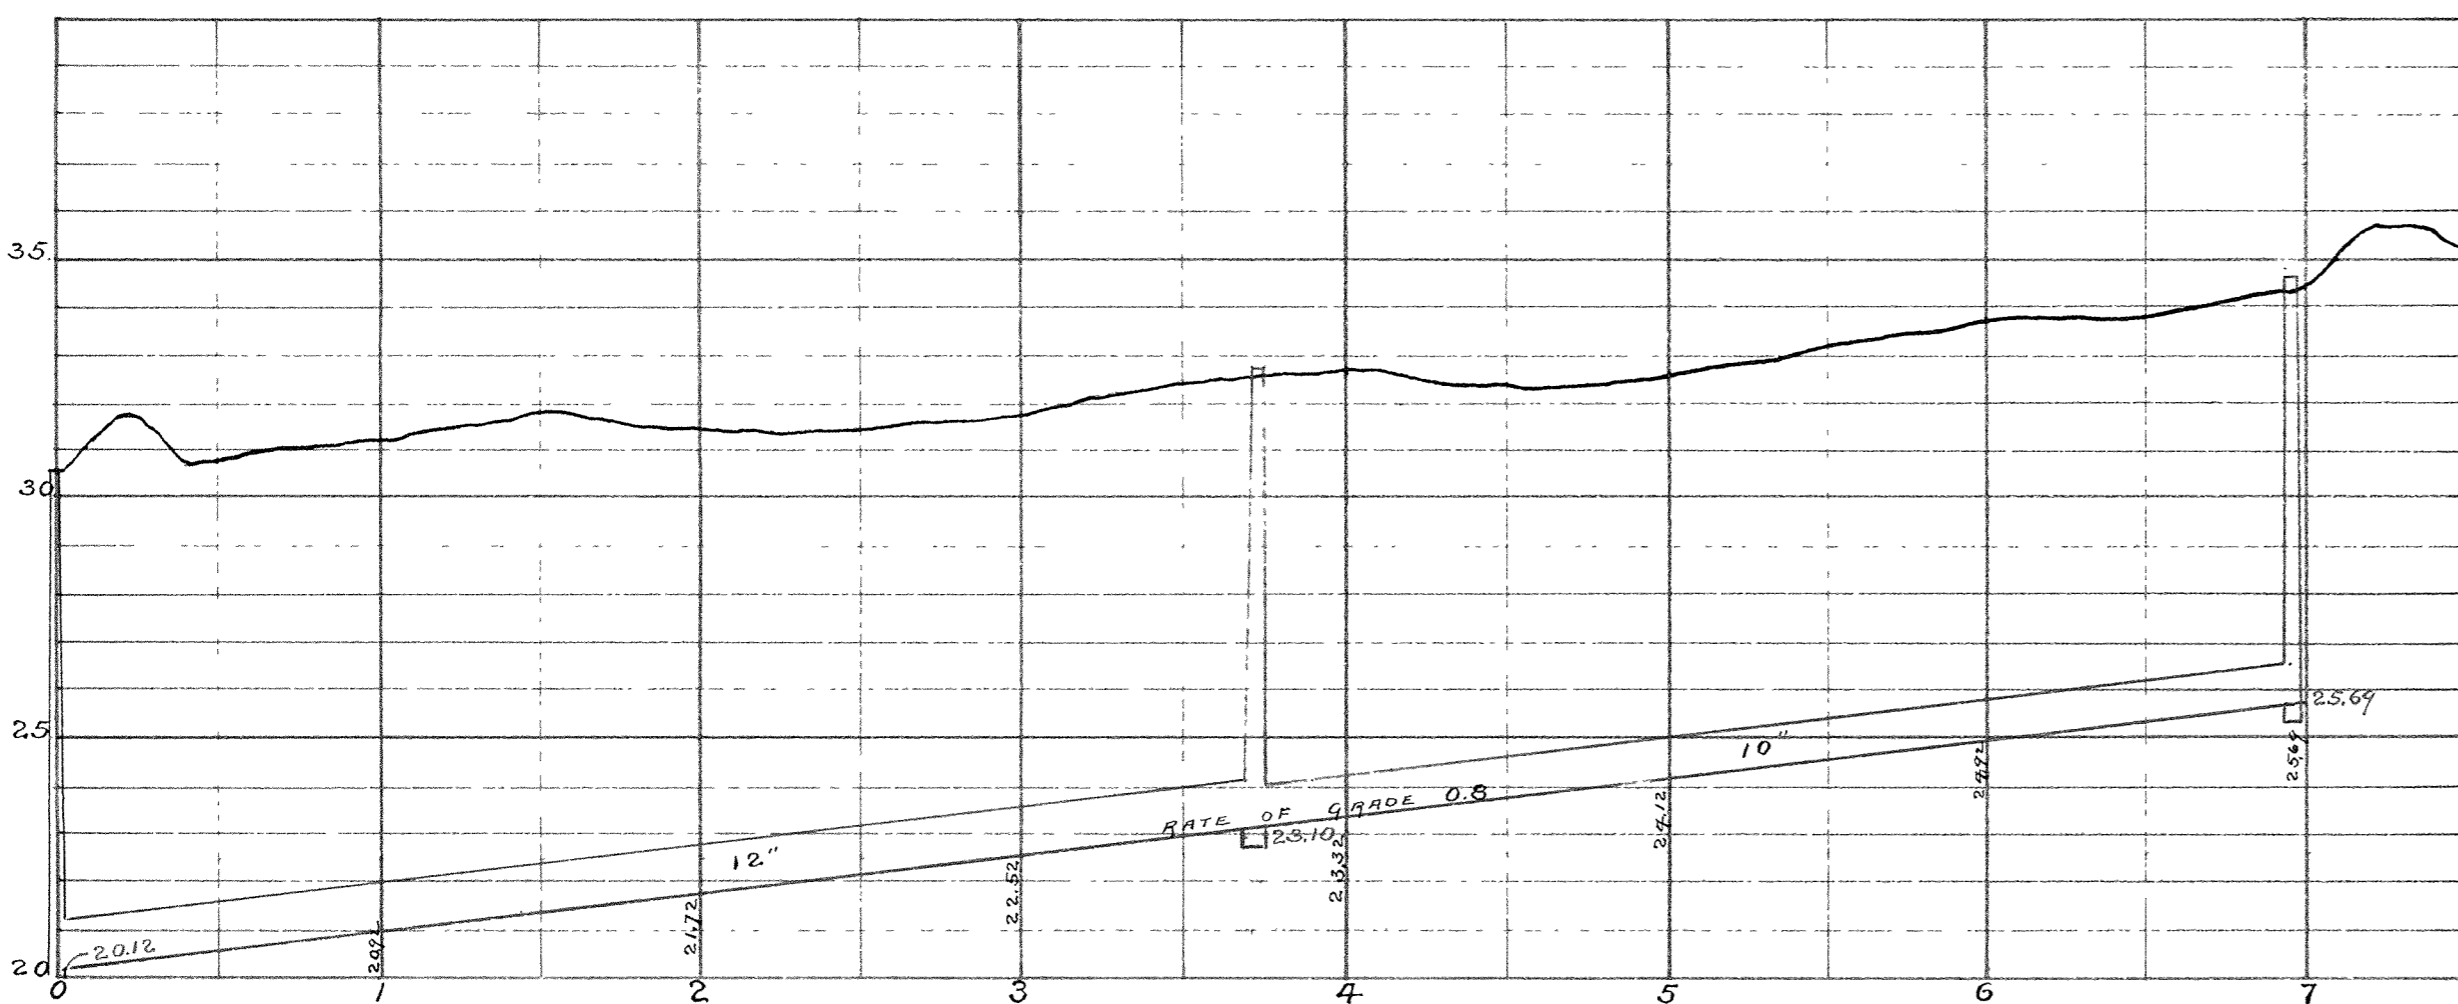


CONTRACT NO. 1574 - RICHES AND SON CONTR'S.
LET APR. 18TH 1918 COMPLETED AUG. 1ST 1918.

E. M. STEFFENSON INSPTR. E. B. BANKS CITY ENGR.

VERTICAL SCALE 1" = 4'
HORIZONTAL " 1" = 60'

RICHES CEMENT PIPE USED.

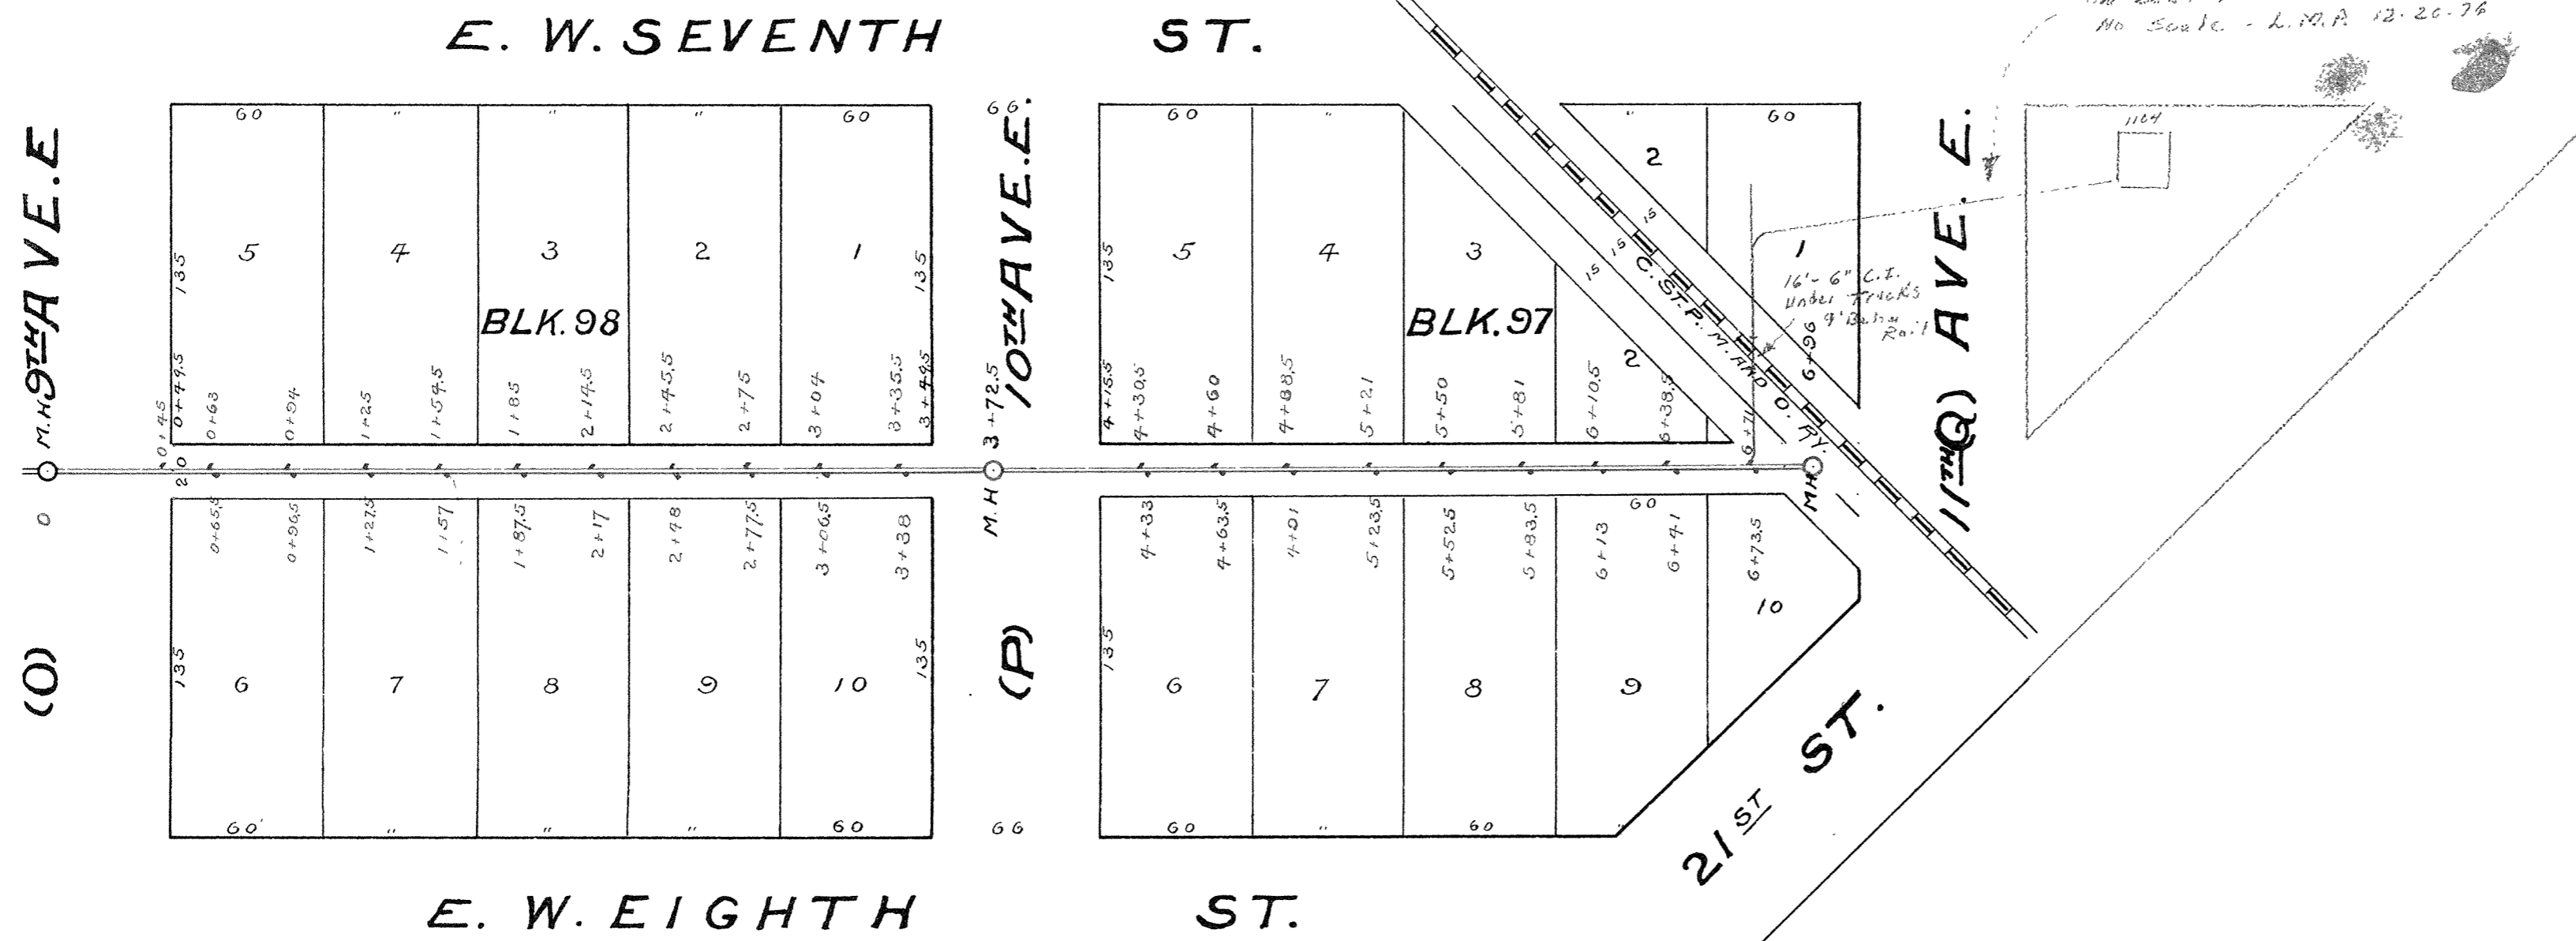

3A-7A