



E. FIFTH

Note - Connections in Block 61 are not suitable.

FIFTH

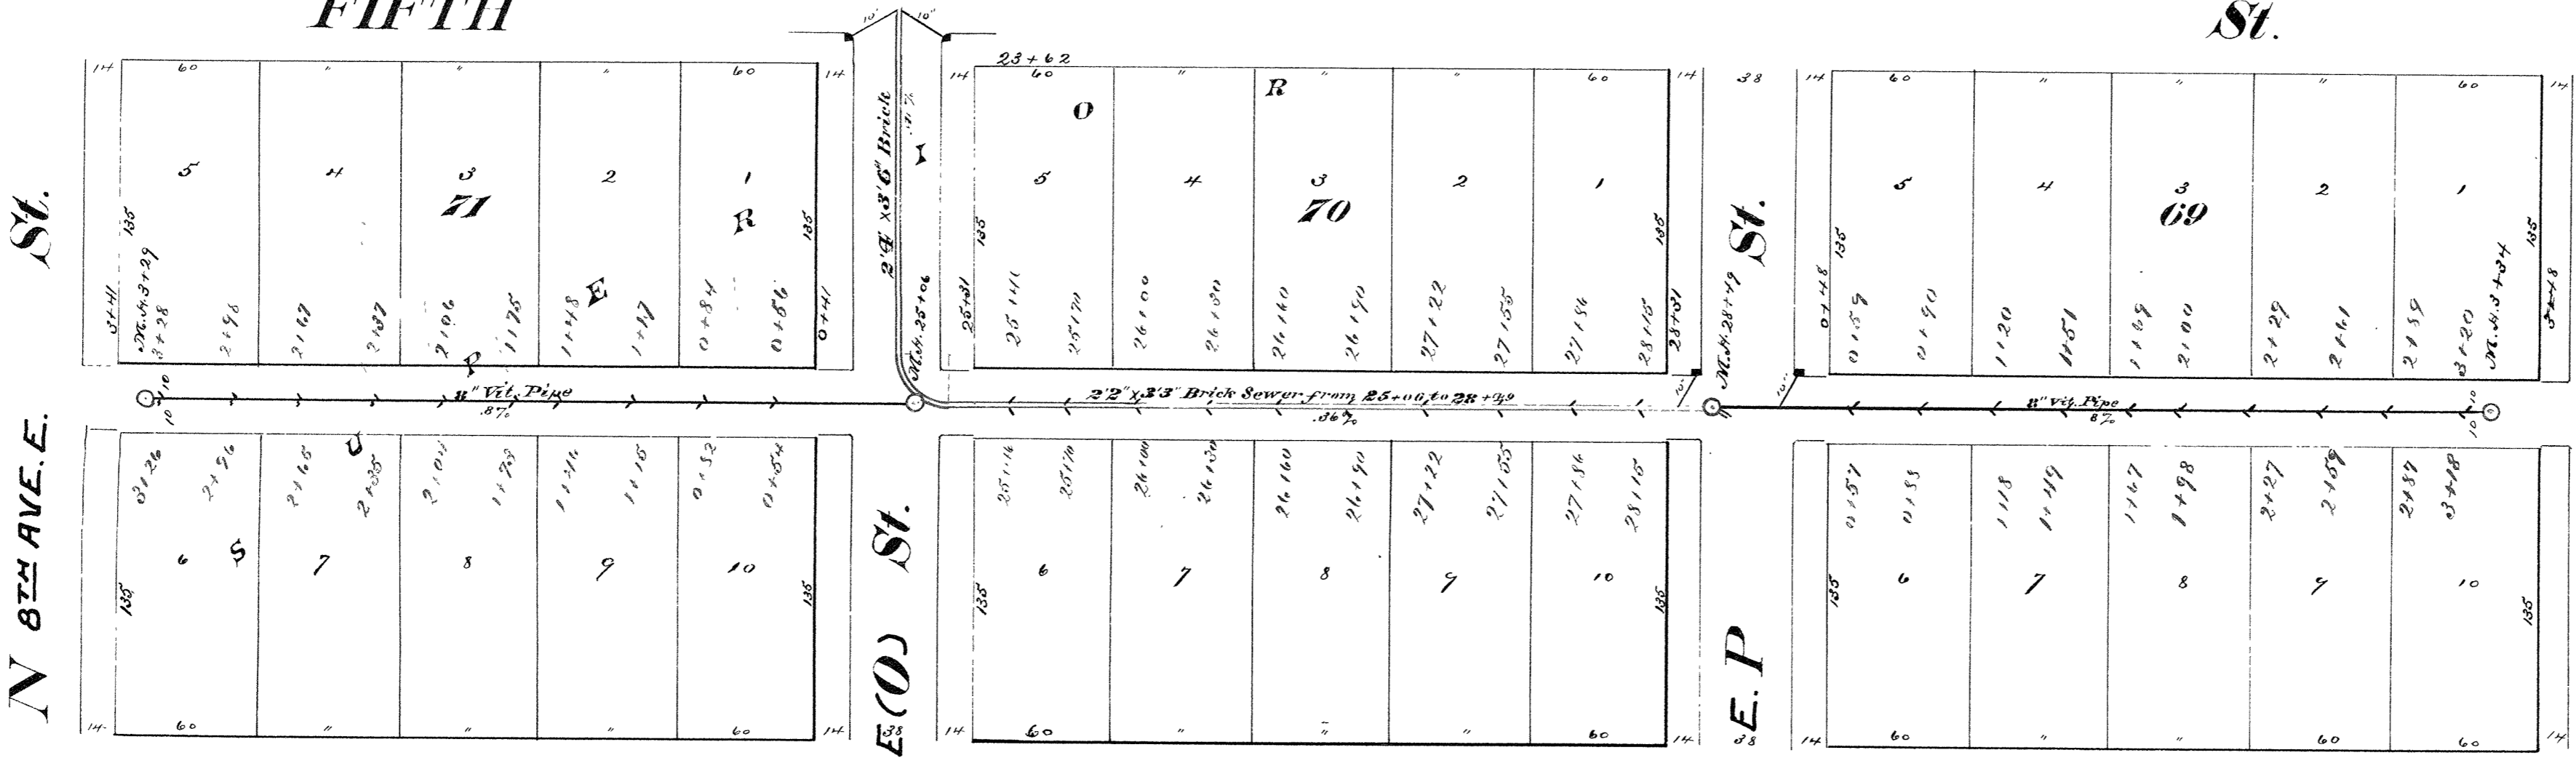

E. SIXTH

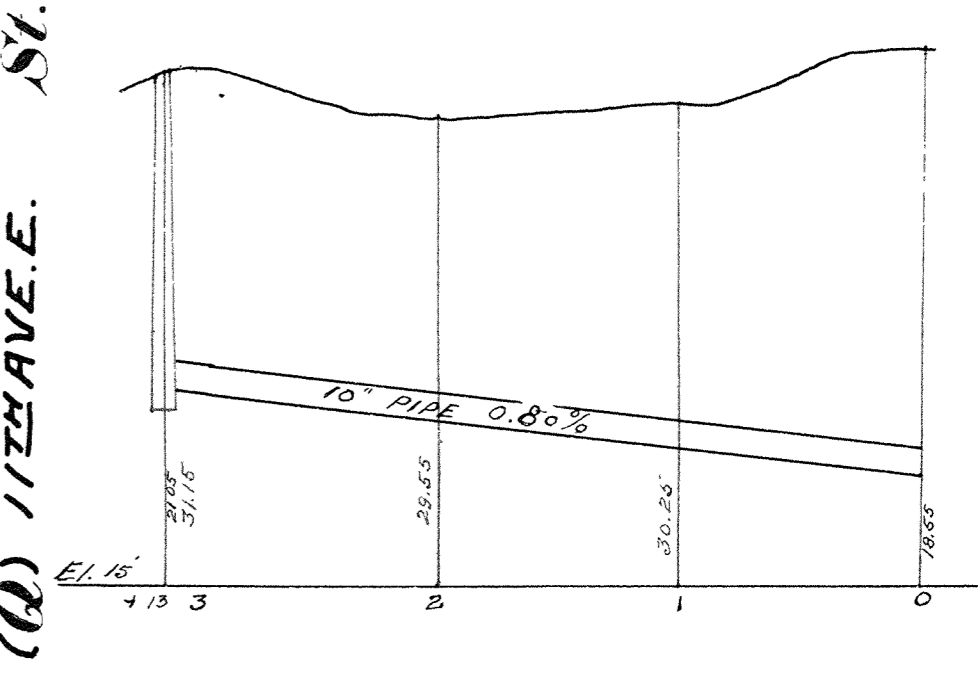

Horizontal Scale: 1 inch = 80 ft.
Vertical Scale 1" = 6'
CONTRACT No 1564

Contract let October 8th 1917
Contract completed December 5th 1917
Magnus Peterson Contractor
F.L. Clerk Inspector
E.B. Banks City Engineer

Sewer & Established Streets & Alley Grades

M.H. at	E.T. at	O Street	P Street	E.T. at	M.H. at	Q Street	S Street	5th Street	Alley betw. 5th & 6th Sts.
3+29	3+23	W. Side	E. Side	W. Side	E. Side	6+83	at 3+34	S. Side	N. Side
Sewer Street	Sewer Street	Sewer Street	Sewer Street	Sewer Street	Sewer Street	Sewer Street	Sewer Street	Sewer Street	Sewer Street
Alley betw. 4th & 5th Sts.	17.47	16.06	15.64	16.34	17.44	17.20	21.29		
Alley betw. 5th & 6th Sts.	19.85	17.68	15.55	16.61	18.98				
O Street								14.28	14.28
								14.08	14.64
									18.18

Scale 1 inch = 60 ft.

3A-8