
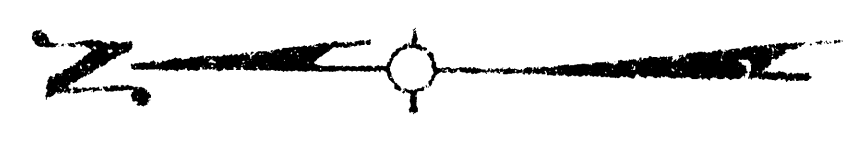


BENCH MARKS		
NO. STA.	DESCRIPTION	ELEV.
1	GEO. MON. # 2394-13 (21- & HILL)	636.122

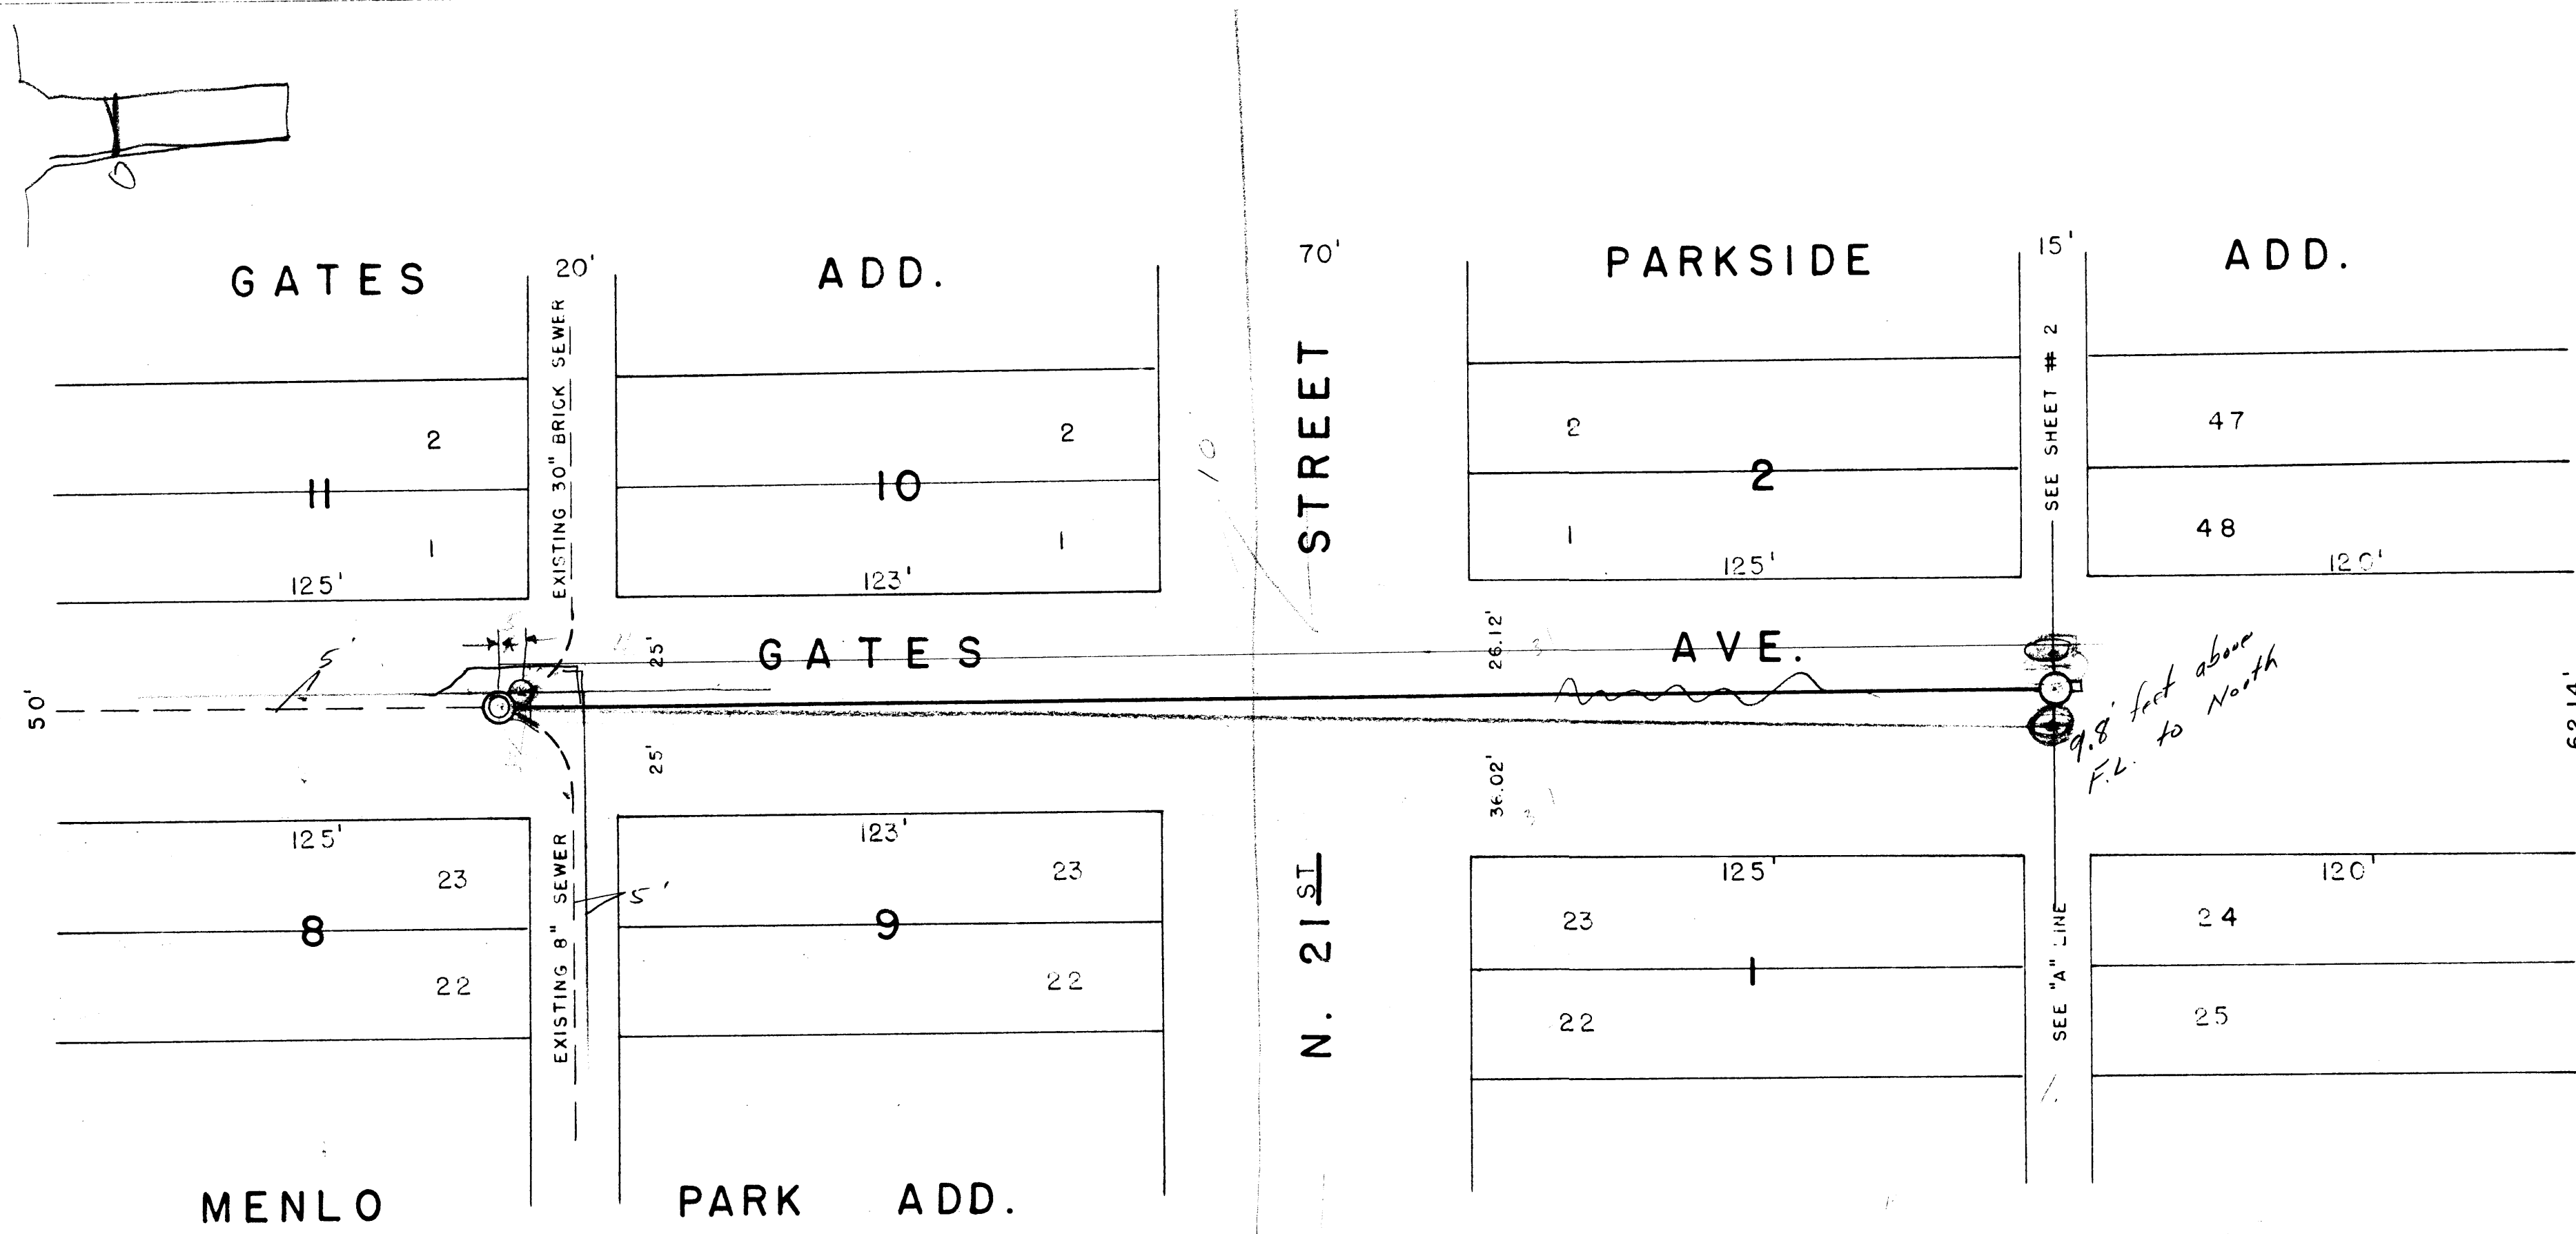


CITY OF SUPERIOR  
ENGINEERING DEPARTMENT  
**PROPOSED EXT. SAN. SEWER**  
BLK. 10 & 11 GATES ADD.  
BLK. 1 & 2 PARKSIDE ADD.  
BLK. 8 & 9 MENLO PARK ADD.

L.M. HAGEN MAYOR  
E.W. BERG CITY ENGINEER

DES. F.M.S.	APPD.	FILE NO.
DRN. G.C.W.		

DATE 12-59 SCALE 1"=30'

**PLAN**  
DESIGNED BY  
CHECKED BY  
DATE 12-59  
SCALE 1"=30'

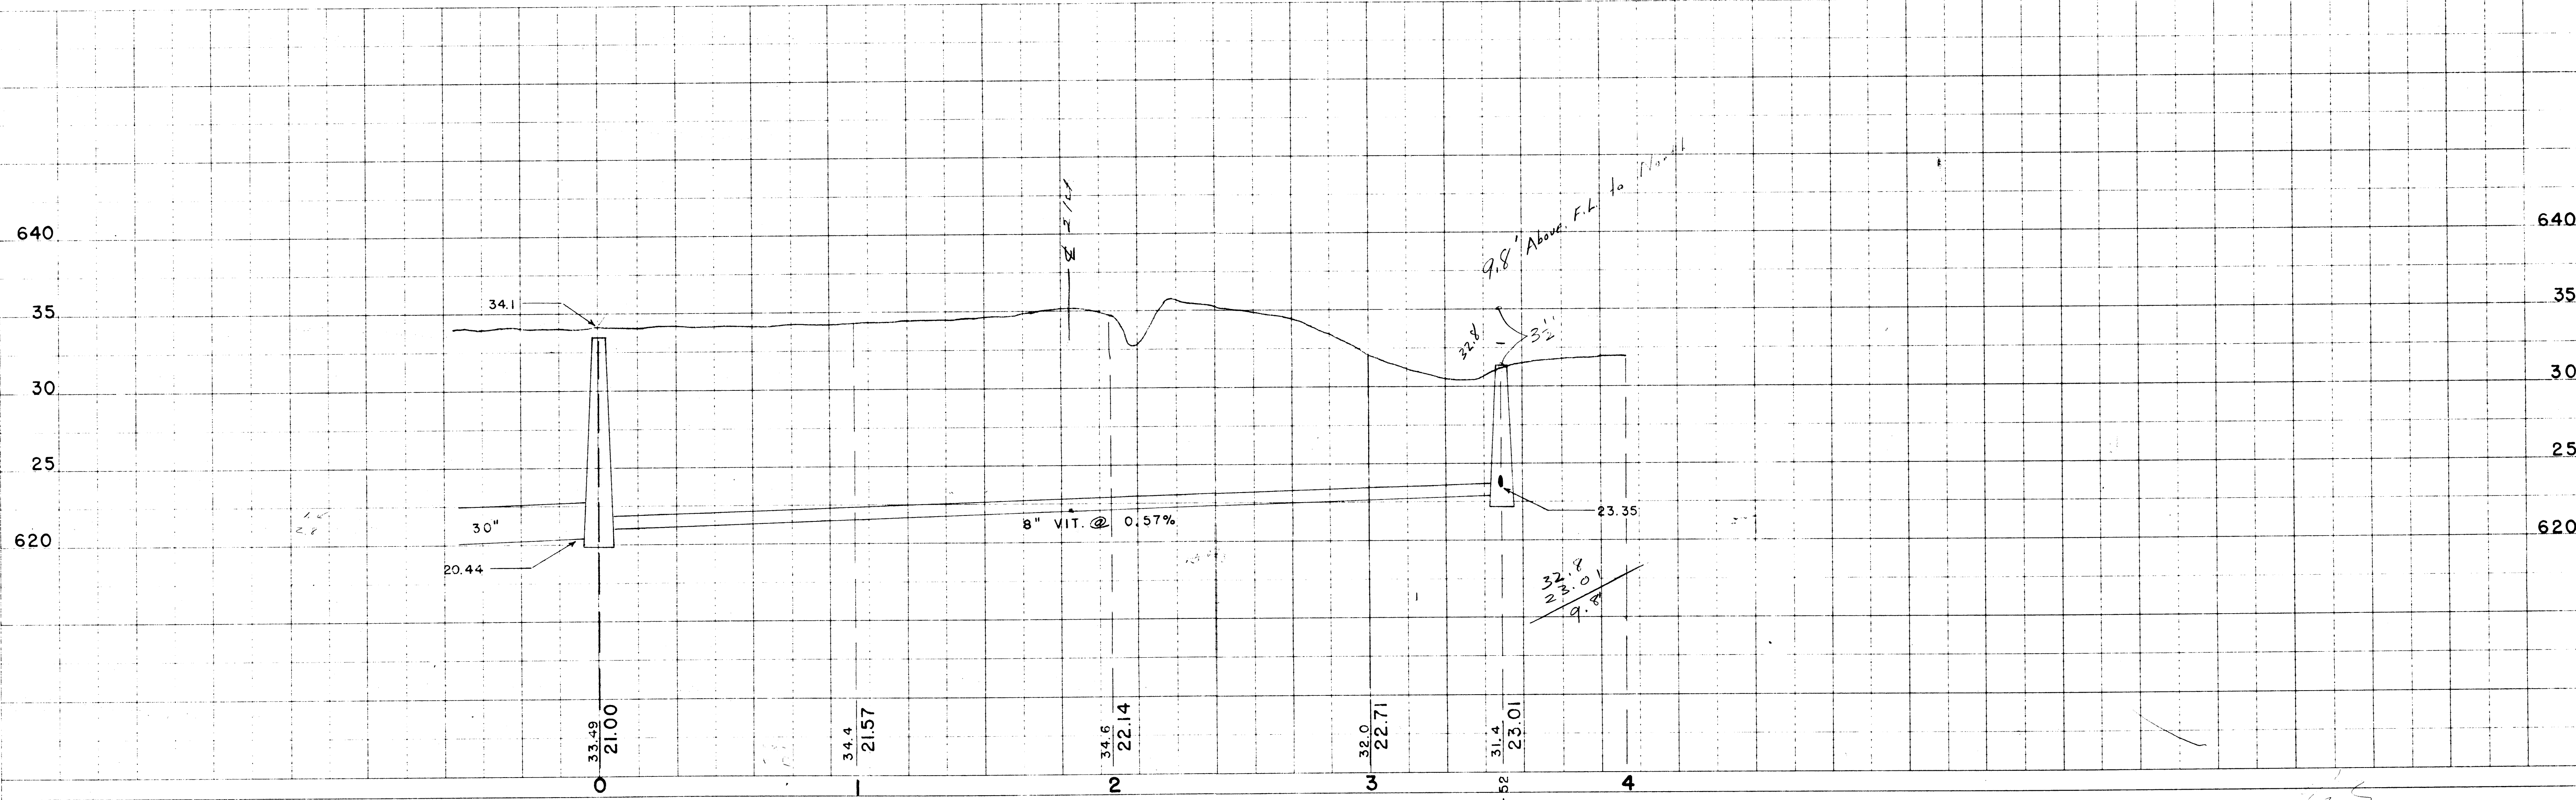

**PROFILE**  
DESIGNED BY  
CHECKED BY  
DATE 12-59  
SCALE 1"=30'

PLATE 1 PLAN PROFILE 12-59-59  
BY FEDERAL ENGINEERING CO. CHICAGO

2410 Banks

3-938

SHEET NO.

Gates Ave. A-4-12