



P:\PROJECTS\10\97055\107055-0.dwg Thu Jun 08 14:45:49 1999

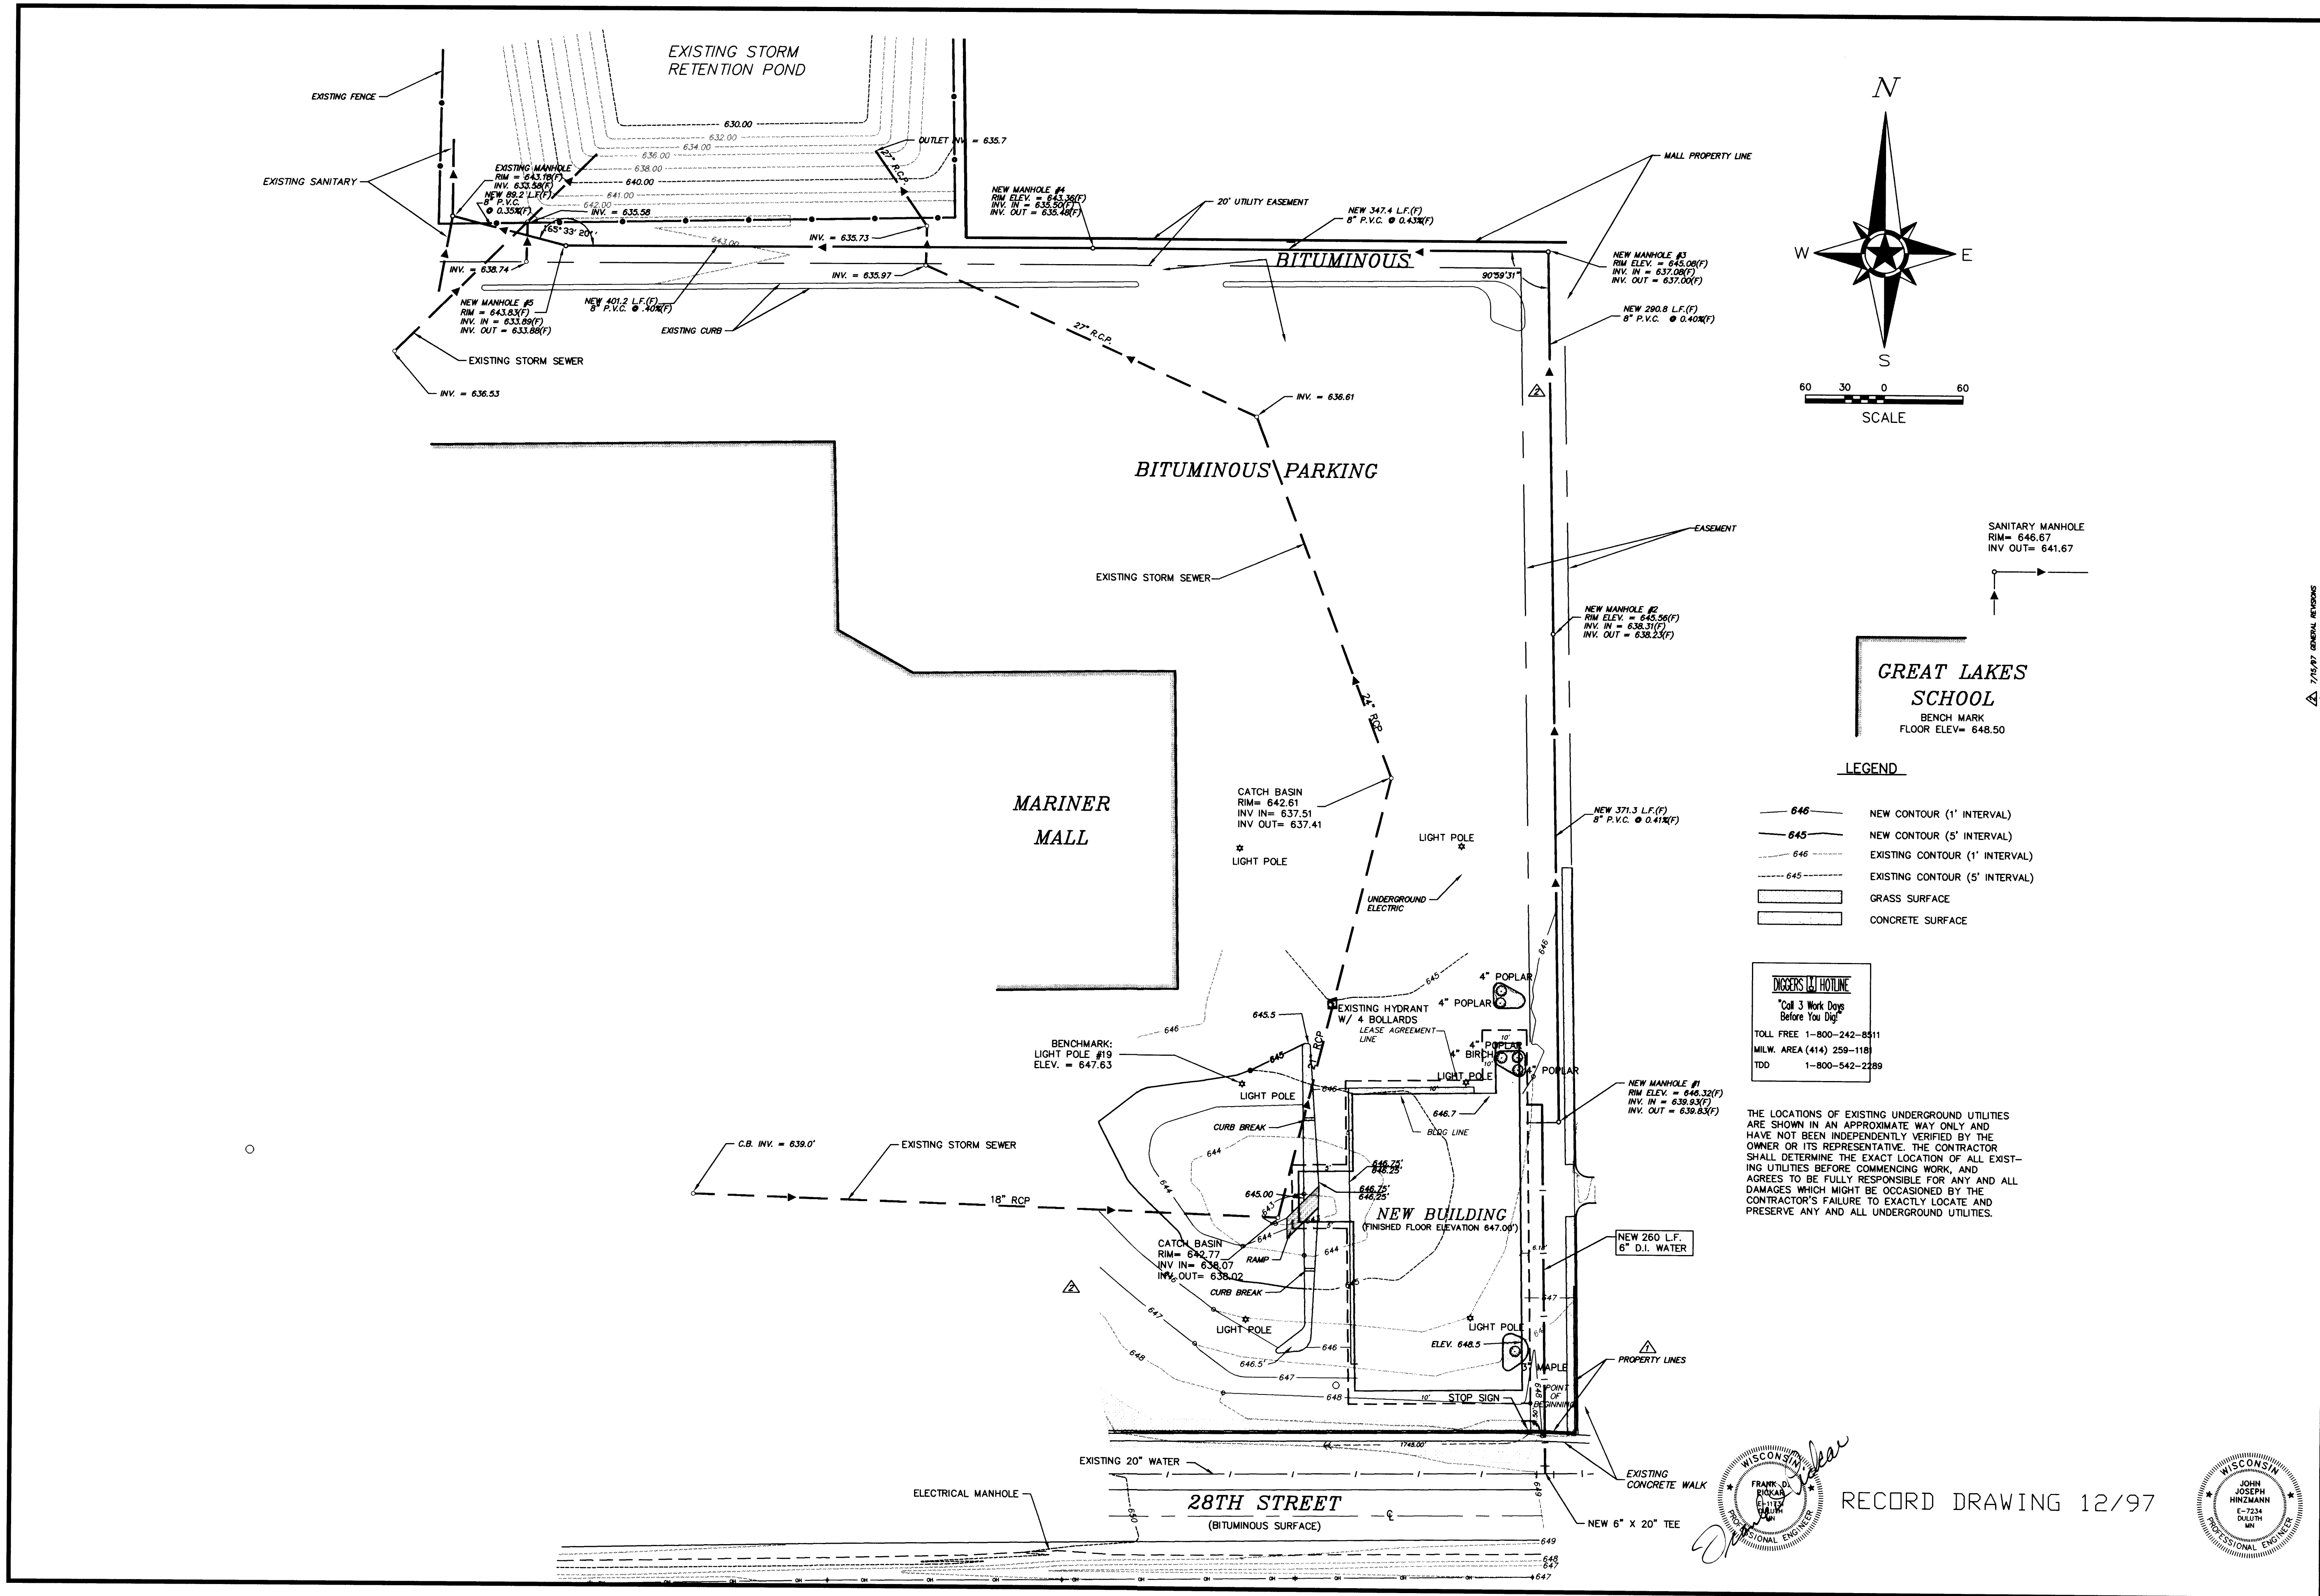

JOB NO. 97055	SHEET OF 1 2	TOPOGRAPHICAL SURVEY FOR A&L PARTNERSHIP		DULUTH, MINNESOTA	
		Seaway Engineering Co. Consulting Engineers & Land Surveyors Duluth, Minnesota			
DESIGN BY	DATE	DRAWN BY	TDM	MARK	REVISION
CHECKED BY	DATE	SCALE	1" = 60'		

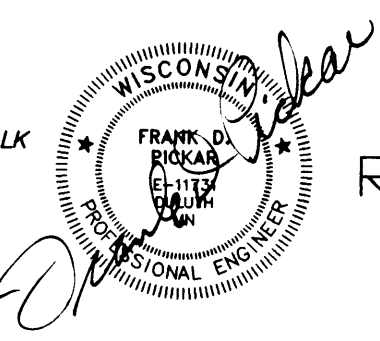

RECORD DRAWING 12/97

