

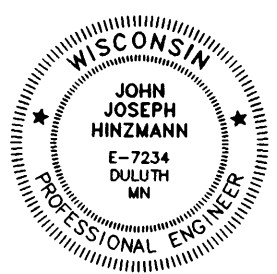
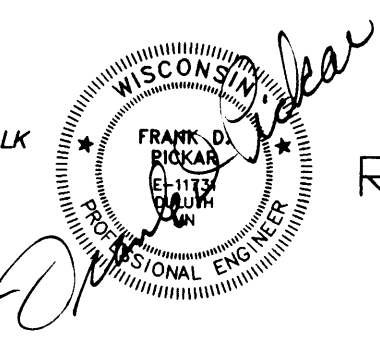
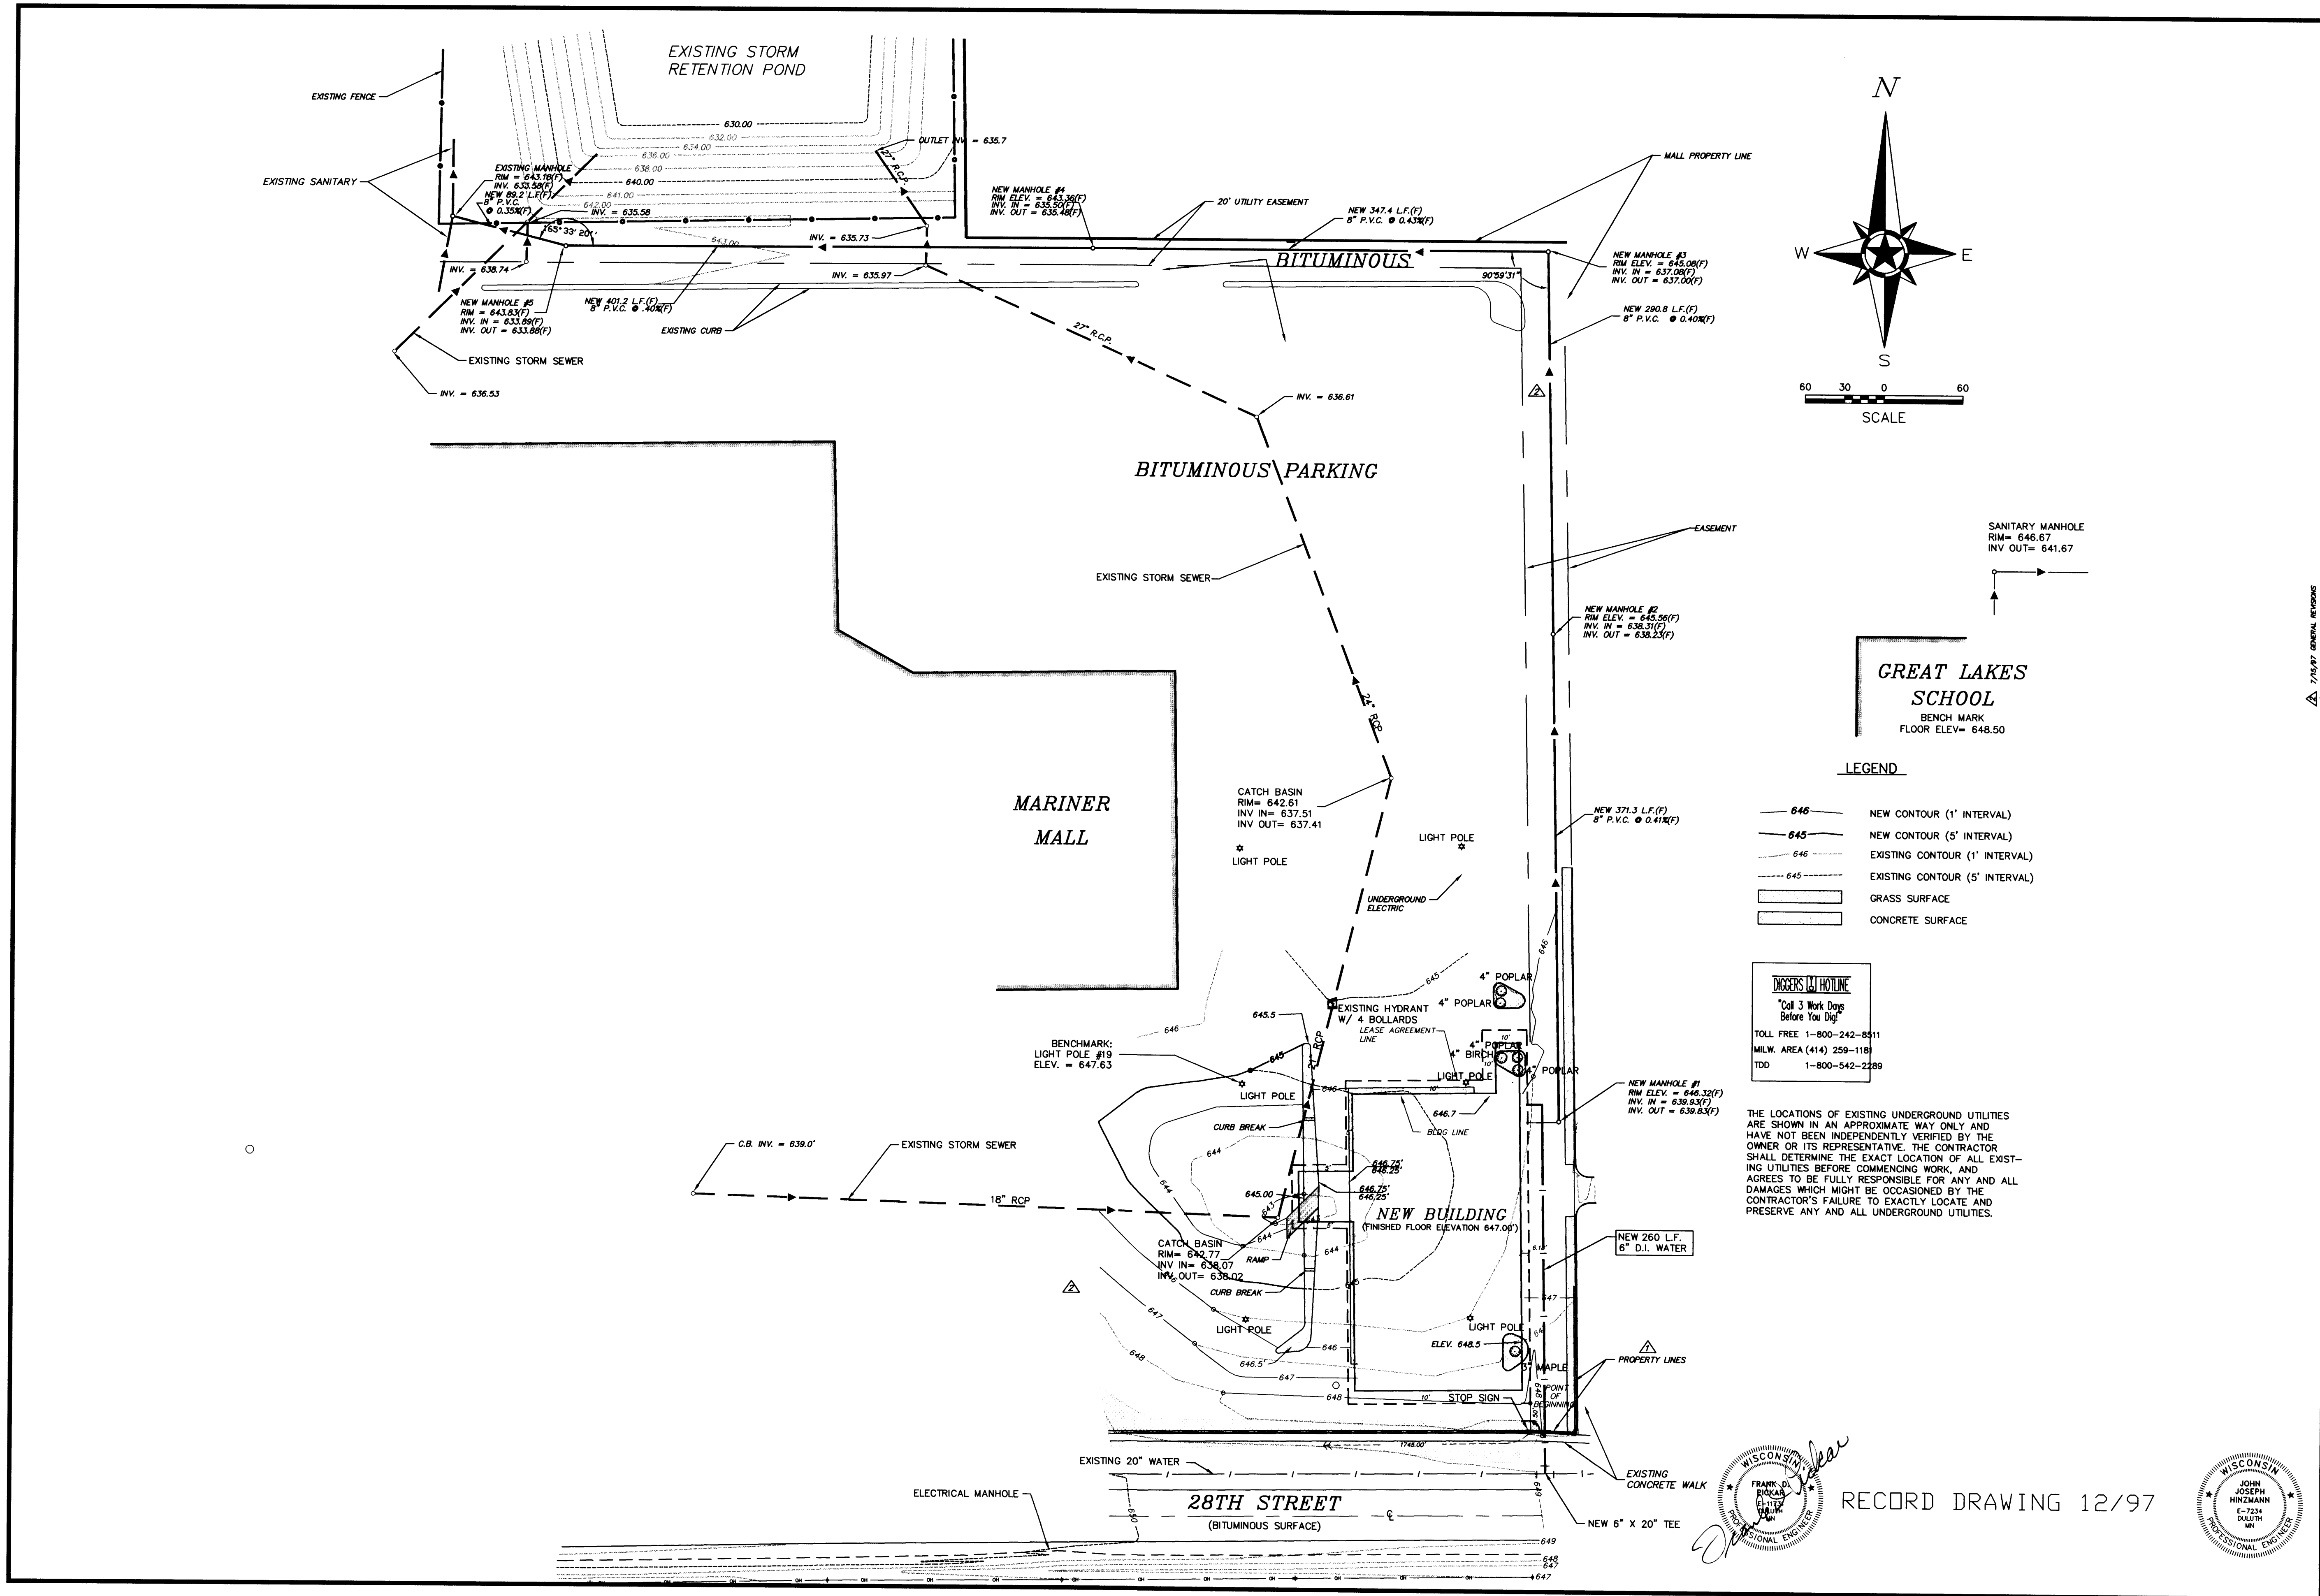
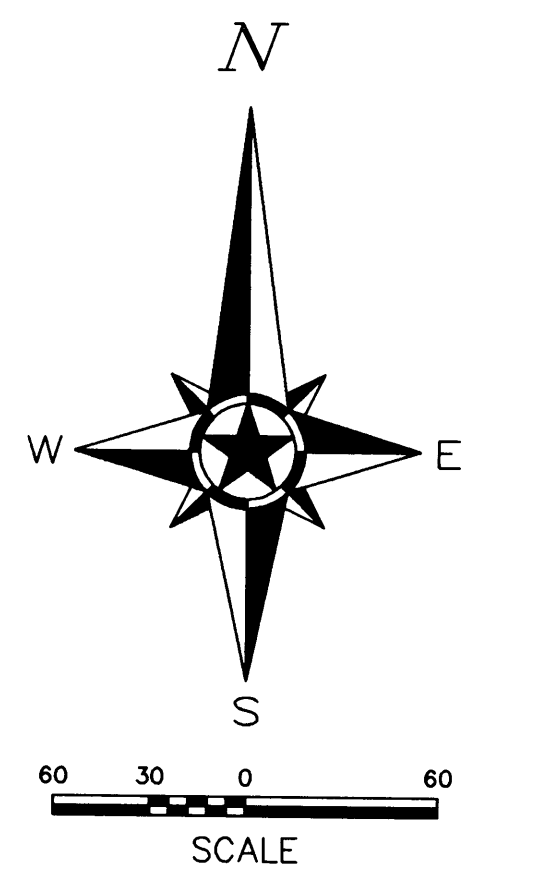
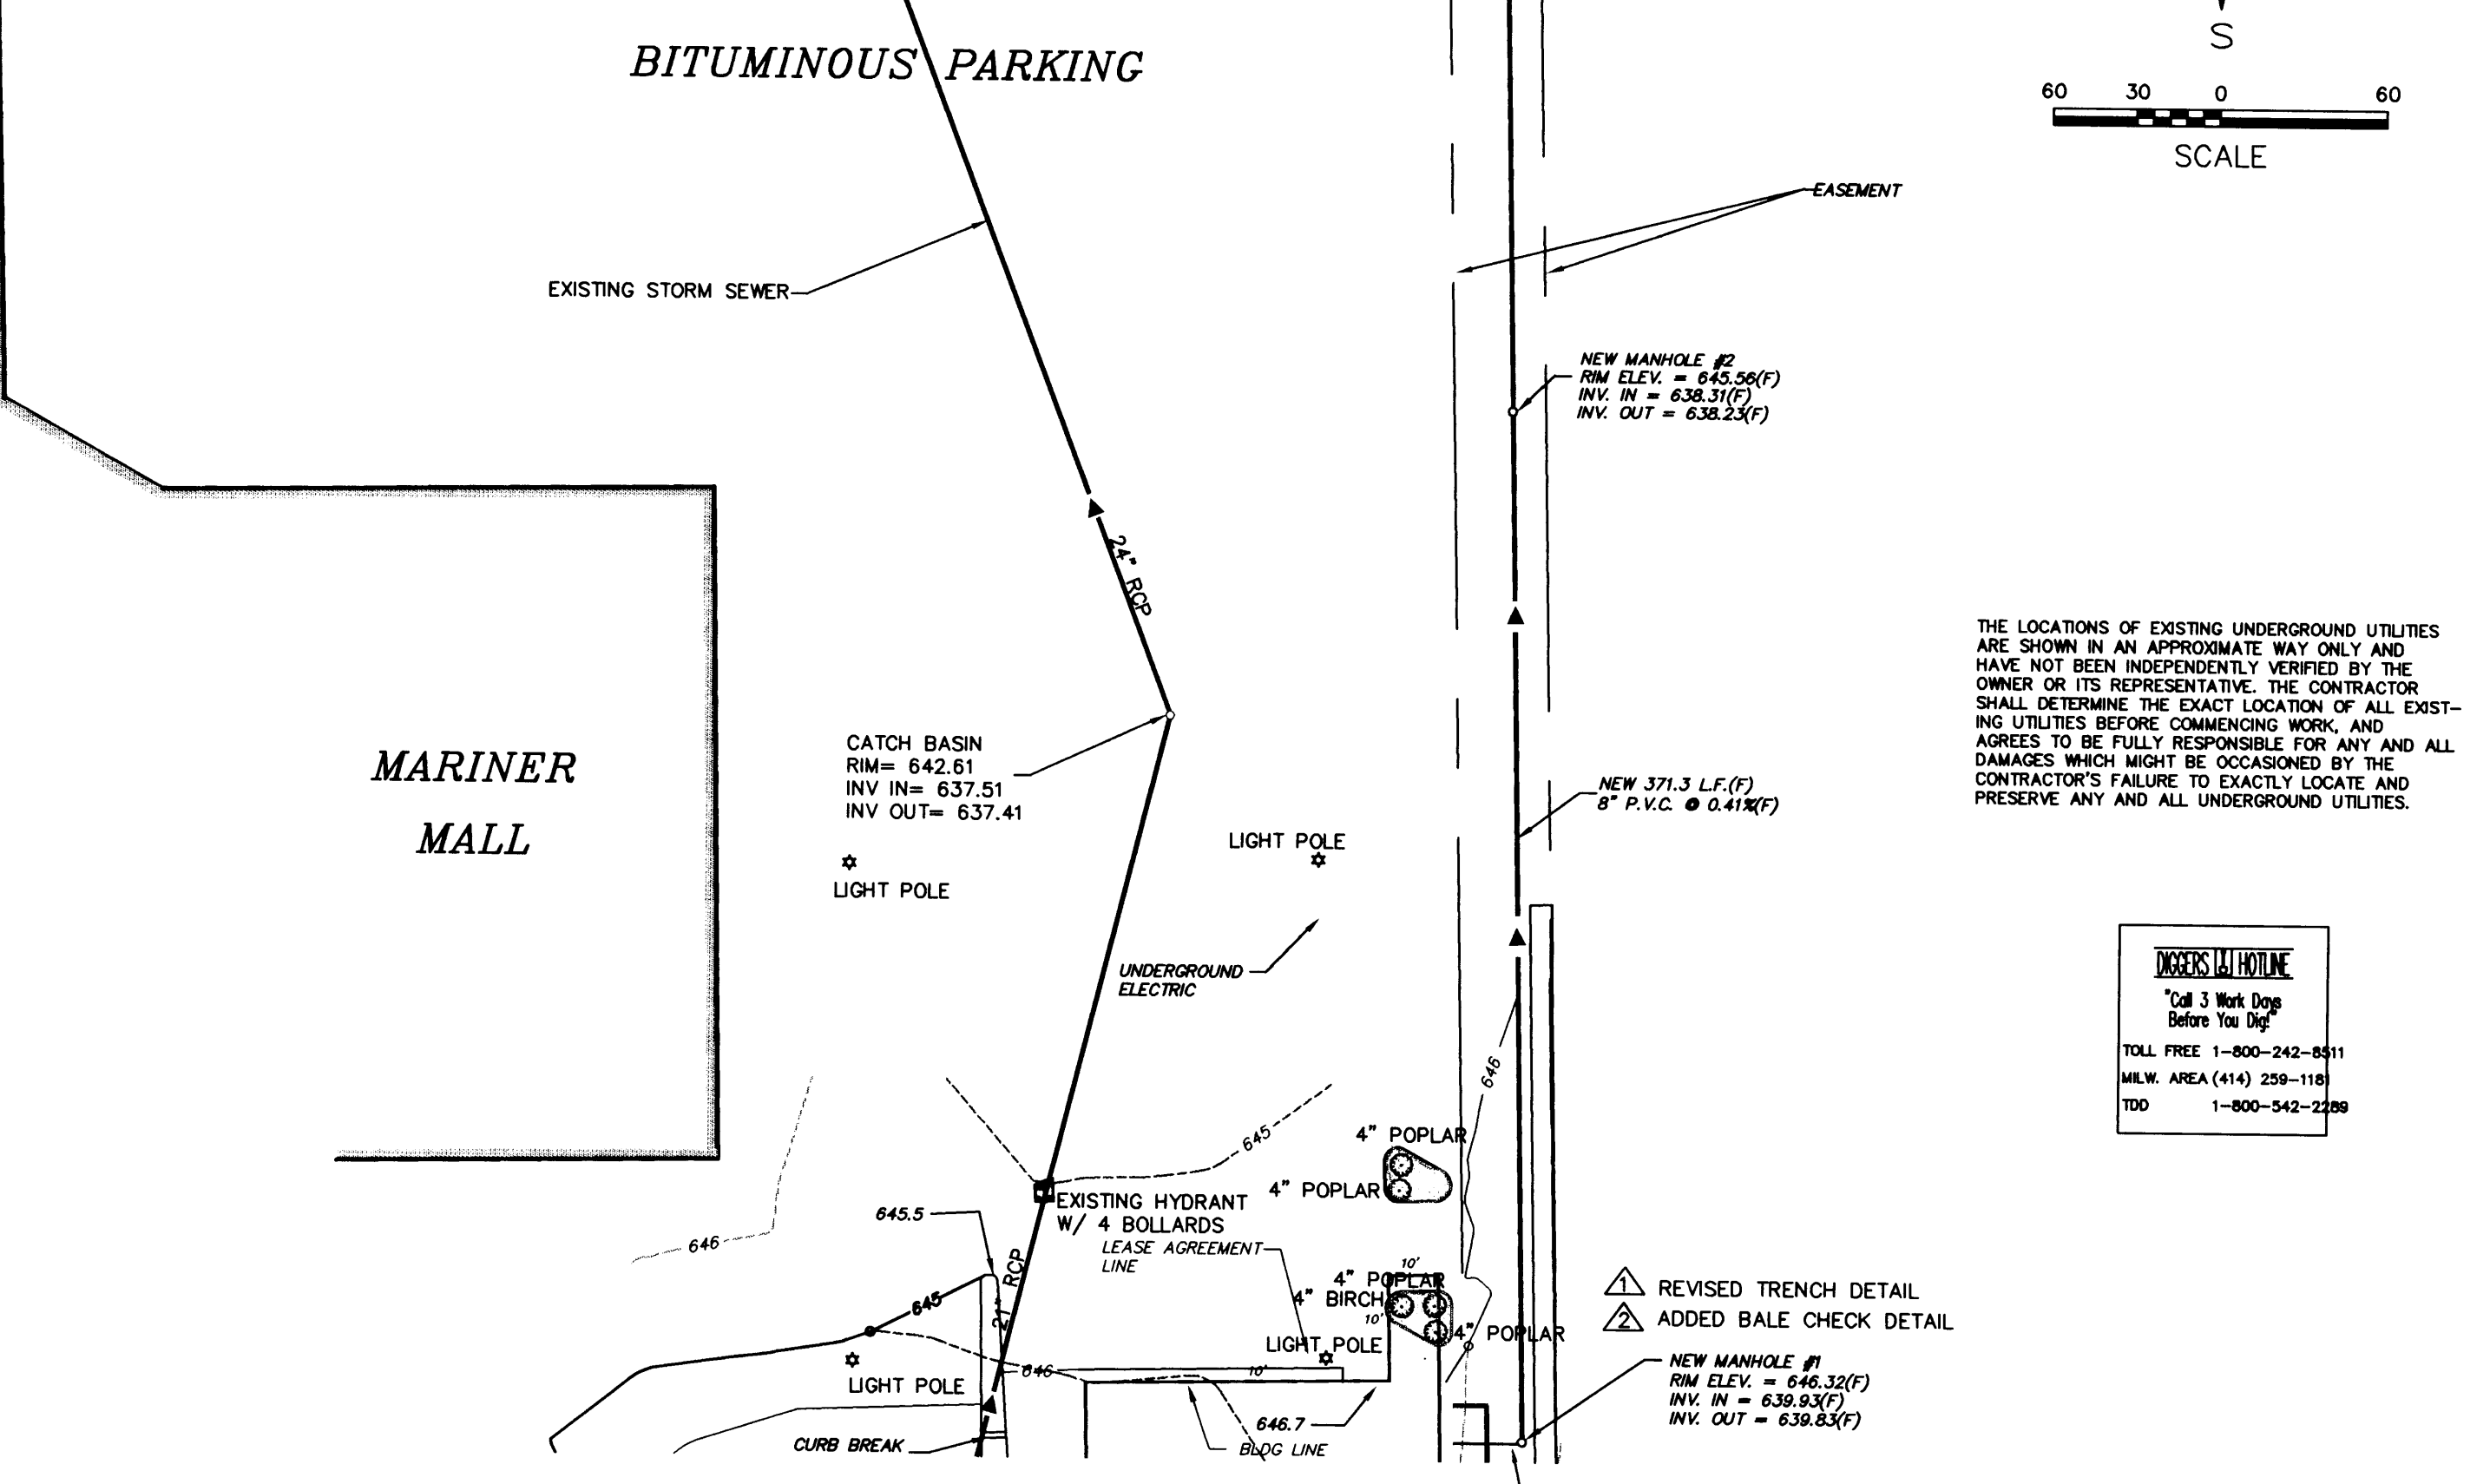
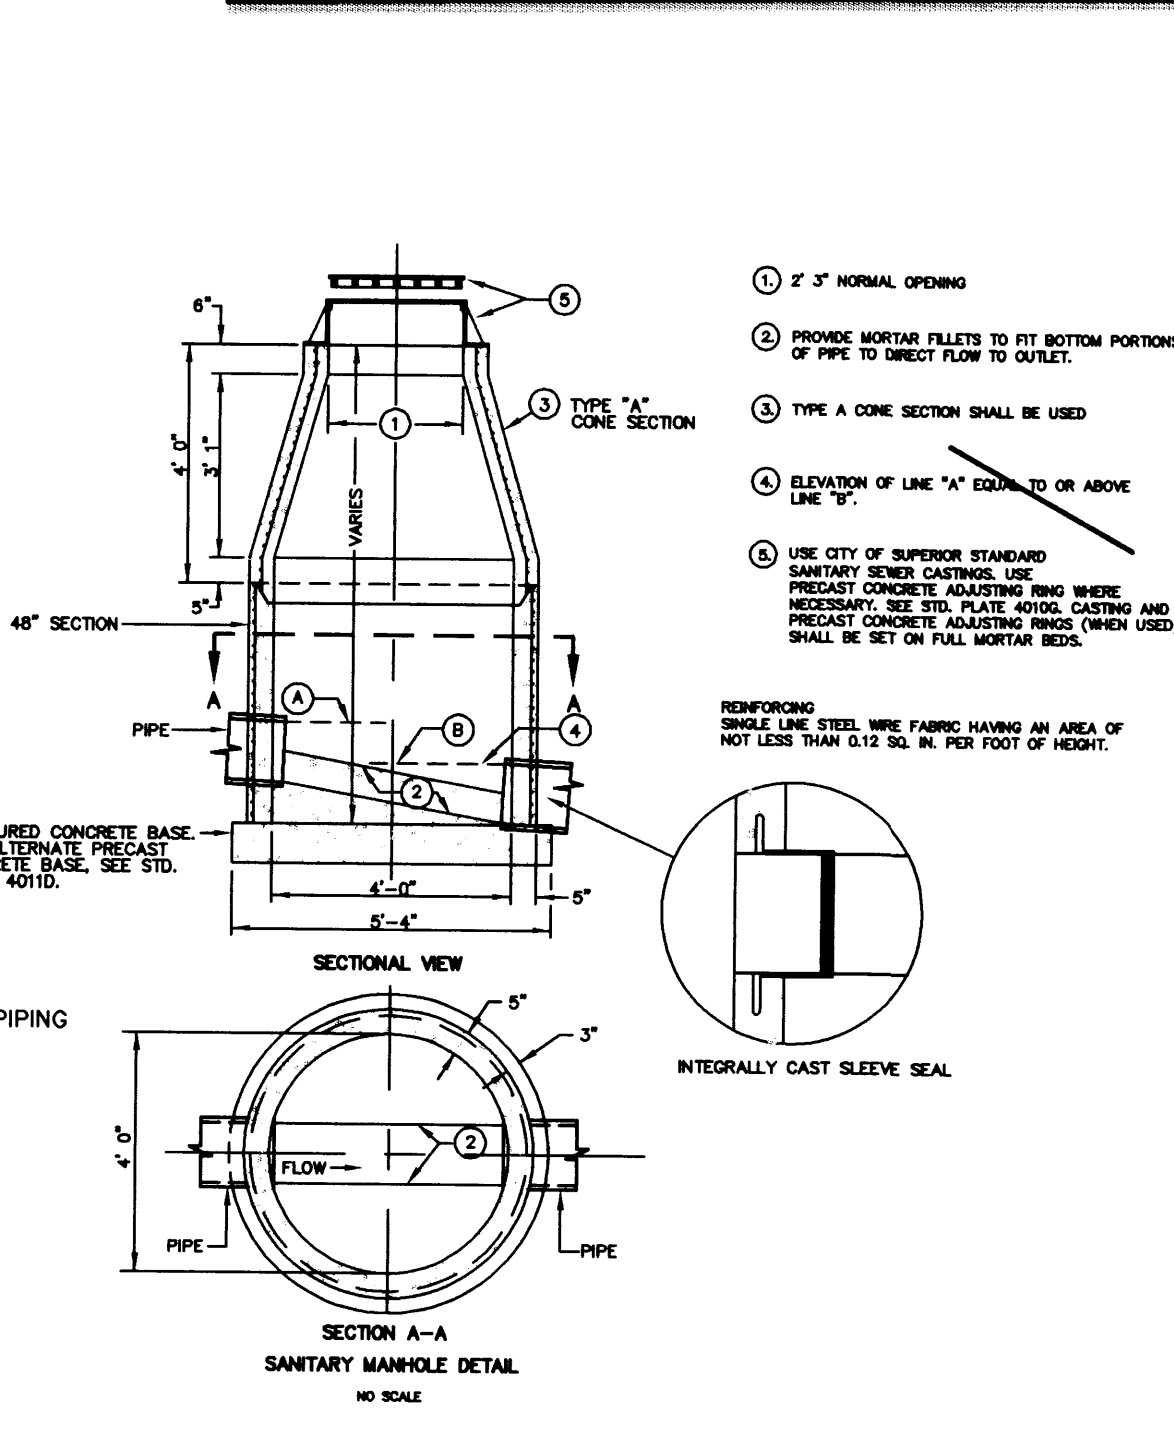
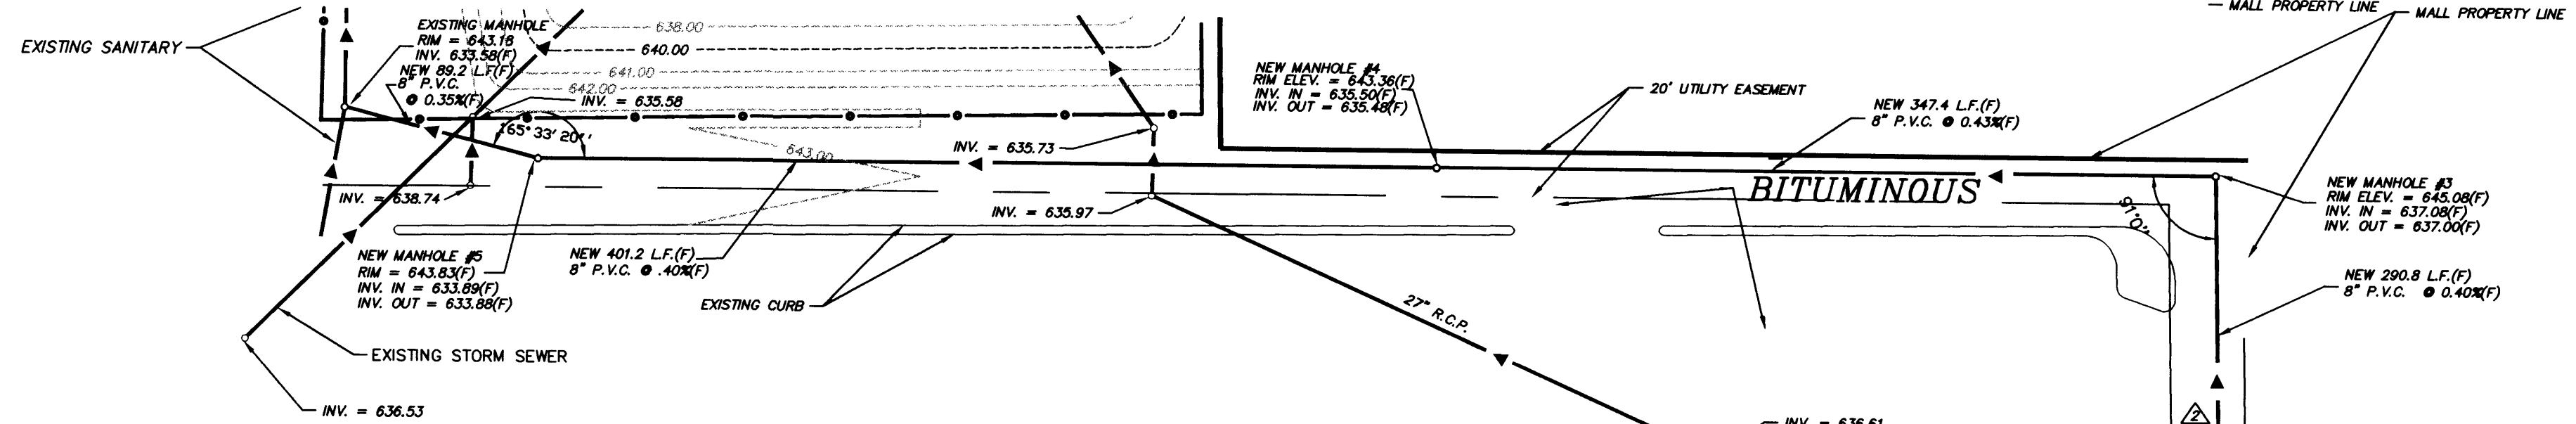
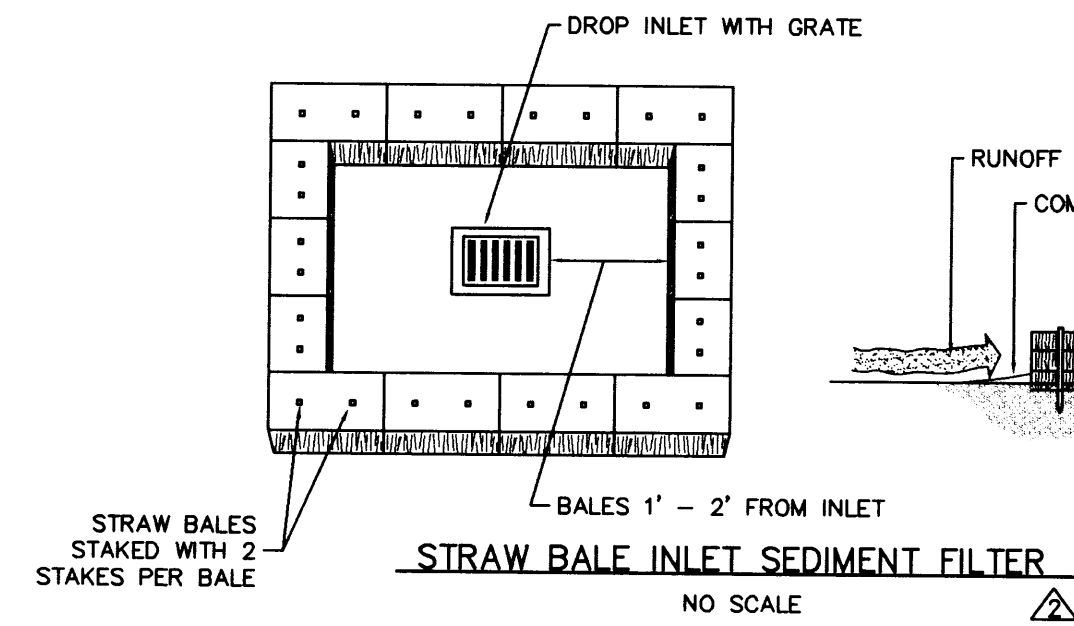
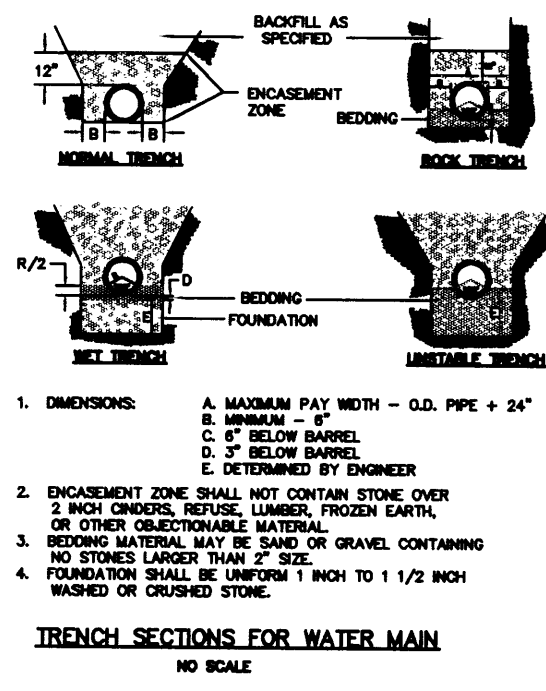


P:\PROJECTS\10\97055\107055-0.dwg Thu Jun 08 14:45:49 1999


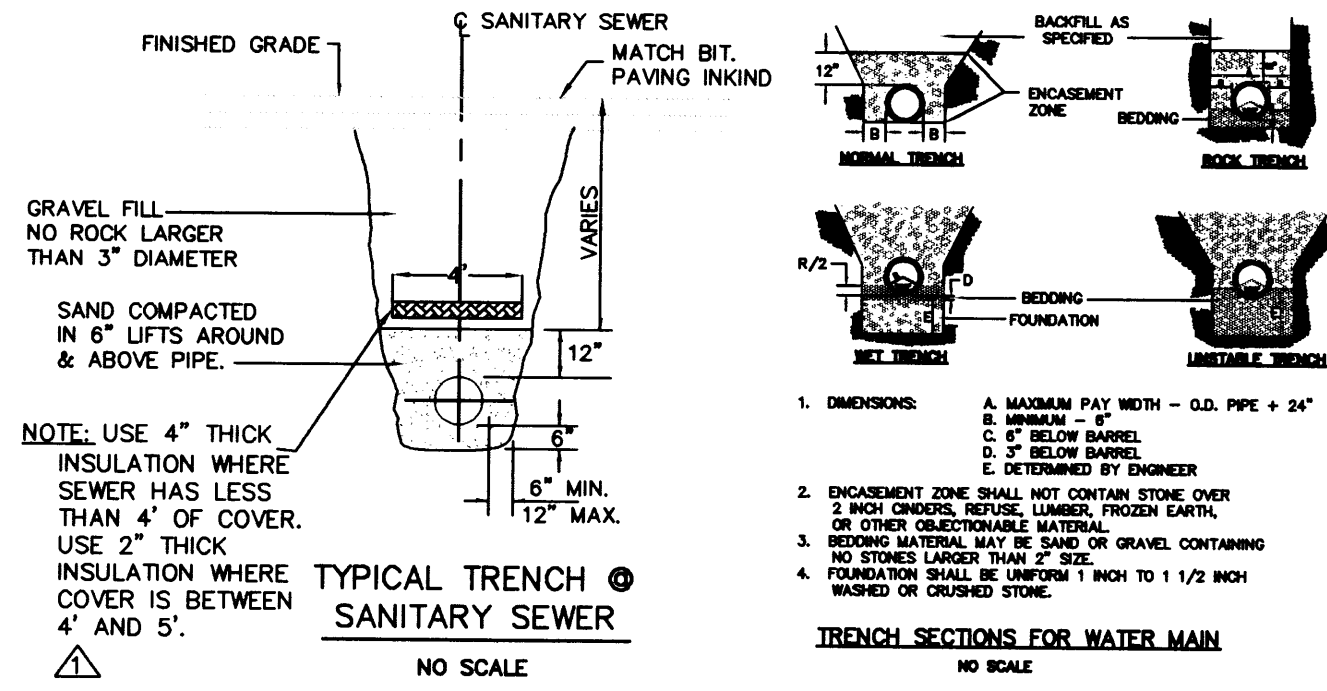


RECORD DRAWING 12/97

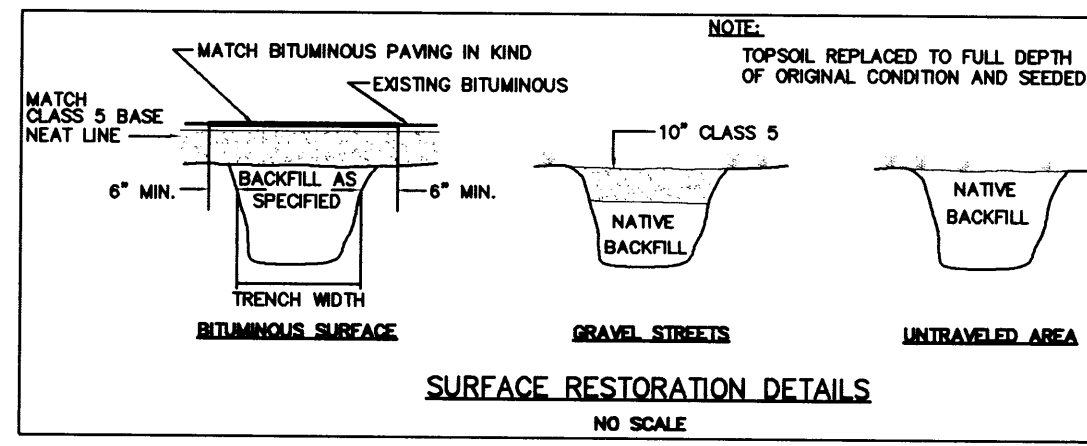


THE LOCATIONS OF EXISTING UNDERGROUND UTILITIES ARE SHOWN IN AN APPROXIMATE WAY ONLY AND HAVE NOT BEEN INDEPENDENTLY VERIFIED BY THE OWNER OR ITS REPRESENTATIVE. THE CONTRACTOR SHALL DETERMINE THE EXACT LOCATION OF ALL EXISTING UTILITIES BEFORE COMMENCING WORK, AND AGREES TO BE FULLY RESPONSIBLE FOR ANY AND ALL DAMAGES WHICH MIGHT BE OCCASIONED BY THE CONTRACTOR'S FAILURE TO EXACTLY LOCATE AND PRESERVE ANY AND ALL UNDERGROUND UTILITIES.

NEEDS A PHONE
Call 3 Mark Days Before You Die
TOLL FREE 1-800-242-8111
MLW AREA (414) 258-1188
TDD 1-800-542-2288

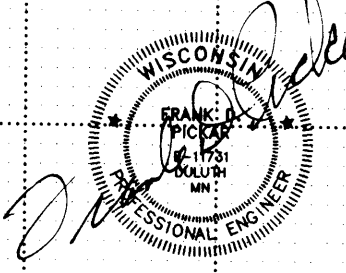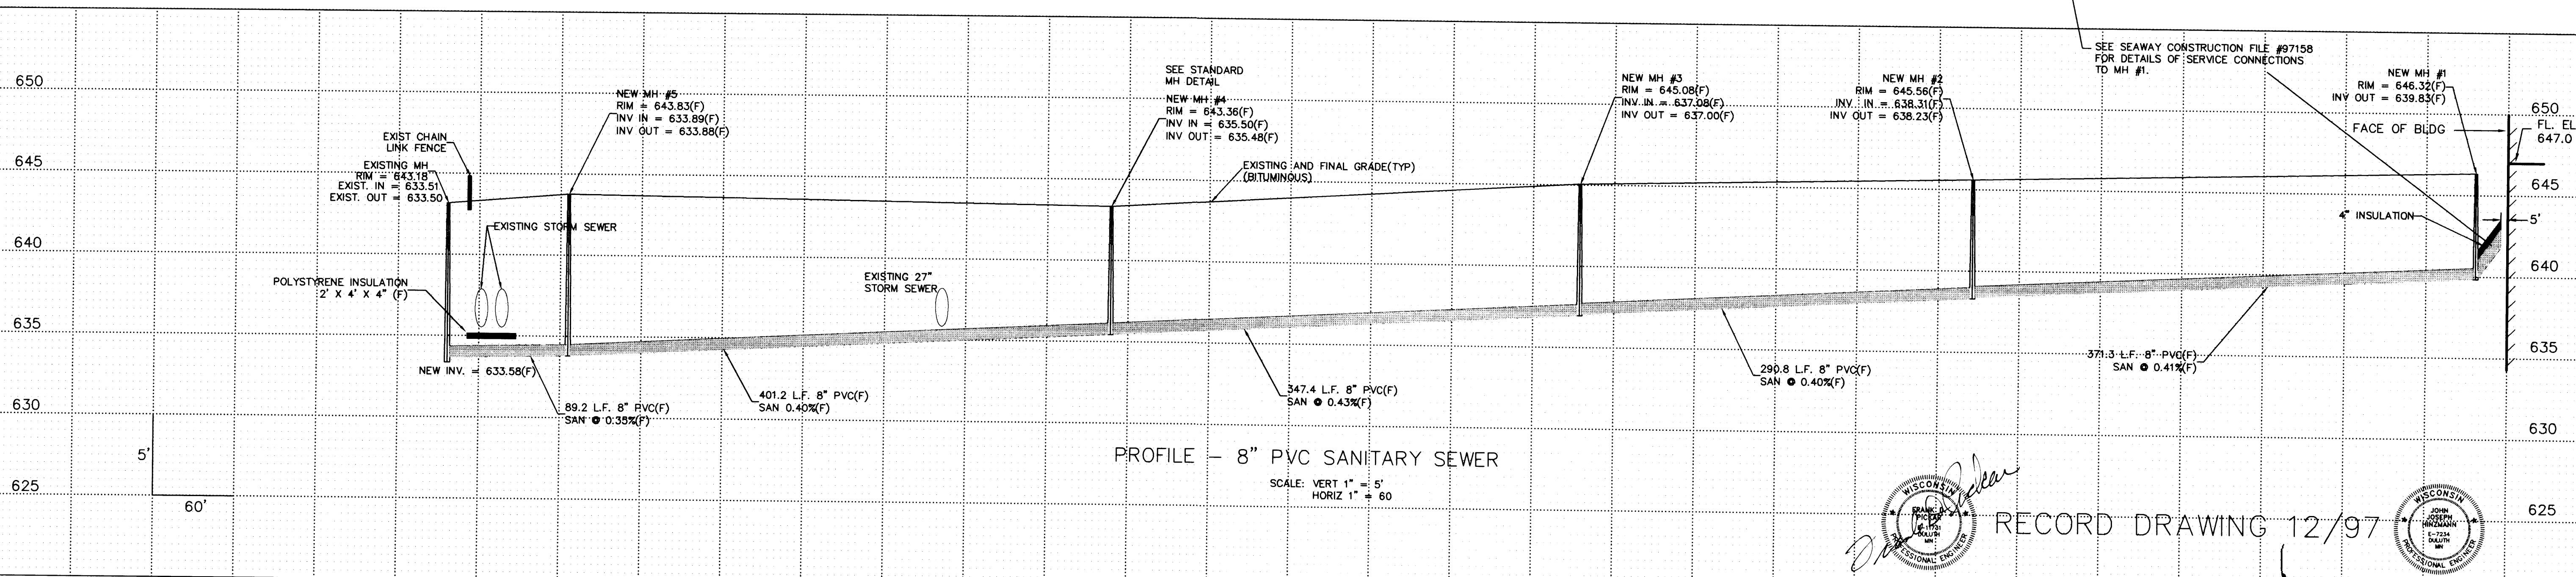

RECORD DRAWING 12/97

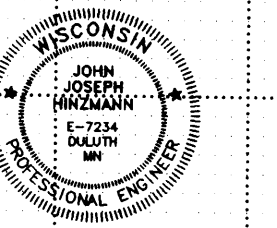

P:\PROJECTS\0197055\97055SPRC.dwg Thu Jan 08 15:05:23 1998