



1
COLOR CODE

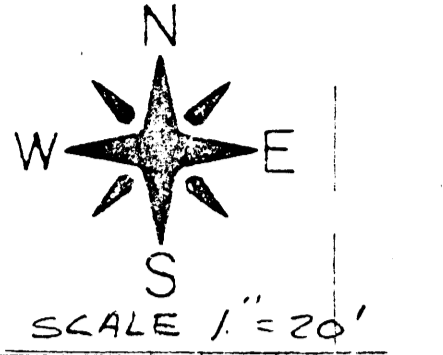


DATE _____
BY _____
PLAN SURVEYED _____
NOTED _____
NOTE BOOK, ALIGNMENT CHECKED _____
PT. OF WAY CHECKED _____
NO. _____

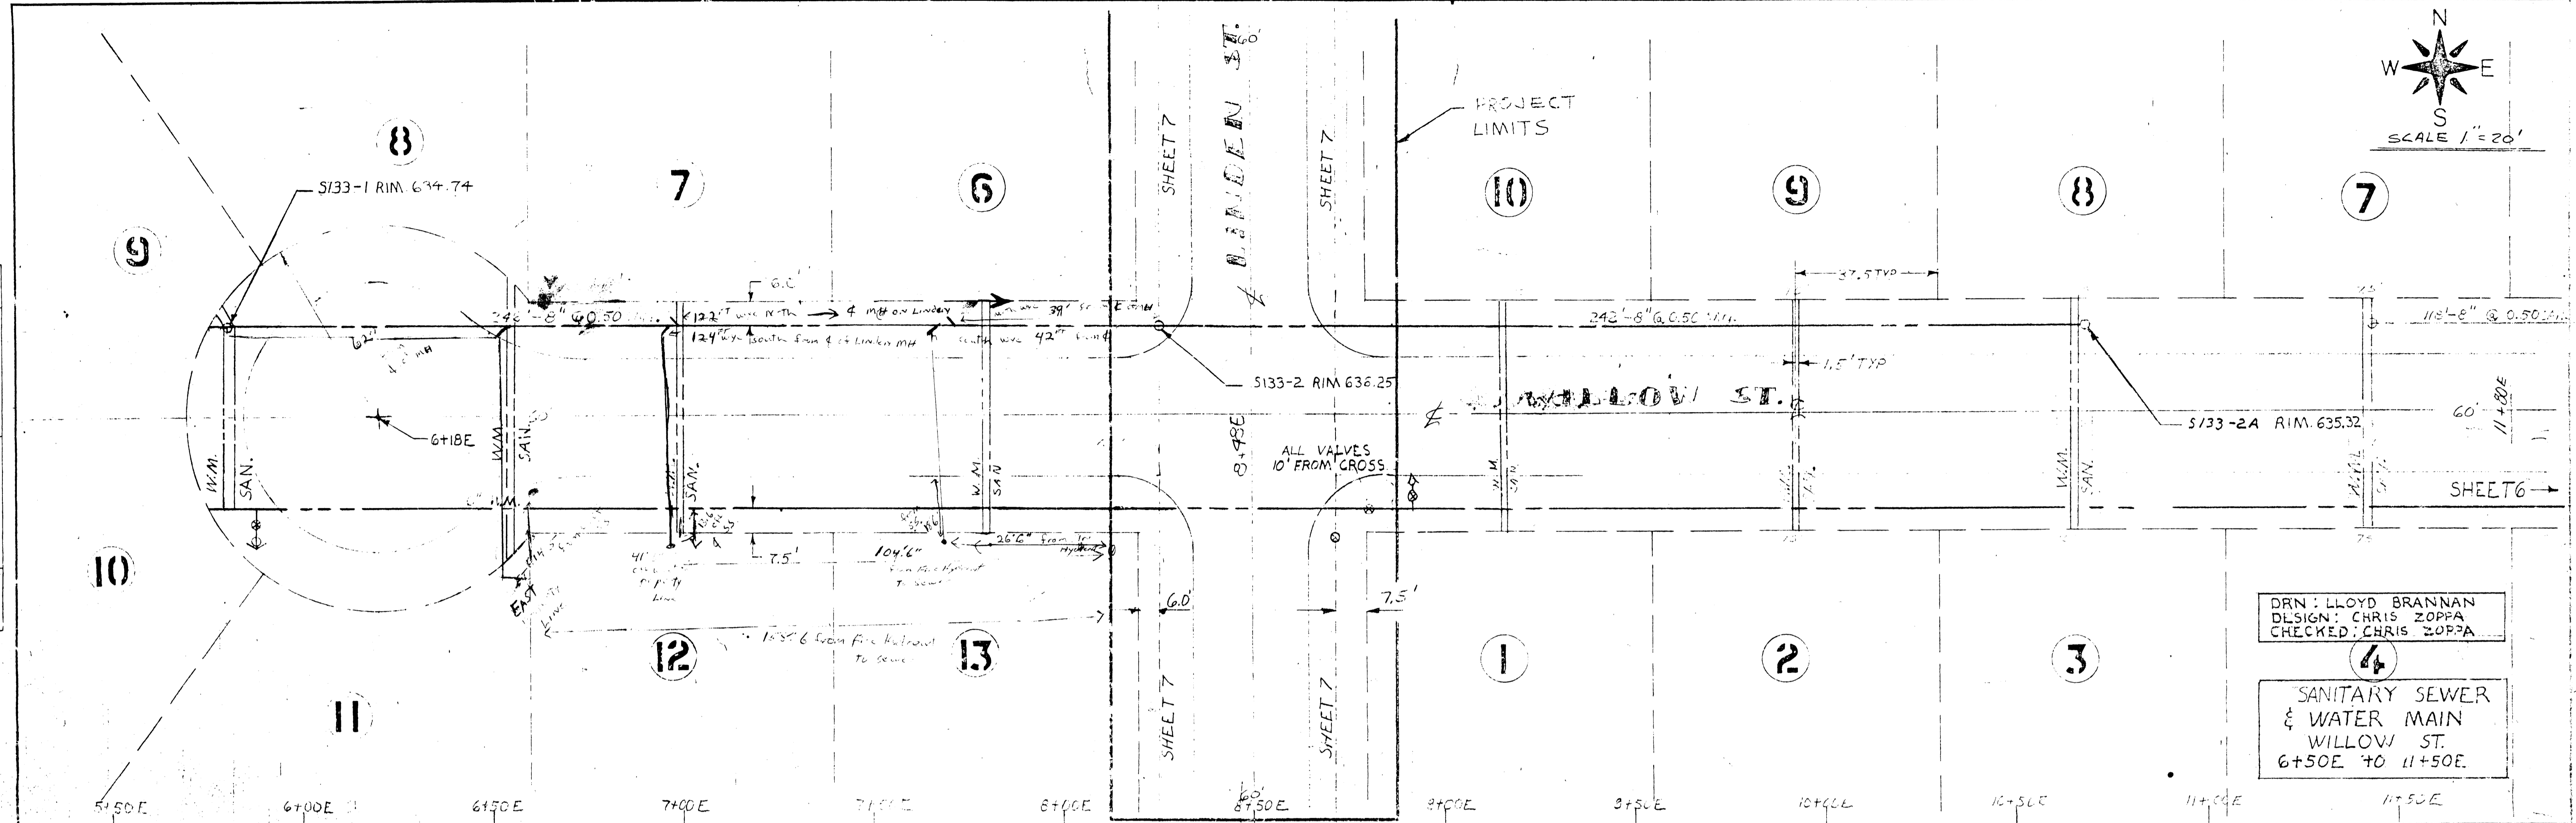


DRN: LLOYD BRANNAN
DESIGN: CHRIS ZOPPA
CHECKED: CHRIS ZOPPA

4
SANITARY SEWER
& WATER MAIN
WILLOW ST.
6+50E TO 11+50E.

DATE _____
BY _____
PROFILE SURVEYED _____
NOTED _____
NOTE BOOK GRADES CHECKED _____
STRUCTURE NOTATIONS CH. NO. _____

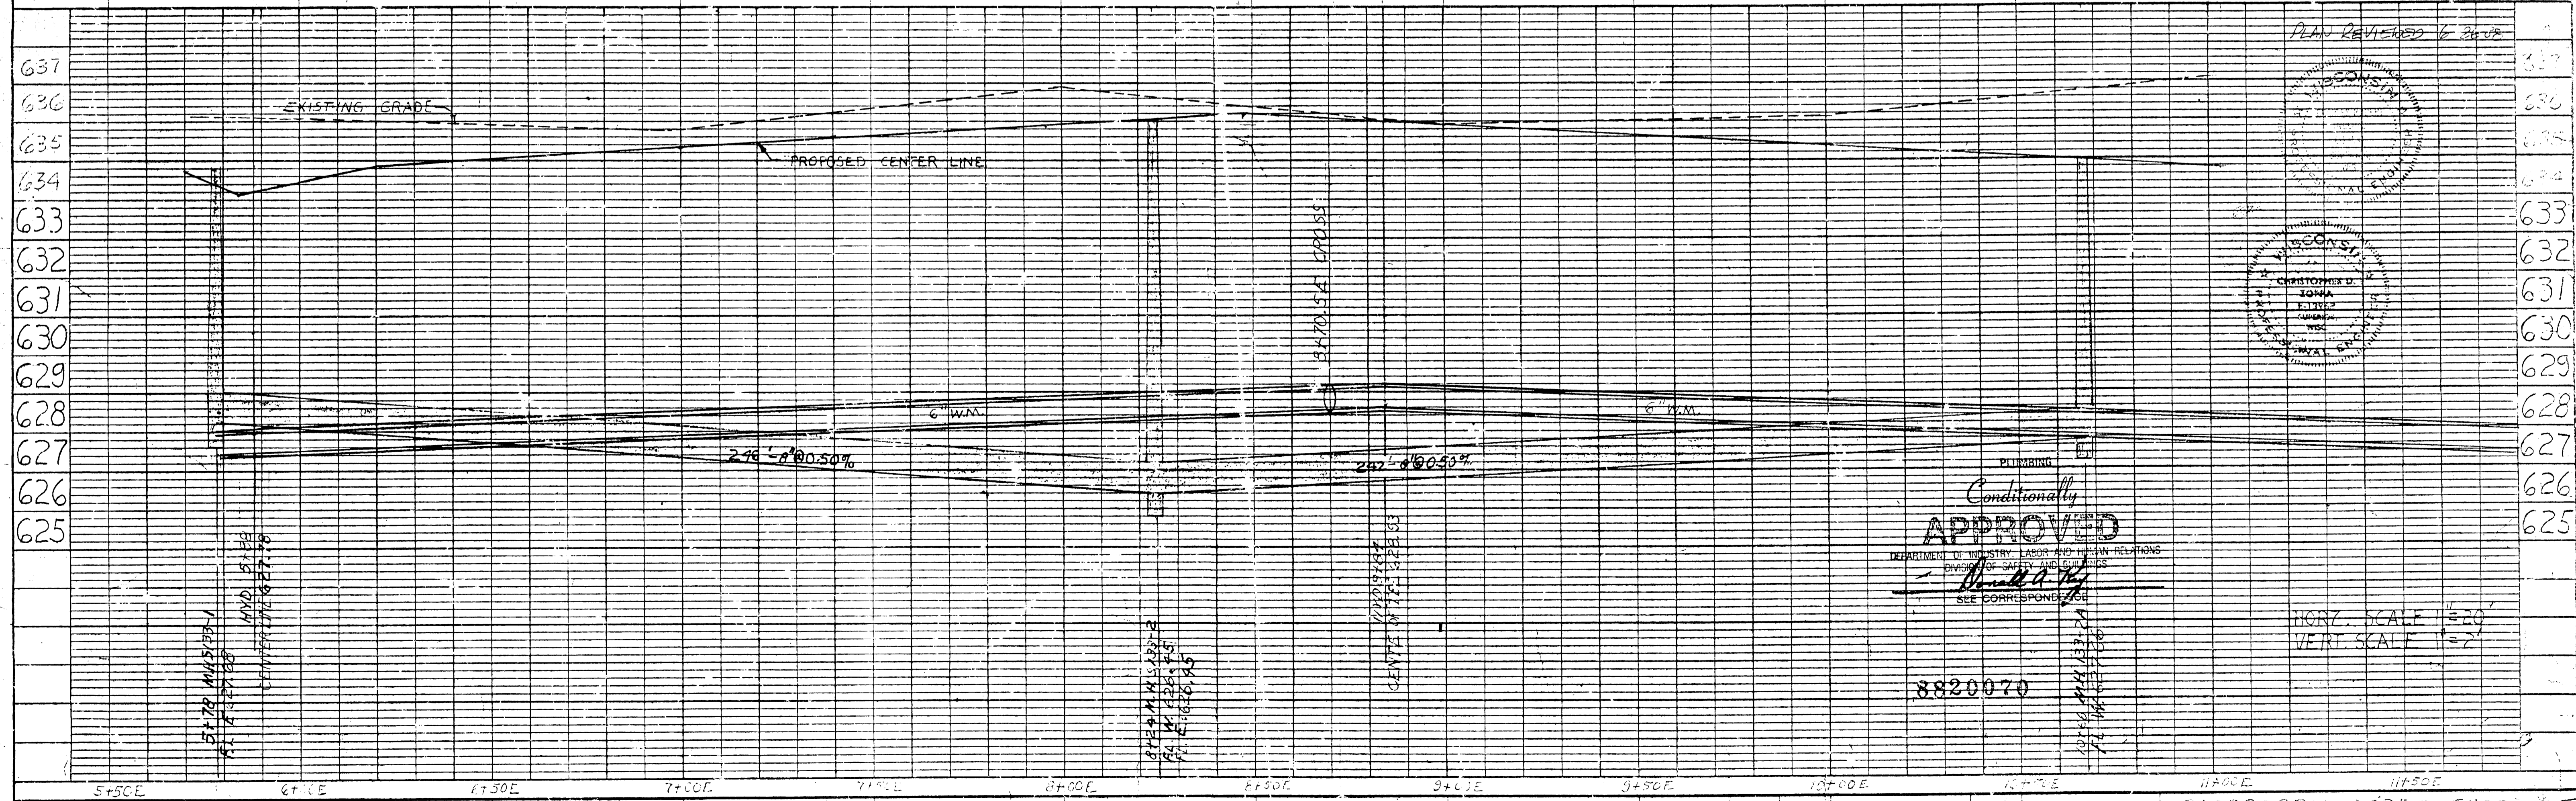

PLUMBING
Conditionally APPROVED
DEPARTMENT OF INDUSTRY, LABOR AND HUMAN RELATIONS
DIVISION OF SAFETY AND HEALTH
Donald A. Taylor
SEE CORRESPONDENCE

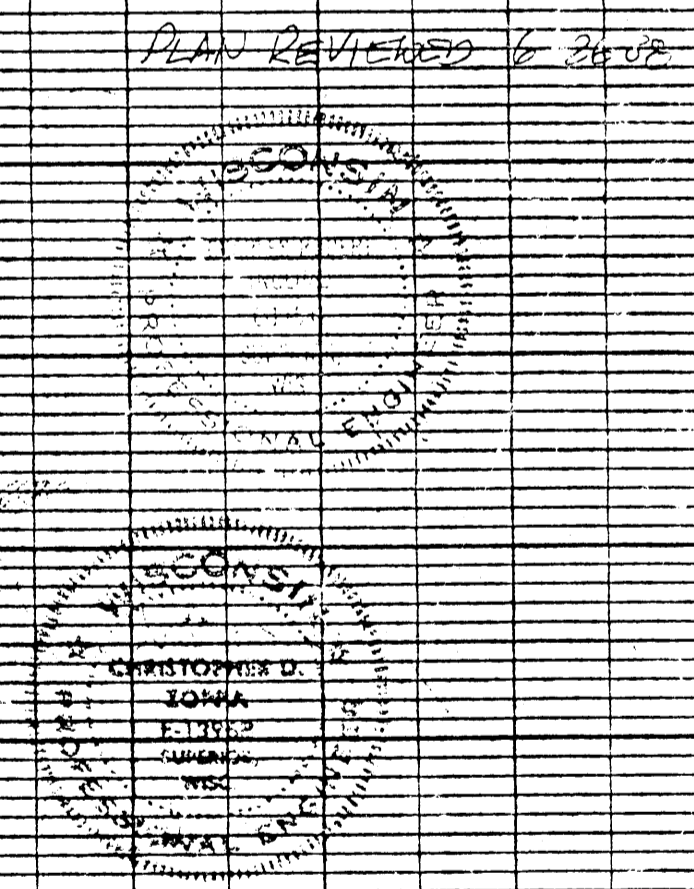

8820070

HORIZ. SCALE 1"=20'
VERT. SCALE 1"=2'