
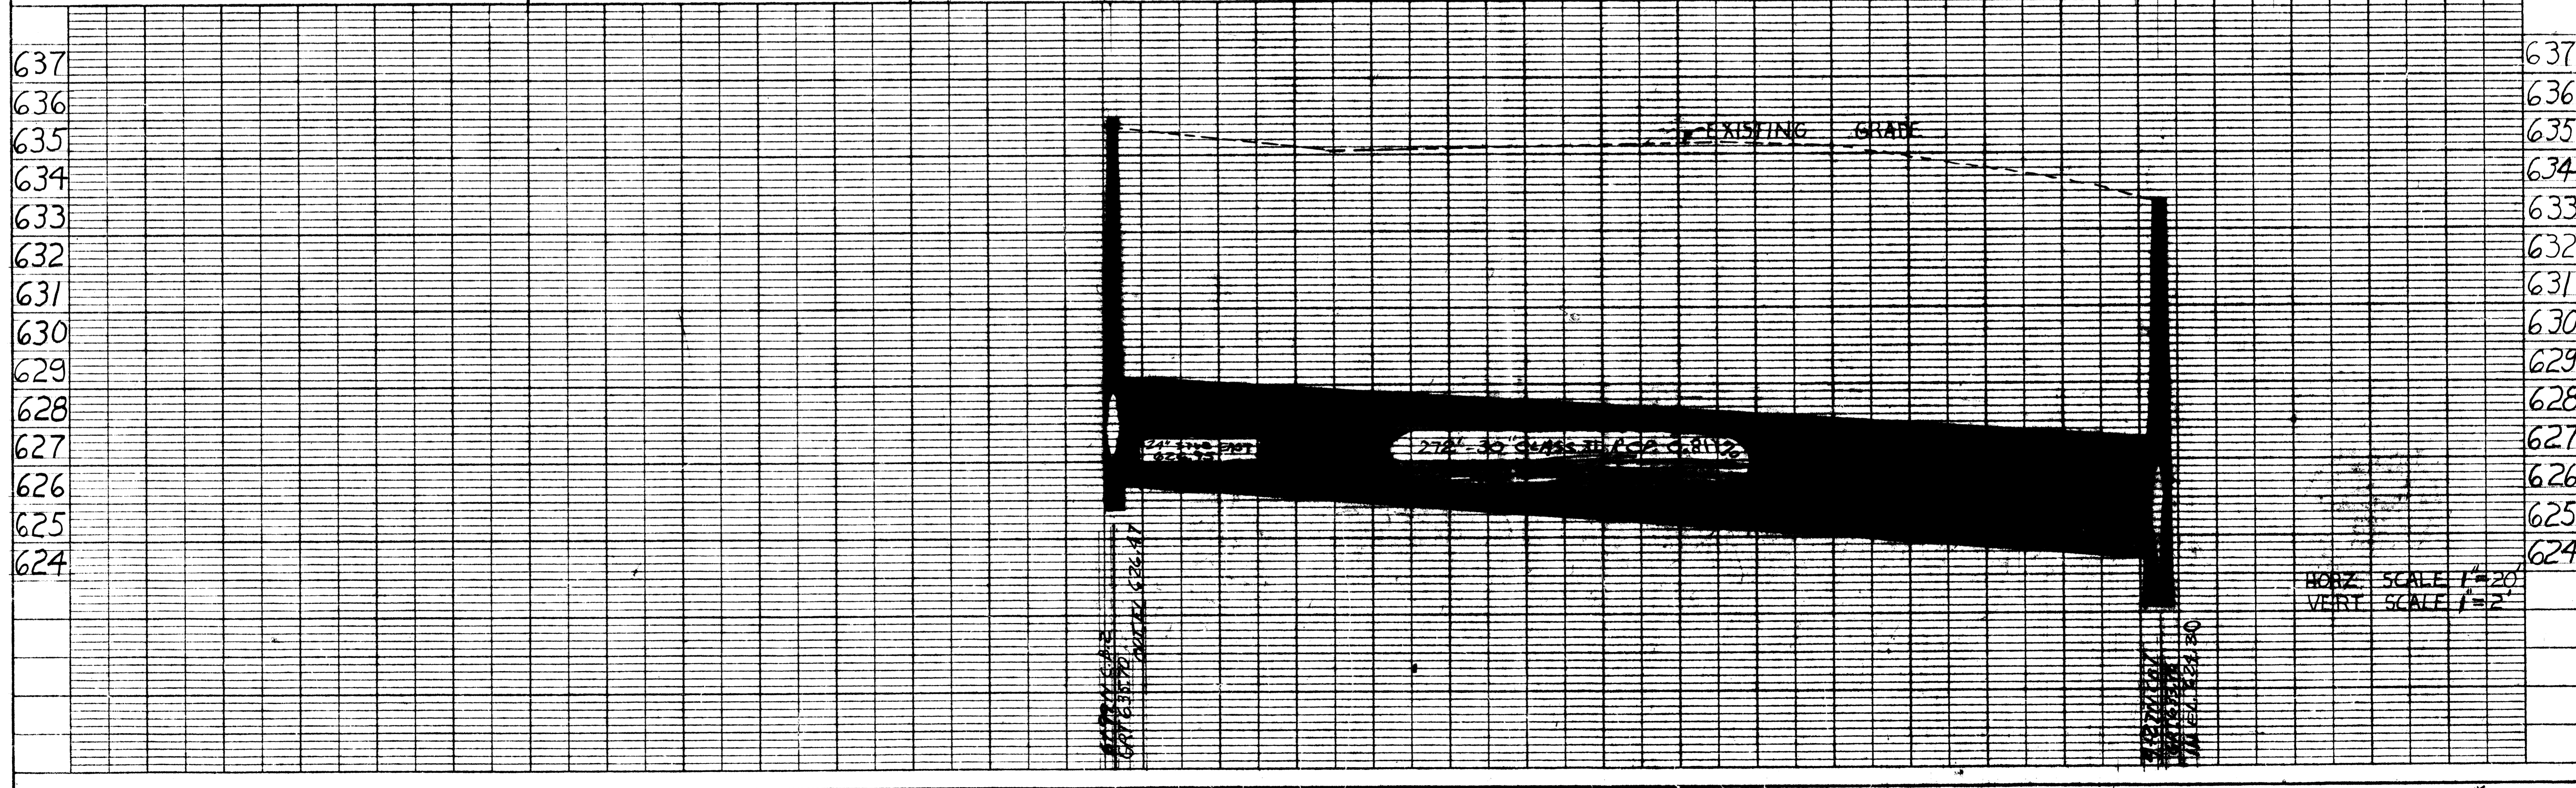


9  
COLOR CODE

PLAN  
NOTE: (9) CORRUGATED ALUMINUM PIPE  
NOTE: (1) C.B. MH #1

PROFILE  
NOTE: (9) CORRUGATED ALUMINUM PIPE  
NOTE: (1) C.B. MH #1

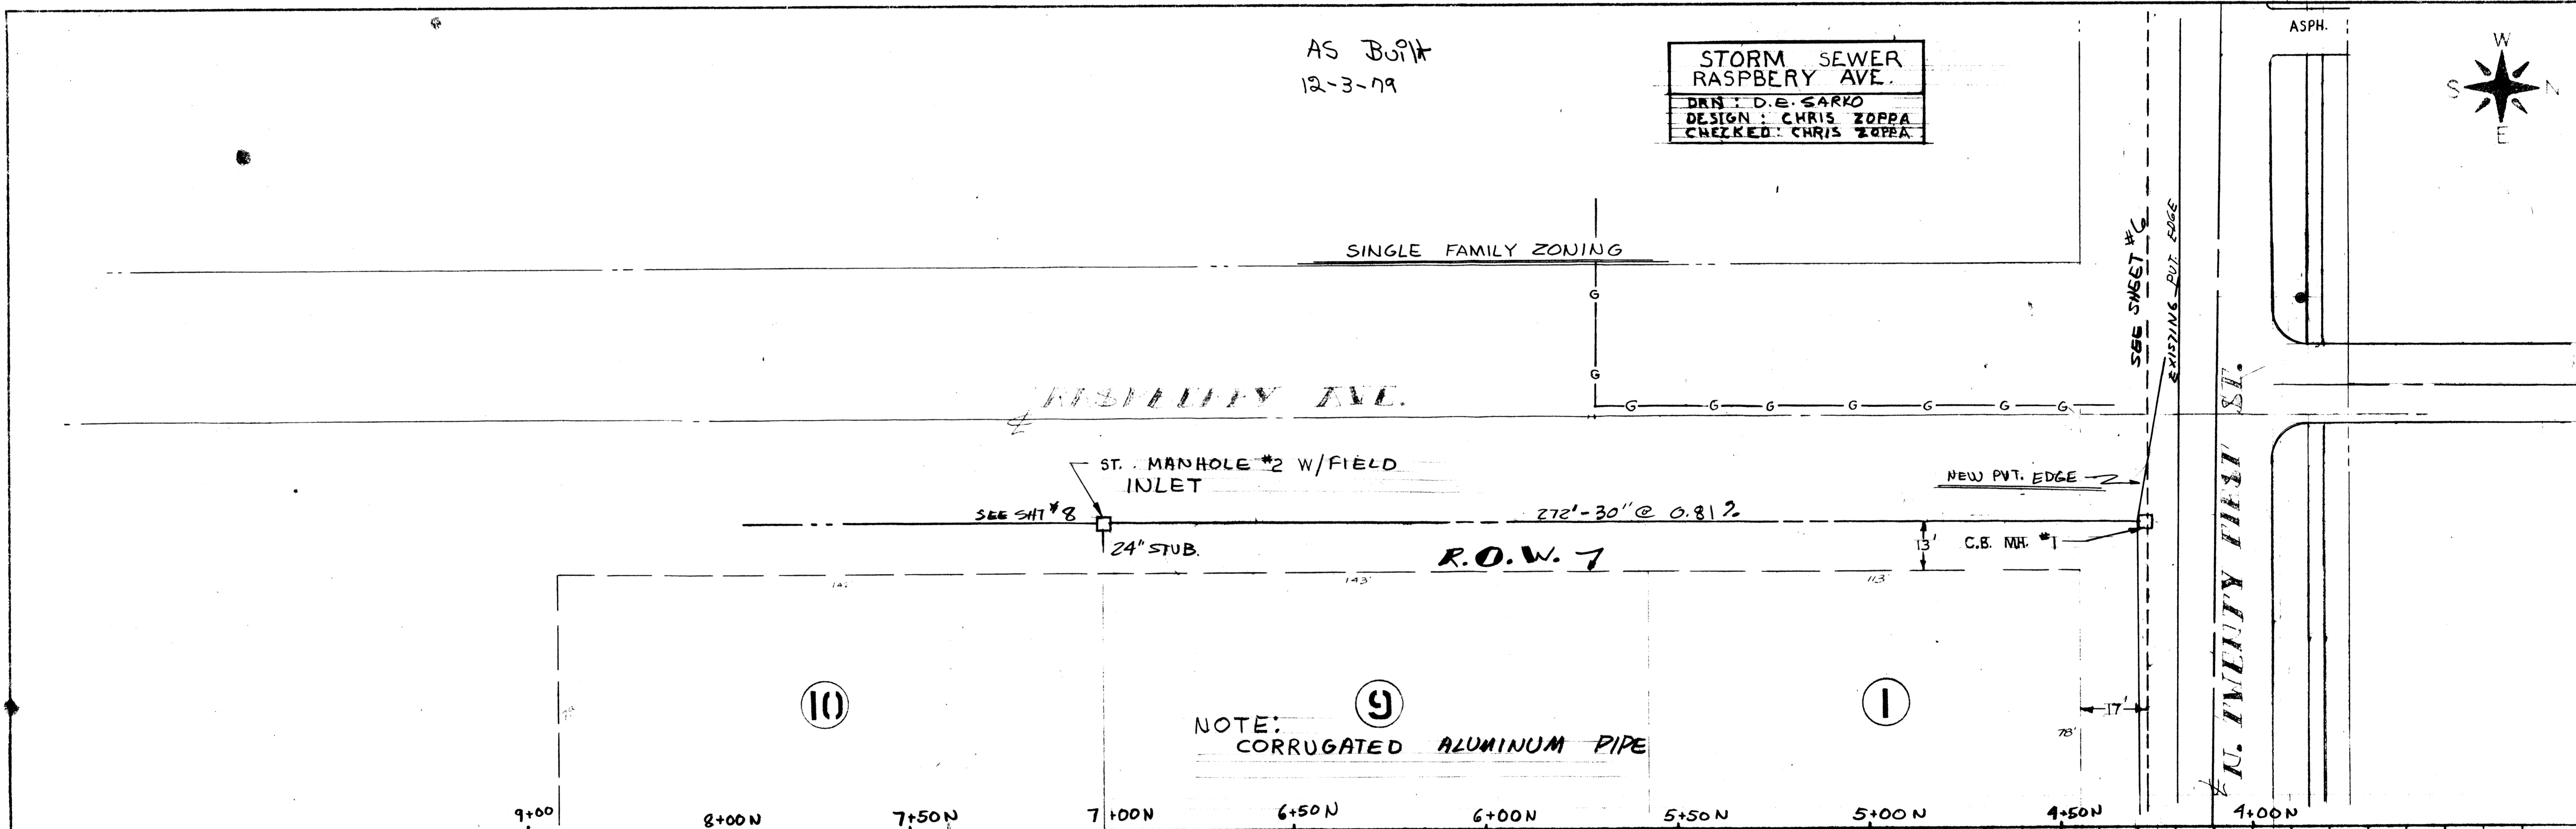

HORIZ. SCALE 1"=20'  
VERT. SCALE 1"=2'