

STORM SEWER EXTENSION

DRN. D.E. SARKO
DES. C. ZOPPA
CHK'D. C. ZOPPA
DATE: 4-17-79

As Built
12-2-79

N 23RD ST.

FAYON AVE.

RASPBERRY AVE.

ST. M.H. #4
WITH FIELD INLET

ST. M.H. #3 WITH FIELD INLET
SEE SHEET # 7

330'-27" @ 0.31%

R.O.W.


SEE SHEET # 9

SEE SHEET # 7

14+50N 14+00N 13+50N 13+00N 12+50N 12+00N 11+50N 11+00N 10+50N 10+00N

637
636
635
637
636
635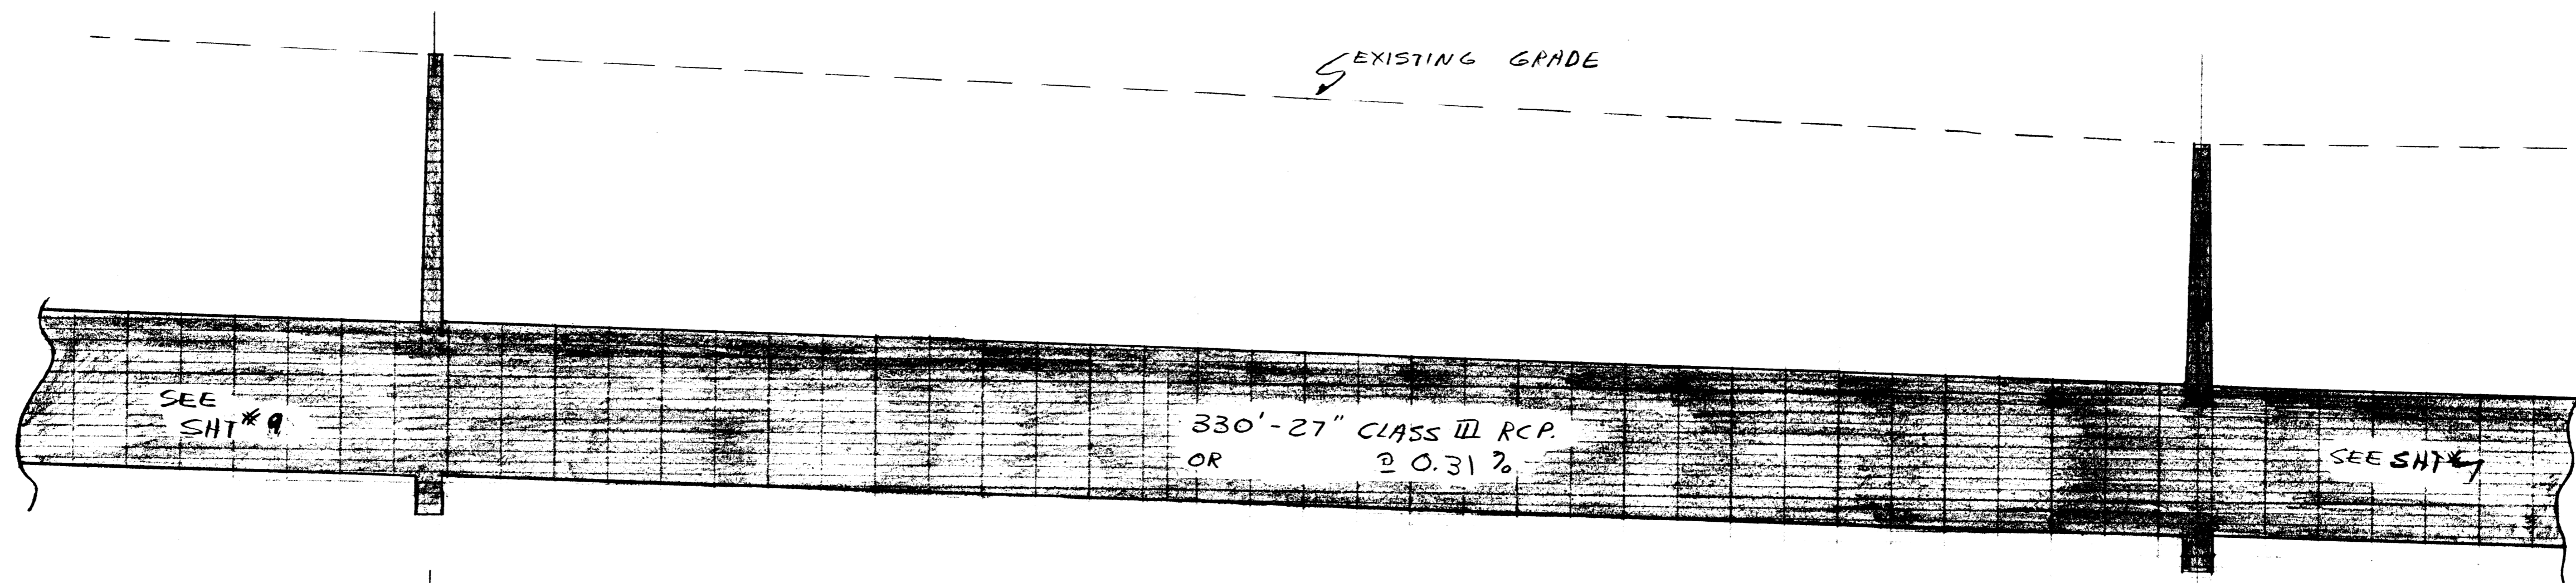
SEE SHEET # 9

SEE SHEET # 7

13+03 C.B. 4
GRT. 637.0
OUT EL. 629.19

10+53 C.B. 3
GRT. 635.7
OUT EL. 628.15

HORZ. SCALE 1"=20'
VERT. SCALE 1"=2'