


As Bldg
12-2-13

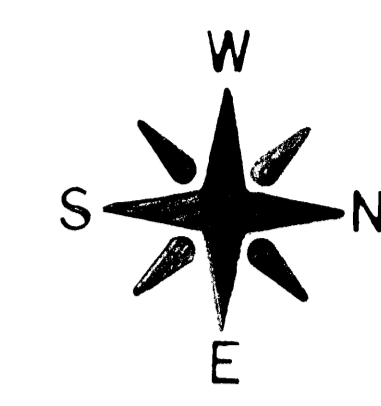

**STORM SEWER
EXTENSION**
DRN: D.E. SARKO
DES: C. ZOPPA
CHK'D: C. ZOPPA
DATE: 4-17-79

SEE SHEET #10

N 24th ST.

AV. 23RD ST.

RASPBERRY AVE.

ST. M.H. #5 W/FIELD

ST. M.H. #4 W/FIELD
INLET

SEE SHEET #8

8'-7 1/2" 21" STUB
BRACKET AT
A. ENP


370'-27" @ 0.28%

R.O.W.

13'

639
638
637
639
638
637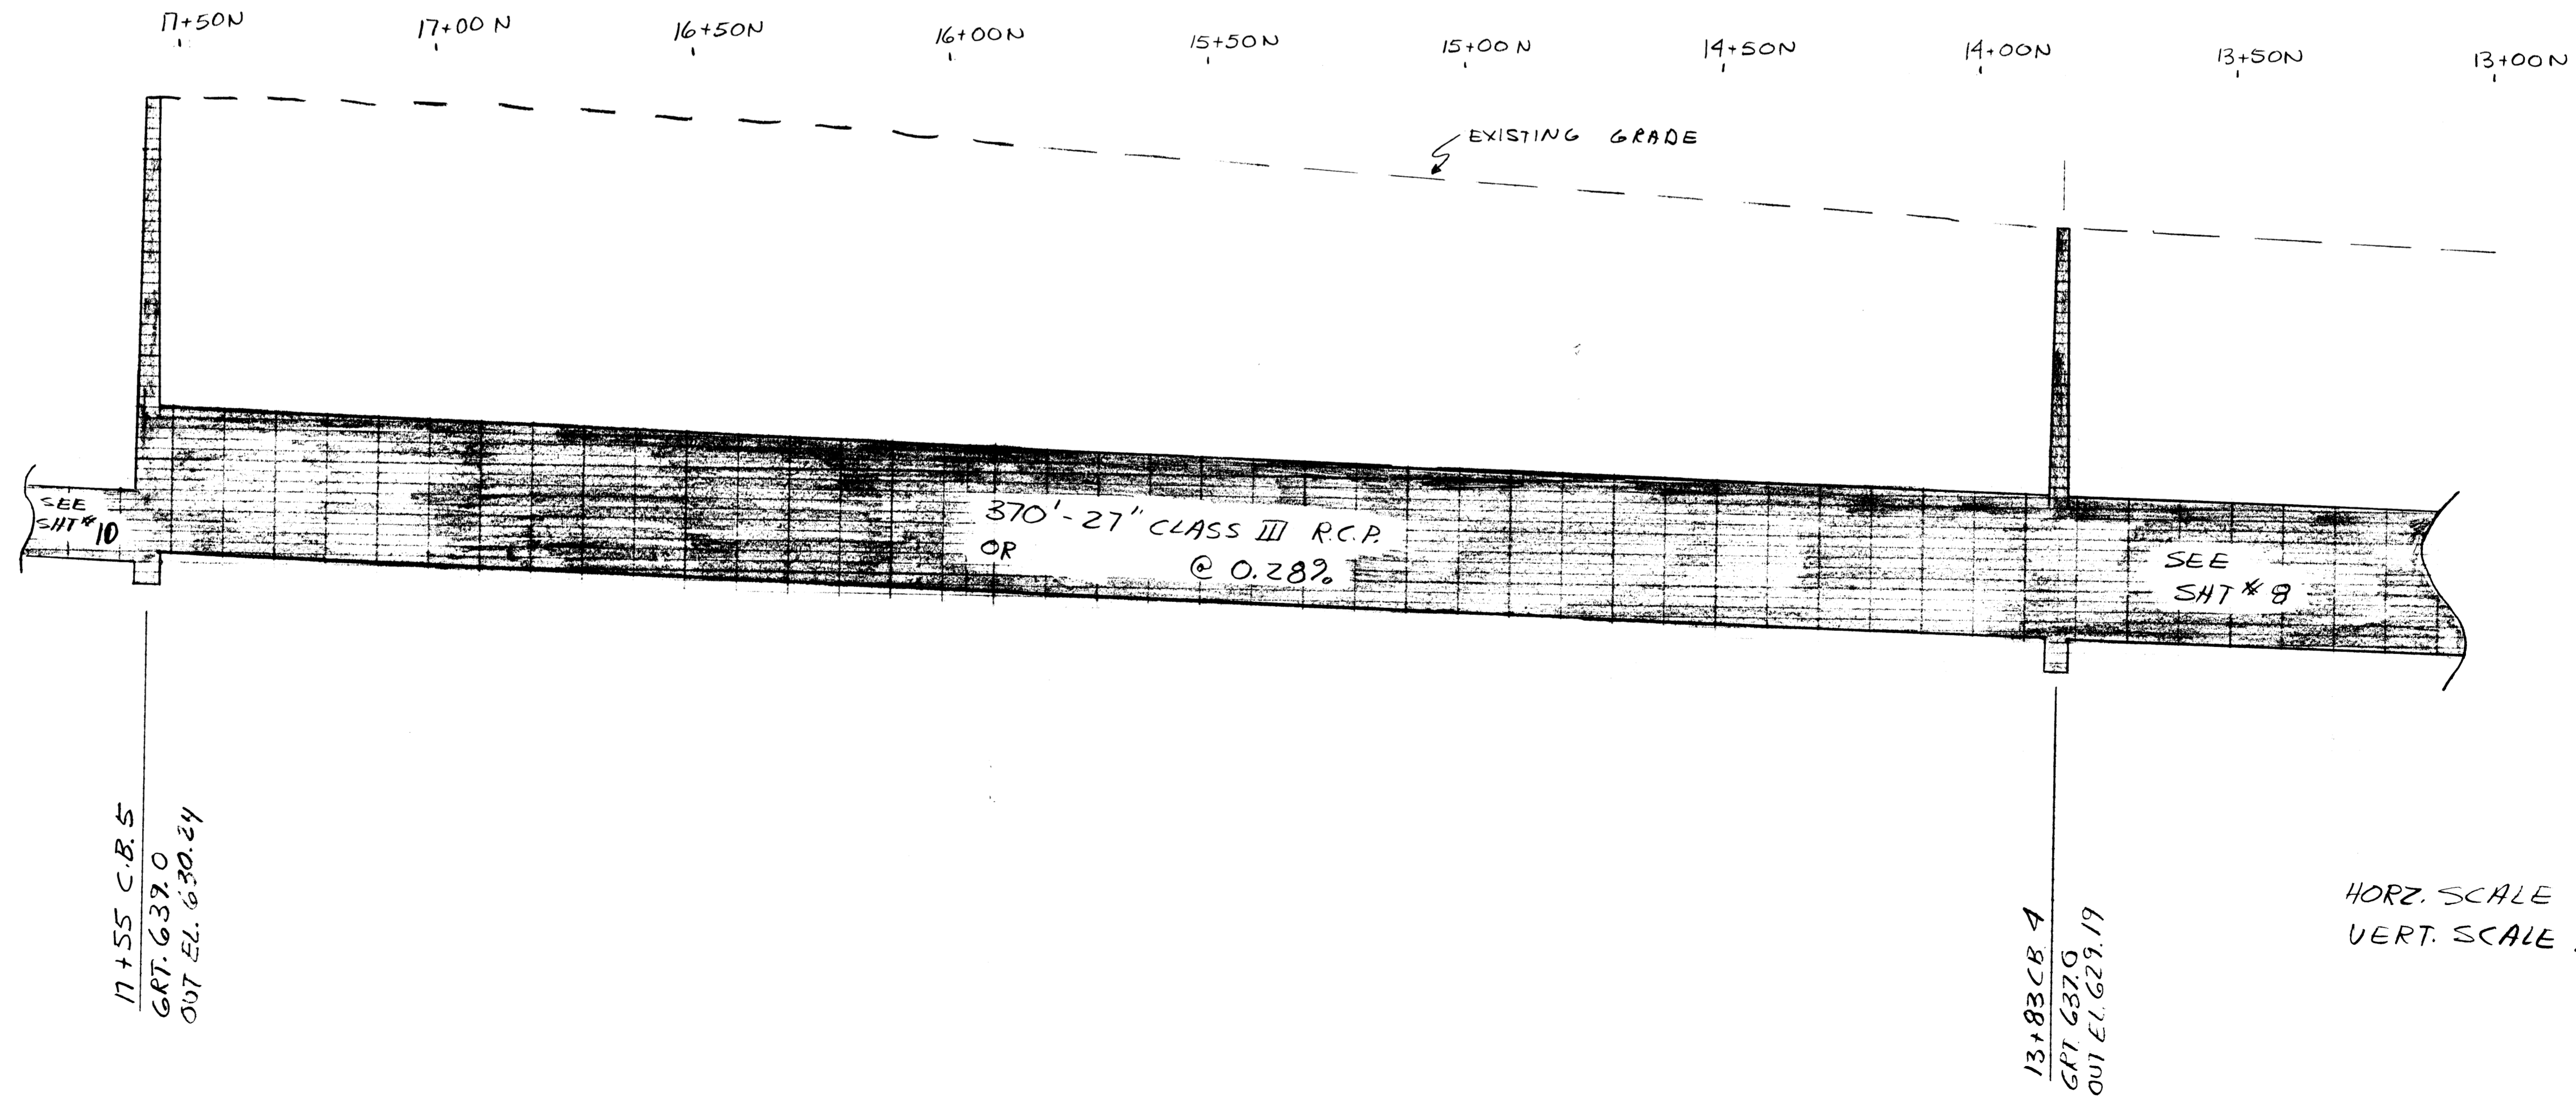
17+55 C.B. 5
GRT. 637.0
OUT EL. 630.24

13+83 C.B. 4
GRT. 637.0
OUT EL. 629.19

HORZ. SCALE 1"=20'
VERT. SCALE 1"=2'