

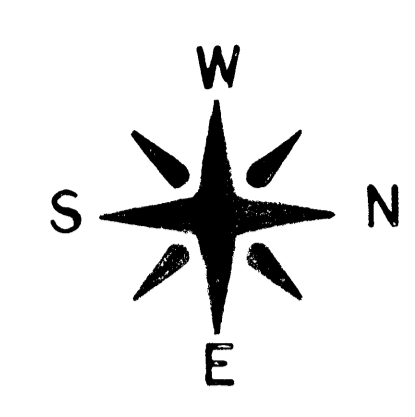


AC EUILT
10-2-79

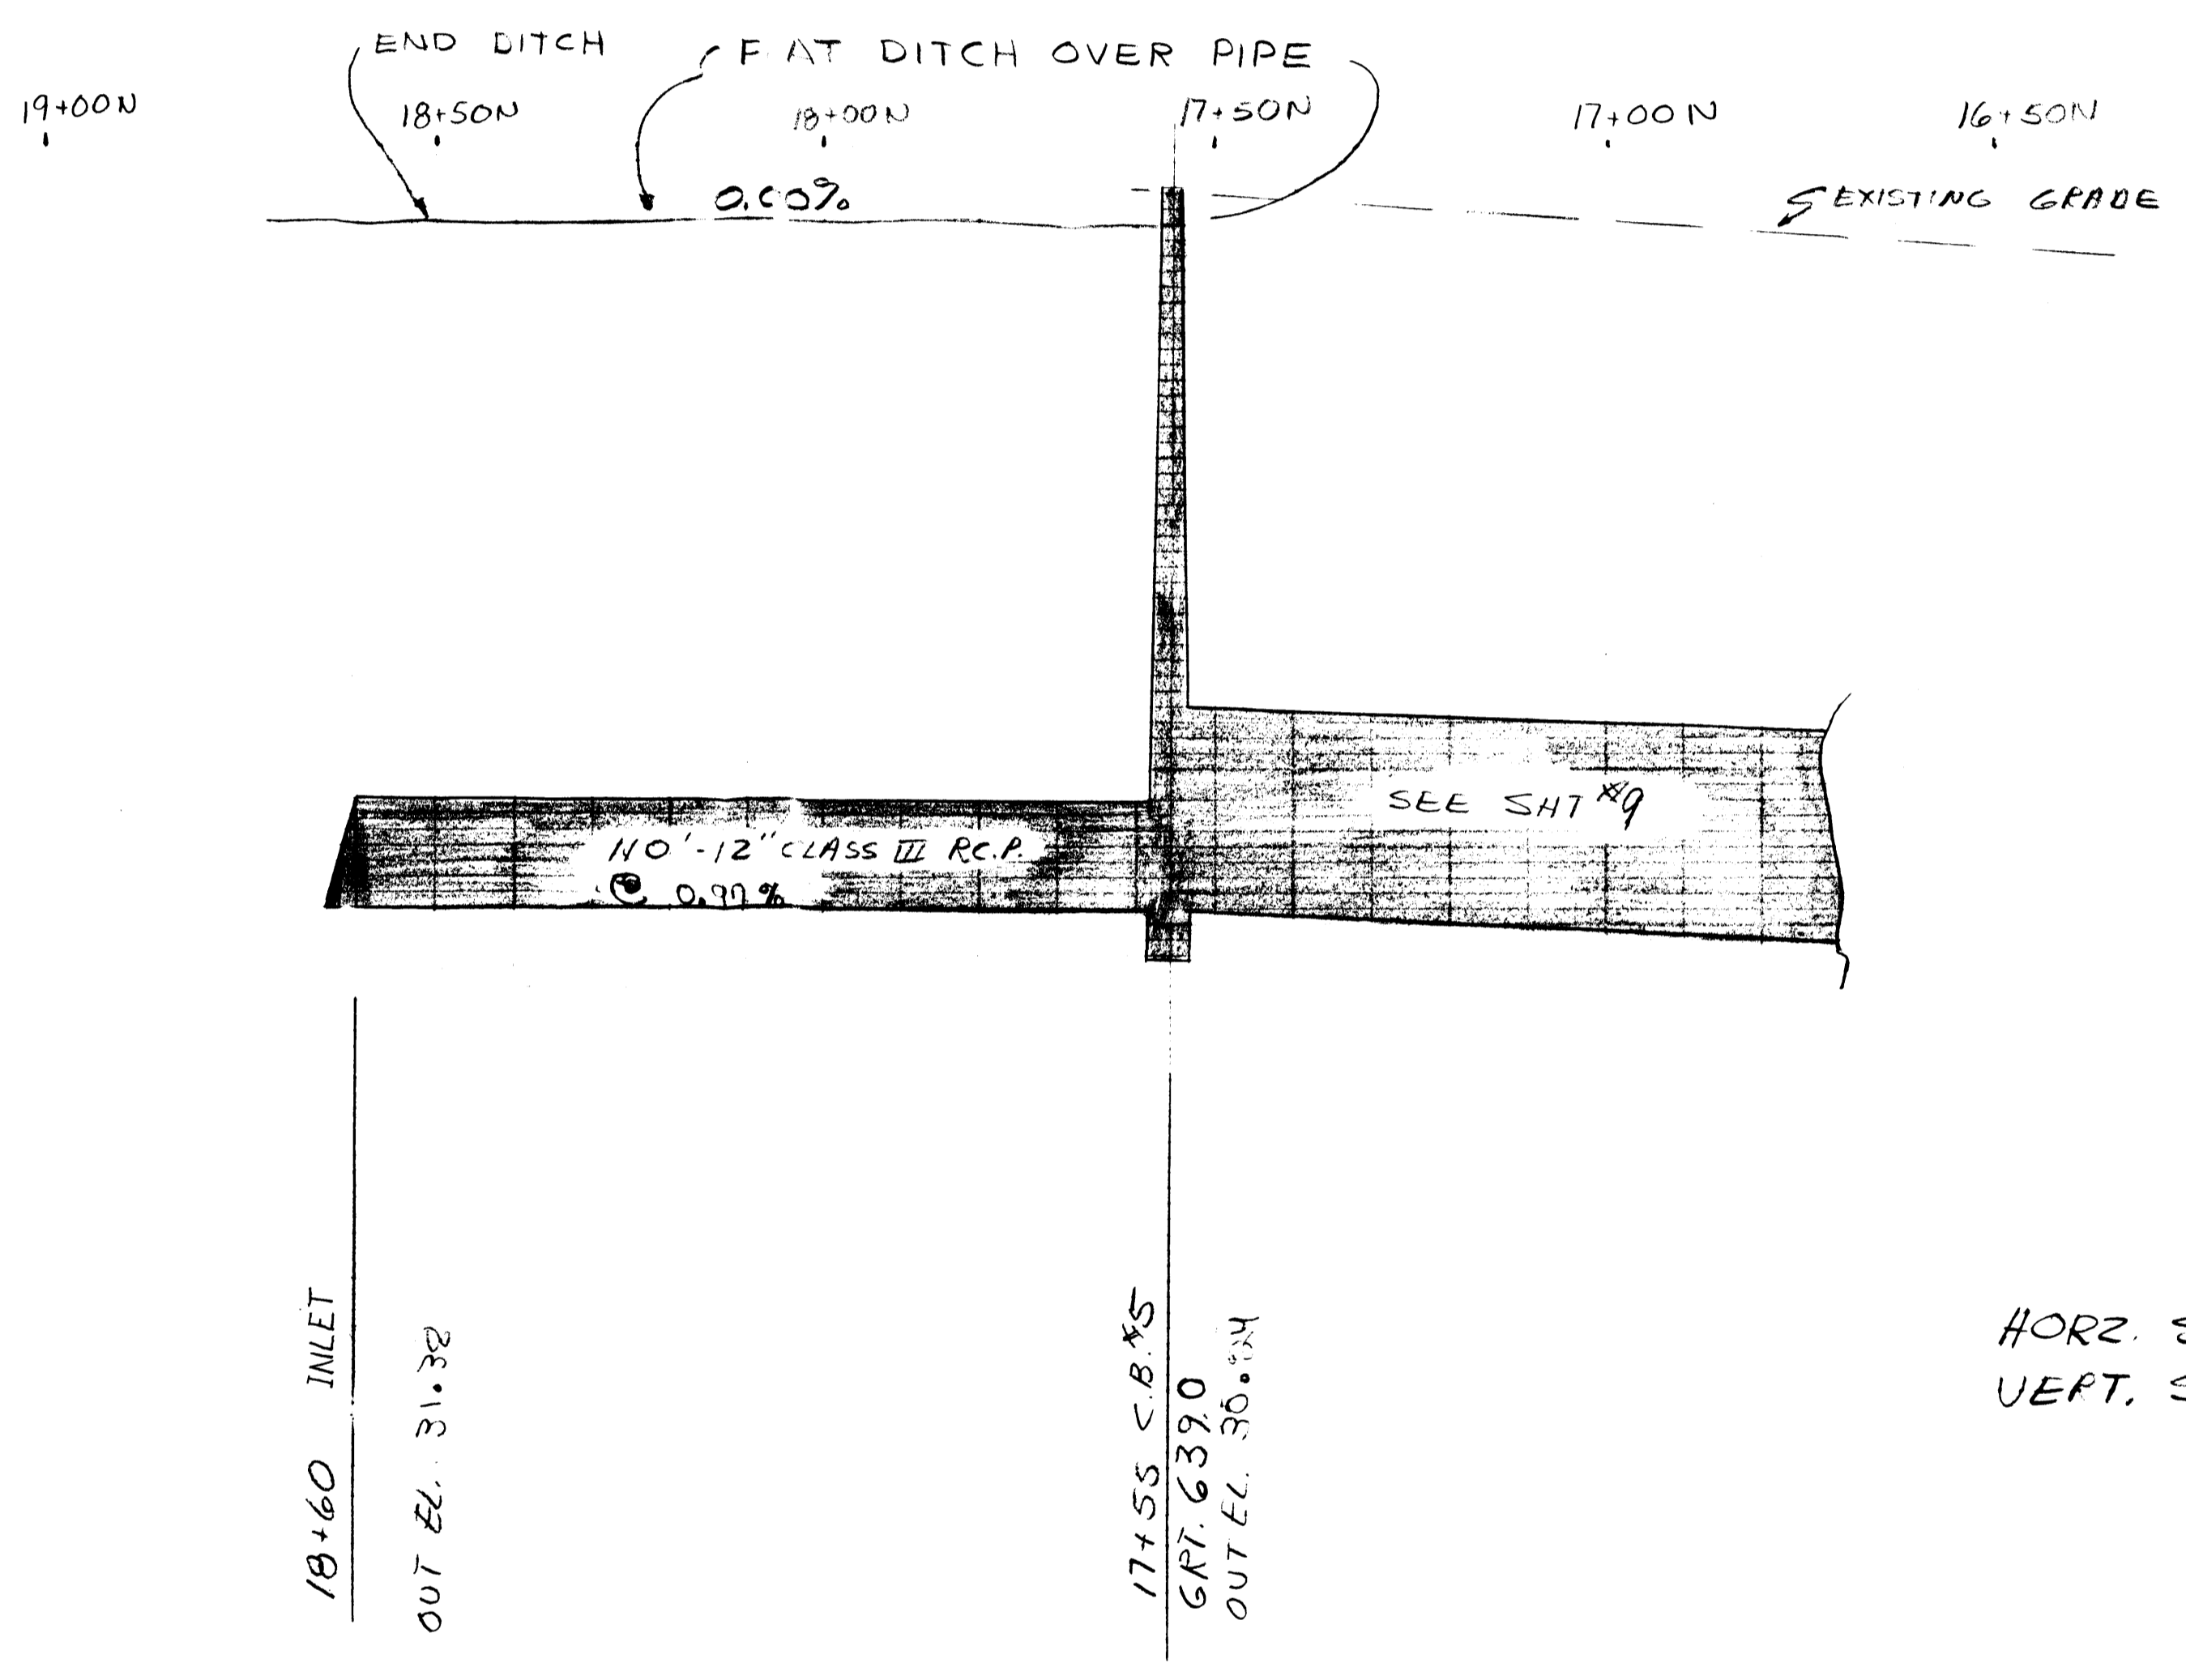

**STORM SEWER
EXTENSION**
DRN. D.E. SARCO
DES. C. ZOPPA
CHK'D. C. ZOPPA
DATE. 4-17-79

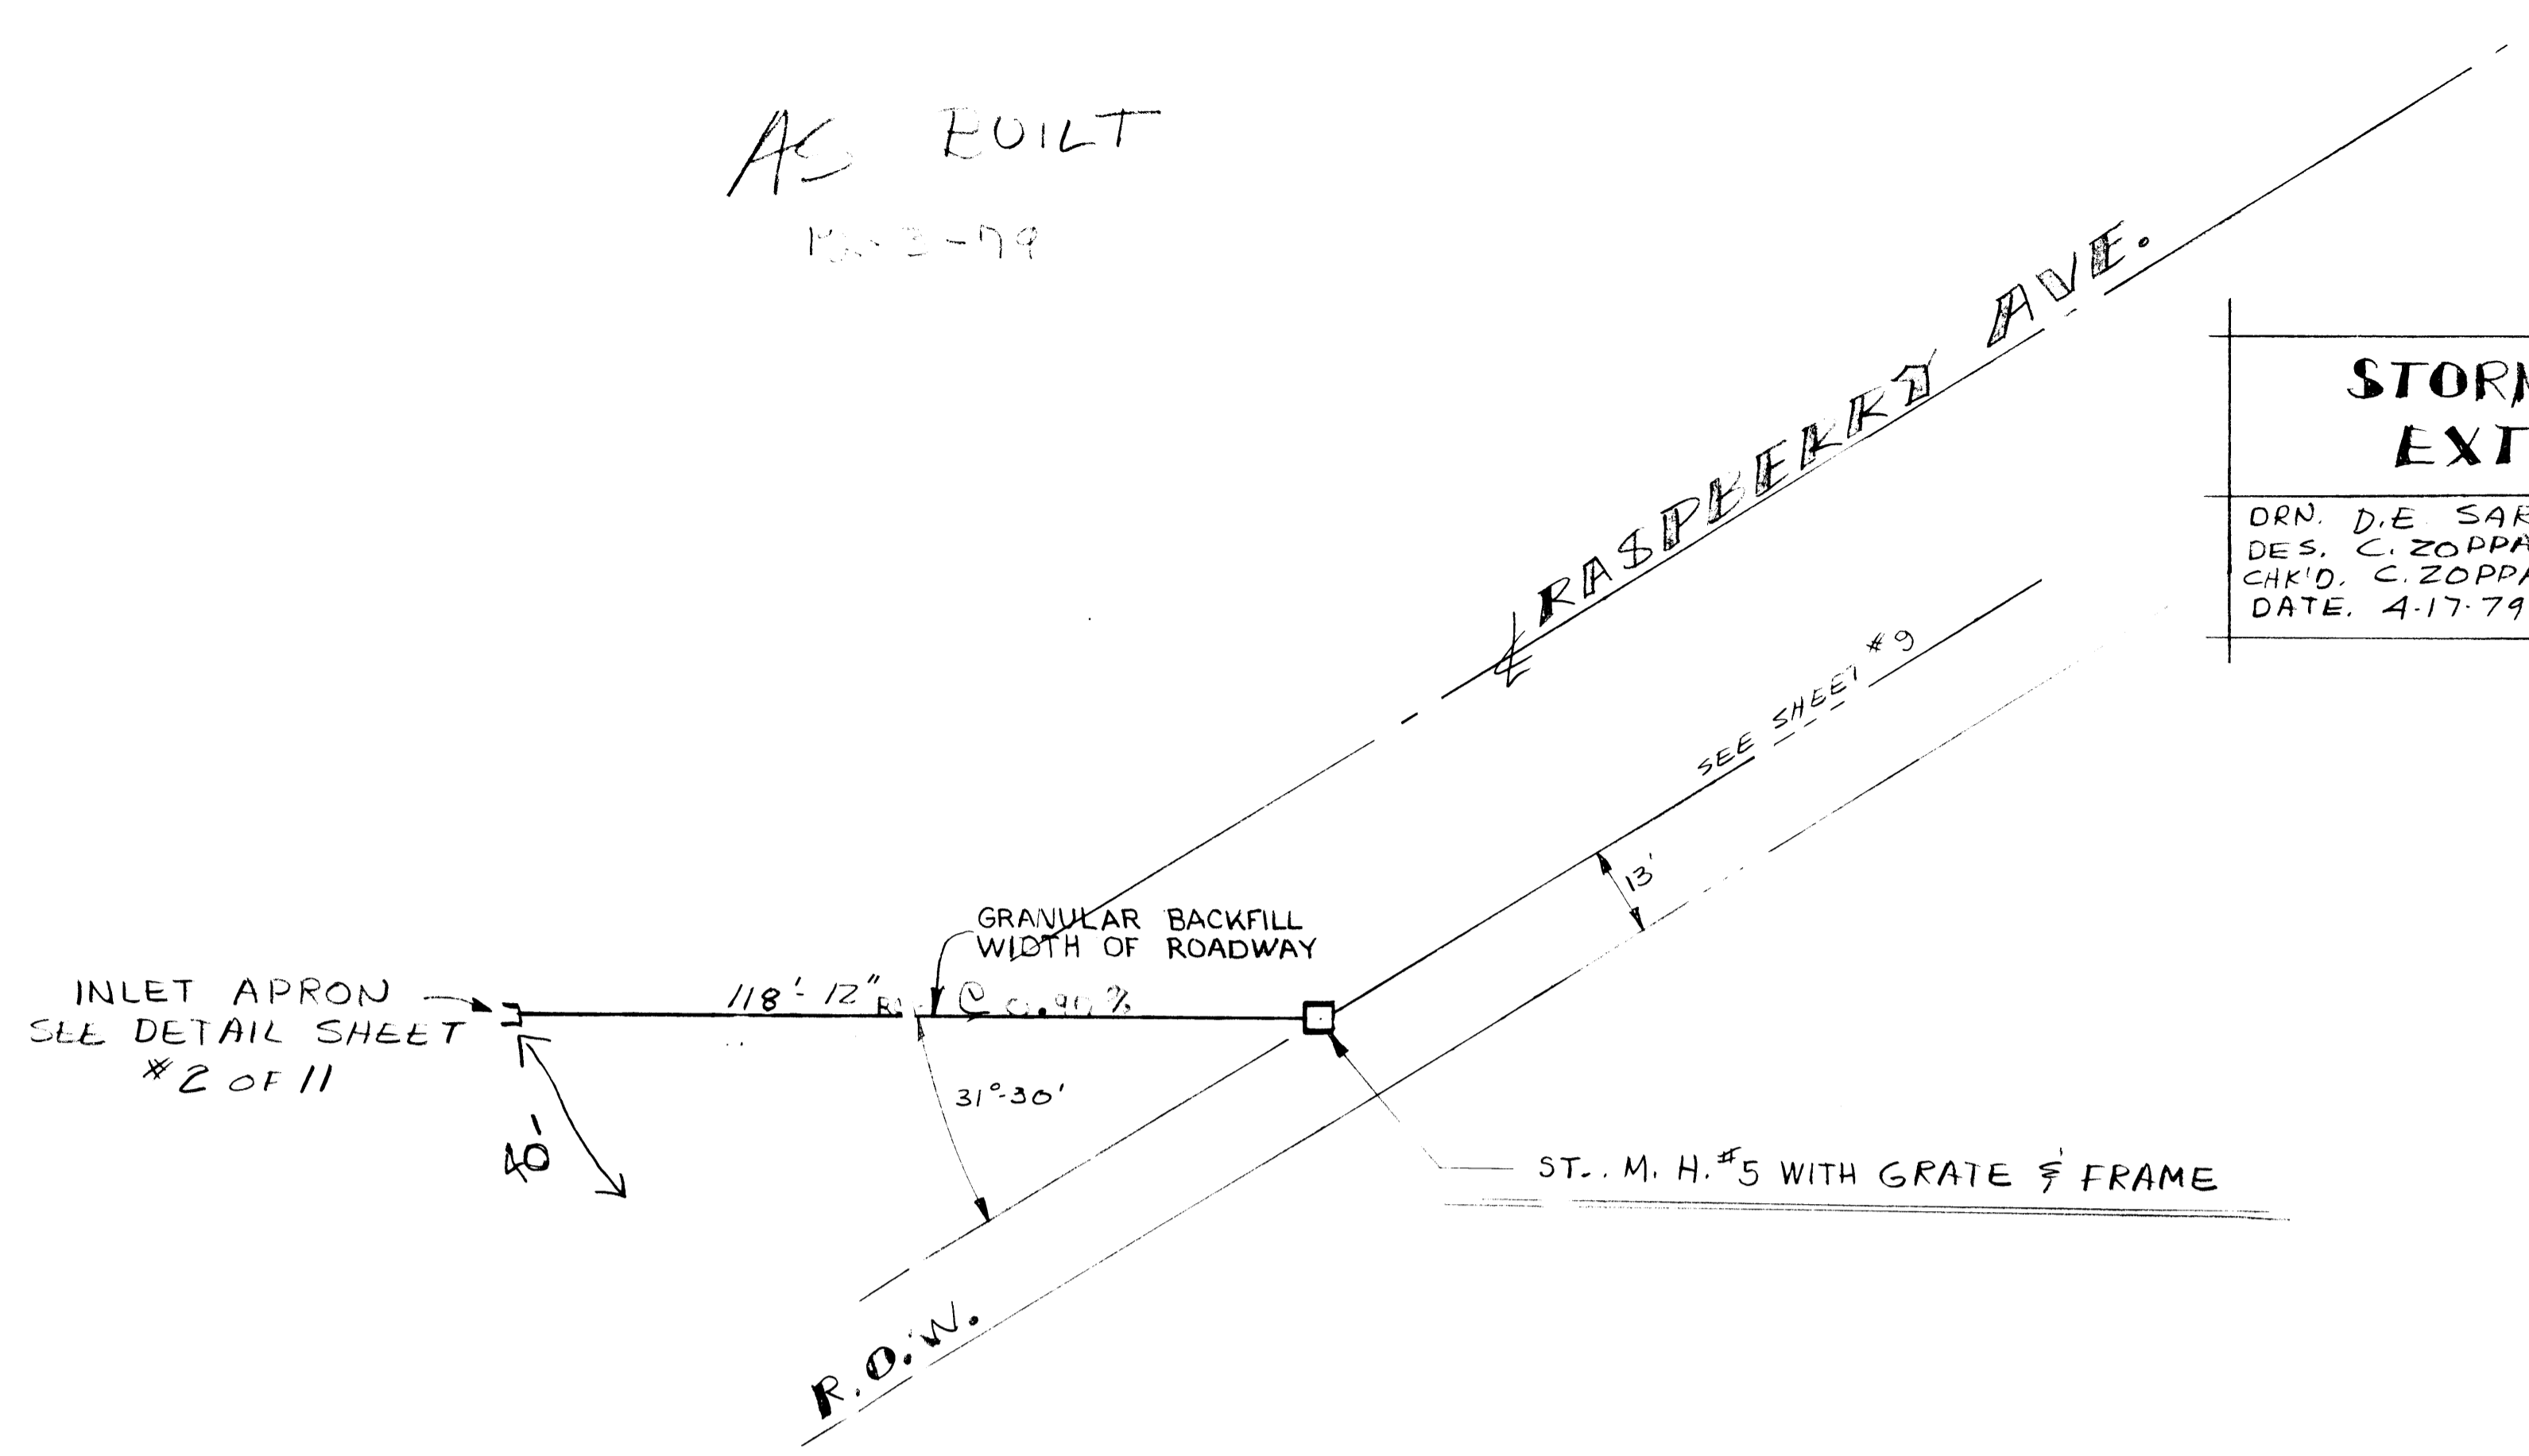

HORZ. SCALE 1" = 20'
VERT. SCALE 1" = 2'

639
638
637
639
638
637
624