

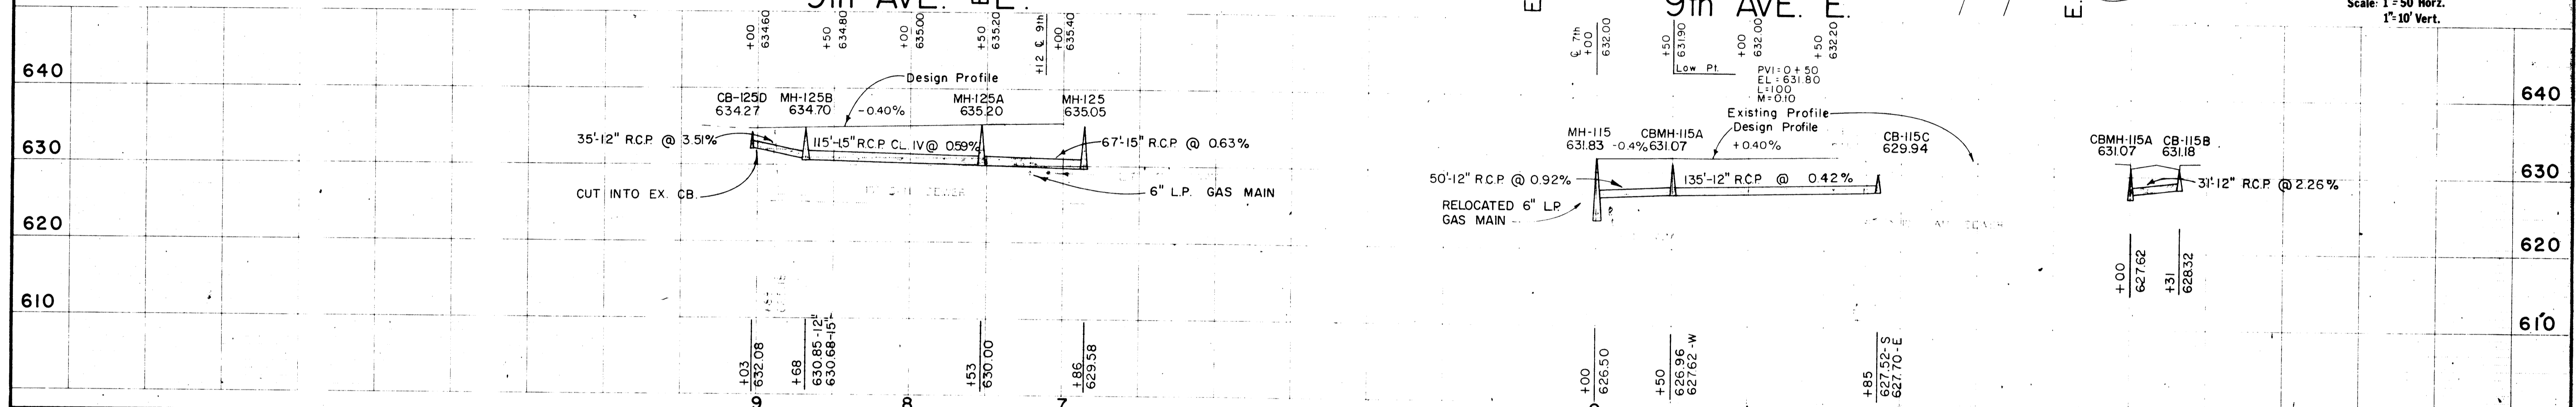
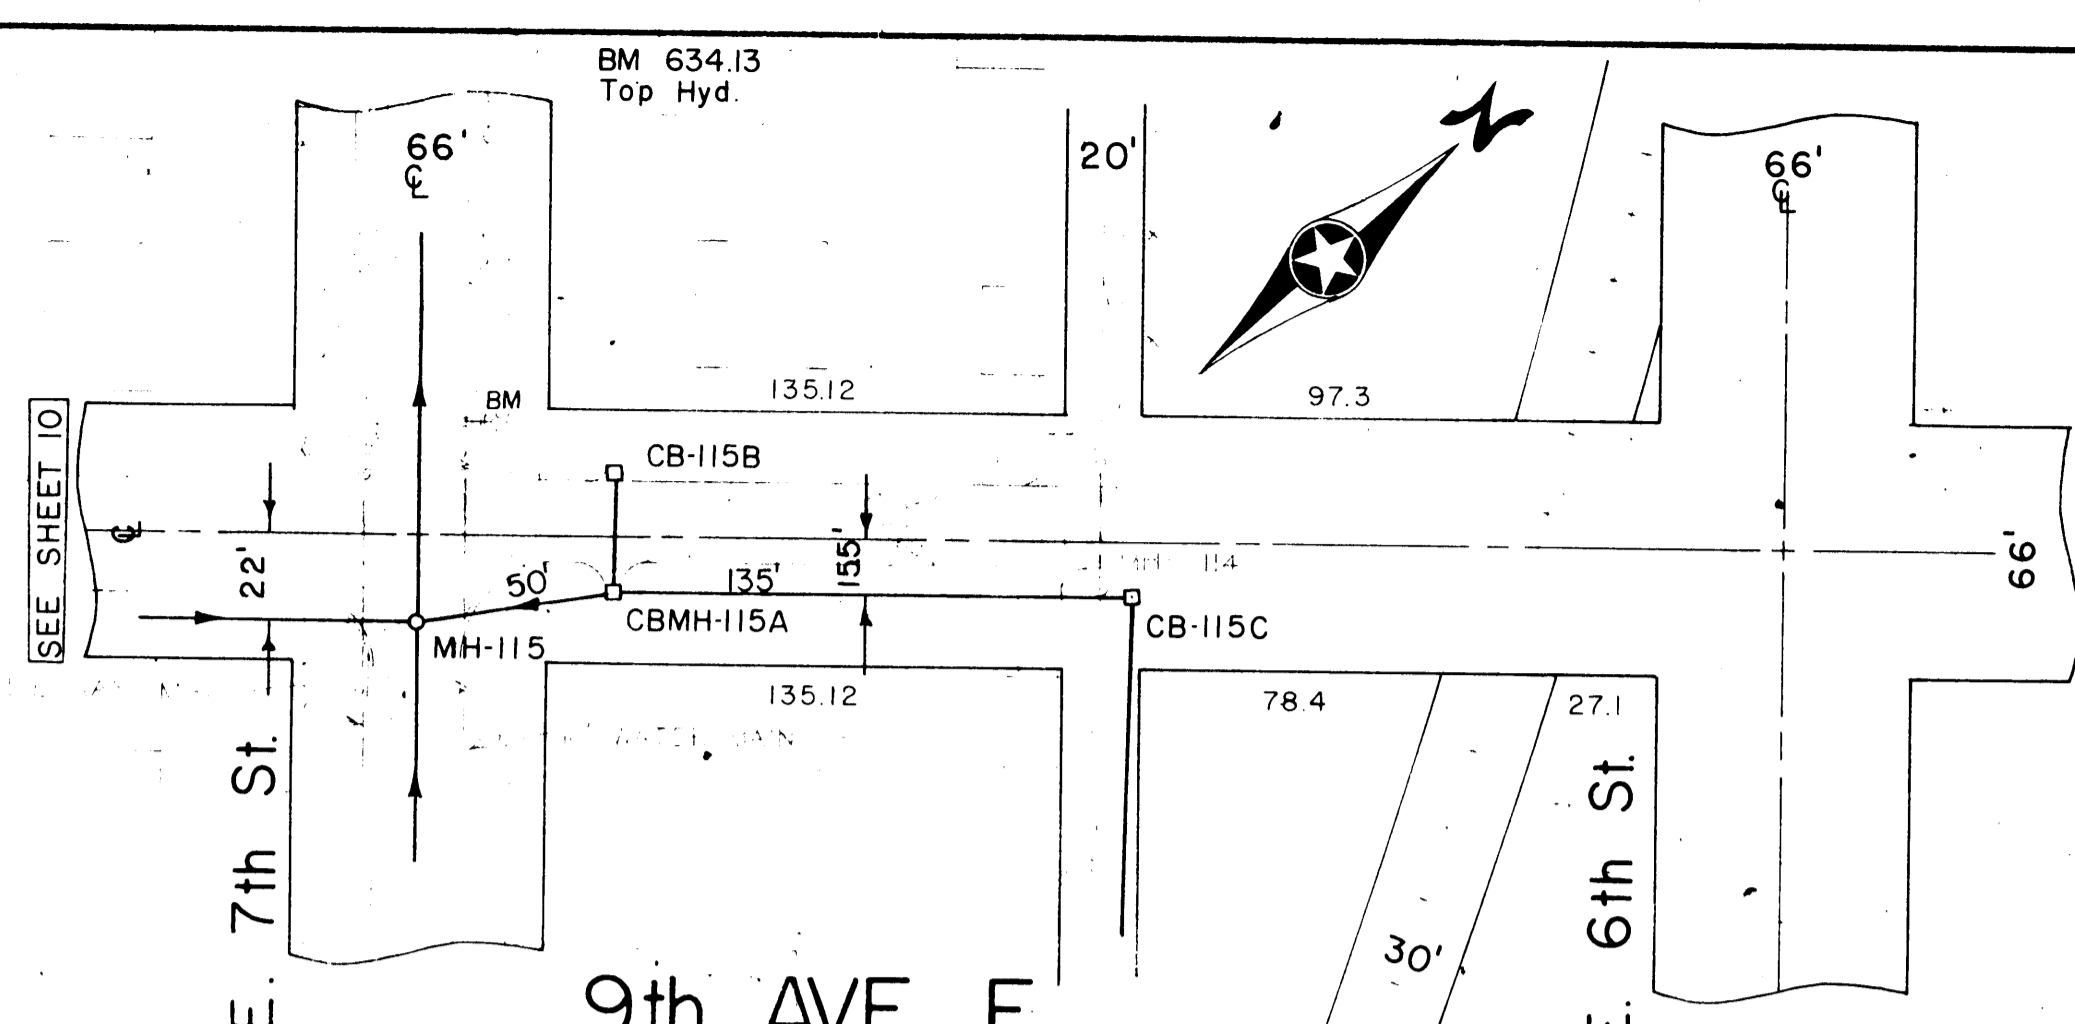
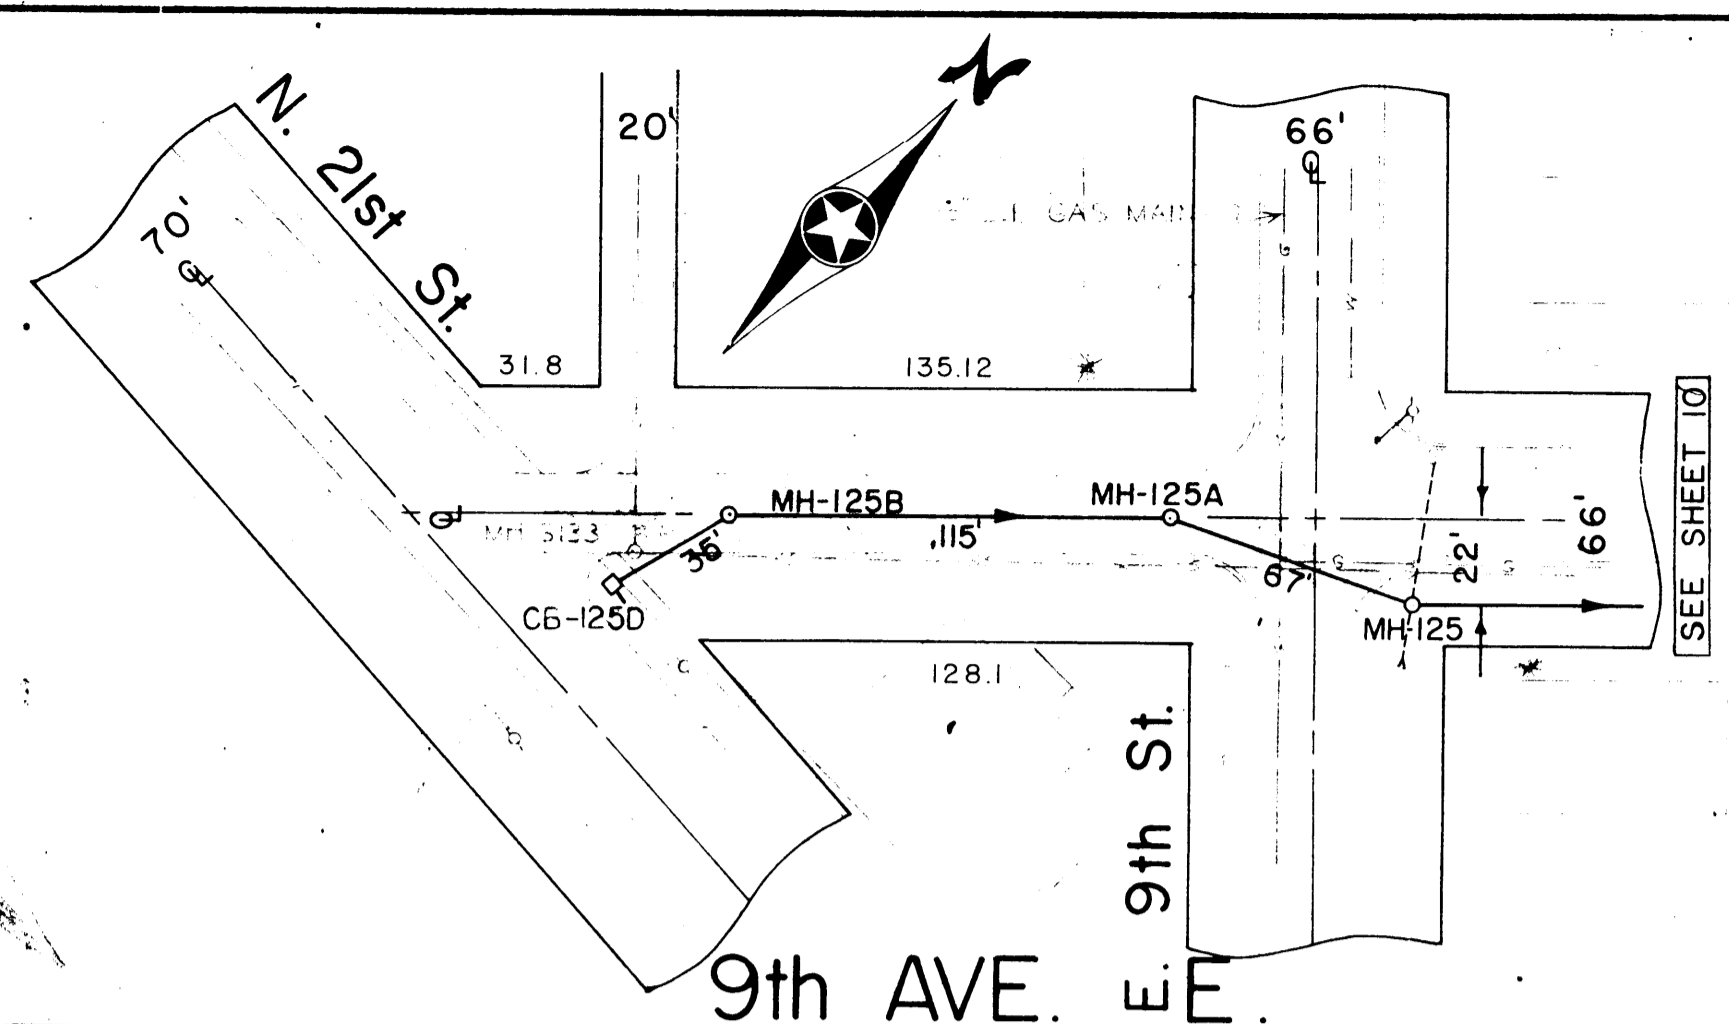
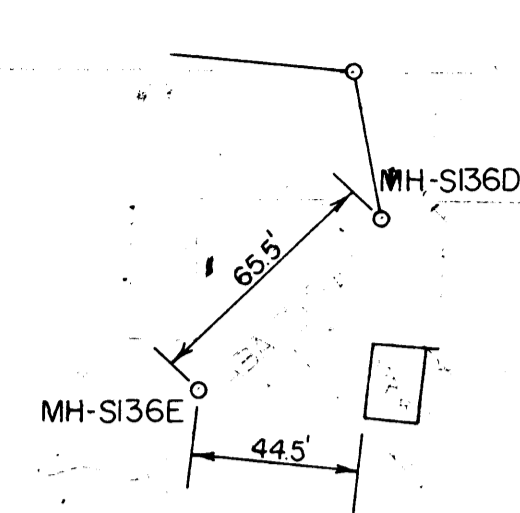
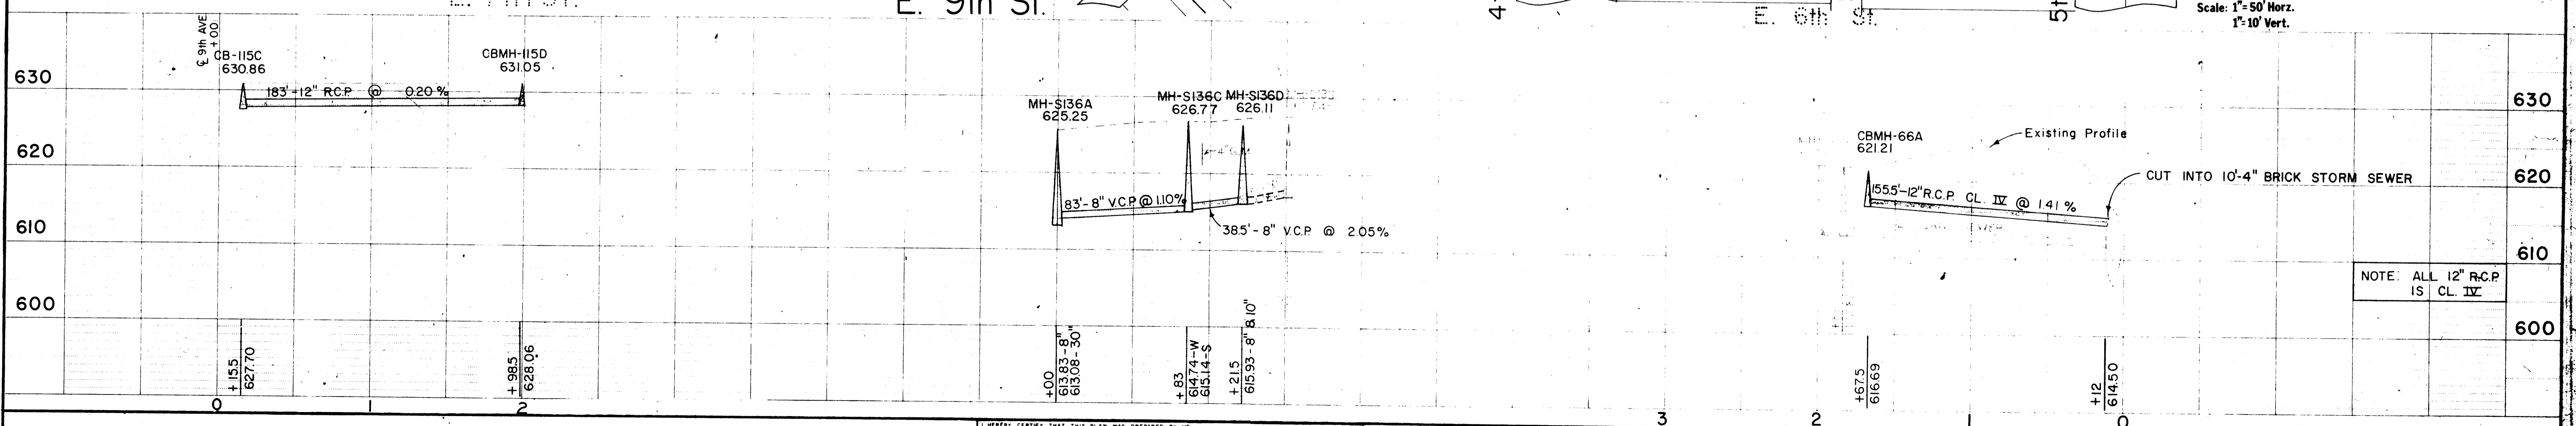
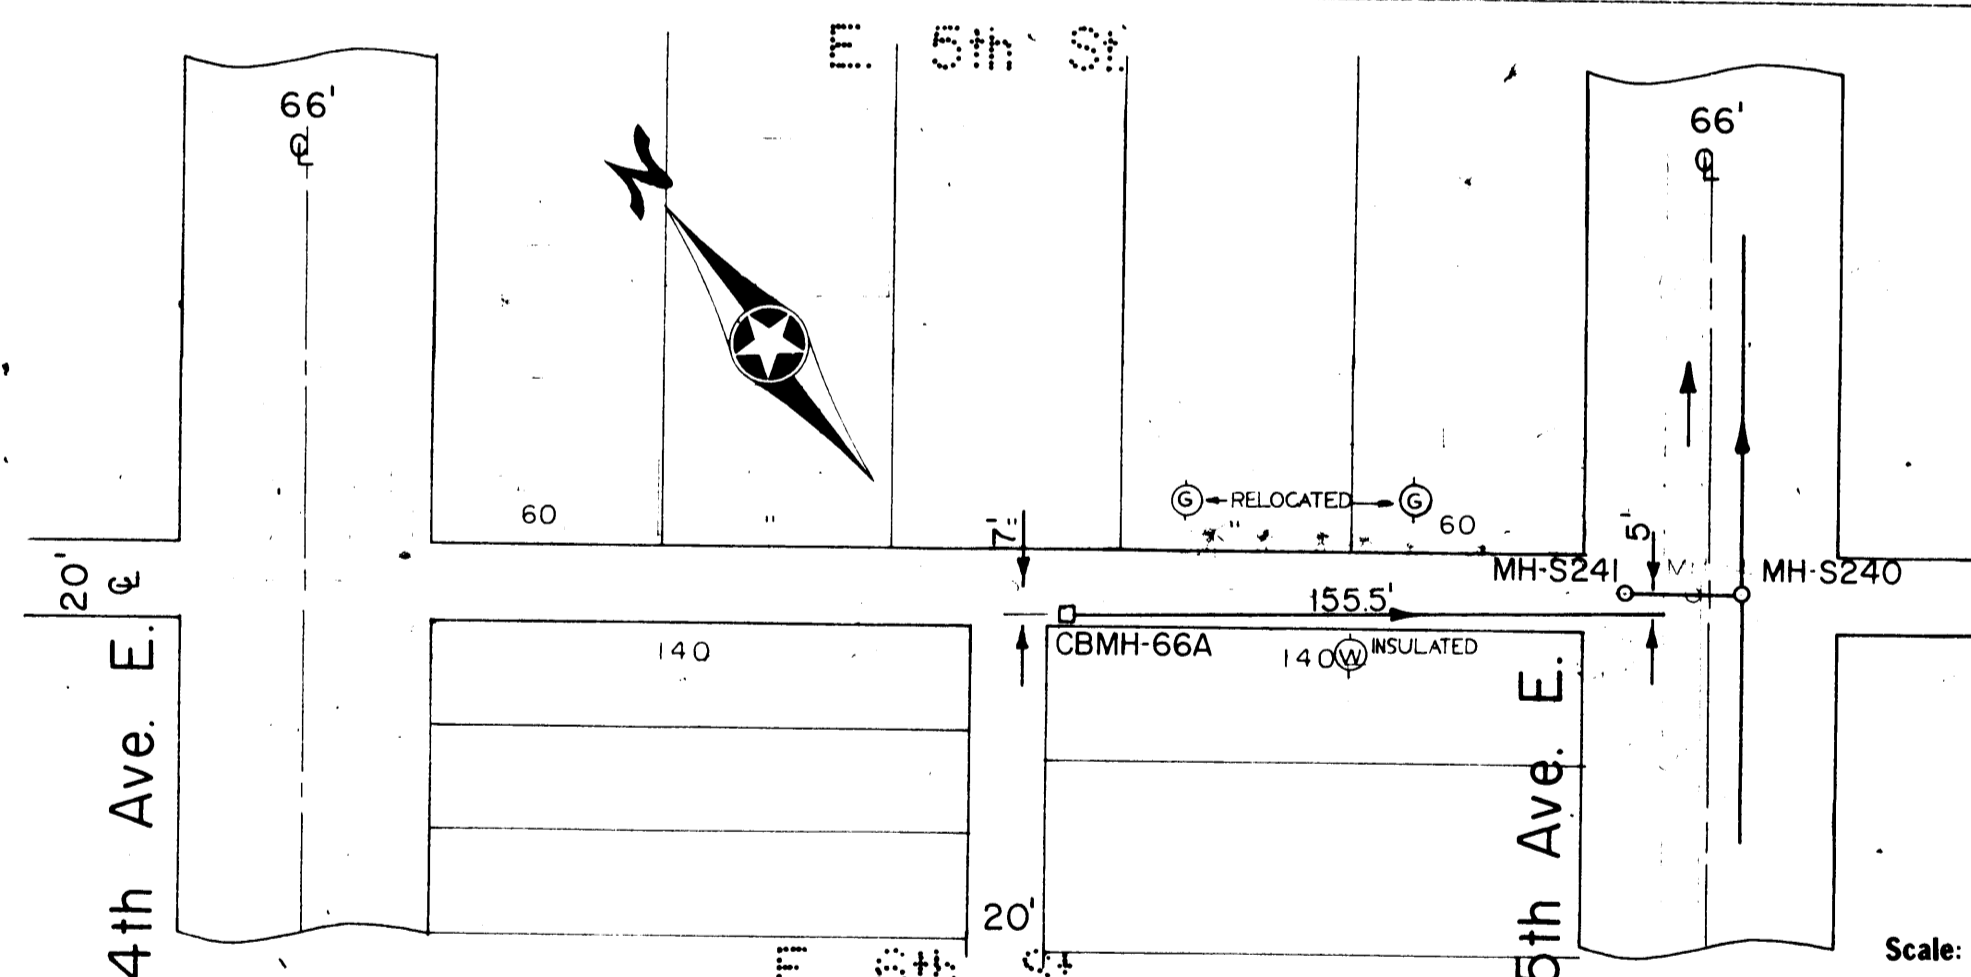


TIES TO MH-SI36E

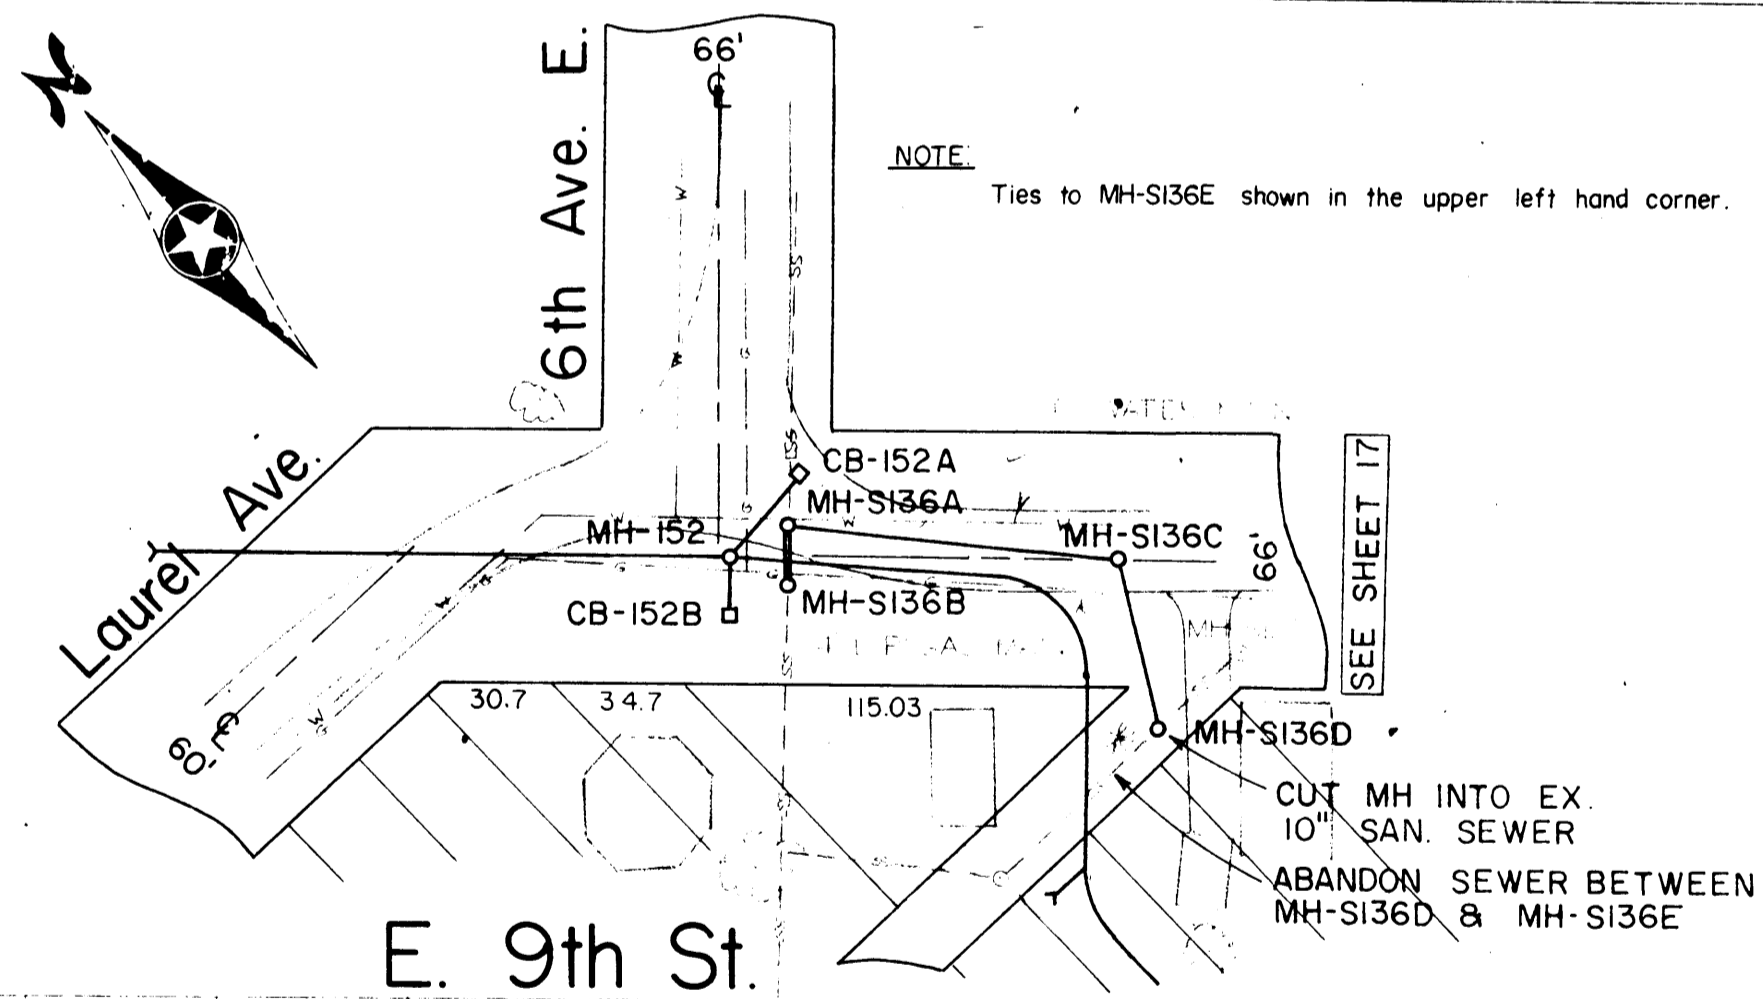

Scale: 1"=50' Horz.
1"=10' Vert.

E. 8TH ST.

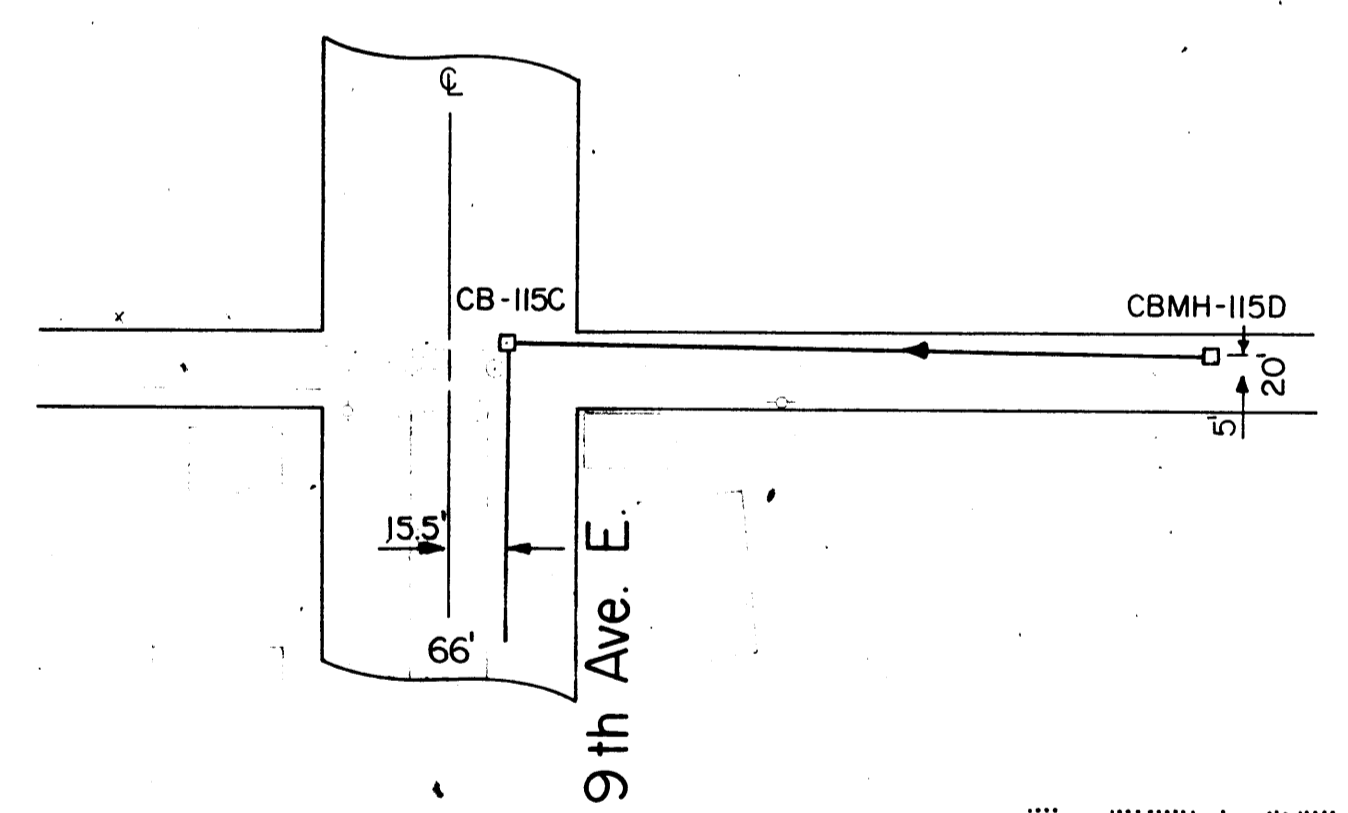

Scale: 1"=50' Horz.
1"=10' Vert.

NOTE: ALL 12" R.C.P. IS CL. IV

I HEREBY CERTIFY THAT THIS PLAN WAS PREPARED BY ME OR UNDER MY DIRECT SUPERVISION AND THAT I AM A REGISTERED PROFESSIONAL ENGINEER UNDER THE LAWS OF THE STATE OF WISCONSIN.		SURVEY: M.L.S.		REVISIONS:	BONESTROO, ROSENE, ANDERLIK & ASSOC., INC. ST. PAUL, MINNESOTA	SUPERIOR, WISCONSIN DATE: MAY 1, 1974 COMM. 6888 I	DISTRICT 3A-CENTRAL PARK	SHEET 11/29
DATE: SEP. 20, 1974		DRAWN: T.G.B.	RECORD PLAN					
		DESIGN: M.L.S.	1/20/77	HBR				
		APPROVED:						

9th AVE. E.
ALLEY-5th AVE. bet. 5th & 6th ST.