
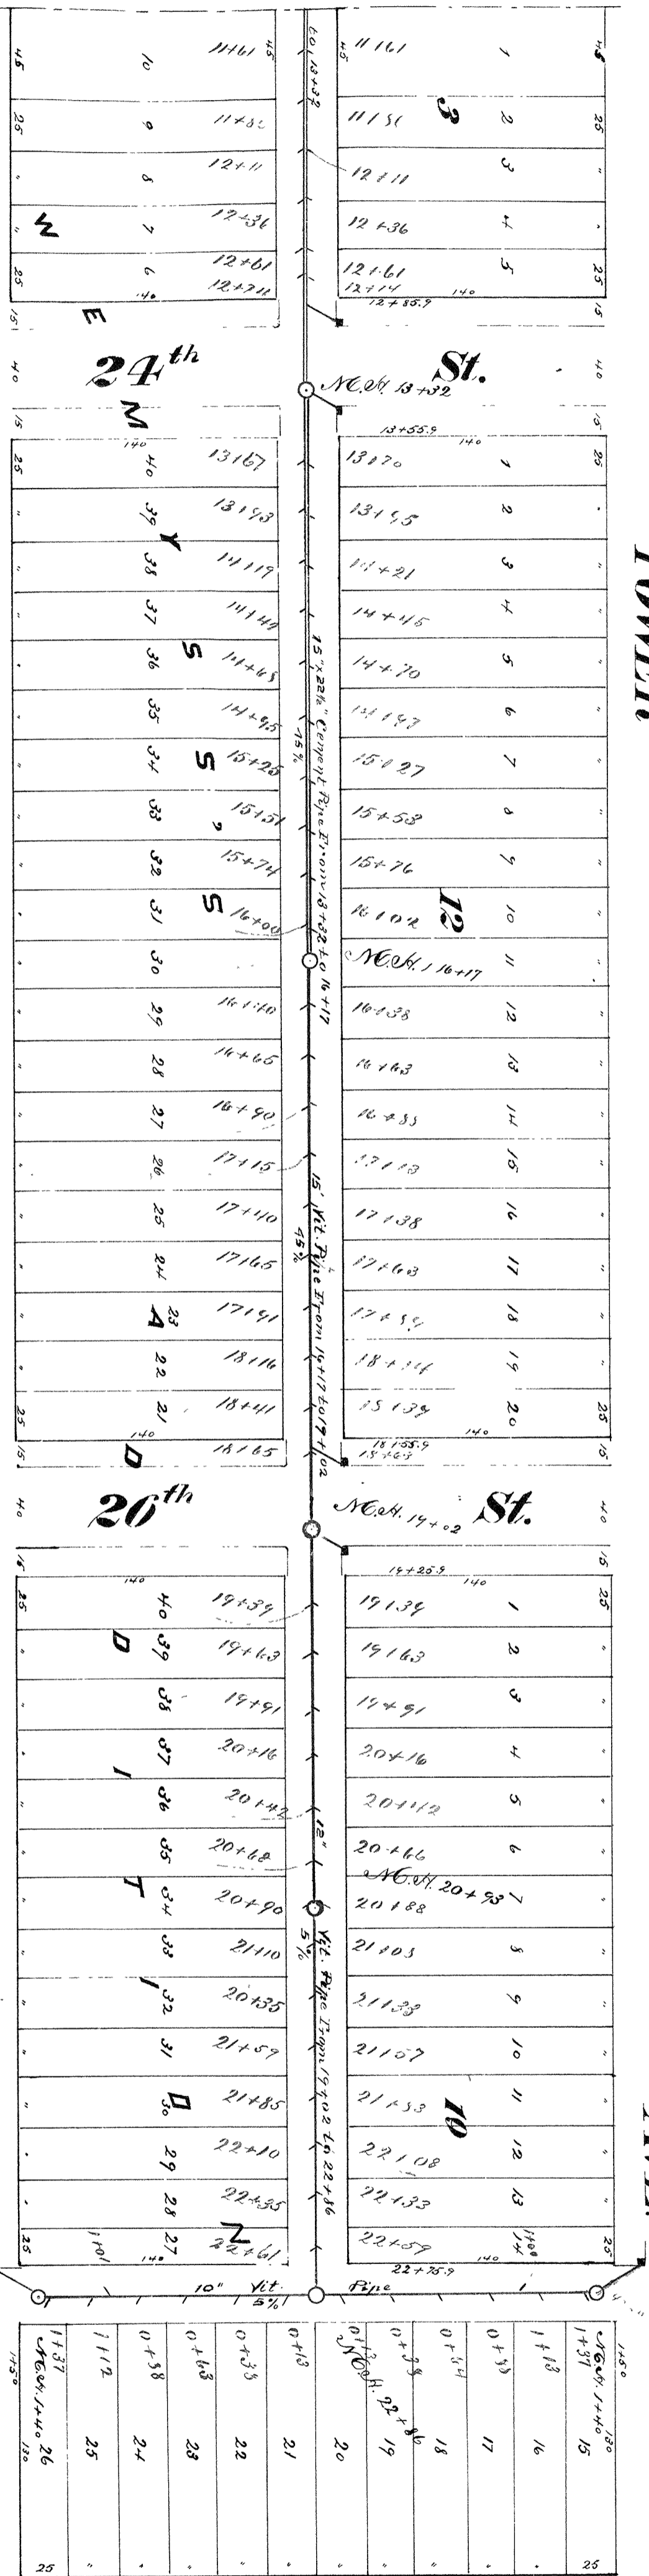


21^{ST.} RITCHIE St. AVE.

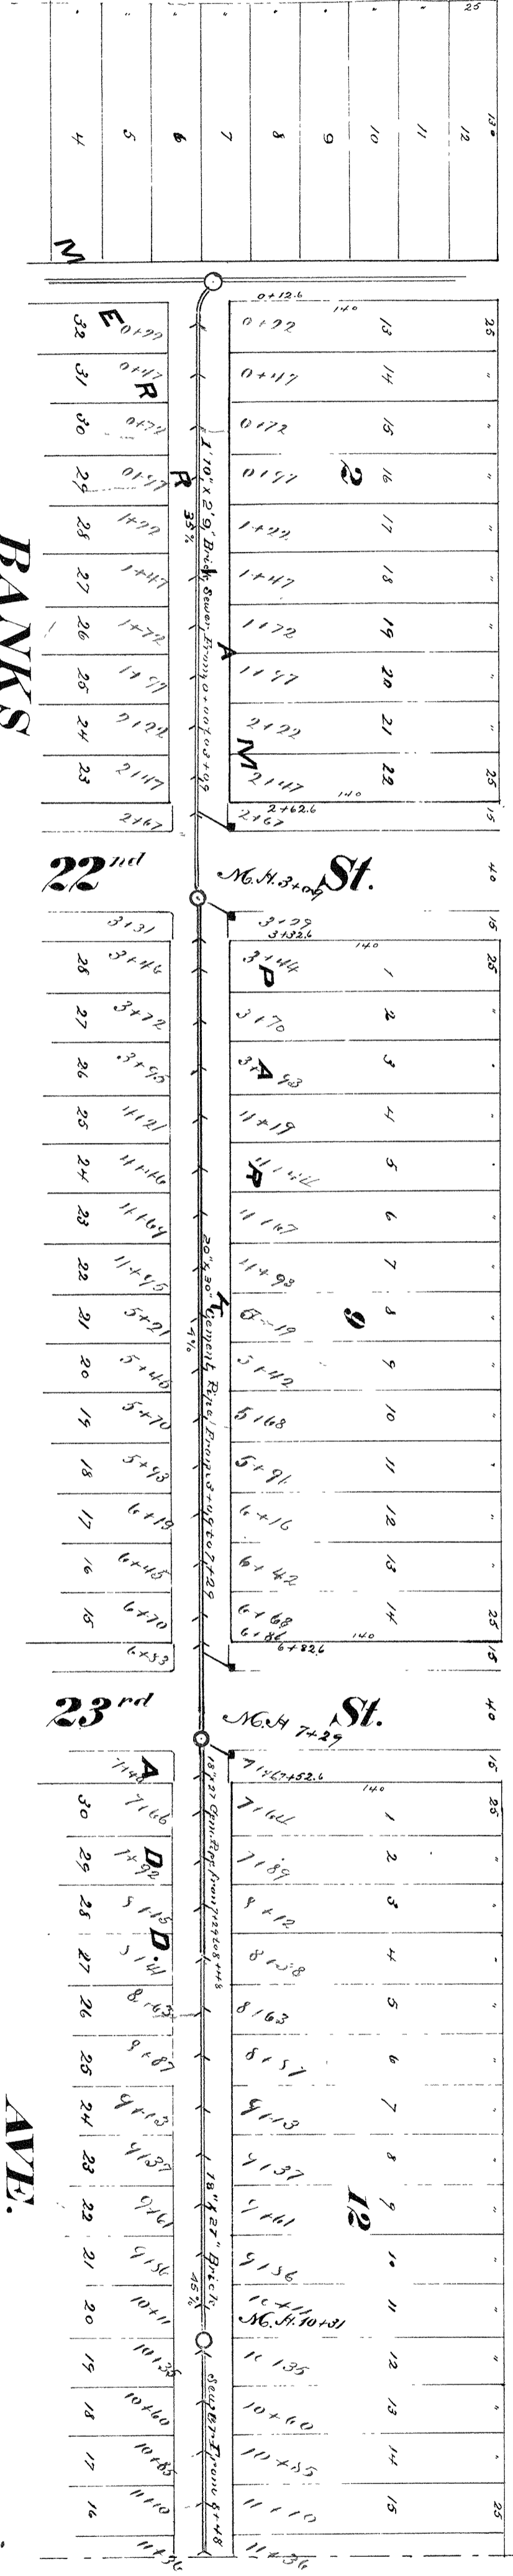

BANKS

AVE.

CITY OF SUPERIOR

SEWER PLAN

Contract let April 16, 1891
 completed Sept. 14, 1891
 Joseph Wolf, Contractor
 A. Carlson, F. McKinzie, Inspectors
 E. B. Banks, City Engineer.

Sewer in alley so. of 21st St.

M.H. 22 nd St.		M.H. 23 rd St.		M.H. 24 th St.		M.H. 25 th St.		M.H. 26 th St.		M.H. 27 th St.		M.H. 28 th St.	
36.74	37.64	38.04	38.94	39.44	39.85	42.24	42.74	43.74	44.24	45.24	45.74	46.24	46.74
Street sewer	Street sewer	Street sewer	Street sewer	Street sewer	Street sewer	Street sewer	Street sewer	Street sewer	Street sewer	Street sewer	Street sewer	Street sewer	Street sewer

Scale: 1" = 60'

3B-4