


**CITY OF SUPERIOR
SEWER PLAN**

Contract let Apr. 16-1891
 completed Sept. 14-1891
 Joseph Wolf, Contractor
 T.A. King, F. McKimzie, Inspectors
 E. B. Banks, City Engr.

Plan & Profile of Sewer in Alley between Tower and Ogden from Ritchie Ave. So.

Scale: { Horizontal 60'-1"
 Vertical 6'-1"

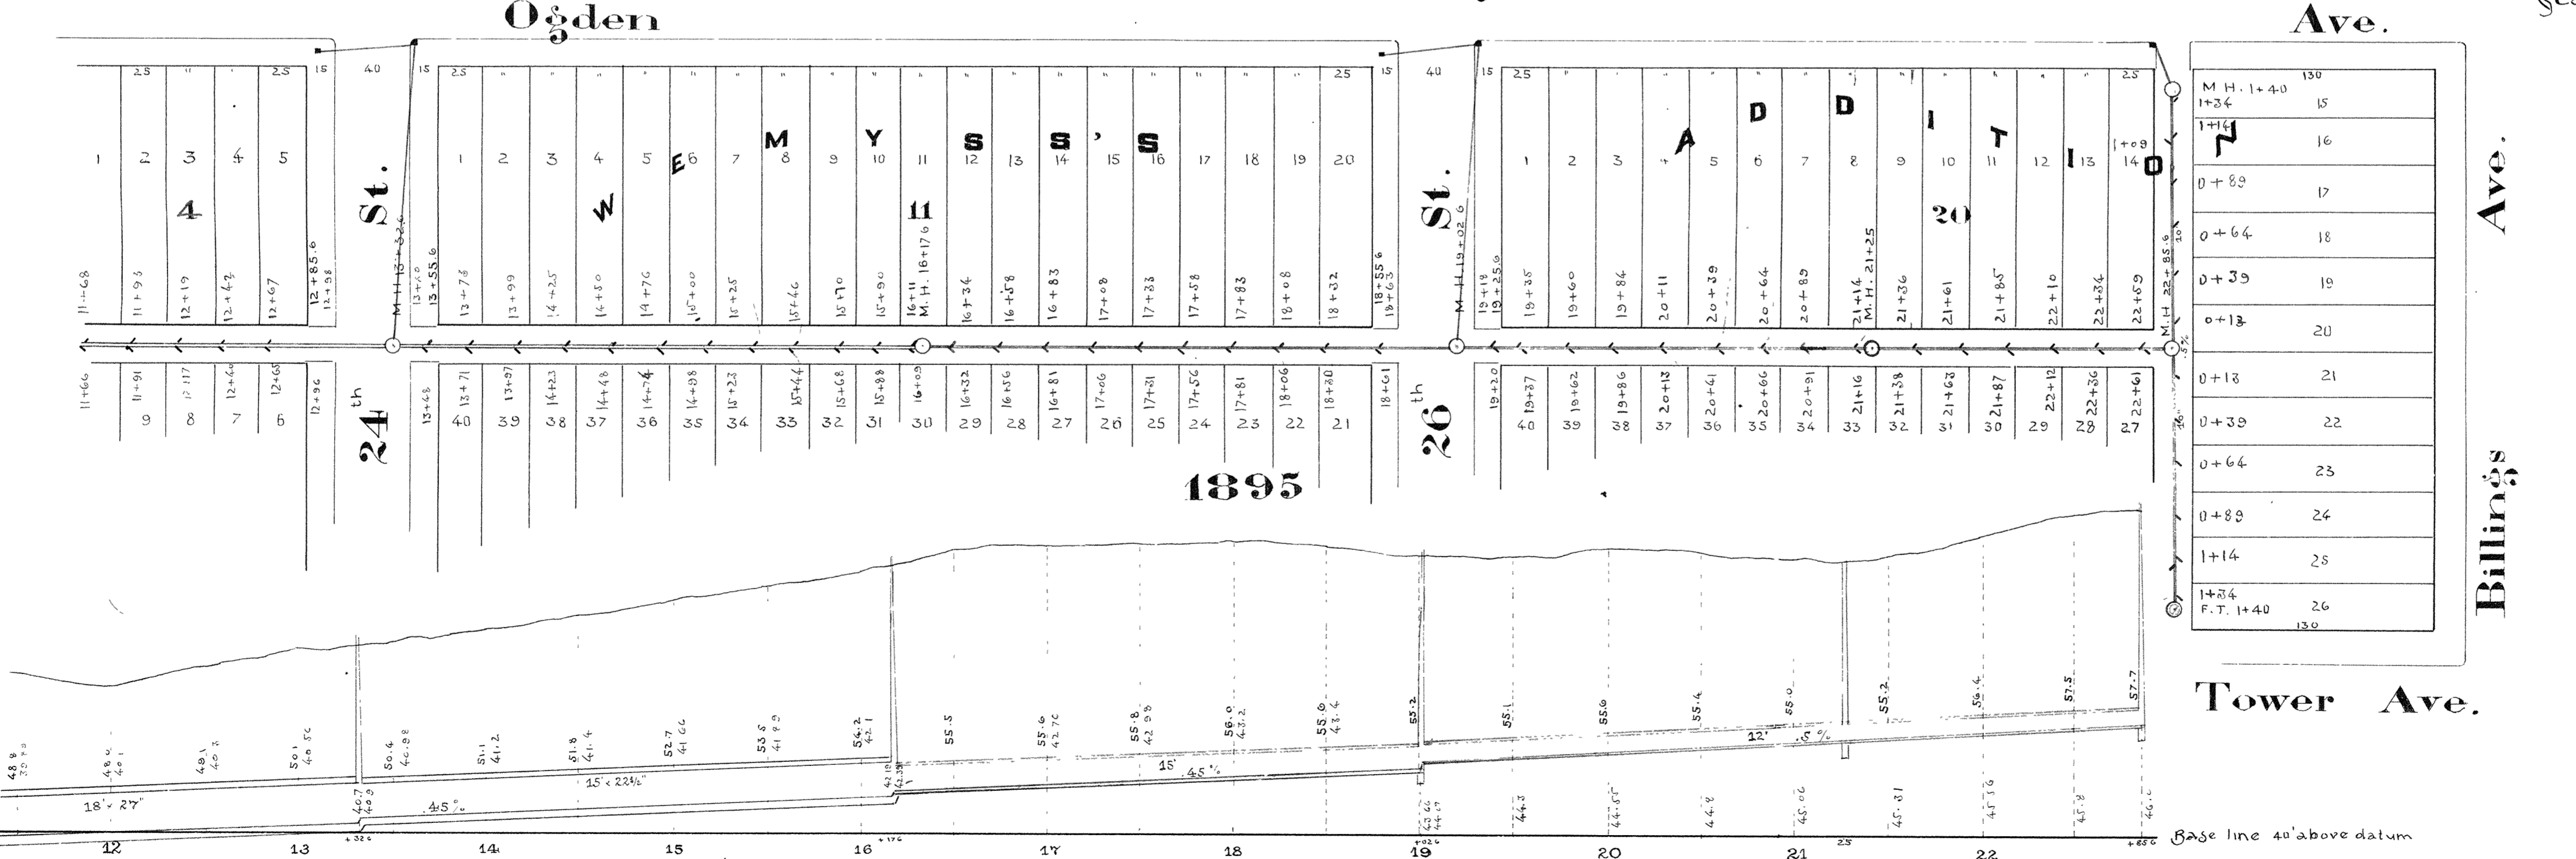

Plan & Profile of Sewer in Alley between Tower and Ogden from Ritchie Ave. So.

3B-5