




Scale: { Horizontal 60' = 1"  
Vertical 6' = 1"

Plan & Profile of Sewer in Alley between Ogden and John Ave. from Ritchie to Billings Ave.

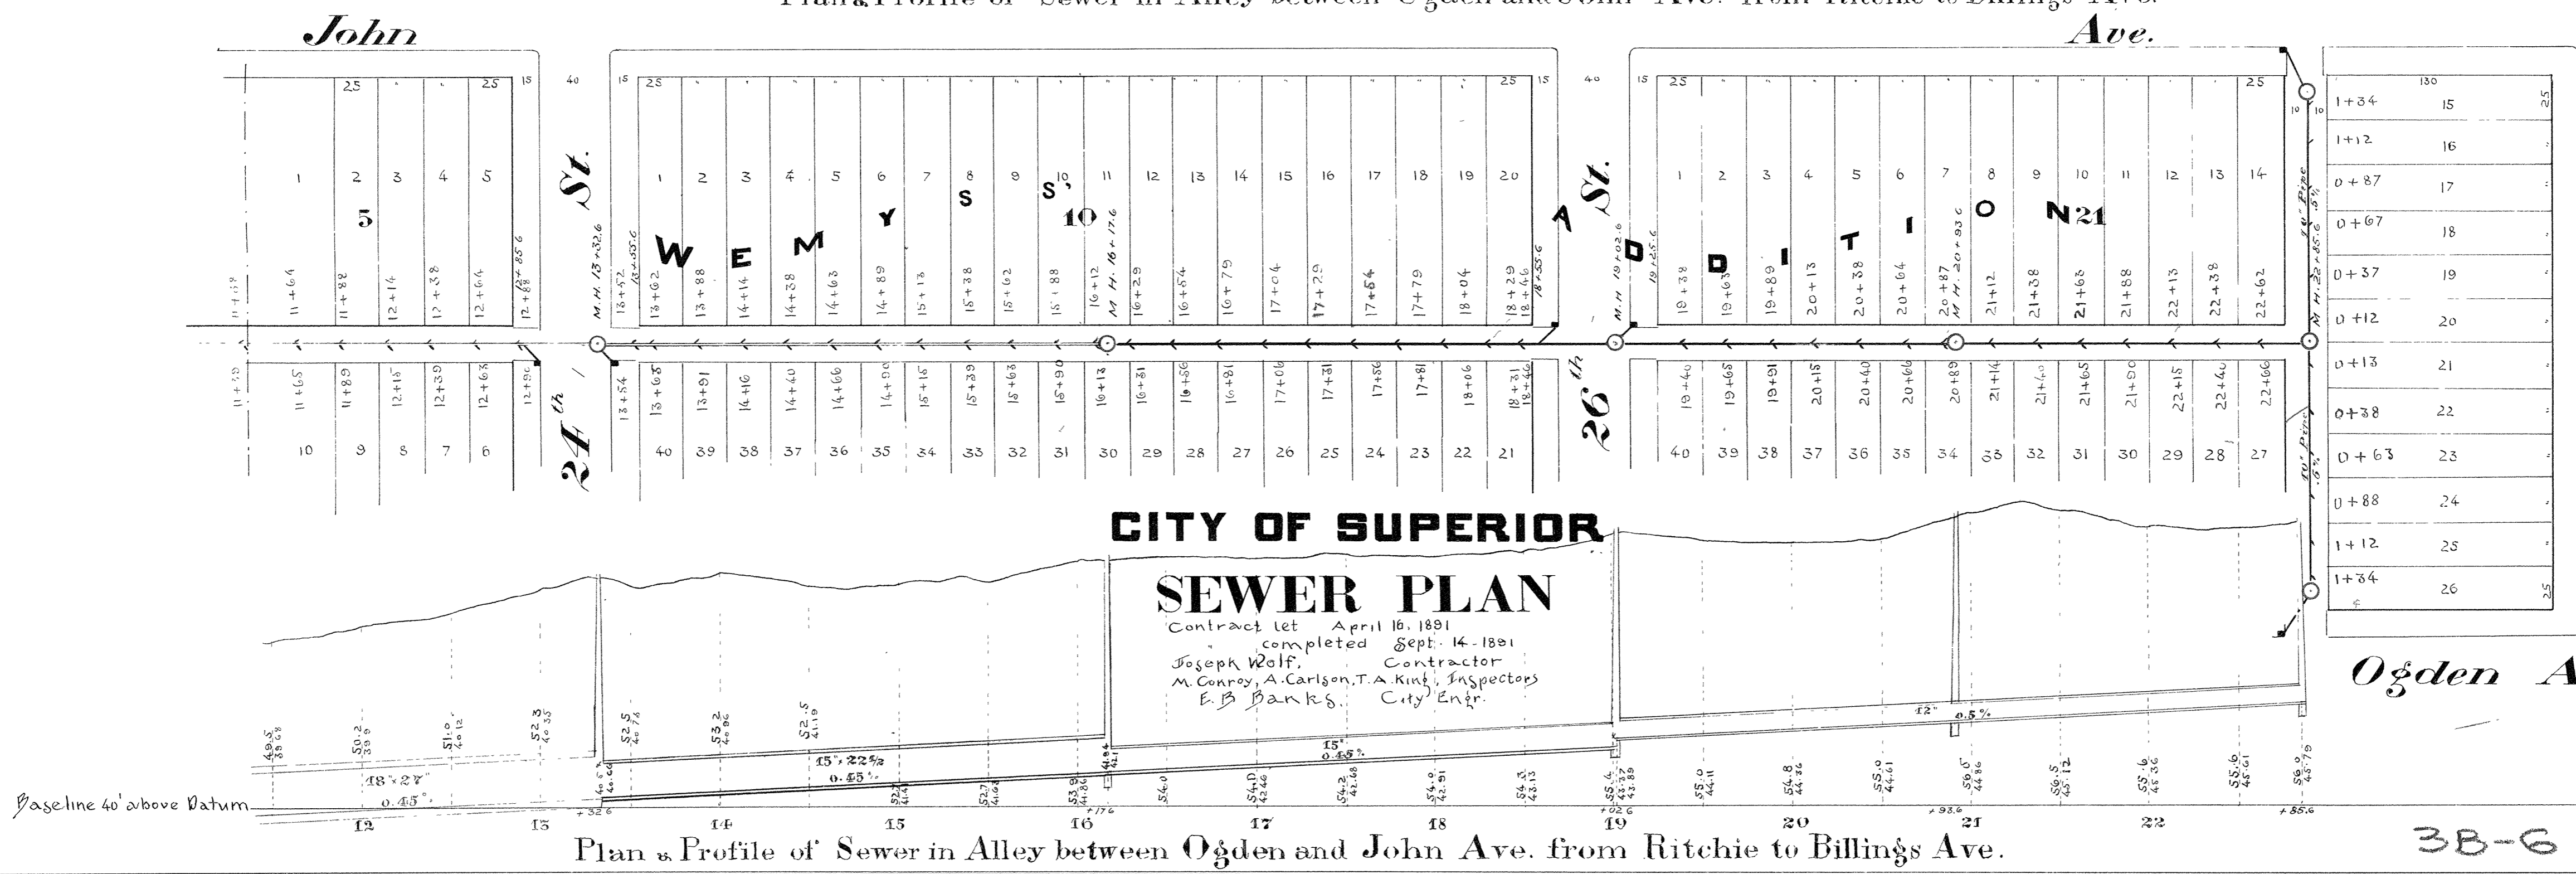

**CITY OF SUPERIOR**  
**SEWER PLAN**  
 Contract let April 16, 1891  
 completed Sept. 14, 1891  
 Joseph Wolf, Contractor  
 M. Conroy, A. Carlson, T.A. King, Inspectors  
 E.B. Banks, City Engr.

Plan & Profile of Sewer in Alley between Ogden and John Ave. from Ritchie to Billings Ave.

3B-6