



Corrected Location of Specials

BENCH MARKS			
NO.	STA.	DESCRIPTION	ELEV.
1	0A+00	RIM OF MANHOLE	629.10
2	-	INTERSECTION 23 <sup>RD</sup> & CATLIN	639.50

PLAN  
 DATE 3-2-64  
 BY M.S.  
 CHECKED  
 PLOTTED  
 ALIGNMENT CHECKED  
 RT. OF WAY CHECKED  
 NO. 1

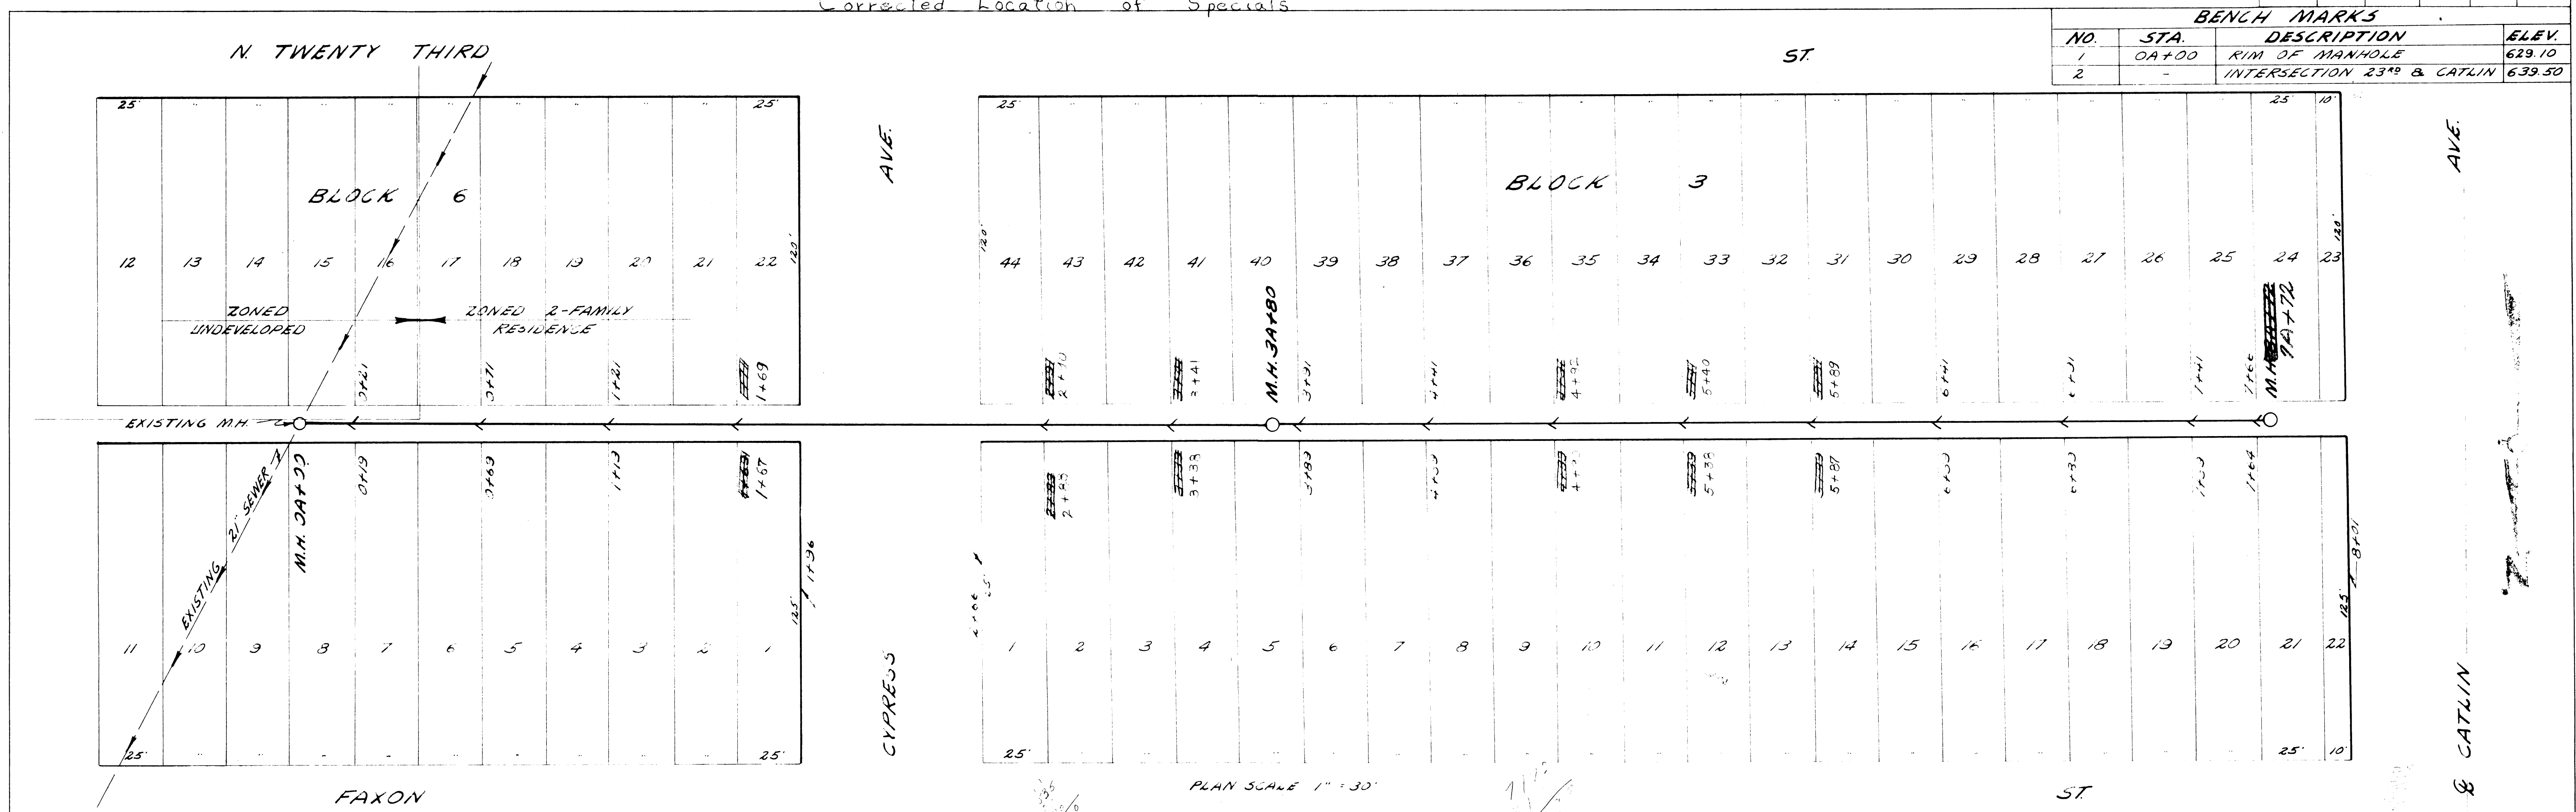

PROFILE  
 DATE 3-2-64  
 BY M.S.  
 CHECKED  
 PLOTTED  
 GRADES CHECKED  
 MANHOLE NOTATIONS CHECKED  
 NO. 1

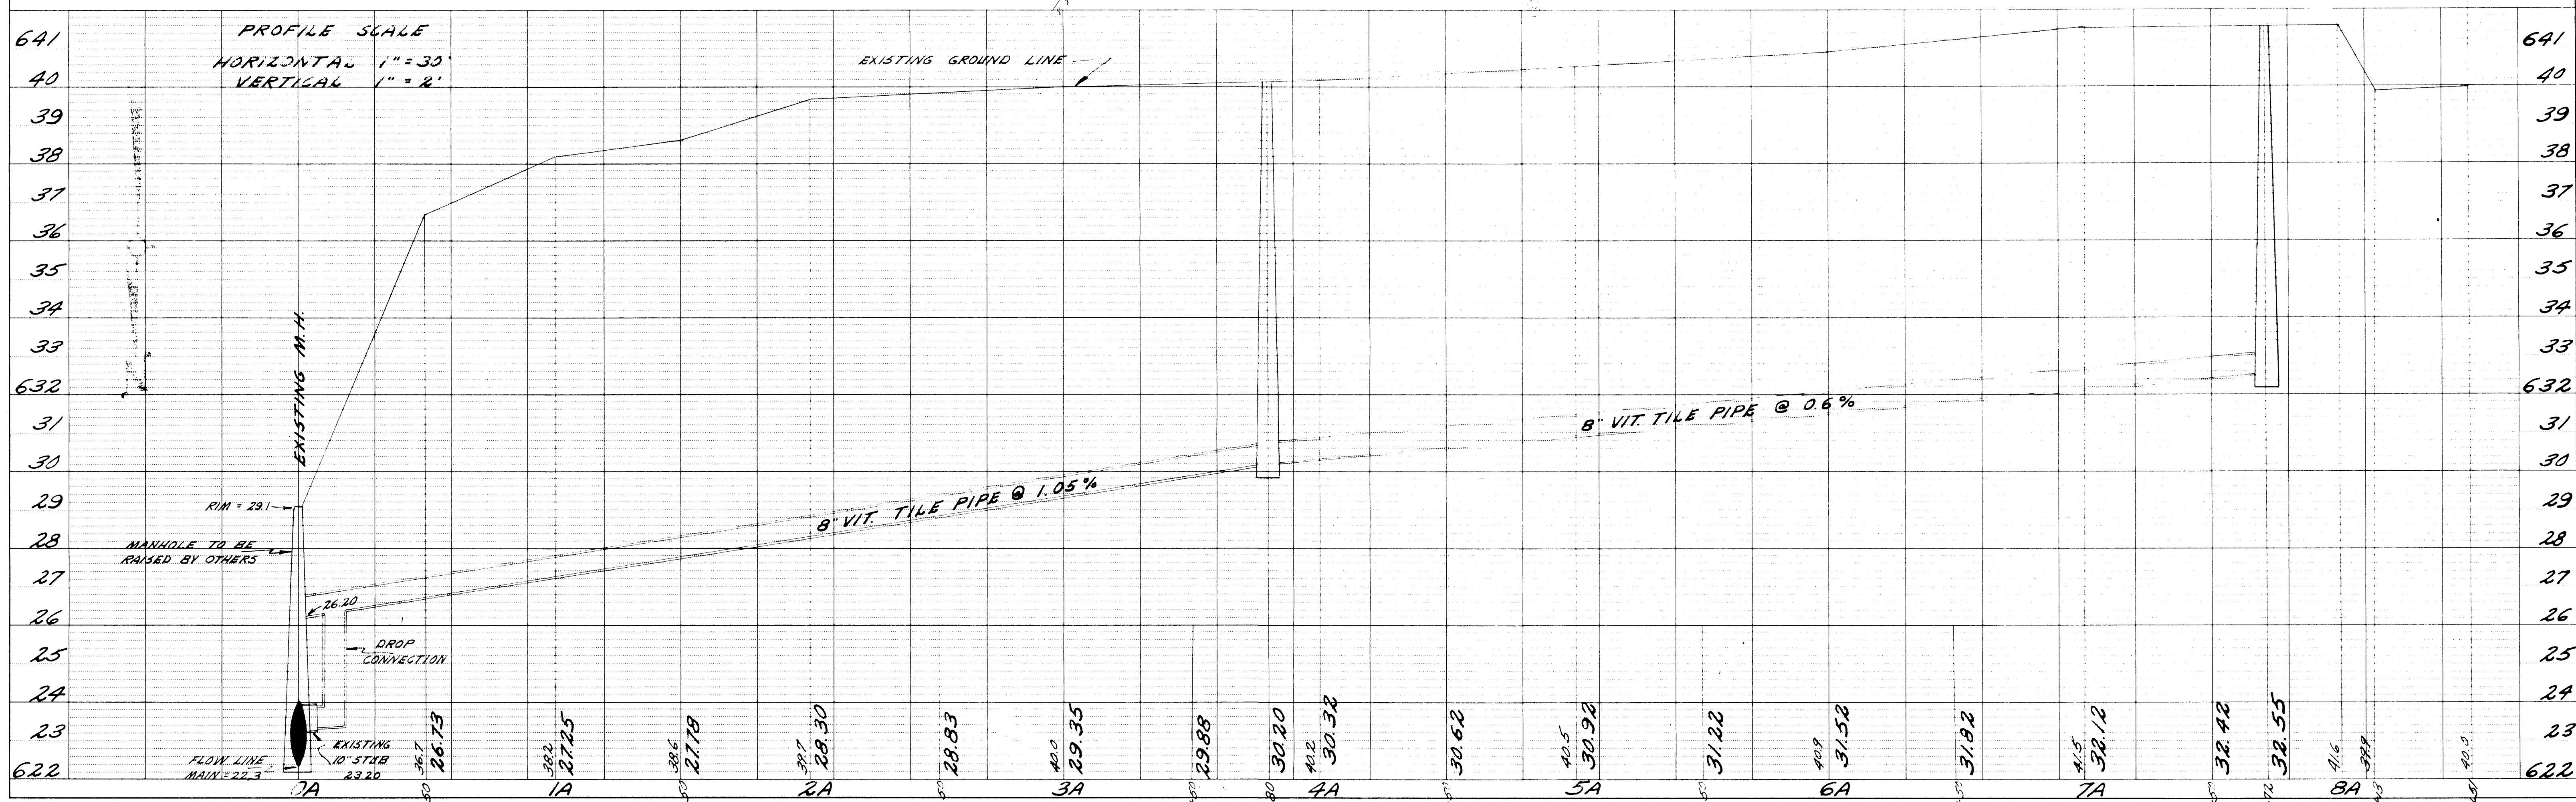

SINGLE PLAN AND PROFILE - DOTTED  
 H. A. ROGERS CO., MINNEAPOLIS - ST. PAUL, DULUTH