

ANIMAL ARTS

architecture • animals • people

Submittal Review

Project: Superior Animal Shelter
Number: 14035
Item Reviewed: ROLLER SHADES

Review Comments:

1. Furnish in the colors indicated.

No Exceptions Taken Furnish as Corrected

Rejected Revise and Submit

This review was performed only for general conformance with the design concept of the project and general compliance with the information given in the Contract Documents. Modifications or comments made on the shop drawings during this review do not relieve contractor from compliance with the requirements of the plans and specifications. Approval of a specific item does not include approval of the assembly of which the item is a component. Contractor is responsible for; dimensions to be confirmed and correlated at the jobsite; information that pertains solely to the fabrication processes or to the means, methods, techniques, sequences, and procedures of construction; coordination of the work of all trades; and for performing all work in a safe and satisfactory manner.

ANIMAL ARTS DESIGN STUDIOS, INC.




Date: June 30, 2015

Reviewer: Heather E. Lewis, AIA

Style 4000


(5% open)

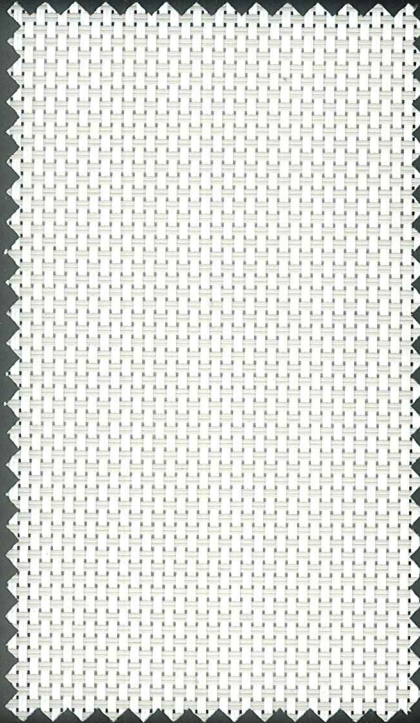

Eco/Alabaster

Style 4100

(10% open)

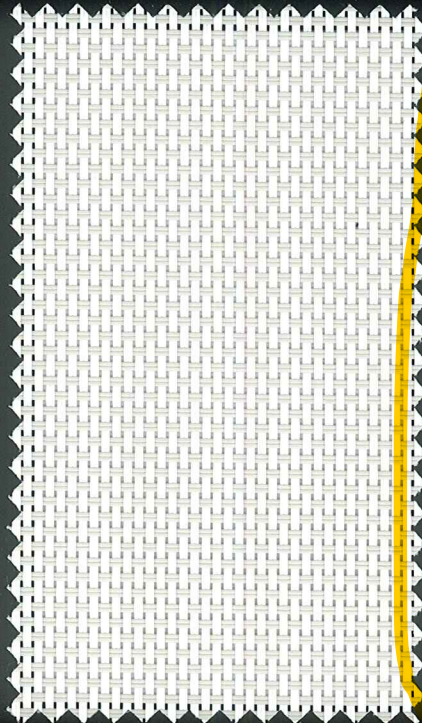

Eco/Alabaster


Style 4400

(3% open)




Eco/Alabaster


THE ABOVE STYLES ARE ALSO AVAILABLE IN THE COLORS SHOWN BELOW.

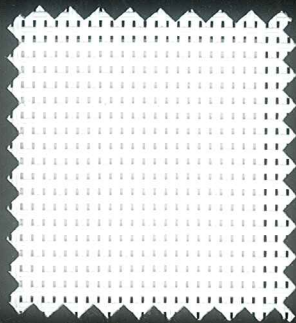


Eco/Chalk

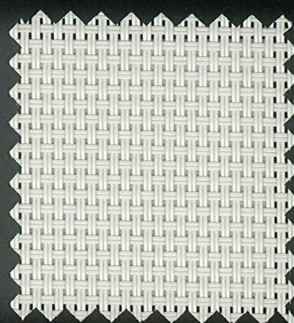


Eco/Pebblestone

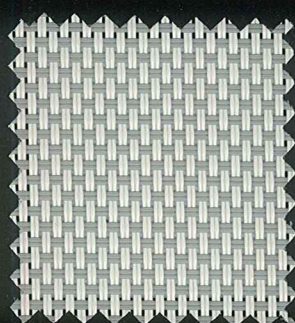


Eco/Greystone

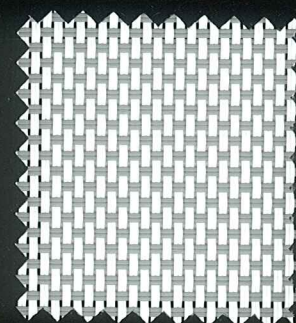


Eco/Granite

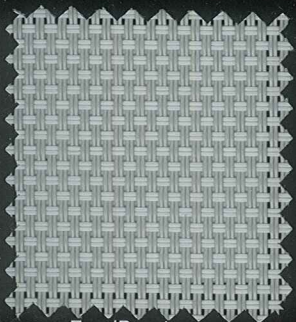


Eco/Pewter

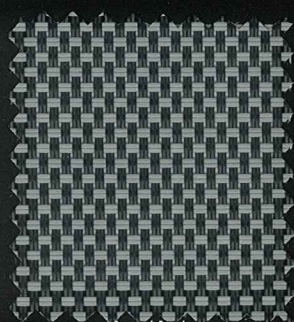

Eco/Ash

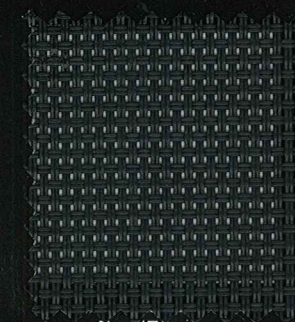

Eco/Ebony

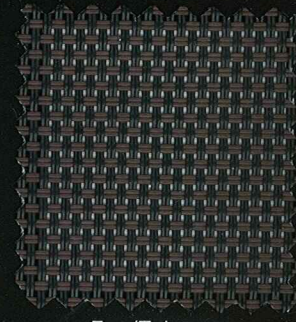

Eco/Tobacco

Draper SunBloc SB9000/SB9100

These DRAPER room-darkening window shade fabrics are constructed of tough woven fiberglass coated on both sides with durable, sun-resistant, flexible vinyl. They are flame, fade, and mildew resistant, washable and tearproof. Designed for the toughest service, without that "institutional look."


SunBloc Series SB9000 (Triopak II)




White




Ivory

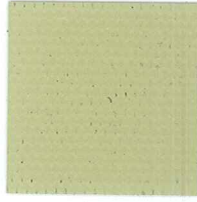

Tan

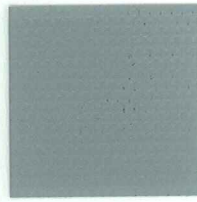

Dark Grey

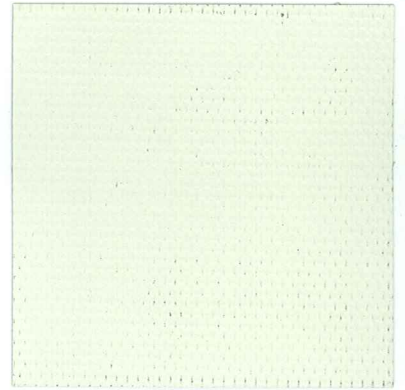

Oyster



Grey



Black




Champagne

SunBloc Series SB9100 (Duopak)


White on the outside.




Grey

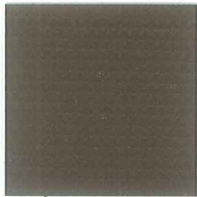


Chocolate

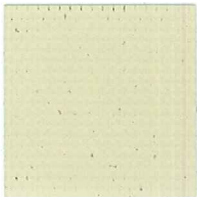


Wheat

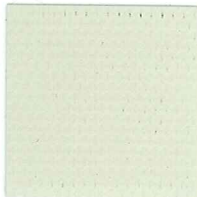


Putty

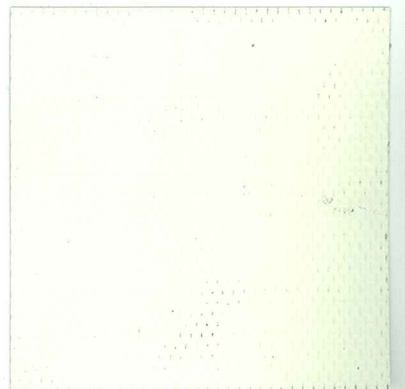

Ivory

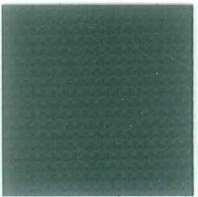


Forest

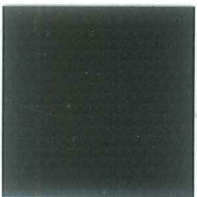

Black



Burgundy

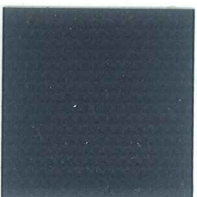

Navy




Dark Grey


DRAPER®

Hardware for FlexShades

Clutch Brackets—The standard mounting hardware supplied for wall, ceiling or jamb installation of Draper Manual FlexShades. As an option for a pair of 1 1/8" brackets, white bracket covers are available. If optional fascia or headbox are specified, then endcaps (not brackets) are supplied.

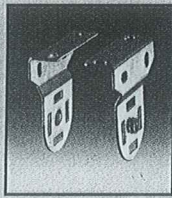

Clutch Brackets

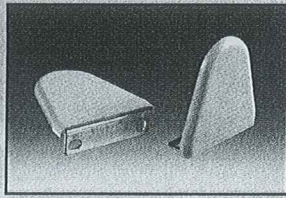


Optional Covers for 1 1/8" brackets

Fascia & Endcaps—Optional extruded fascia and endcaps in square or radius styles hides hardware and roller. Available in clear anodized (standard), black, white, ivory, or charcoal bronze. 3/8" or 4/8" high as required. Color samples are available.




Fascia Finishes

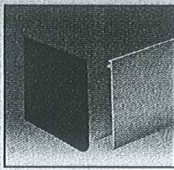

Printed colors may vary from actual finishes.

COLOR CHOICES


Surface-Mounted Headbox—Complete extruded headbox is available to hide hardware and roller as an option for Motorized and Manual FlexShades. Two-piece assembly is suitable for surface mount to head, jamb or wall, in sizes 3 1/16" high or 4 1/16" high required.

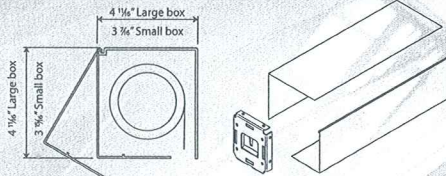


Surface-mounted Headbox is two pieces plus endcaps

as


Pocket-Style Headbox—Complete extruded headbox with endcaps is available for ceiling recessed installation. In sizes 3 7/8" high or 4 5/8" high as required.

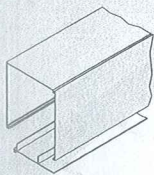

Pocket-Style Headbox

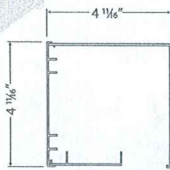


Large Pocket Headbox

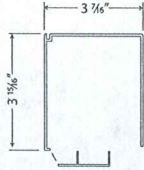

Small Pocket Headbox


Type D Pocket—An extruded aluminum pocket for clean, ceiling flush installation. With bottom closure panel in place, only a narrow slot is visible. Aluminum pockets offer a convenient architectural solution for mounting either Motorized or Manual FlexShades at the curtain wall.

Installation of Type D Pocket in coordination with ceiling finishing allows

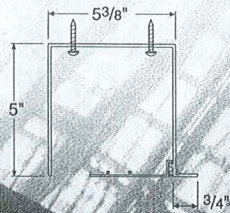

for later installation of shades. Pockets are finished in white with 1 1/2" or 3" closure. FlexShades are installed using standard ceiling brackets.

Draper's Type D Pocket cross-section dimensions are 5" deep x 5 3/8" high. Comes in 12' lengths. A 3/4" tile-support flange along lower edge supports lay-in ceiling. Pre-welded corners and pocket ends are available. Endcaps optional. Add 1/4" to overall case width if using endcaps. Closures are 1 1/2" (recommended for clutch operation) or 3" (motorized).

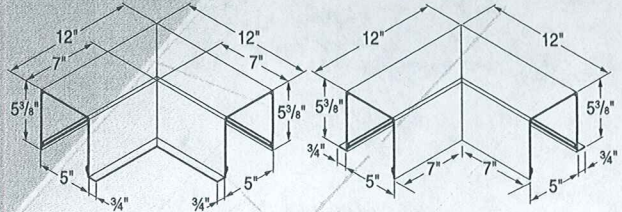


D Pocket Corner with Inner Flange

D Pocket Corner with Outer Flange


Standard Wall Clip & Wall Clip with Ceiling

Tile Lip—Pocket already exists? Specify FlexShade Wall Clip with choice of 2 closures. Wall Clip mounts to the wall and bottom closure panel drops neatly into place without fasteners, leaving a minimal slot through which the shade descends. For sleek appearance, use continuous wall clip (up to 12'). Closure sizes 1 1/2", 3", and 5" in 12' extrusions.

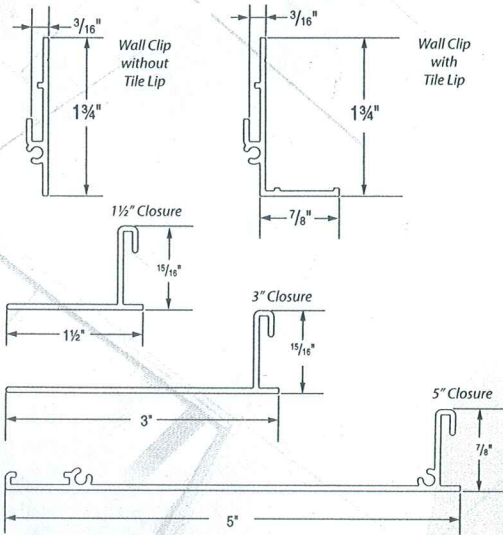

U Channel, H Channel, or L Angle

—Side (U or H) Channels or L Angles prevent direct light gaps at sides of shade fabrics. U Channels are 1" deep x 2 1/2" wide, and mount to the jamb or face of window opening. H Channels are 1" deep x 5" wide (2 1/2" wide each side), and mount to window mullion. L Angles measure 1" x 3/4" or 1" x 2 3/4" and mount inside the jamb. Not available with all products.

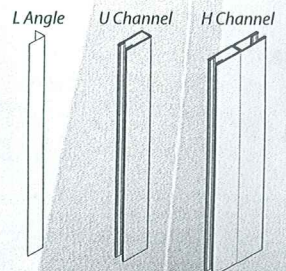

Custom Powder Coating—Custom powder coat colors available for most Draper hardware. Contact Draper or see next page for details.