
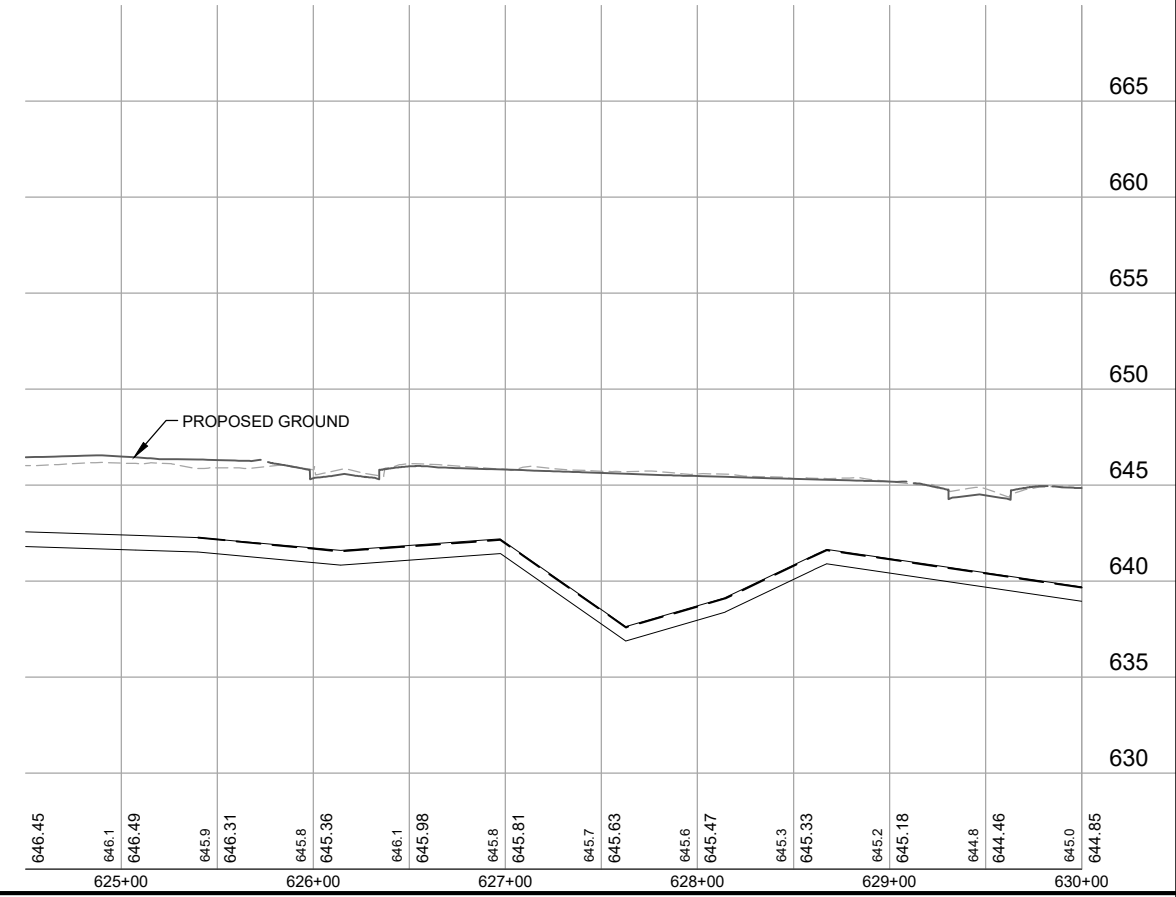
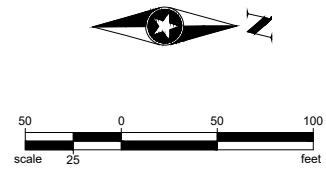


Save: 2/22/2024 10:39 AM Iglendermng Plot: 2/22/2024 2:24 PM X:\PT\GIS\SUPER\1637285-final-dsgn\C3D\69980036\WaterPhase 1.dwg\exhibits\SU163728 EAST GAS MAIN EXHIBITS.dwg

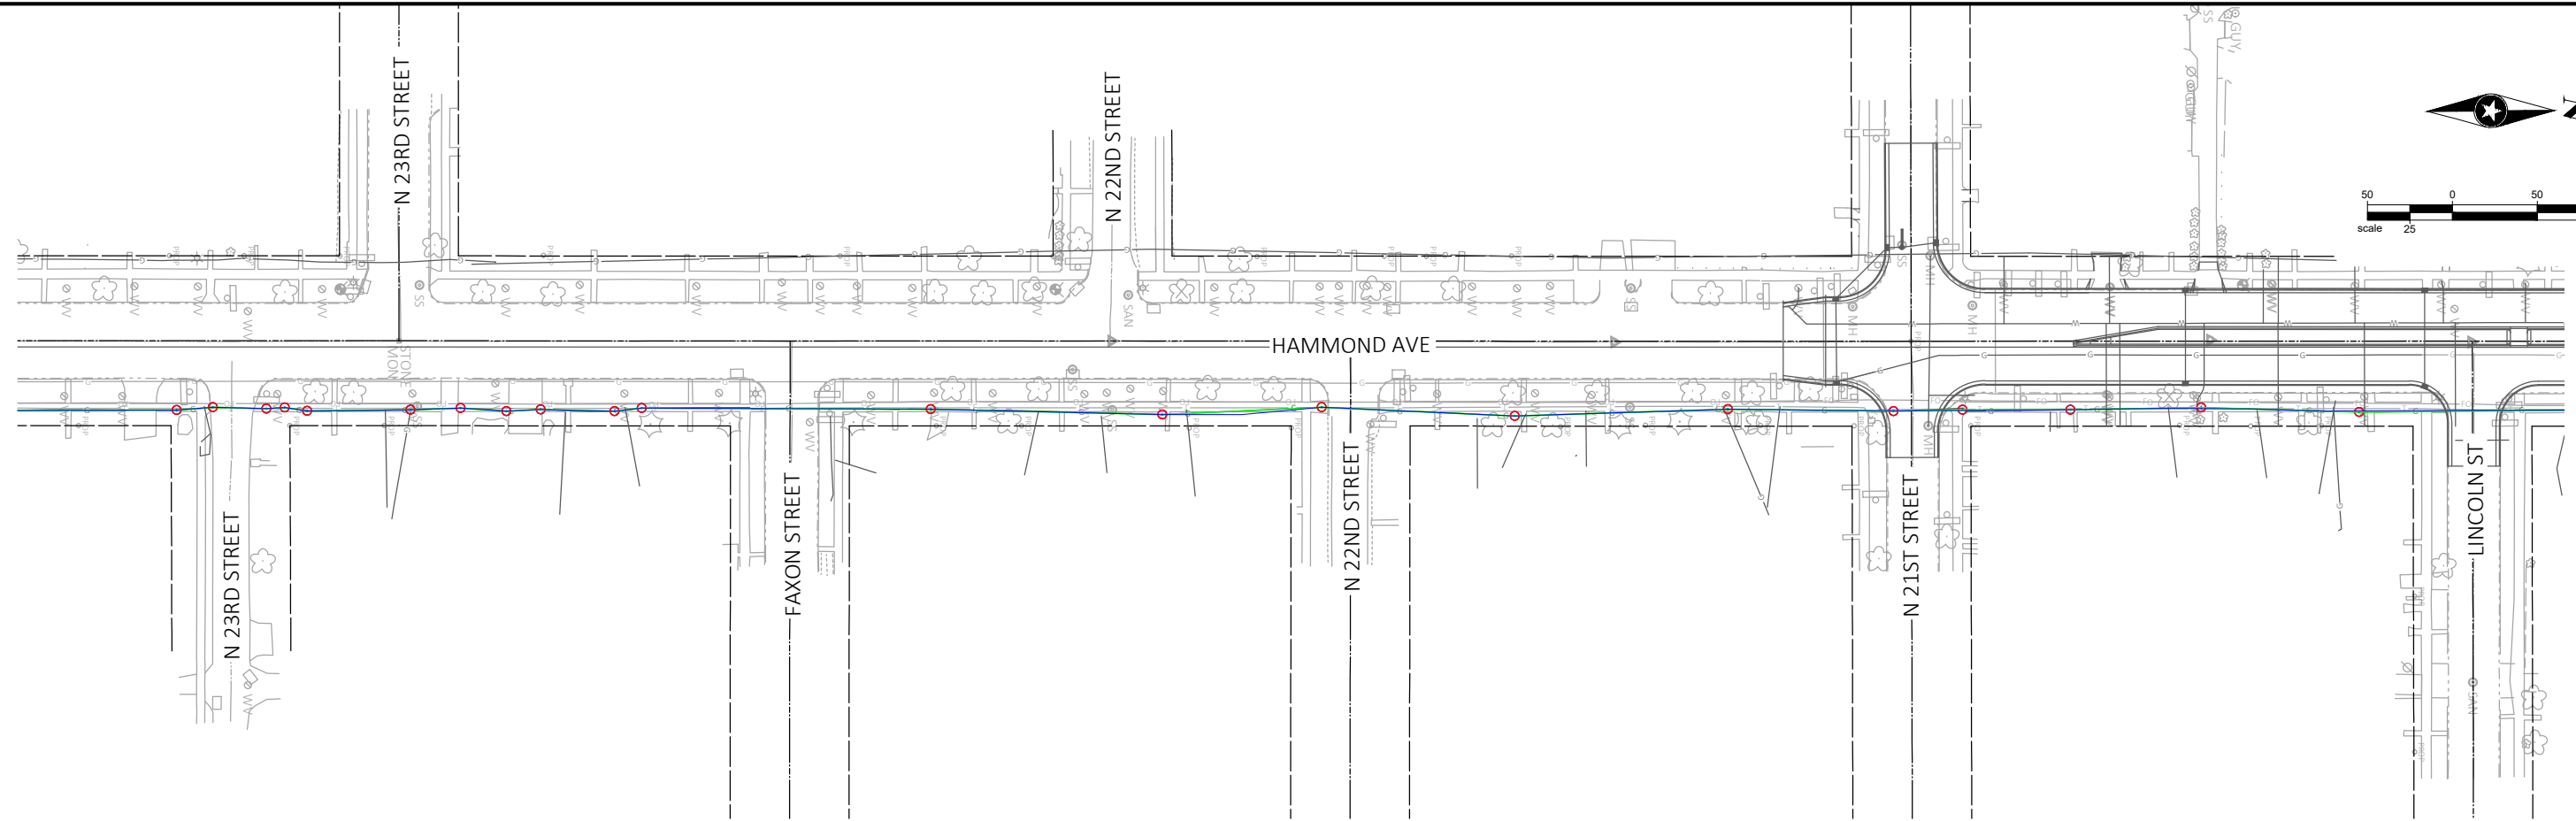

SEH Project	SARTE145169	Rev.#	Revision Issue Description	Date	Rev.#	Revision Issue Description	Date
Drawn By	-	.			.		
Designed By	-	.			.		
Checked By	-	.			.		




I HEREBY CERTIFY THAT THIS PLAN WAS PREPARED BY ME OR UNDER MY DIRECT SUPERVISION AND THAT I AM A DULY LICENSED LICENSE PROFESSIONAL UNDER THE LAWS OF THE STATE OF WISCONSIN.

LICENSE NAME: XX  
DATE: XX-XX-XX  
LICENSE NO. LICENSE NO.

**HAMMOND AVE. WATERMAIN**  
SUPERIOR, WISCONSIN

**EAST GAS MAIN**

Save: 2/22/2024 10:39 AM I:\glendmring\Plot\_2/22/2024 2:24 PM X:\PTT\GIS\SUPER\1637285-final-dsgn\C3D\69980036\WaterPhase 1\dwg\exhibits\SU163728 EAST GAS MAIN EXHIBITS.dwg

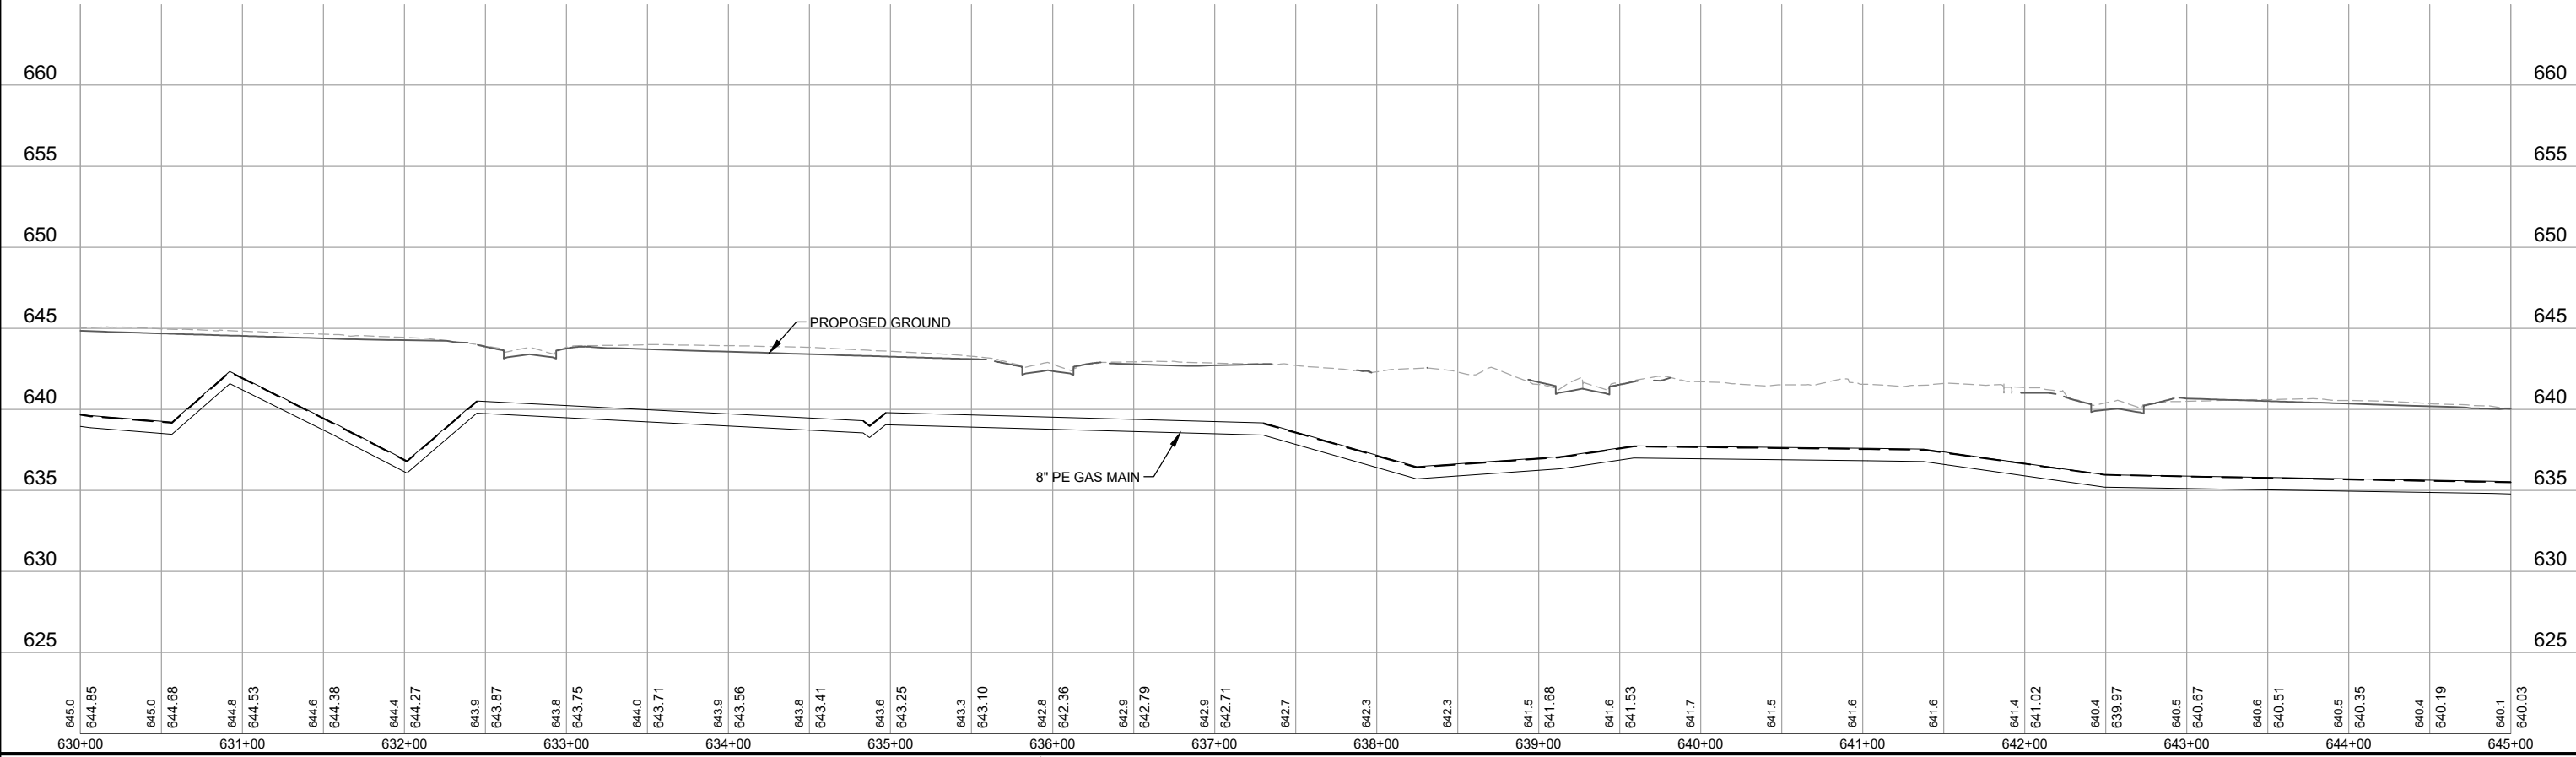
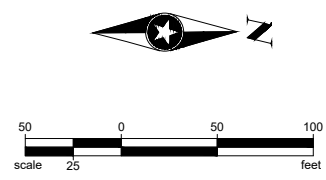
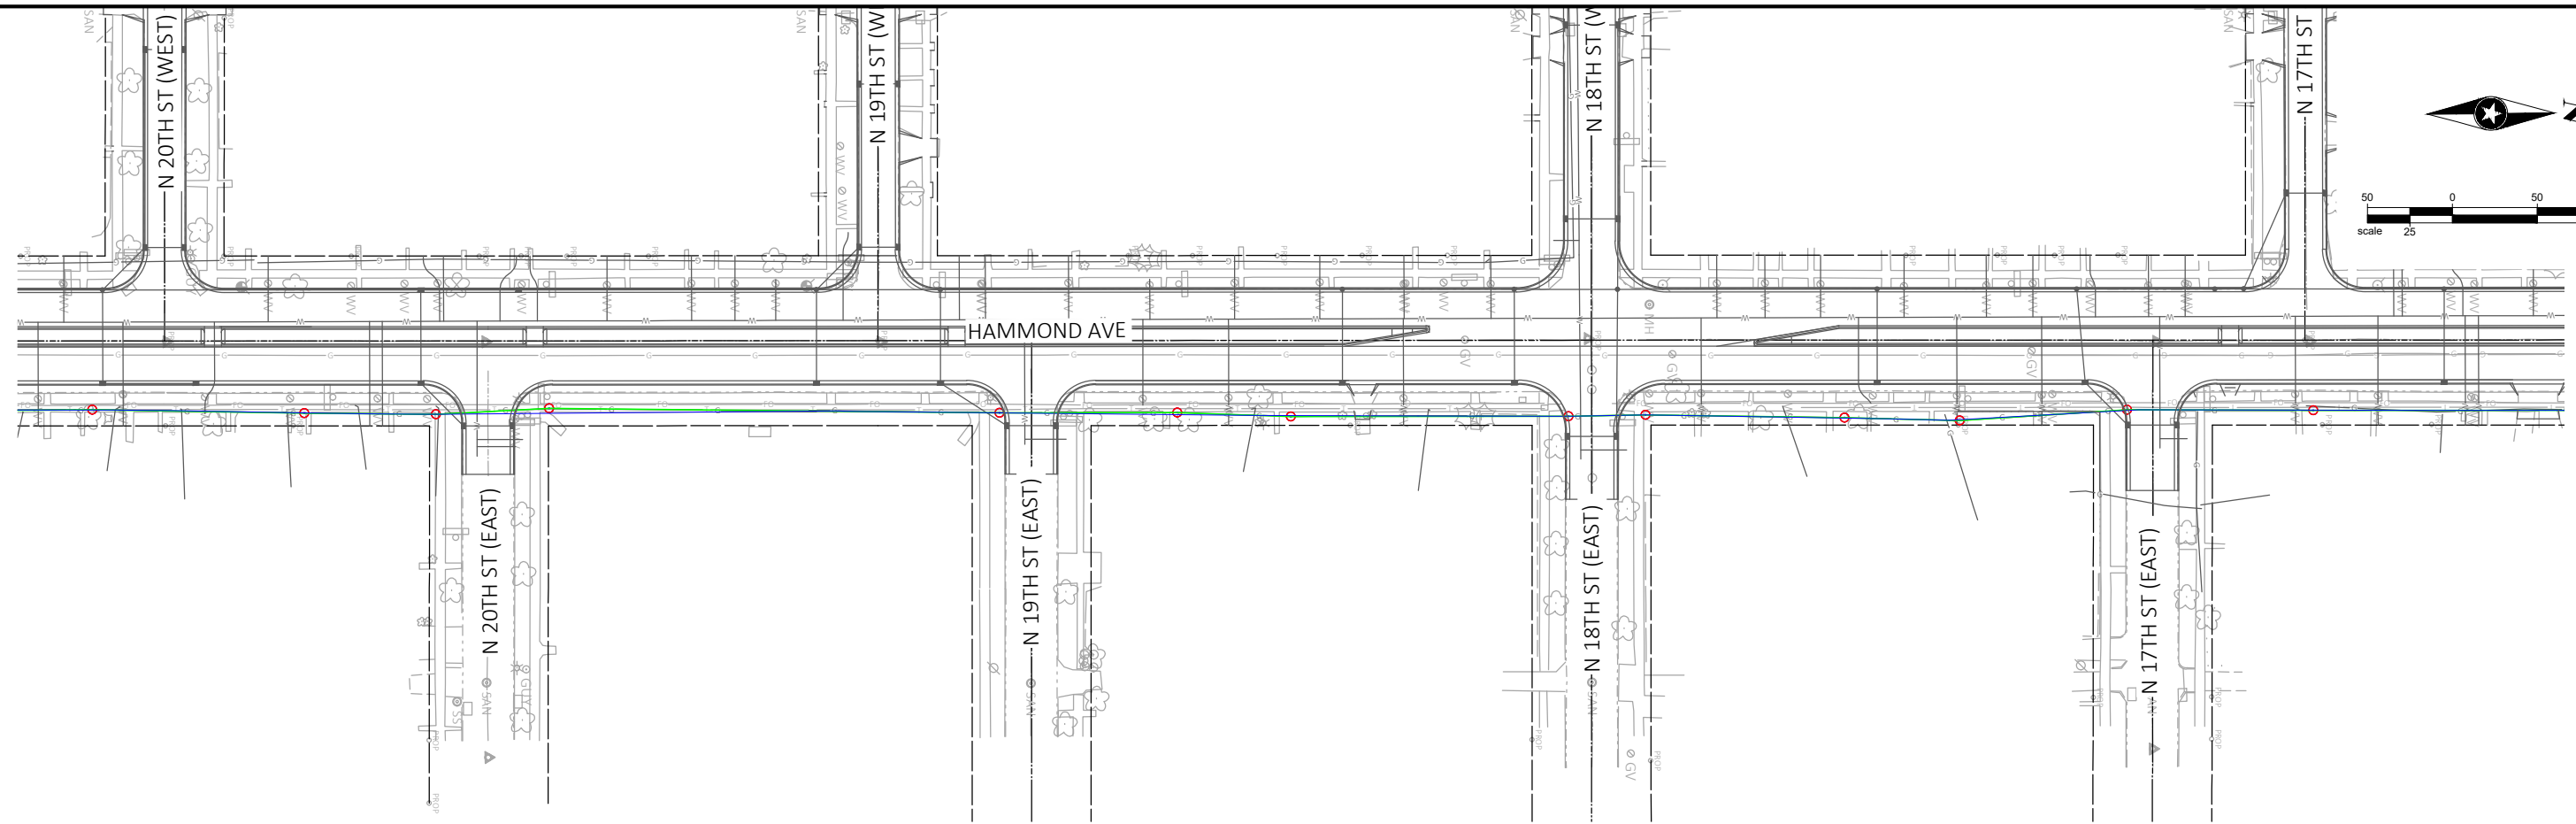


SEH Project	SARTE145169	Rev.#	Revision Issue Description	Date	Rev.#	Revision Issue Description	Date
Drawn By	-	.			.		
Designed By	-	.			.		
Checked By	-	.			.		


I HEREBY CERTIFY THAT THIS PLAN WAS PREPARED BY ME OR UNDER MY DIRECT SUPERVISION AND THAT I AM A DULY LICENSED LICENSE PROFESSIONAL UNDER THE LAWS OF THE STATE OF WISCONSIN.

LICENSE NAME: XX  
 DATE: XX-XX-XX  
 LICENSE NO. LICENSE NO.

Save: 2/22/2024 10:39 AM Iglendermng Plot: 2/22/2024 2:25 PM X:\PT\GIS\SUPER\1637285-final-dsgn\C3D\69980036\WaterPhase 1.dwg\exhibits\SU163728 EAST GAS MAIN EXHIBITS.dwg

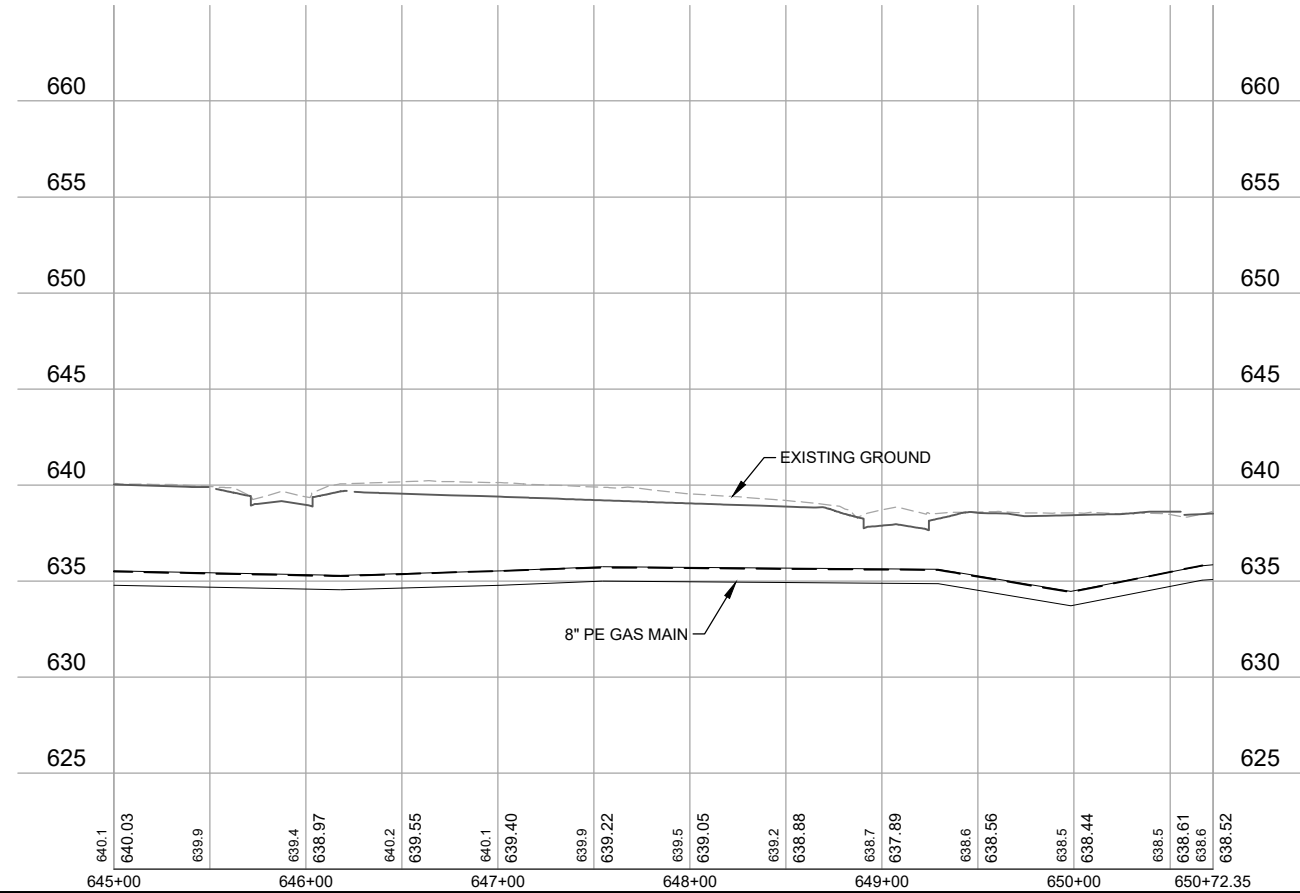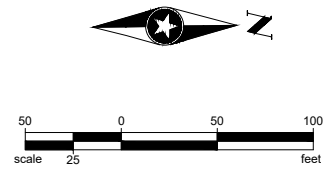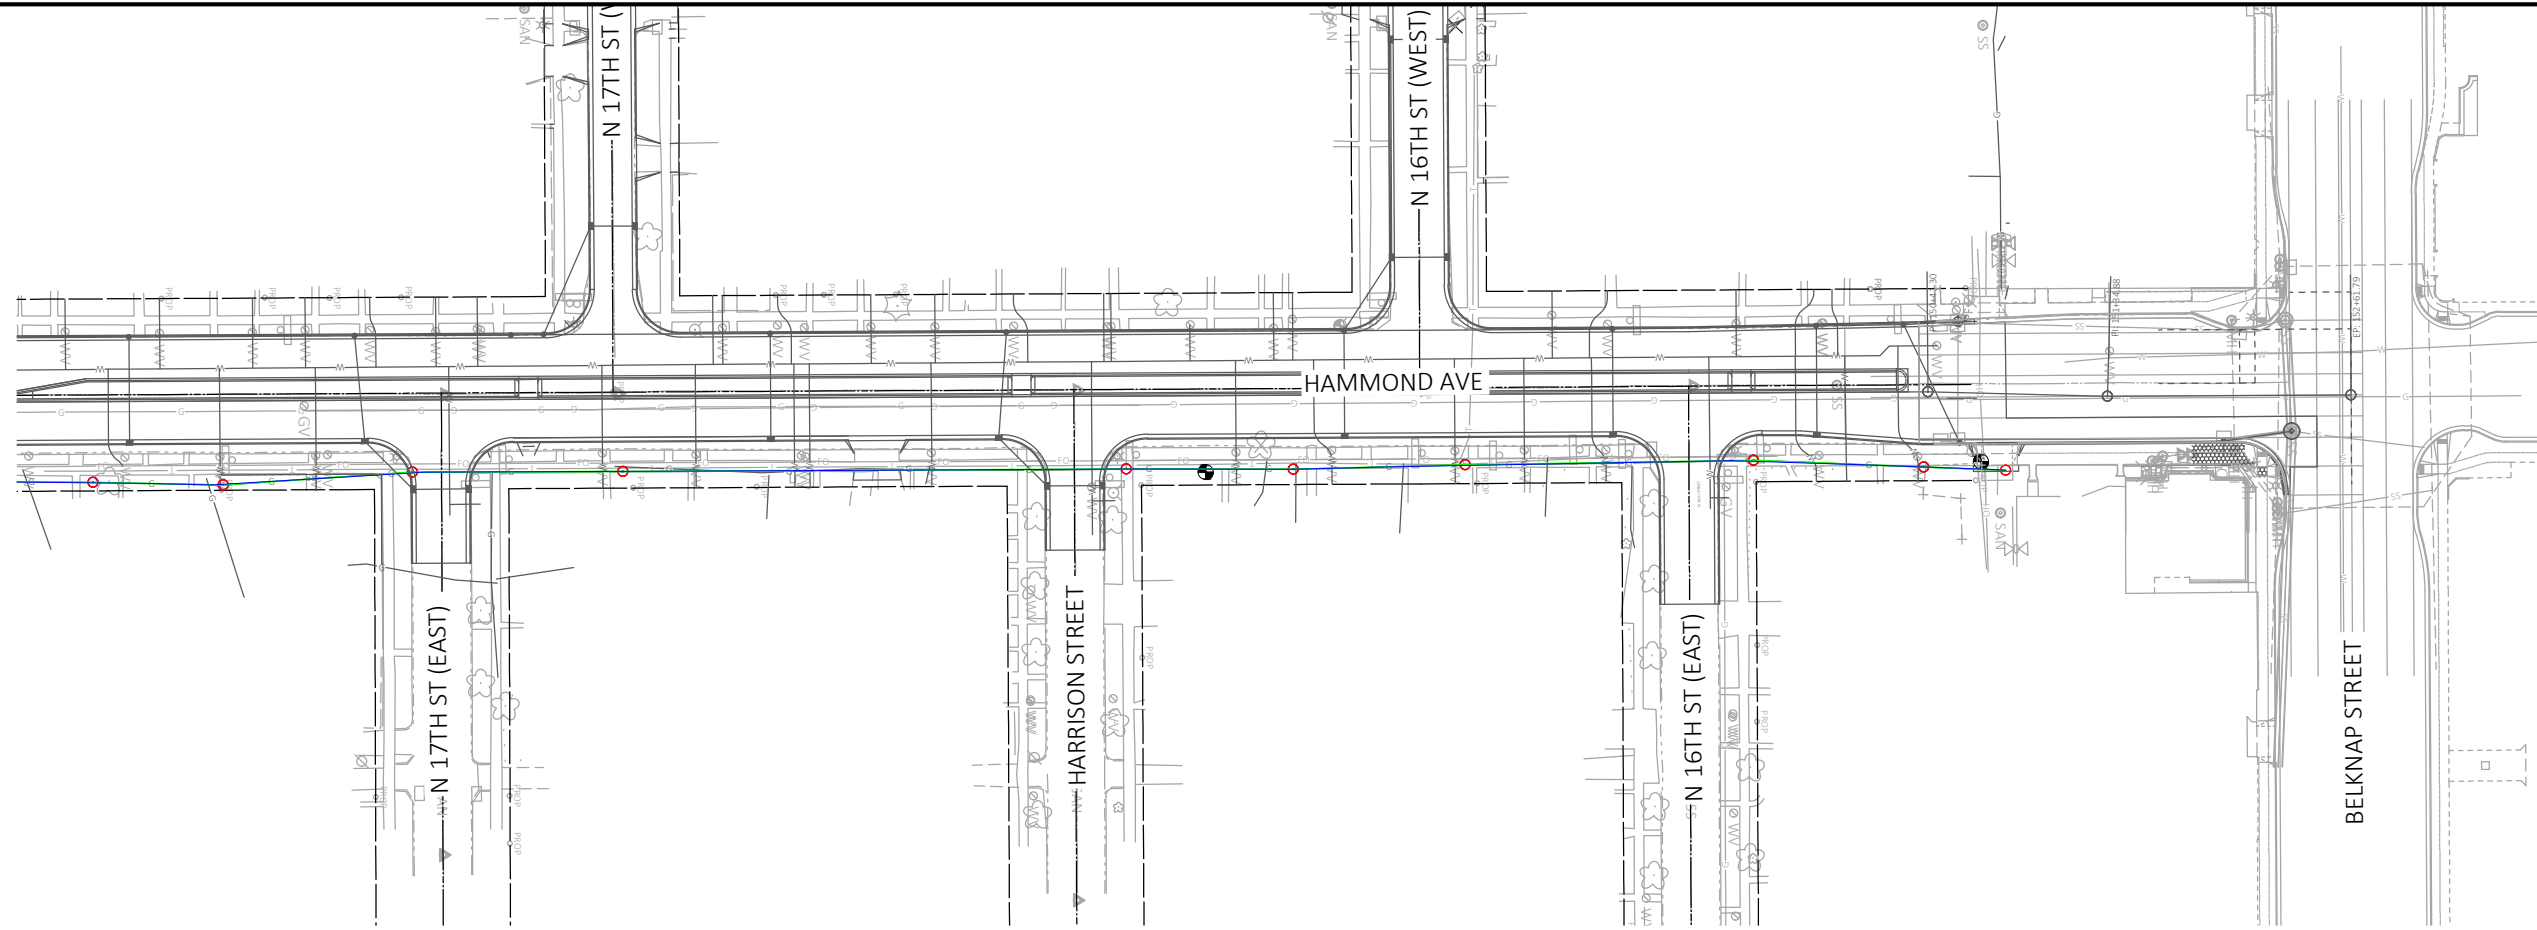




SEH Project	SARTE145169	Rev.#	Revision Issue Description	Date	Rev.#	Revision Issue Description	Date
Drawn By	-	.			.		
Designed By	-	.			.		
Checked By	-	.			.		


 I HEREBY CERTIFY THAT THIS PLAN WAS PREPARED BY ME OR UNDER MY DIRECT SUPERVISION AND THAT I AM A DULY LICENSED LICENSE PROFESSIONAL UNDER THE LAWS OF THE STATE OF WISCONSIN.  
 LICENSE NAME: XX  
 DATE: XX-XX-XX  
 LICENSE NO.: LICENSE NO.

**HAMMOND AVE. WATERMAIN**  
SUPERIOR, WISCONSIN

**EAST GAS MAIN**

Save: 2/22/2024 2:15 PM klgendanning Plot: 2/22/2024 2:26 PM X:\PT\GIS\SUPER\163728\5-final-dsgn\C3D\8980036\Water\Phase 1\dwg\exhibit\SU163728 WEST GAS MAIN EXHIBITS.dwg

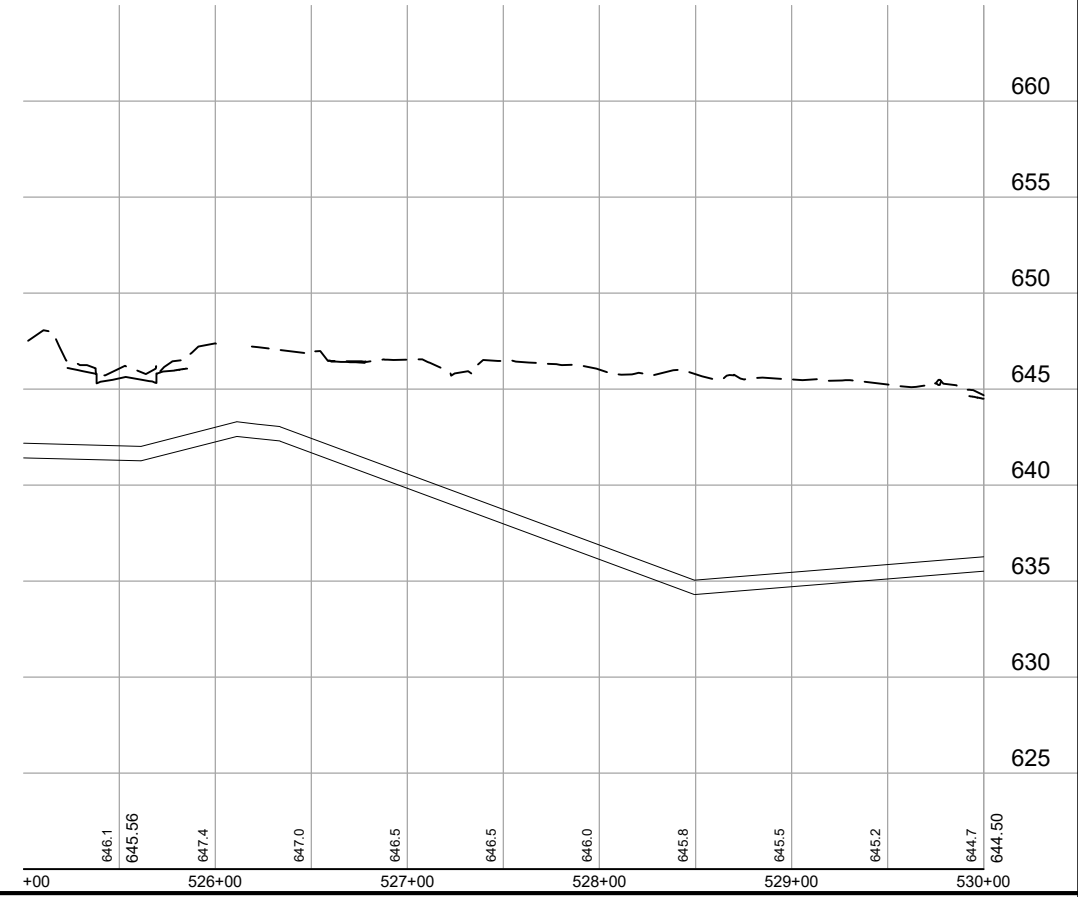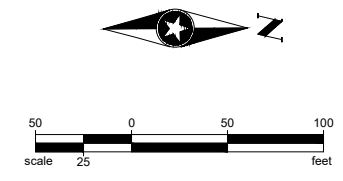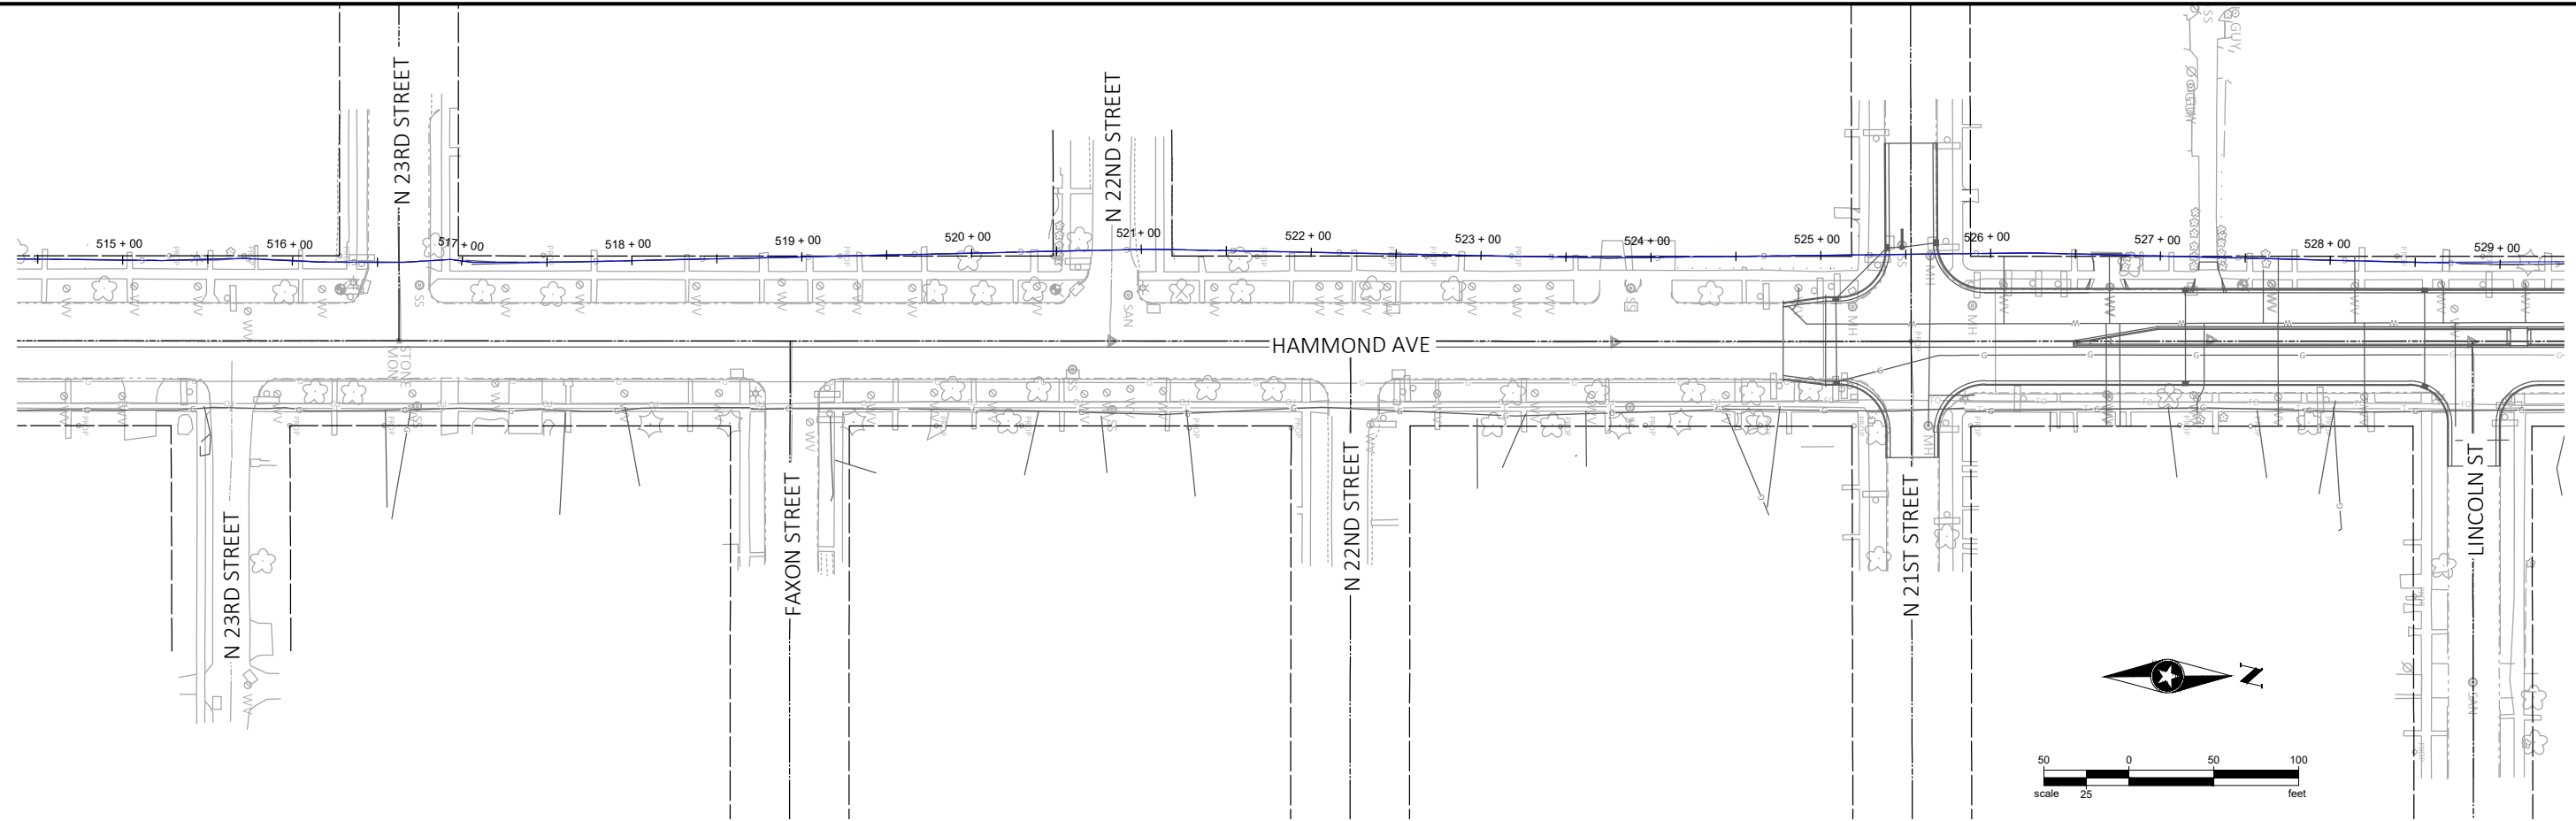

SEH Project	SARTE145169	Rev.#	Revision Issue Description	Date	Rev.#	Revision Issue Description	Date
Drawn By	-	.			.		
Designed By	-	.			.		
Checked By	-	.			.		



I HEREBY CERTIFY THAT THIS PLAN WAS PREPARED BY ME OR UNDER MY DIRECT SUPERVISION AND THAT I AM A DULY LICENSED LICENSE PROFESSIONAL UNDER THE LAWS OF THE STATE OF WISCONSIN.

LICENSE NAME: XX  
DATE: XX-XX-XX  
LICENSE NO. LICENSE NO.

**HAMMOND AVE. WATERMAIN**  
SUPERIOR, WISCONSIN


**WEST GAS MAIN**

Save: 2/22/2024 2:15 PM kjglendaming Plot: 2/22/2024 2:25 PM X:\PT\S\S\SUPER\163728\5-final-dsgn\C3D\8980036\Water\Phase 1\dwg\exhibit\SU163728 WEST GAS MAIN EXHIBITS.dwg

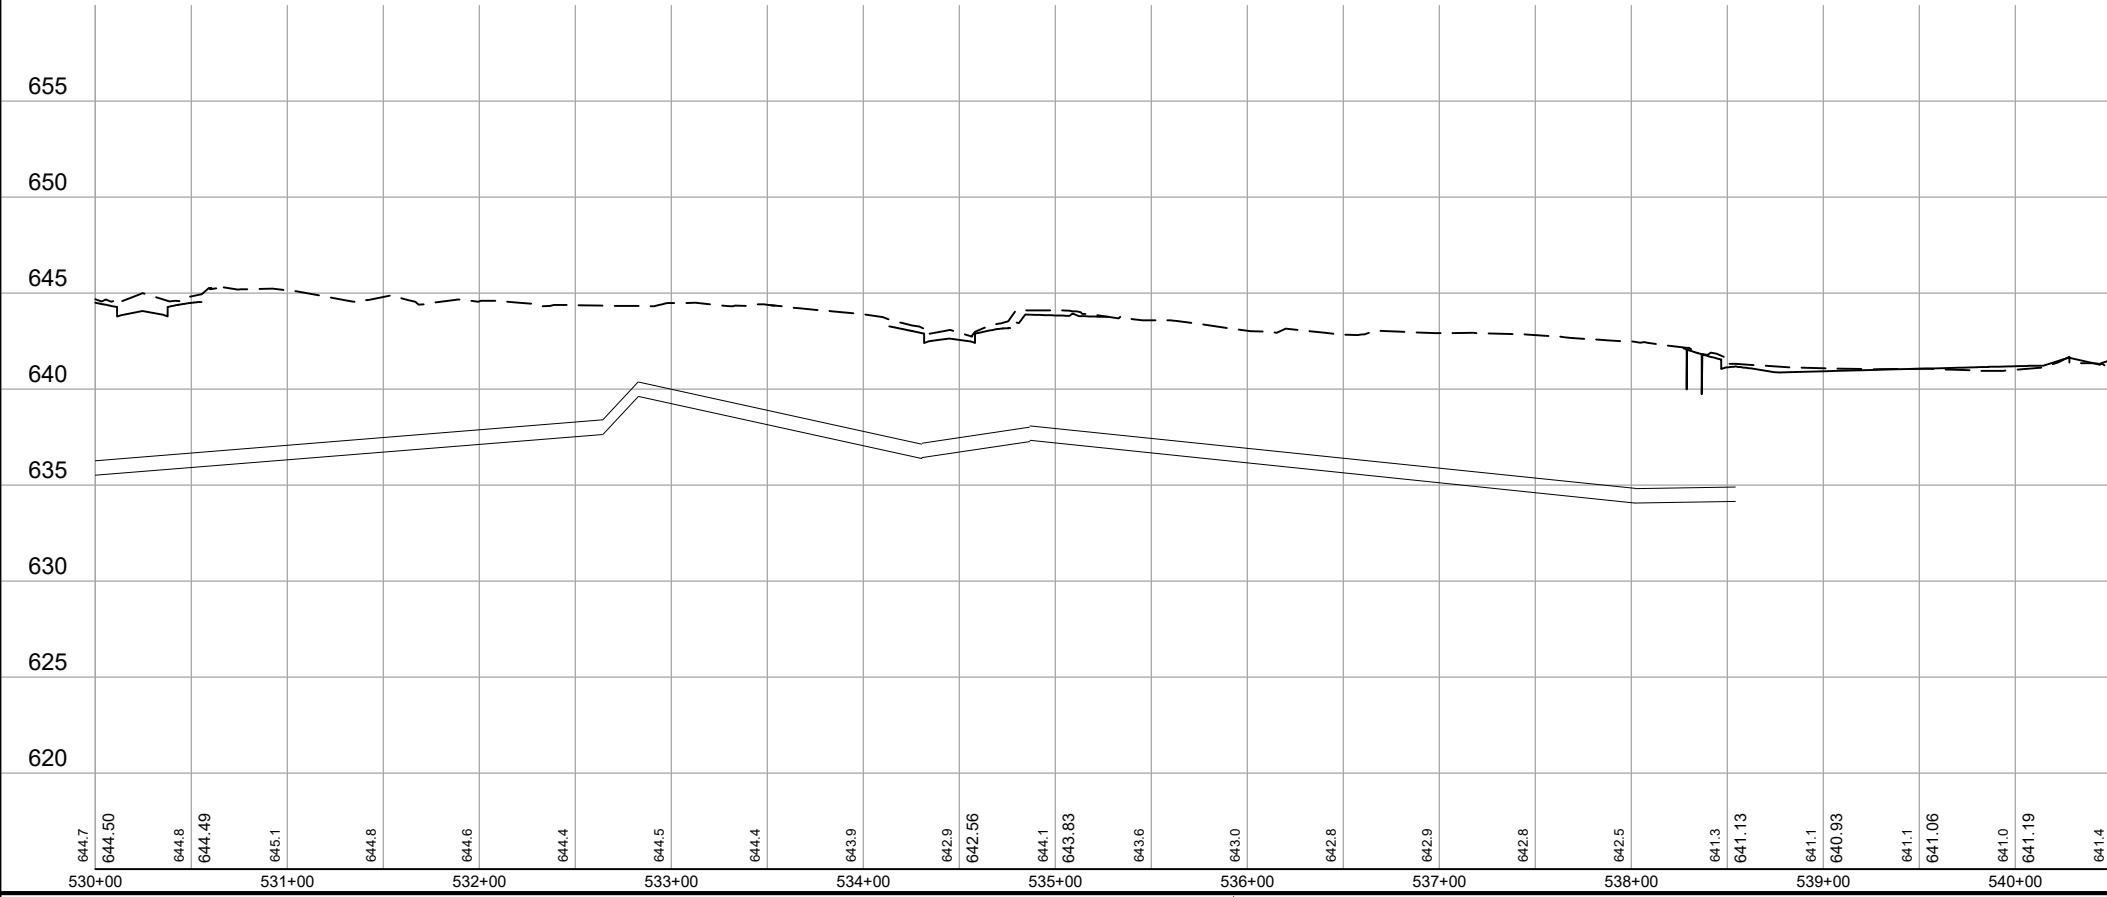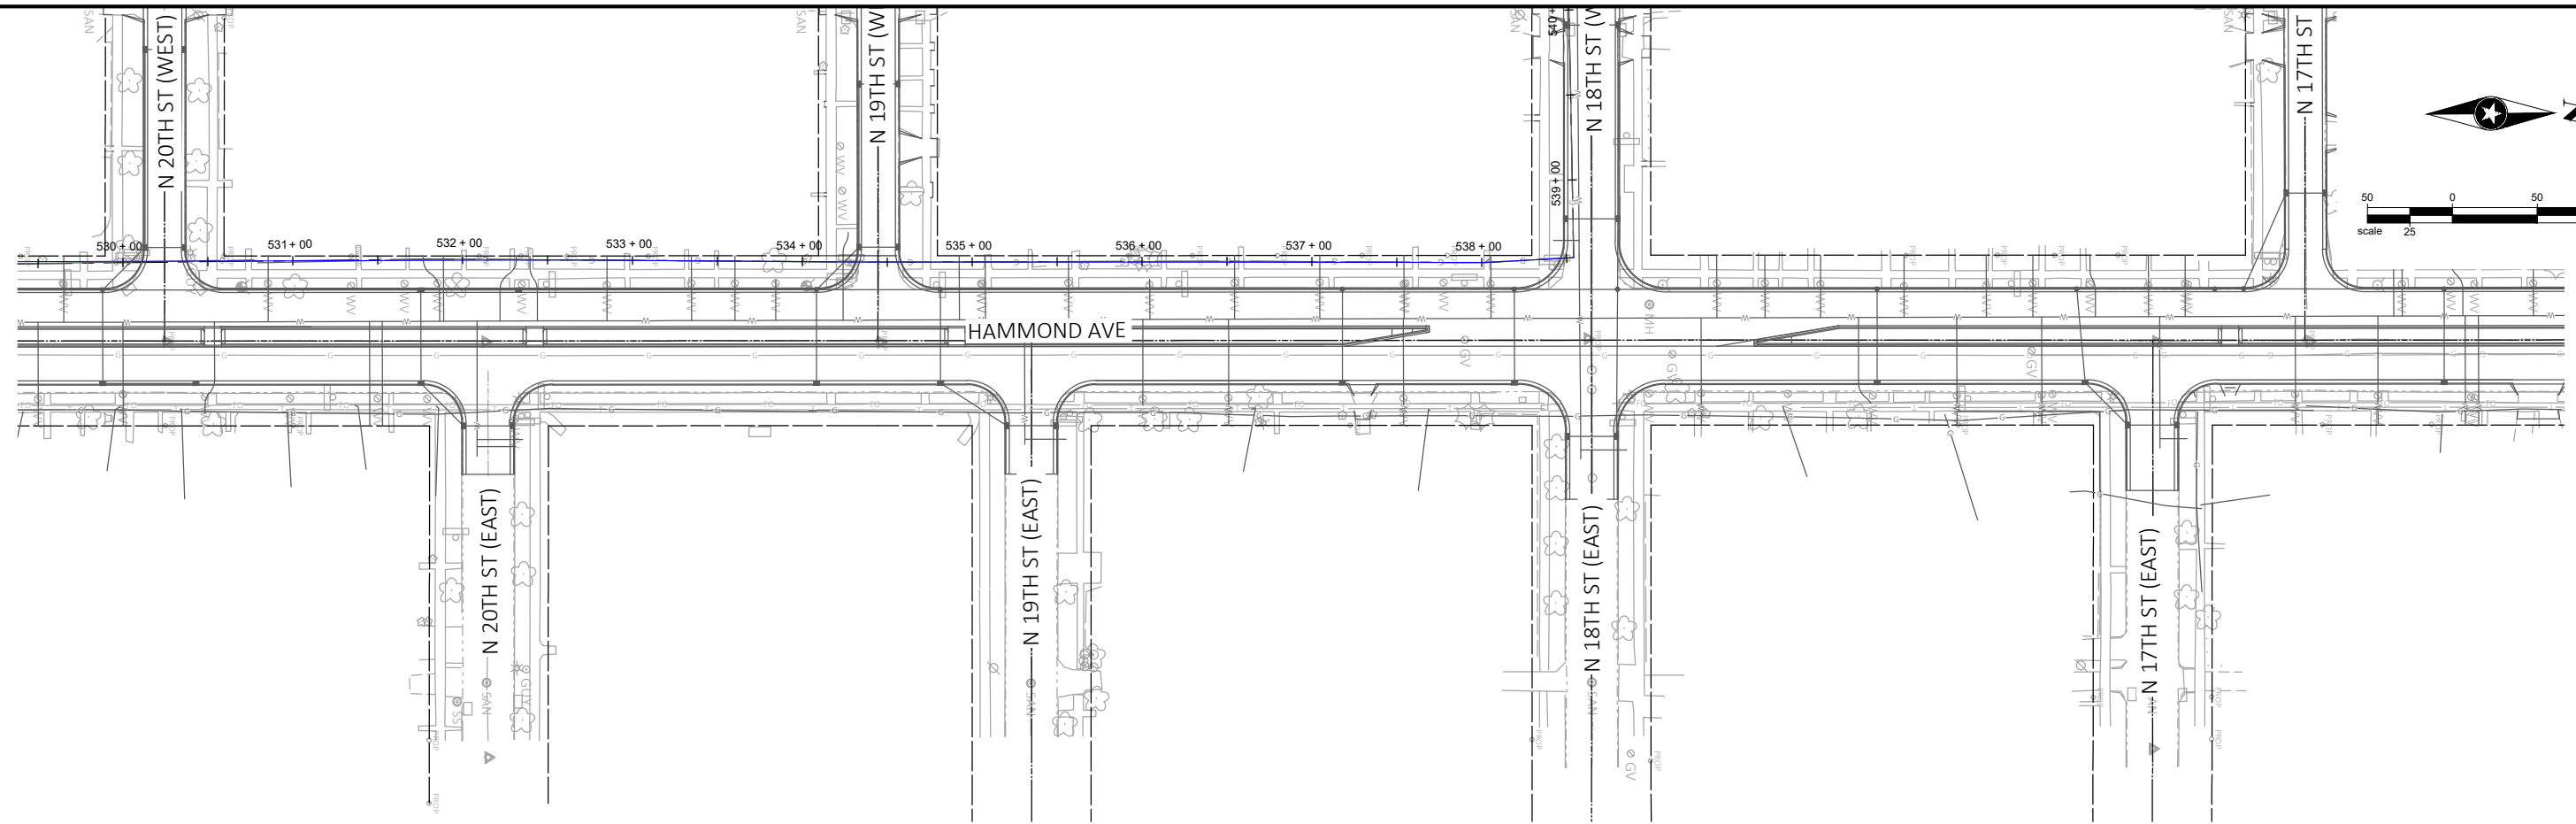

SEH Project	SARTE145169	Rev.#	Revision Issue Description	Date	Rev.#	Revision Issue Description	Date
Drawn By	-	.			.		
Designed By	-	.			.		
Checked By	-	.			.		

I HEREBY CERTIFY THAT THIS PLAN WAS PREPARED BY ME OR UNDER MY DIRECT SUPERVISION AND THAT I AM A DULY LICENSED LICENSE PROFESSIONAL UNDER THE LAWS OF THE STATE OF WISCONSIN.


 LICENSE NAME: XX  
 DATE: XX-XX-XX  
 LICENSE NO.: \_\_\_\_\_ LICENSE NO.: \_\_\_\_\_