


BELKNAP


ST.

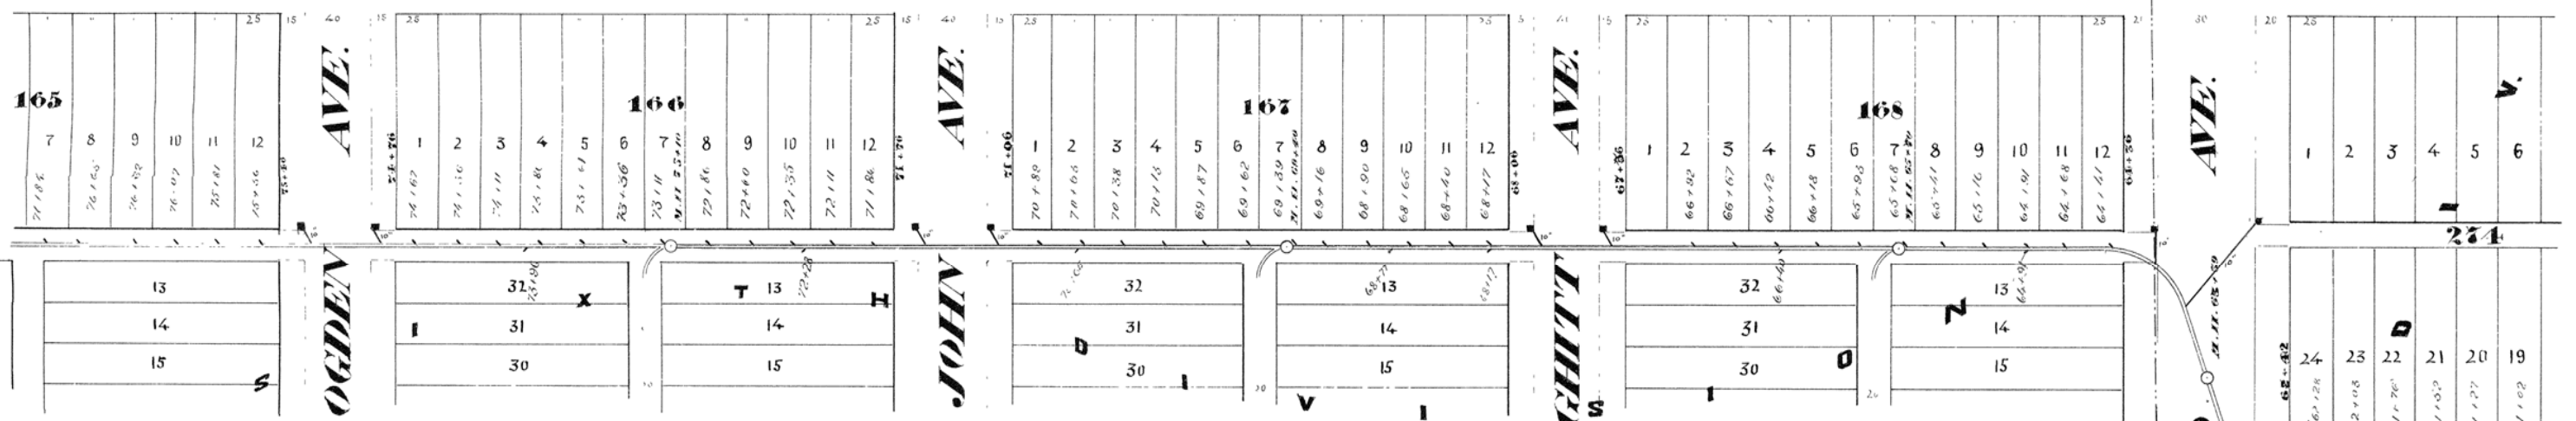


CITY OF SUPERIOR 1894

SEWER PLAN


Contract let June 15, 1890
 Copld. June 1, 1891
 Kirkland & Starkey, Contr.
 John Dailey, Inspector
 E. B. Banks, City Engr.

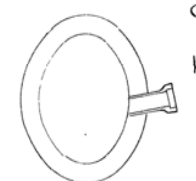


Section of 3'0" x 4'6" Sewer

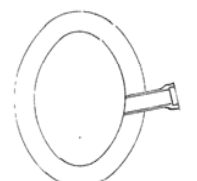

Section of 3'2" x 4'9" Sewer

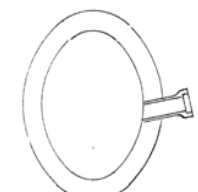


Section of 3'6" x 5'5" Sewer

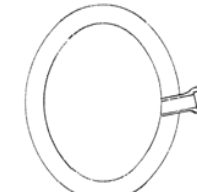

Section of 5'11" x 5'6" Sewer

Scale: { Horizontal 60' = 1"
 Vertical 4' = 1"
 Section 4' = 1"

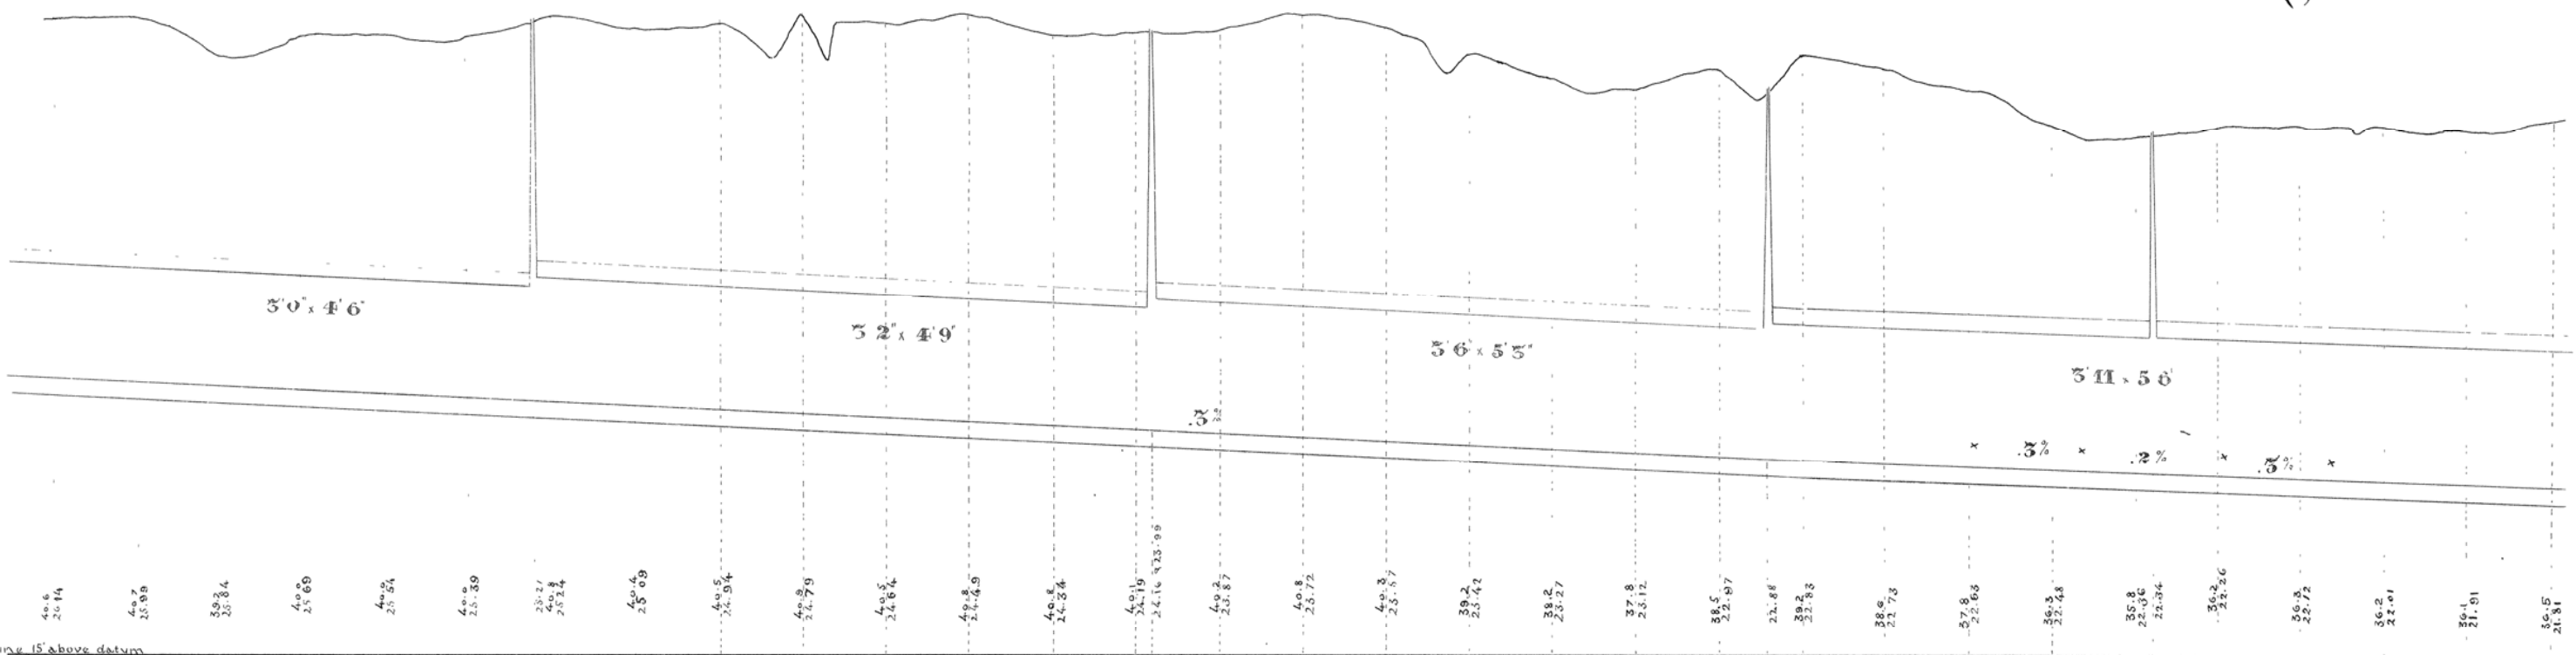

Base line 15' Above datum

76 75 74 73 72 71 70 69 68 67 66 65 64 63 62 61

Plan & Profile of Sewer in Alley South of Belknap St. from Hammond Ave. to Alley betw. Ogden & Tower Aves.

2A-32