


CITY OF SUPERIOR SEWER PLAN

Contract let April 16, 1891
completed Sept. 30, 1891
Kirkland & Starkey Contractor
James Nelson Inspector
E. B. Banks City Engineer.

Scale: { Horizontal 60' = 1'
Vertical 6' = 1'

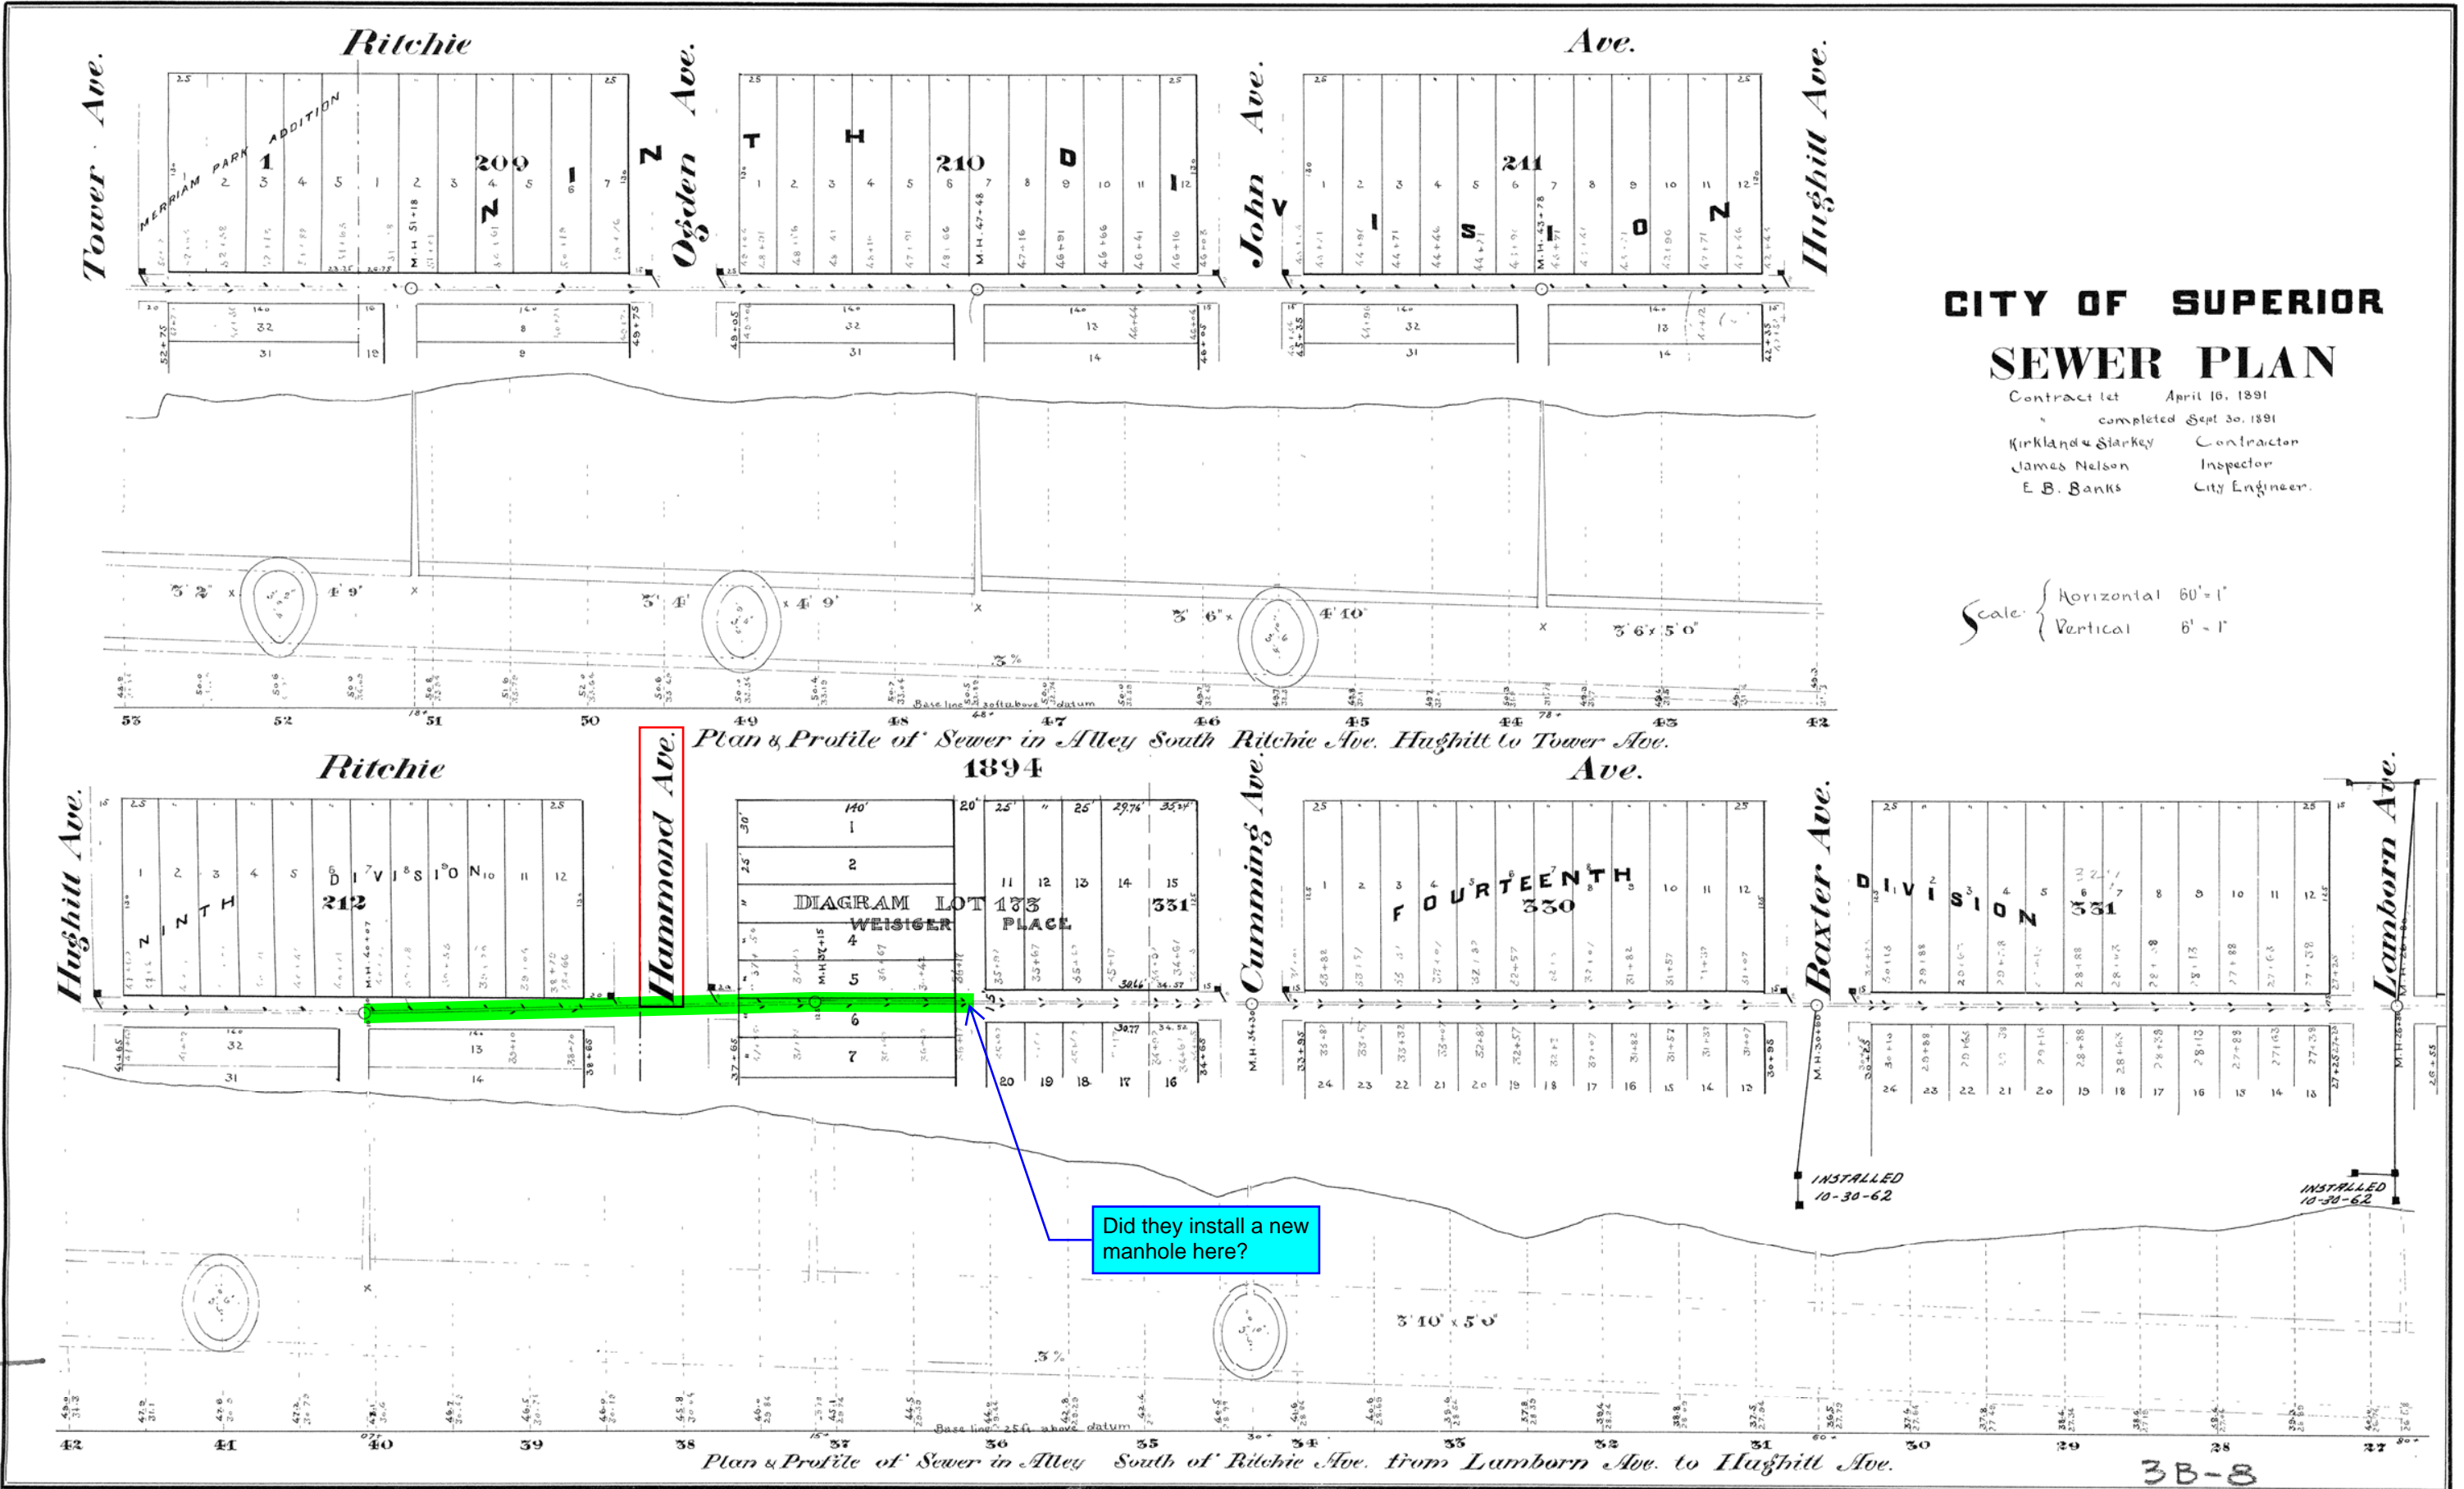

Did they install a new manhole here?

3B-8