


PROJECT: MAIN CONTROL BLDG.  
ADMINISTRATION & OPERATIONS  
51 EAST FIRST STREET  
SUPERIOR, WISCONSIN

| CERTIFICATIONS |            |
|----------------|------------|
| ARCHITECTURAL  | MECHANICAL |
| ELECTRICAL     | STRUCTURAL |

21 W. Superior Street  
Suite 500  
Duluth, MN 55802  
  
TEL 218/727-8446  
FAX 218/727-8456  
  
<http://www.LHBcorp.com>  
**DULUTH** • **MINNEAPOLIS**  
LHB PROJECT NO. 060565

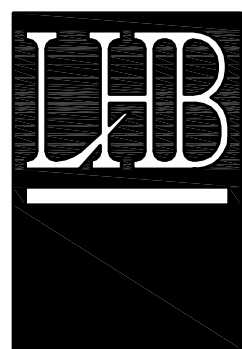

# OFFICE & STORAGE MEZZANINE INDEX

GENERAL  
TITLE, PROJECT LOCATION, CERTIFICATIONS.....1


ARCHITECTURAL  
CODE ANALYSIS, ABBREVIATIONS, & DOOR SCHEDULES.....2  
FLOOR PLAN AND DETAILS.....3

STRUCTURAL  
GENERAL NOTES & SCHEDULES.....4  
PLANS AND SECTIONS.....5

MECHANICAL  
SYMBOLS AND ABBREVIATIONS.....6  
FIRST FLOOR PIPING PLAN AND MECHANICAL SPACES.....7  
MEZZANINE LEVEL PIPING PLAN.....8  
FIRST FLOOR VENTILATION PLAN.....9

ELECTRICAL  
ELECTRICAL SYMBOLS AND ABBREVIATIONS.....10  
ELECTRICAL DEMOLITION PLAN.....11  
ELECTRICAL LIGHTING PLAN.....12  
ELECTRICAL POWER AND SYSTEMS PLAN.....13  
ELECTRICAL SPECIFICATIONS.....14

REVISION DATE: 09/05/07

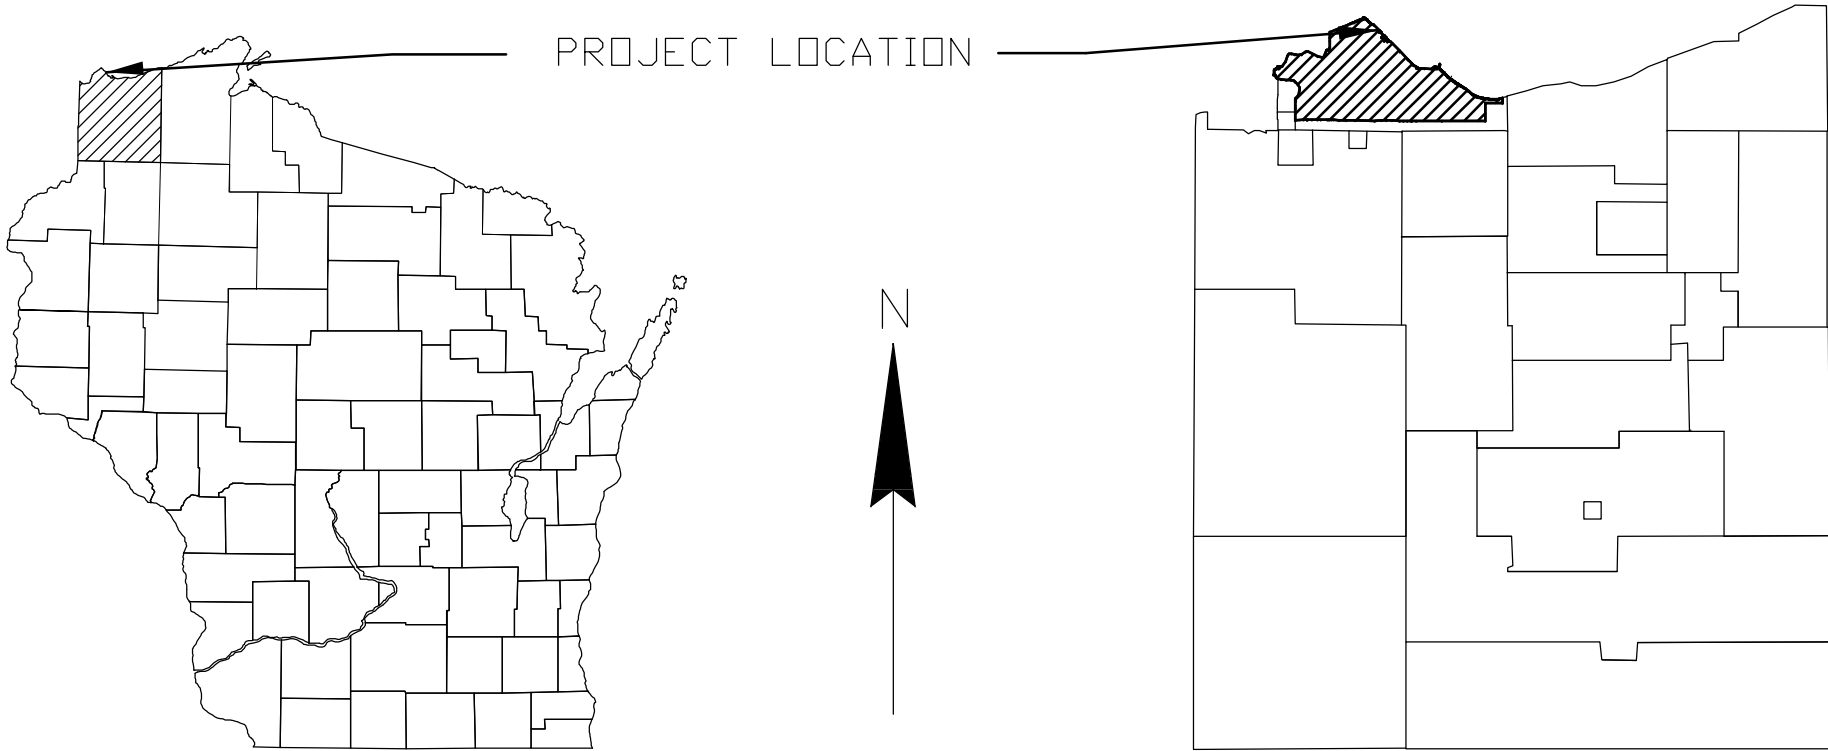

# ENVIRONMENTAL SERVICES DIVISION OF PUBLIC WORKS


21 W. Superior Street  
Suite 500  
Duluth, MN 55802

TEL 218/727-8446  
FAX 218/727-8456

http://www.LHBcorp.com

DULUTH • MINNEAPOLIS

LHB PROJECT NO. 060565

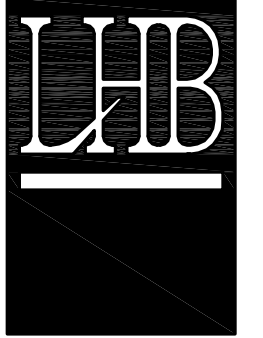















## MAIN CONTROL BUILDING - ADMINISTRATION & OPERATIONS 51 EAST FIRST STREET, SUPERIOR, WISCONSIN 54880

### ABBREVIATIONS

|                                |                              |   |                                 |
|--------------------------------|------------------------------|---|---------------------------------|
| A.B. Anchor Bolt               | EXP. Expansion, Exposed      | MET. Metal                                      | T. Tread, Toilet                |
| AC. Acoustic                   | EXP.JT. Expansion Joint      | MFR. Mounting, Meeting                          | TEMP. Tempered                  |
| AC.BD. Acoustic Board          | EXP.MATL. Expansion Material | MTG. Mounting, Meeting                          | T & G Tongue and Groove         |
| ADJ. Adjustable                | EXT. EXIST. Existing         | N. E. S. W. etc. North, East, South, West, etc. | Typ. Typical                    |
| A.F.F. Above Finished Floor    | F.B.P. Finish Birch Plywood  | N.I.C. Not In Contract                          | U. Urinal                       |
| ALT. Alternate                 | F.D. Floor Drain             | N.T.S. Not To Scale                             | V.C.T. Vinyl Composition Tile   |
| ALUM. Aluminum                 | F.F. Foundation              | NO. No.   | VERT. Vertical                  |
| A.P. Access Panel              | FR. Frame                    | O.C. On Center                                  | W/O Without                     |
| BD. Board                      | FIN. Finish                  | O.D. Outside Diameter                           | W.C. Water Closet               |
| BIT. Bituminous                | FL. FLR. Floor               | OP. Opening                                     | WD. Wood                        |
| BLDG. Building                 | F.P. Fireproofing            | OPP. Opposite                                   | WDW. Window                     |
| BLK. Block                     | FR. Frame                    | PERF. Perforated                                | W.G. Wire Glass                 |
| BLKG. Blocking                 | FTG. Footing                 | P.T.H. Paper Towel Holder                       | WPG. Waterproofing              |
| B.M. Bench Mark                | GA. Gauge                    | PL. Plate                                       | W.W.M. Welded Wire Mesh         |
| B.M. Beam                      | G.B. Grab Bar                | PLAS. Plaster                                   | At At                           |
| C.B. Catch Basin               | GALV. Galvanized             | PLAS.LAM. Plastic Laminate                      | Angle Angle                     |
| CBT. Cabinet                   | GEN.L. General               | PLYWD. Plywood                                  | Center Line Center Line         |
| C.I. Cast Iron                 | G.I. Galvanized Iron         | P.T.D. Paper Towel Dispenser                    | Channel Channel                 |
| C.J. Control Joint             | GL. Glass                    | PTN. Partition                                  | Plate Plate                     |
| C.T. Ceramic Tile              | GYP.BD. Gypsum Board         | PTCL.BD. Paint, Painted                         | Feet Feet                       |
| CEM. Cement                    | H.C. Hollow Core             | Q.T. Quarry Tile                                | Inches Inches                   |
| CEM. PLAS. Cement Plaster      | HDBD. Hardboard              | R. Riser, Radius                                | Number Number                   |
| CLG. Ceiling                   | HD. Handrail                 | R.D. Roof Drain                                 | Round, Diameter Round, Diameter |
| CLR. Clear                     | HDW. Hardware                | REIN. Reinforce, Reinforcing                    |                                 |
| COL. Column                    | HDWD. Hardwood               | REV. Reverse                                    |                                 |
| COMP. Composition              | HT. Height                   | RM. Room  |                                 |
| CONC. Concrete                 | H.M. Hollow Metal            | R.O. Rough Opening                              |                                 |
| CONC. BLK. Concrete Block      | HORIZ. Horizontal            | R.S. Rough Sawn                                 |                                 |
| CONT. Continuous               | I.D. Inside Diameter         | RUBB. Rubber                                    |                                 |
| CONTR. Contractor              | INT. Interior                | S.C. Solid Core                                 |                                 |
| CPT. Carpet                    | INSUL. Insulation            | S.G.T. Structural Glazed Tile                   |                                 |
| DBL. Double                    | INT. Interior                | SIM. Similar                                    |                                 |
| DET. Detail                    | JAN. Janitor                 | SPEC. Specification, Special                    |                                 |
| D.F. Drinking Fountain         | JST. Joint                   | SQ.FT. Square Foot                              |                                 |
| DIA. Diameter                  | JT. Joint                    | STL. Steel                                      |                                 |
| DM. Dimension                  | LAV. Lavatory                | STOR. Storage                                   |                                 |
| DN. Down                       | MATL. Material               | STRUCT. Structural                              |                                 |
| DR. Door                       | MAX. Maximum                 | SUSP. Suspended                                 |                                 |
| D.S. Down Spout                | MCH. Mechanical              | SUSP.AC.B. Acoustic Board                       |                                 |
| EA. Each                       | M.H. Manhole                 | SUSP.AC.T. Suspended                            |                                 |
| E.F. Each Face                 | MIN. Minimum, Minute         | SUSP.AC.T. Acoustic Tile                        |                                 |
| ELEC. Electrical               | MINTL. Mineral               | SUSP.GYP.BD. Suspended Gypsum Board             |                                 |
| EL., ELEV. Elevation, Elevator | M.O. Masonry Opening         |   |                                 |
| EQUIP. Equipment               | M.R. Moisture Resistant      |   |                                 |
| E.W. Each Way                  |                              |   |                                 |
| E.W.C. Elect. Water Cooler     |                              |   |                                 |

### MATERIALS SYMBOLS

|   |                           |   |                             |
|---|---------------------------|---|-----------------------------|
|  | FACE BRICK                |  | PLYWOOD                     |
|  | CONCRETE BLOCK            |  | WOOD BLOCKING               |
|  | WOOD STUD PARTITION       |  | FINISH WOOD                 |
|  | METAL STUD PARTITION      |  | GYPSUM BOARD OR PLASTER     |
|  | BATT INSULATION           |  | METAL-LARGE SCALE           |
|  | EXTERIOR RIGID INSULATION |  | STONE                       |
|  | RIGID INSULATION          |  | EXISTING (DETAILS/SECTIONS) |

### GENERAL NOTES

- CONTRACTOR SHALL VISIT THE SITE AND APPRAISE HIMSELF/HERSELF OF THE EXISTING CONDITIONS AND SEQUENCE FOR INSTALLATION. DRAWINGS ARE NOT TO BE SCALED. CONTRACTOR MUST VERIFY ALL DIMENSIONS AND FIELD CONDITIONS PRIOR TO COMMENCING THE WORK.
- MATERIALS COMMON TO SEVERAL DRAWINGS MAY BE NOTED ON ONLY ONE DRAWING.
- CONTRACTOR RESPONSIBLE FOR ENTIRE SET OF DOCUMENTS.
- CONTRACTOR SHALL BE RESPONSIBLE FOR MAINTAINING SAFE WORKING CONDITIONS OR AREAS FOR EMPLOYEES AND ALL OTHER PERSONS AT THE SITE.
- ALL WORK TO CONFORM TO STATE AND LOCAL CODES.
- REPORT ANY DISCREPANCIES TO OWNER.
- BEFORE STARTING ANY OPERATION, EACH CONTRACTOR SHALL EXAMINE WORK PERFORMED BY OTHERS TO WHICH HIS OR HER WORK ADJOINS OR IS APPLIED & WILL REPORT TO THE OWNER ANY CONDITIONS THAT WILL PREVENT SATISFACTORY ACCOMPLISHMENT OF THE CONTRACT.
- CLEAN UP - UPON COMPLETION OF THE WORK, THE BUILDING, THE PREMISES & THE ADJOINING AREAS SHALL BE MADE NEAT, DELIVERED CLEAN, WHOLE, TIGHT, & FIT FOR IMMEDIATE OCCUPANCY. EACH INDIVIDUAL CONTRACTOR IS RESPONSIBLE AFTER THEIR WORK COMPLETION TO CLEAN UP & MAKE AREAS NEAT THAT WERE AFFECTED BY THEIR WORK.
- CONTRACTOR FOR THE PROJECT SHALL BE RESPONSIBLE FOR OBTAINING ALL REQUIRED BUILDING PERMITS.

### DOOR SCHEDULE

| NUMBER | DOOR LOCATION         | DOOR SIZE     | MATERIAL |      | FRAME    |      | DETAILS   |           |        | HARDWARE GROUP | GLASS    | RATING  | REMARKS         |
|--------|-----------------------|---------------|----------|------|----------|------|-----------|-----------|--------|----------------|----------|---------|-----------------|
|        |                       |               | TYPE     | TYPE | MATERIAL | TYPE | HEAD/JAMB | THRESHOLD | LINTEL |                |          |         |                 |
| 103    | LARGE VEHICLE STORAGE | 3'-0" x 6'-8" | H.M.     | 1    | H.M.     | F1   | -         | -         | -      | -              | 4" x 24" | 90 MIN. | SEE NOTES BELOW |
| 103A   | OFFICE                | 3'-0" x 6'-8" | H.M.     | 1    | H.M.     | F1   | -         | -         | -      | -              | 4" x 24" | N.A.    | SEE NOTES BELOW |
| 103B   | SAFETY SUPPLY STORAGE | 3'-0" x 6'-8" | H.M.     | 1    | H.M.     | F1   | -         | -         | -      | -              | 4" x 24" | N.A.    | SEE NOTES BELOW |

#### HARDWARE NOTES:

**INTERIOR METAL DOORS - TYPE 1:**  
MANUFACTURER - CURRIES ESSEX - MASON CITY, IA 50401.  
R 6666, 36" METAL DOOR W/ 45 MIN. FIRE RATING (C), SWINGING FIRE DOOR.  
GRADE III, EXTRA HEAVY DUTY, MODEL 1 - FULL FLUSH, W/ 1/2" THICK 4"x24" DIAMOND WIRE GLASS, PRIMED. DOOR IN ACCORDANCE WITH REQUIREMENT OF SDI 100.  
MATCH EXISTING INTERIOR METAL DOORS.

**STEEL DOORS & FRAMES - TYPE F1:**  
CONSTRUCTION MITERED AND WELDED CORNERS, MINIMUM THICKNESS 16 GAUGE.  
DRILL STOPS TO RECEIVE SILENCERS. PRIMED.  
MATCH EXISTING INTERIOR METAL FRAMES

**LOCKS, LATCHES & BOLTS:**  
MANUFACTURER - SARGENT. LEVER HANDLE STYLE LNH, SERIES 8100, SATIN FINISH. (630)  
MATCH EXISTING LOCK, LATCH AND BOLTS. RE-KEY EXISTING GARGAGE HALL DOOR (FOR PARTS ROOM) AND NEW OFFICE DOOR TO ESPDW MASTER, SUB-MASTER AND NEW KEY.  
NEW GARAGE HALL DOOR AND SAFETY SUPPLY ROOM DOORS TO ESPDW MASTER, SUB-MASTER AND EXISTING OUTSIDE DOOR KEY.

**HINGES:**  
MANUFACTURER - HAGER, INTERIOR DOOR BALL BEARING BUTT HINGES BB1279.  
MATCH EXISTING HINGES.

**CLOSERS:**  
MANUFACTURER - SARGENT, SERIES 350 CLOSER. 180 DEGREE SWING.  
MATCH EXISTING CLOSERS

**KICKPLATE:**  
STAINLESS STEEL, 0.050 INCH THICK, SATIN FINISH (630)  
10 INCHES HIGH x 2" LESS THAN DOOR WIDTH.  
MATCH EXISTING KICKPLATES

### CODE ANALYSIS OF EXISTING BUILDING

|                        |                                  |
|------------------------|----------------------------------|
| CONSTRUCTION TYPE:     | IIA                              |
| OCCUPANCY TYPE:        | S1                               |
| FIRE PROTECTION:       | NONE                             |
| NEW SF:                | 526                              |
| OCCUPANCY SEPARATIONS: | NO NEW (ACCESSORY USE)           |
| FIRE WALLS:            | 2 HR EXISTING, INDICATED ON PLAN |
| EGRESS:                | UNCHANGED                        |

**BRIEF DESCRIPTION:**  
526 SF MEZZANINE CONSTRUCTED ABOVE NEW ENCLOSED ACCESSORY OFFICE SPACE. ALL CONSTRUCTION OCCURS WITHIN EXISTING BUILDING LIMITS.

### CLIENT

STEVE ROBERTS, ESD ENGINEERING MANAGER  
PH: 715-394-0392  
51 EAST FIRST STREET  
SUPERIOR, WI 54880

### ARCHITECT / DESIGNERS

STRUCTURAL ENGINEER (CONTACT)  
ALAN J. VORDERBRUGGEN  
218-727-8446 X 2254 FAX 218-727-8456  
E-MAIL: ALAN.VORDERBRUGGEN@LHBCORP.COM


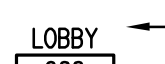

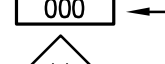
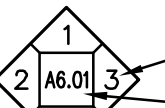

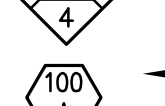

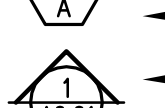

ARCHITECT  
KEVIN HOLM  
218-727-8446 X 2417 FAX 218-727-8456  
E-MAIL: KEVIN.HOLM@LHBCORP.COM

CERTIFIED INTERIOR DESIGNER  
AARON HANSEN  
218-727-8446 X 2400 FAX 218-727-8456  
E-MAIL: AARON.HANSEN@LHBCORP.COM

MECHANICAL ENGINEER  
STEWART CRAN  
218-727-8446 X 2435  
E-MAIL: STEWART.CRAN@LHBCORP.COM


ELECTRICAL ENGINEER  
LINNEA WEYANDT  
218-727-8446 X 2439  
E-MAIL: LINNEA.WEYANDT@LHBCORP.COM

### REFERENCE SYMBOLS

|   |                  |   |                  |
|---|------------------|---|------------------|
|  | DETAIL NUMBER    |  | ROOM NAME        |
|  | SHEET NUMBER     |  | ROOM NUMBER      |
|  | SECTION NUMBER   |  | WINDOW TYPE      |
|  | ELEVATION NUMBER |  | ELEVATION MARKER |
|  | DOOR NUMBER      |  | WALL TYPE        |


### FINISH NOTES

- ALL PAINT FINISH OF METAL PARTS FOR DUCTS, FRAMES, DOORS, HANDRAILS, ETC, SHALL BE BENJAMIN MOORE'S PORCH & FLOOR URETHANE REINFORCED ALKYD ENAMEL - HAMILTON BLUE. MATCH EXISTING DOOR & HANDRAIL PAINT.
- ALL CEILING DIFFUSERS AND REGISTERS SHALL BE PAINTED TO MATCH CEILING, UNLESS OTHERWISE NOTED.
- FLAME SPREAD RATINGS FOR INTERIOR FINISHES TO BE CLASS THREE (3) OR BETTER.
- ALL PAINT SHALL BE QUALITY TYPE CALLED FOR BY THE OWNER APPLIED IN ACCORDANCE WITH FOR MFR SPECIFICATIONS FOR THE PARTICULAR SURFACE. WALL PAINT TO BE SHERWIN - WILLIAMS SW1032 CITY LOFT (LATEX). MATCH EXISTING WALL PAINT.
- ALL WALL FINISH SURFACES TO BE DUSTED OF ALL FOREIGN MATERIAL AND PROPERLY PREPARED PRIOR TO APPLICATION OF WALL FINISH.
- ALL PAINTS TO BE APPLIED WITH (2) COATS OF FINISH PAINT OVER 2 COATS OF PRIMER OR BLOCK FILLER AS REQUIRED ON WALLS AND CEILING.
- CONTRACTOR IS RESPONSIBLE FOR MAINTAINING A CLEAN TRANSITION AT POINTS WHERE NEW AND EXISTING CONSTRUCTION INTERSECT.
- PAINING CONTRACTORS APPLICATION OF WALL FINISH CONSTITUTES ACCEPTANCE OF WALL CONDITION AND RESPONSIBILITY FOR IMPERFECTION CORRECTION.
- CLEAN SEAL EXISTING CONCRETE FLOORING AT AREAS OF WORK FOR NEW FLOOR FINISH. INSTALL RESILIENT COVE BASE 4" RUBBER AT PERIMETER OF EACH ROOM.
- PATCH AND REPAIR ANY AND ALL FLOORS, WALLS, CEILINGS, ETC IN A WORKMANSHIP LIKE MANNER TO MATCH THE SURROUNDING SURFACE AREAS WHERE THERE IS DAMAGE BECAUSE OF REMOVAL OR REPLACEMENT OF EXISTING CONDITIONS.
- ALL FIRE RATED WALLS PENETRATED ARE REQUIRED TO BE FIRESTOPPED
- CONTRACTOR FOR THE PROJECT SHALL TAKE CARE TO PROTECT NEWLY INSTALLED MATERIALS AND FINISHES.
- MATERIAL AND FINISHES SHALL BE APPLIED TO ALL SURFACES WITHIN THE CONSTRUCTION LIMITS, INCLUDING 103 NORTH END, 103A, 103B, AND 103C AND MEZZANINE LEVEL, AND AS REQUIRED IN CORRIDOR OUTSIDE DOOR 103. ALL WALL AND CEILING SURFACES TO BE FINISHED TO MATCH EXISTING.

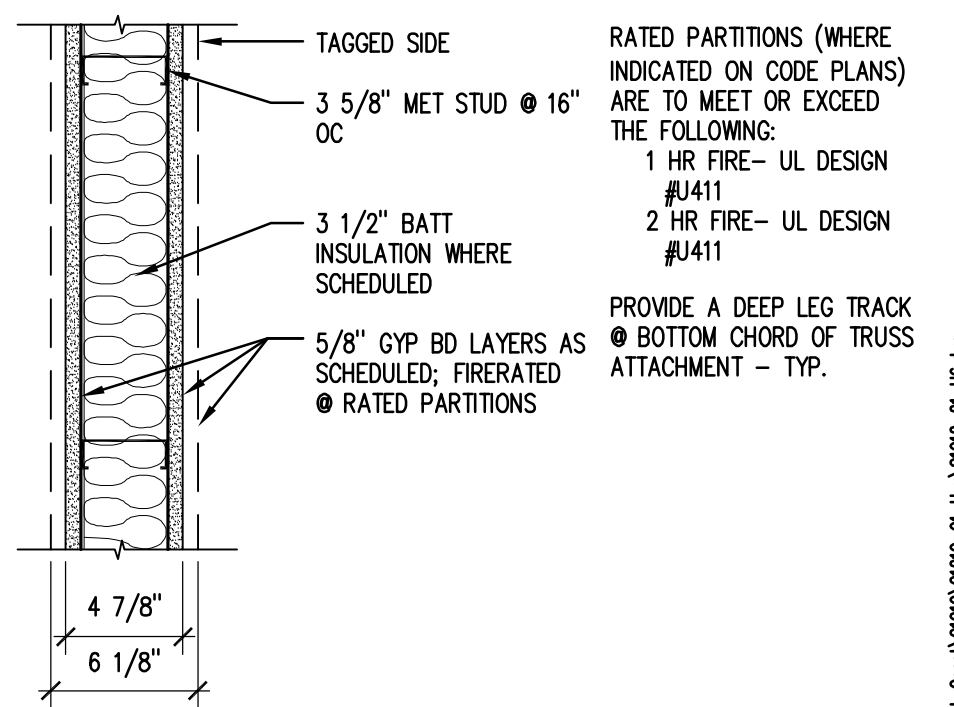


RATED PARTITIONS (WHERE INDICATED ON CODE PLANS) ARE TO MEET OR EXCEED THE FOLLOWING:  
 1 HR FIRE- UL DESIGN #J411  
 2 HR FIRE- UL DESIGN #J411  
 PROVIDE A DEEP LEG TRACK @ BOTTOM CHORD OF TRUSS ATTACHMENT - TYP.

**M3 WALL TYPE M3**  
 1 1/2"=1'-0"

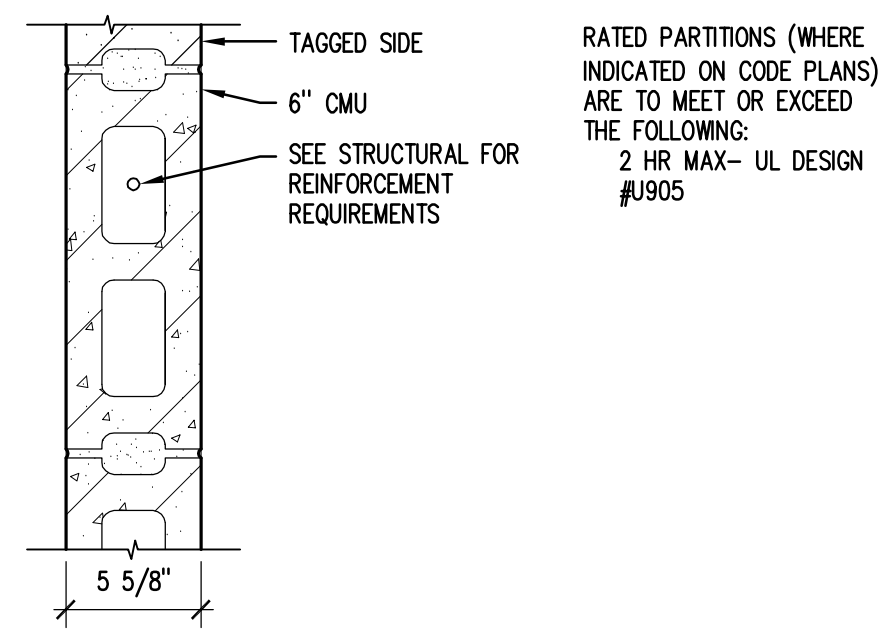


RATED PARTITIONS (WHERE INDICATED ON CODE PLANS) ARE TO MEET OR EXCEED THE FOLLOWING:  
 2 HR MAX- UL DESIGN #J905


**U6 WALL TYPE U6**  
 1 1/2"=1'-0"

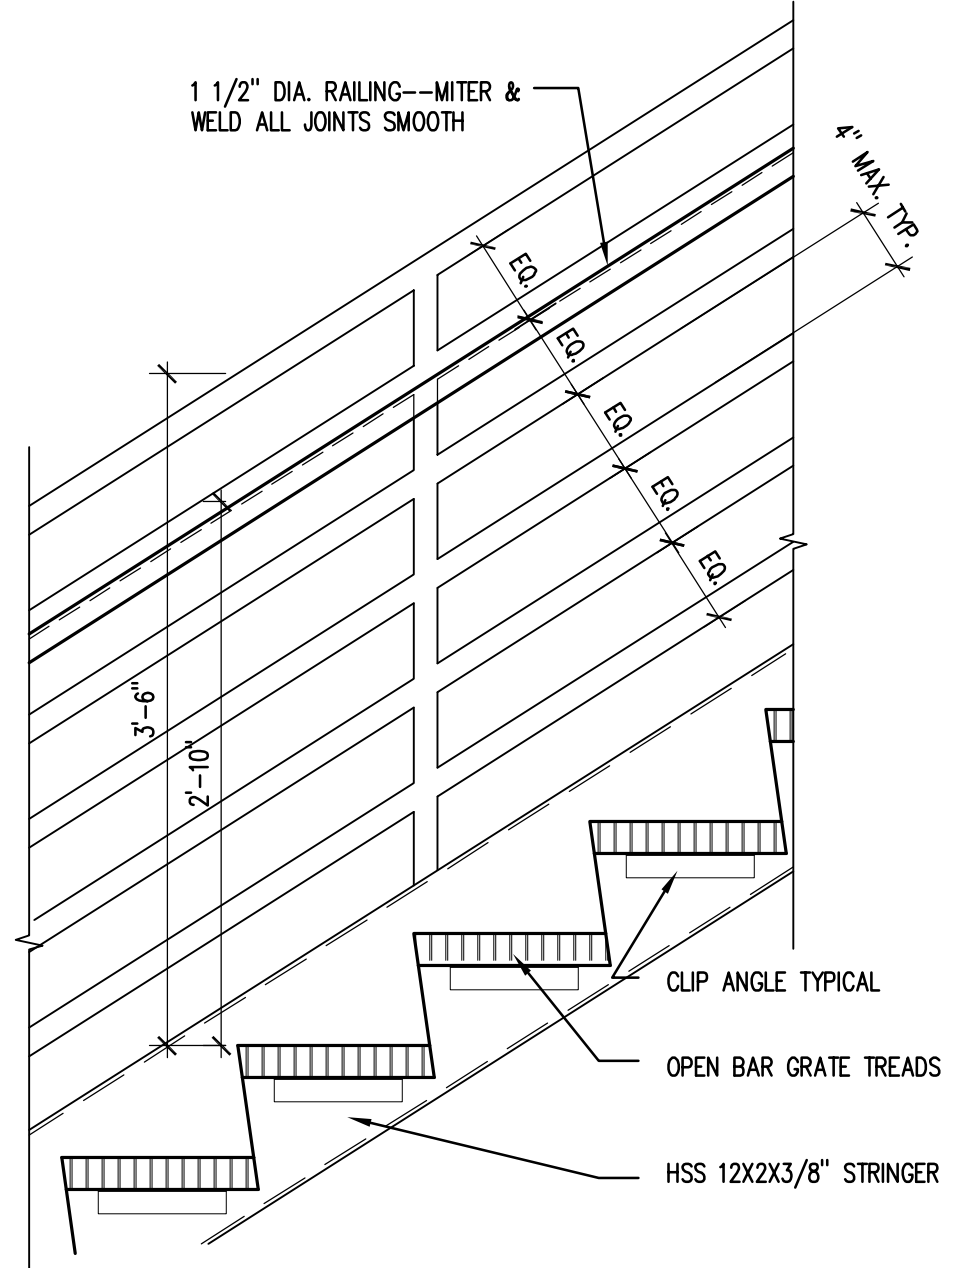


**3 TYPICAL PIPE RAILING DETAIL**  
 1"=1'-0"

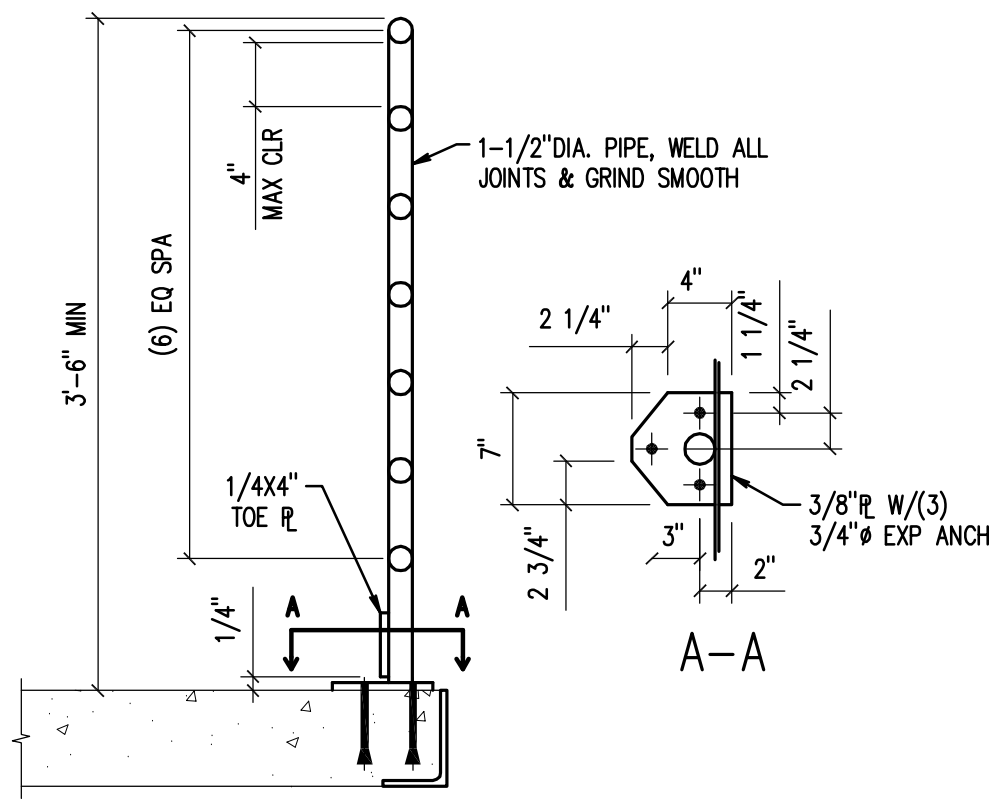

**4 TYPICAL GUARD RAIL DETAIL**  
 1"=1'-0"

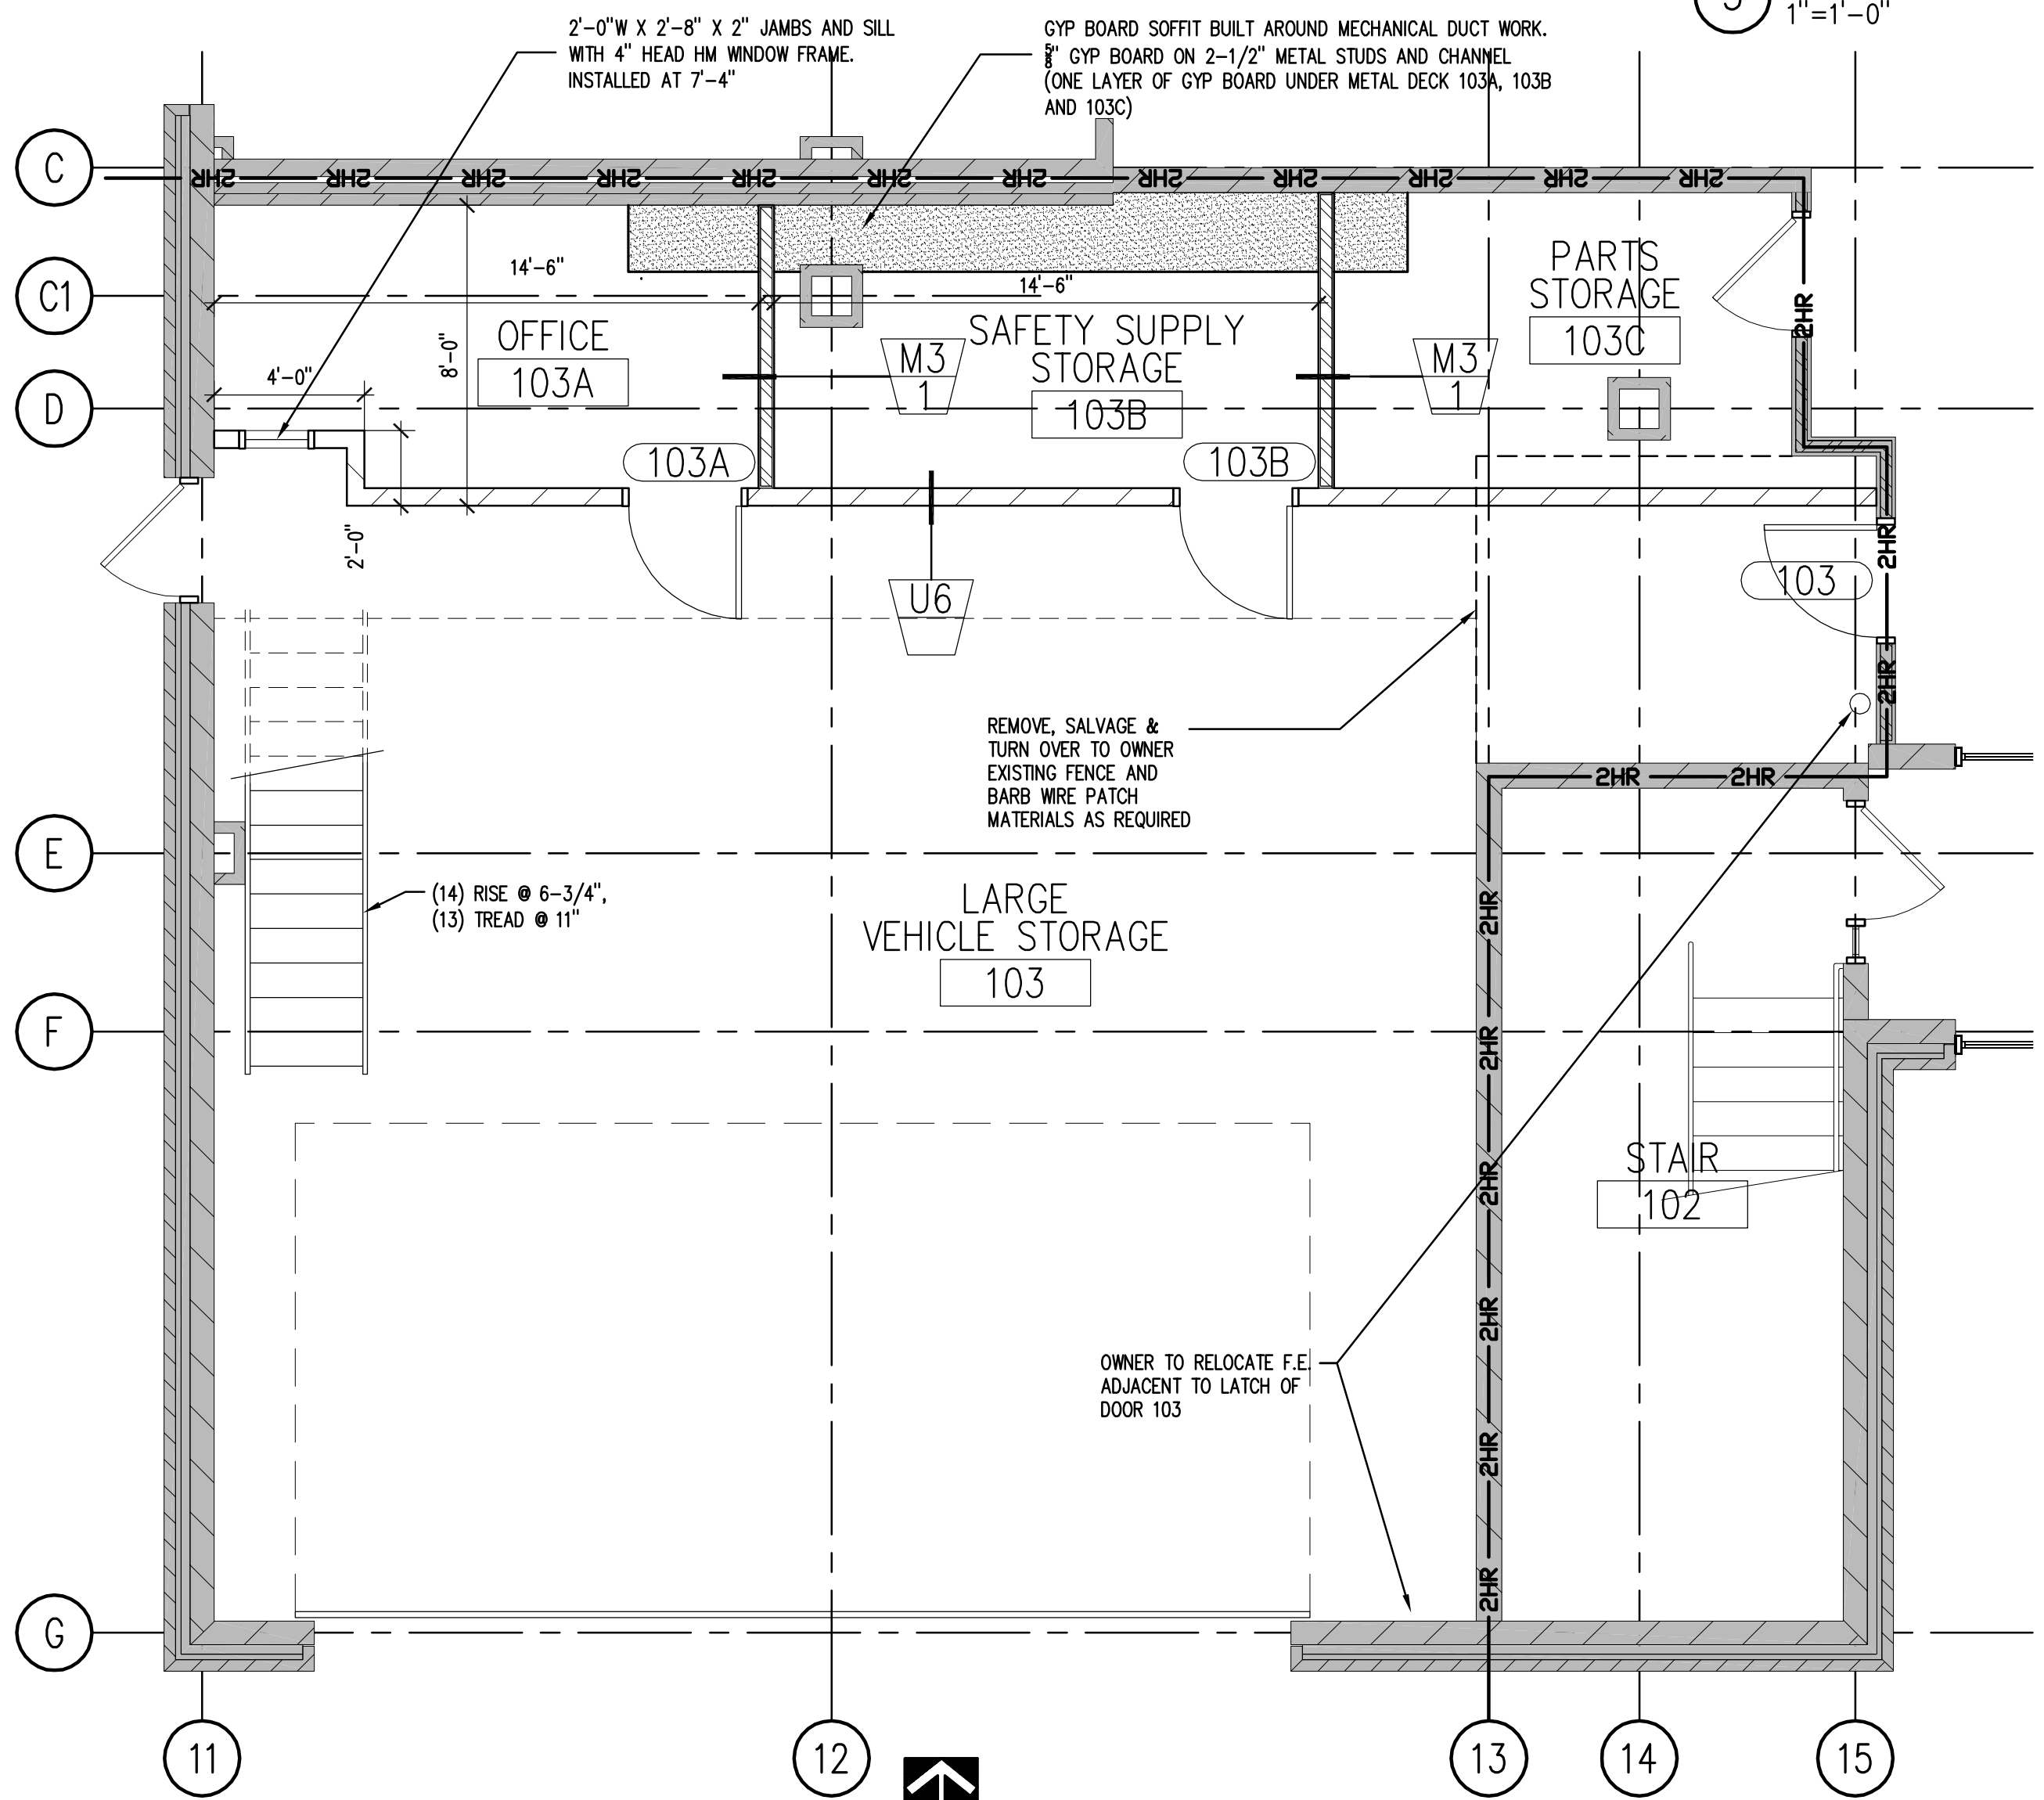


**1 PLAN: FIRST FLOOR**  
 1/4"=1'-0"

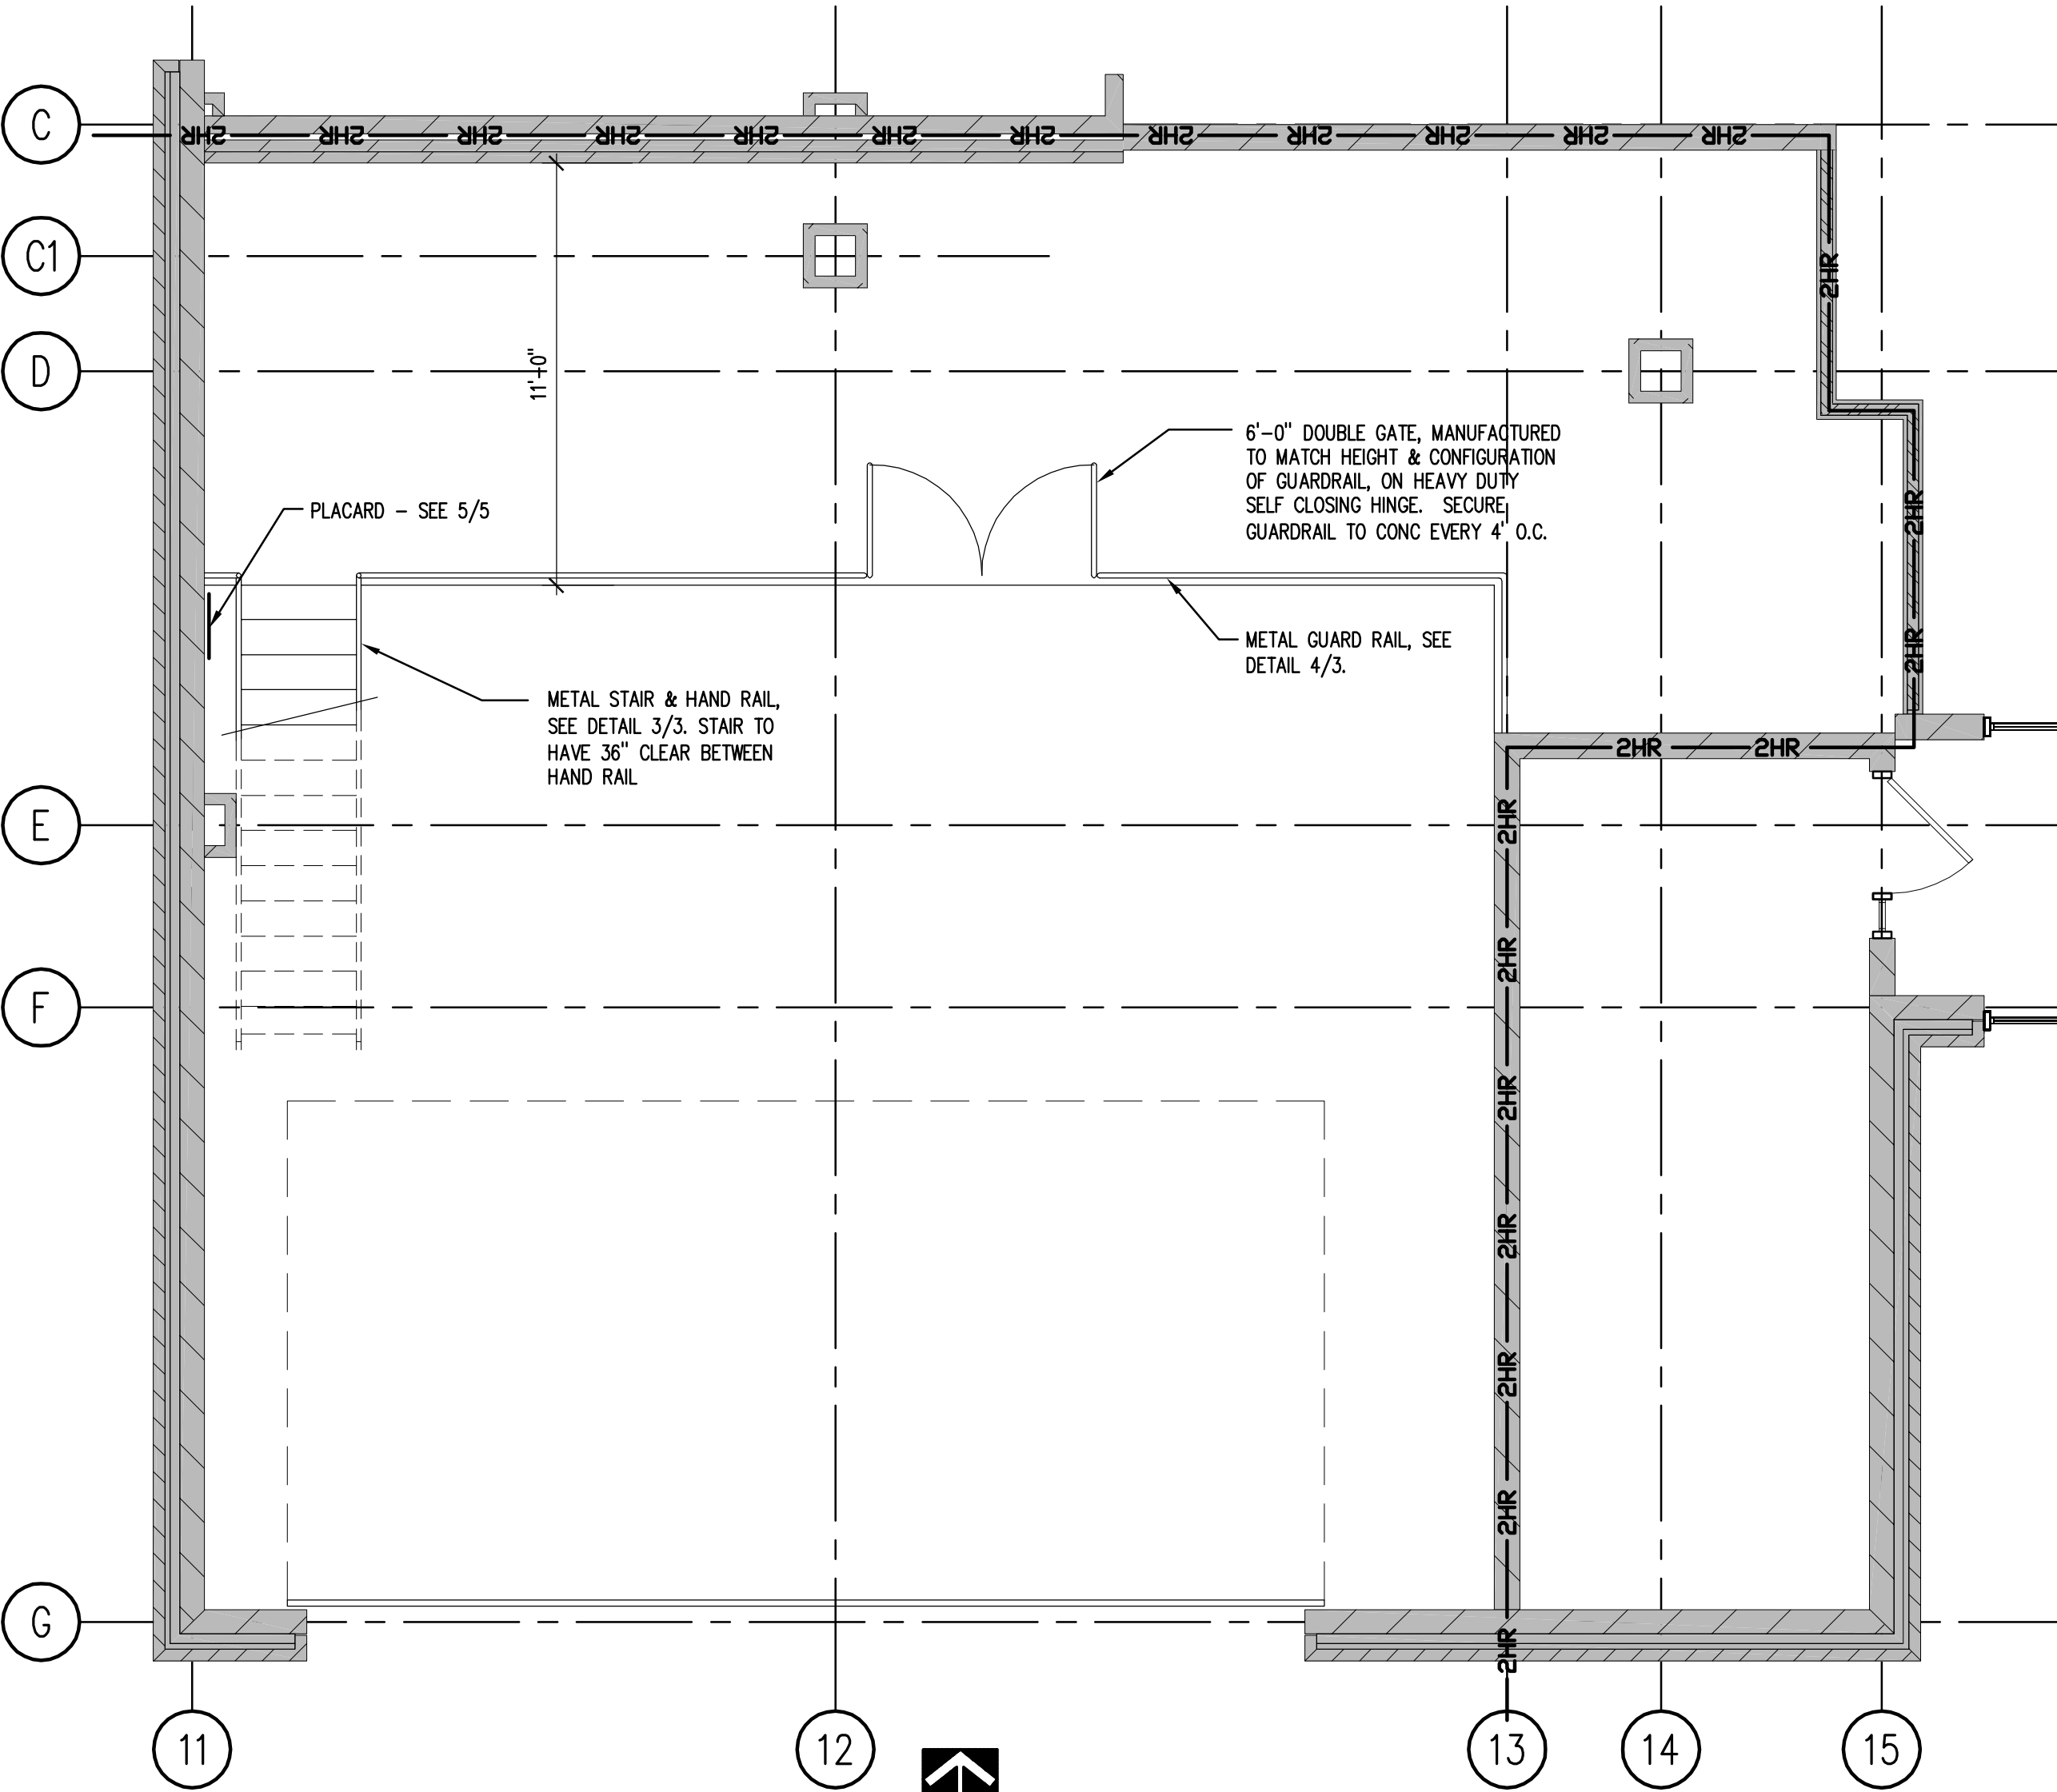

**2 PLAN: MEZZANINE LEVEL**  
 1/4"=1'-0"

21 W. Superior Street  
 Suite 500  
 Duluth, MN 55802  
 TEL 218/727-8446  
 FAX 218/727-8456  
 http://www.LHBcorp.com  
**DULUTH** • **MINNEAPOLIS**  
 LHB PROJECT NO. 060565

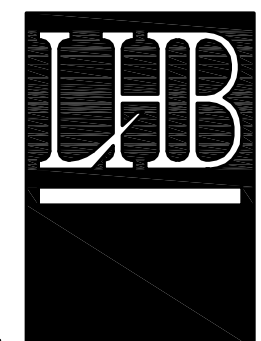

SCALE AS NOTED FOR 22"x34" SHEETS

FLOOR PLAN AND DETAILS

OFFICE & STORAGE MEZZANINE

SUPERIOR, WISCONSIN

|          |     |                 |            |
|----------|-----|-----------------|------------|
| SURVEY   | N/A | RECORD DRAWINGS | 3          |
| DRAWN    | ARH | DATE            | 06/26/2008 |
| DESIGN   | KCH |                 |            |
| APPROVED | KCH |                 |            |



GENERAL DESIGN AND CONSTRUCTION NOTES

- A. BUILDING CODE
- 2002 WISCONSIN ENROLLED COMMERCIAL BUILDING CODE
  - 2000 INTERNATIONAL BUILDING CODE (IBC).
- B. DESIGN LIVE LOADS
- WIND LOAD: NOT APPLICABLE
  - SEISMIC LOAD: NOT APPLICABLE (MSBC).
  - ROOF LIVE LOAD: NOT APPLICABLE
  - FLOOR LIVE LOAD: UNIFORM (PSF) CONCENTRATED (LB)  
LIGHT STORAGE \_\_\_\_\_ 125 \_\_\_\_\_ 0
  - LOADS PROVIDED ON DRAWINGS ARE ALLOWABLE STRESS DESIGN LOADS. 1.33 ALLOWABLE STRESS INCREASE FOR SHORT-TERM LOADING IS NOT ALLOWED.
- C. FOOTINGS AND FOUNDATIONS
- BEARING WALL WILL REST DIRECTLY ON EXISTING CONCRETE SLAB. EXISTING SLAB IS 8" THICK WITH #5 @ 12" O.C. EACH WAY ACCORDING TO LHB PROJECT #94064 DRAWING S1, AND CONFIRMED BY AMERICAN ENGINEERING TESTING REPORT DATED MAY 14, 2007. EXISTING SLAB  $f_c = 4000$  PSI. ASSUMED SUBGRADE  $k = 50$  PCI.
- D. CONSTRUCTION NOTES
- ALL DIMENSIONS INVOLVING COORDINATION OF NEW WORK WITH EXISTING CONSTRUCTION SHALL BE FIELD CHECKED BY THE CONTRACTOR AND FURNISHED TO THE SUBCONTRACTORS PRIOR TO FABRICATION OF ANY WORK. THE VERIFIED DIMENSIONS SHALL APPEAR AND BE NOTED ON THE SHOP DRAWINGS SUBMITTED.
  - THE CONTRACTOR IS RESPONSIBLE FOR THE PROTECTION OF EXISTING BUILDINGS, UTILITIES, STREETS, ETC. DURING CONSTRUCTION. CONTRACTOR IS RESPONSIBLE FOR DESIGN AND INSTALLATION OF ALL NECESSARY TEMPORARY BRACING.
  - ANY HOLES CUT IN NEW OR EXISTING CONSTRUCTION THAT ARE NOT DETAILED ON THE STRUCTURAL DRAWINGS SHALL BE REVIEWED WITH THE STRUCTURAL ENGINEER. COORDINATE ALL HOLES AND PENETRATIONS WITH OTHER DISCIPLINES.
  - THE STRUCTURE SHALL BE ADEQUATELY BRACED AND SHORED DURING ERECTION AGAINST WIND AND ERECTION LOADS. STRUCTURAL MEMBERS ARE DESIGNED FOR IN-PLACE LOADS.
  - THE CONTRACTOR SHALL NOTIFY THE ENGINEER IMMEDIATELY OF DISCREPANCIES FOUND BETWEEN CONSTRUCTION DOCUMENTS AND ACTUAL FIELD CONDITIONS.

STRUCTURAL STEEL

- MATERIAL PROPERTIES
- A. 1. STEEL PROPERTIES:  $F_y$  (PSI)  $F_u$  (PSI) ASTM
- W SHAPES: \_\_\_\_\_ 50,000 65,000 A992, A572  
 OTHER SHAPES, PLATES: \_\_\_\_\_ 36,000 58,000 A36, A283  
 HOLLOW STRUCTURAL SECTIONS: \_\_\_\_\_ 46,000 58,000 A500, GR B  
 STEEL PIPES: \_\_\_\_\_ 35,000 60,000 A53, GR B
- HIGH STRENGTH BOLTS, U.N.O., BEARING CONNECTIONS: \_\_\_\_\_ 92,000 120,000 A325N  
 HIGH STRENGTH BOLTS, SLIP CRITICAL CONNECTIONS, (WHERE NOTED): \_\_\_\_\_ 92,000 120,000 A325 SC CLASS A  
 NUTS \_\_\_\_\_ \_\_\_\_\_ \_\_\_\_\_ A563 HEAVY HEX  
 WASHERS \_\_\_\_\_ \_\_\_\_\_ \_\_\_\_\_ F436 HARDENED STEEL  
 ANCHOR BOLTS: \_\_\_\_\_ 36,000 58,000 F1554 OR A36  
 WELDING ELECTRODES: \_\_\_\_\_ \_\_\_\_\_ \_\_\_\_\_ E70XX A233
2. GROUT: NONSHRINK, NON-METALLIC AGGREGATE TYPE, COMPLYING WITH ASTM C1107 AND CAPABLE OF DEVELOPING A MINIMUM COMPRESSIVE STRENGTH OF 7,000 PSI AT 28 DAYS.
- B. STRUCTURAL STEEL NOTES
- STRUCTURAL STEEL DESIGN AND CONSTRUCTION SHALL CONFORM TO AISC ASD (1989).

CAST-IN-PLACE CONCRETE

- A. MATERIAL PROPERTIES
- CONCRETE PROPERTIES: \*  $f_c$  (PSI) SLUMP MAX. ENTR. MAX. 28 DAYS INCHES AGGR. AIR (%) W/C
- INT. ELEV. SLAB (NW): \_\_\_\_\_ 4,000 4 3/4" 0 -
- REINFORCING PROPERTIES:  $F_y$  (PSI) ASTM
- ALL BARS UNLESS NOTED OTHERWISE: \_\_\_\_\_ 60,000 A615  
 TIES & STIRRUPS: \_\_\_\_\_ 60,000 A615  
 WELDED WIRE FABRIC (SMOOTH, SHEETS): \_\_\_\_\_ 65,000 A185
- IF CONCRETE SUPPORT BLOCKS ARE USED, THEIR STRENGTH SHALL BE EQUAL TO OR GREATER THAN THAT OF THE CONCRETE BEING PLACED.
  - THE FOLLOWING MATERIALS SHALL NOT EXCEED THE FOLLOWING PERCENT OF TOTAL CEMENTITIOUS MATERIAL BY WEIGHT:  
 FLY ASH: \_\_\_\_\_ 15% SLABS, 25% ELSEWHERE  
 SILICA FUME: \_\_\_\_\_ 5%  
 SOLUBLE CHLORIDE: \_\_\_\_\_ 0.1%
  - CONCRETE COMPONENTS SHALL MEET THE FOLLOWING: ASTM
- FLY ASH \_\_\_\_\_ \_\_\_\_\_ \_\_\_\_\_ C618  
 FINE AND COARSE AGGREGATES: \_\_\_\_\_ \_\_\_\_\_ \_\_\_\_\_ C33  
 LIGHTWEIGHT AGGREGATES: \_\_\_\_\_ \_\_\_\_\_ \_\_\_\_\_ C330  
 PORTLAND CEMENT: \_\_\_\_\_ \_\_\_\_\_ \_\_\_\_\_ C150, TYPE I OR III  
 AIR ENTRAINING ADMIXTURES: \_\_\_\_\_ \_\_\_\_\_ \_\_\_\_\_ C260  
 OTHER CHEMICAL ADMIXTURES: \_\_\_\_\_ \_\_\_\_\_ \_\_\_\_\_ C494, TYPE A-G  
 WATER: CLEAN AND NOT DETRIMENTAL TO CONCRETE \_\_\_\_\_ \_\_\_\_\_ N/A
- B. CONCRETE NOTES
- PERFORM WORK IN ACCORDANCE WITH ACI 301-89 AND ACI 318-99.
  - CONCRETE CLEAR COVER OVER REINFORCING STEEL SHALL MEET THE REQUIREMENTS OF ACI 318-99.
  - PROVIDE LAP SPLICES AT ALL CORNERS AND INTERSECTIONS, SAME SIZE AND SPACING AS HORIZONTAL REINFORCING.
  - PROVIDE SUPPORTS AND SPACERS FOR ALL REINFORCING, INCLUDING WWF.
  - CONSOLIDATE ALL CONCRETE, INCLUDING SLABS, BY VIBRATING.
  - ALL CONCRETE SHOWN SHALL BE REINFORCED. PLANS, SECTIONS AND DETAILS SHOWN WITHOUT REINFORCEMENT ARE INTENDED TO SHOW DIMENSIONS AND DETAILS OF CONSTRUCTION ONLY. REINFORCEMENT OF THESE SECTIONS SHALL BE PROVIDED IN ACCORDANCE WITH THE DETAILS SHOWING REINFORCEMENT.
  - MIX DESIGNS SHALL INCORPORATE ADMIXTURES AS APPROPRIATE FOR ENVIRONMENTAL CONDITIONS.
  - ALL REINFORCING SHALL BE DETAILED, FABRICATED & PLACED IN ACCORDANCE WITH CRSI "MANUAL OF STANDARD PRACTICE".
  - CONCRETE SLABS SHALL NOT DEVIATE MORE THAN 1/8" IN FLATNESS IN ANY DIRECTION WHEN CHECKED WITH A 10 FOOT STRAIGHTEDGE.
  - USE SONNEBORN "KURE-N-SEAL CURING/SEALING/DUST-PROOFING COMPOUND OR APPROVED ALTERNATE ON ALL CONCRETE SLABS. CONTRACTOR SHALL VERIFY COMPATIBILITY WITH ALL PROPOSED FLOOR FINISHES AND FLOORING ADHESIVES. USE 7-DAY MOIST CURE WITH POLYETHYLENE WHEN COMPATIBILITY IS A CONCERN.
  - SAWCUT ALL CONTROL JOINTS WITHIN 8 HOURS OF PLACEMENT. CONSTRUCTION AND CONTROL JOINTS SHALL BE AS INDICATED ON THE DRAWINGS
  - JOINT SEALANT SHALL BE SILICONE (ASTM D5893-96) UNLESS NOTED OTHERWISE.
  - ALL SLABS SHALL HAVE STEEL TROWEL FINISH.
  - FORMED CONCRETE SURFACES SHALL BE SMOOTH FORM FINISH. EXPOSED SURFACES SHALL BE SMOOTH RUBBED FINISH.
  - PROVIDE EXTRA REINFORCING AROUND ALL OPENINGS 24" OR LARGER IN SLAB EQUAL TO (1) #5 BAR ON ALL FOUR SIDES AND EXTEND 2 FEET BEYOND OPENINGS.
  - PROVIDE ISOLATION JOINTS AROUND COLUMNS.

MASONRY

- A. MATERIAL PROPERTIES
- MASONRY PROPERTIES: STRENGTH (PSI) ASTM
- HOLLOW MASONRY UNITS (INDIVIDUAL): \_\_\_\_\_ 1,900 C90-N  
 HOLLOW MASONRY UNITS (AVERAGE NET)  $f_m$ : \_\_\_\_\_ 1,500  
 BRICK MASONRY (ASSY): \_\_\_\_\_ 1,400 C216-SW  
 MORTAR TYPE S (ABOVE GRADE): \_\_\_\_\_ 1,800 C270  
 MORTAR TYPE M (BELOW GRADE): \_\_\_\_\_ 2,500 C270  
 GROUT (COREFILL): \_\_\_\_\_ 3,000 C476  
 GROUT (BOND BEAMS): \_\_\_\_\_ 3,000 C476  
 REINFORCING BARS: \_\_\_\_\_ 60,000 A615  
 COLD DRAWN STEEL WIRE: \_\_\_\_\_ 70,000 A82, GALV.
- B. MASONRY NOTES
- DESIGN AND CONSTRUCTION SHALL COMPLY WITH ACI 530/ASCE 5/TMS 402-99 AND ACI 530.1/ASCE 6/TMS 602-99.
  - ALL REINFORCEMENT SPLICES SHALL BE 48 BAR DIAMETERS U.N.O.
  - MASONRY WALLS SHALL HAVE CONTROL JOINTS AT A MAXIMUM OF 20 FEET UNLESS SPECIFICALLY NOTED OTHERWISE. IF CONTROL JOINTS ARE NOT SPECIFICALLY SHOWN ON THE DRAWINGS, CONTRACTOR SHALL FOLLOW LOCALLY ACCEPTED PRACTICES. CONTROL JOINTS SHALL BE PLACED ABOVE JOINTS IN FOUNDATION OR SUPPORTING FLOOR SLABS, WITHIN 15 FEET OF CORNERS AND AT ONE SIDE OF DOOR AND WINDOW OPENINGS, DEPENDING ON THE WIDTH AND LOCATION OF THE OPENING. JOINTS AT OPENINGS SHALL JOG 8" AT THE TOP OF OPENINGS TO ALLOW FOR LINTEL BEARING.
  - ALL MASONRY WALLS SHALL HAVE A MINIMUM OF #5'S AT 48" ON CENTER MAX. SPACING, UNLESS NOTED OTHERWISE. (PROVIDE (1) #5 BAR FULL HEIGHT AT EACH SIDE OF MASONRY OPENINGS AND AT CORNERS UNLESS NOTED OTHERWISE.)
  - PROVIDE CONTINUOUS BOND BEAM REINFORCEMENT WITH (2) #5 BARS OR AS NOTED. DISCONTINUE BARS AT CONTROL JOINTS U.N.O.
  - ALL GROUT SHALL BE CONSOLIDATED BY MECHANICAL VIBRATION OR PUDDLING. RECONSOLIDATE GROUT POURS EXCEEDING 12" IN HEIGHT.
  - WHEN GROUTING IS STOPPED FOR ONE HOUR OR LONGER, HORIZONTAL CONSTRUCTION JOINTS SHALL BE FORMED BY STOPPING THE GROUT POUR 1 1/2" BELOW THE TOP OF THE UPPERMOST UNIT. IF UPPERMOST UNIT IS A BOND BEAM, STOP POUR 1/2" BELOW THE TOP OF MASONRY.
  - GROUT LIFTS SHALL NOT EXCEED 5 FEET WITHOUT APPROVAL OF THE ENGINEER.
  - SECURE VERTICAL REINFORCING IN REQUIRED ALIGNMENT BEFORE GROUTING.
  - ALL HOLLOW UNIT BLOCK COMPRESSION TEST STRENGTHS REQUIRED TO ACHIEVE THE  $f_m$  STATED ABOVE SHALL BE ACCORDING IBC SECTION 2105.2.2.2 PRISM TEST METHOD.
  - SUBMIT SHOP DRAWINGS TO ARCHITECT/ENGINEER FOR REVIEW CLEARLY SHOWING REINFORCEMENT LAYOUT, SIZE, SPACING AND DETAILS.
  - PROVIDE 9 GA. HOT-DIP GALVANIZED HORIZONTAL JOINT REINFORCEMENT (DUR-O-WALL OR EQUAL) EVERY COURSE IN STACK BOND WALLS AND EVERY OTHER COURSE IN RUNNING BOND WALLS. WALLS SHALL BE RUNNING BOND UNLESS NOTED OTHERWISE.

| LINTEL SCHEDULE |          |                            |
|-----------------|----------|----------------------------|
| MARK            | TYPE     | ELEVATION OR DETAIL / SHT. |
| L-1             | 6"x8" BB | 3/5                        |

NON-COMPOSITE STEEL DECK

- A. ALL STEEL DECK, FORM DECK AND NON-COMPOSITE FLOOR DECK SHALL BE DESIGNED AND SELECTED IN ACCORDANCE WITH THE SDI DESIGN MANUAL.
- B. STEEL DECK SHALL BE MANUFACTURED FROM STEEL CONFORMING TO ASTM A1008 OR ASTM A653, GRADE 33 OR HIGHER (33 KSI YIELD STRENGTH).
- C. DECK ANCHORAGE SHALL BE MADE WITH 5/8" DIAMETER PUDDLE WELDS AT SUPPORTS AND EDGES, AND #10 TEK SCREWS AT SIDELAPS. FASTENER PATTERNS SHALL BE AS FOLLOWS UNLESS NOTED OTHERWISE:
- FLOOR DECK: 3/4" PATTERN (12" ON CENTER) AT SUPPORTS AND 12" ON CENTER AT EDGES. PROVIDE TWO SIDELAP FASTENERS PER DECK SPAN.
- D. NON-COMPOSITE FLOOR DECK SHALL BE GALVANIZED, TYPE C, CONFORM, DEPTH AND GAUGE AS INDICATED ON THE DRAWINGS.
- E. SUBMIT SHOP DRAWINGS FOR DECK PLACEMENT SHOWING DECK CHARACTERISTICS, ANCHORAGE DETAILS AND ACCESSORIES.

21 W. Superior Street  
 Suite 500  
 Duluth, MN 55802



TEL 218/727-8446  
 FAX 218/727-8456

http://www.LHBcorp.com


DULUTH • MINNEAPOLIS

LHB PROJECT NO. 060565




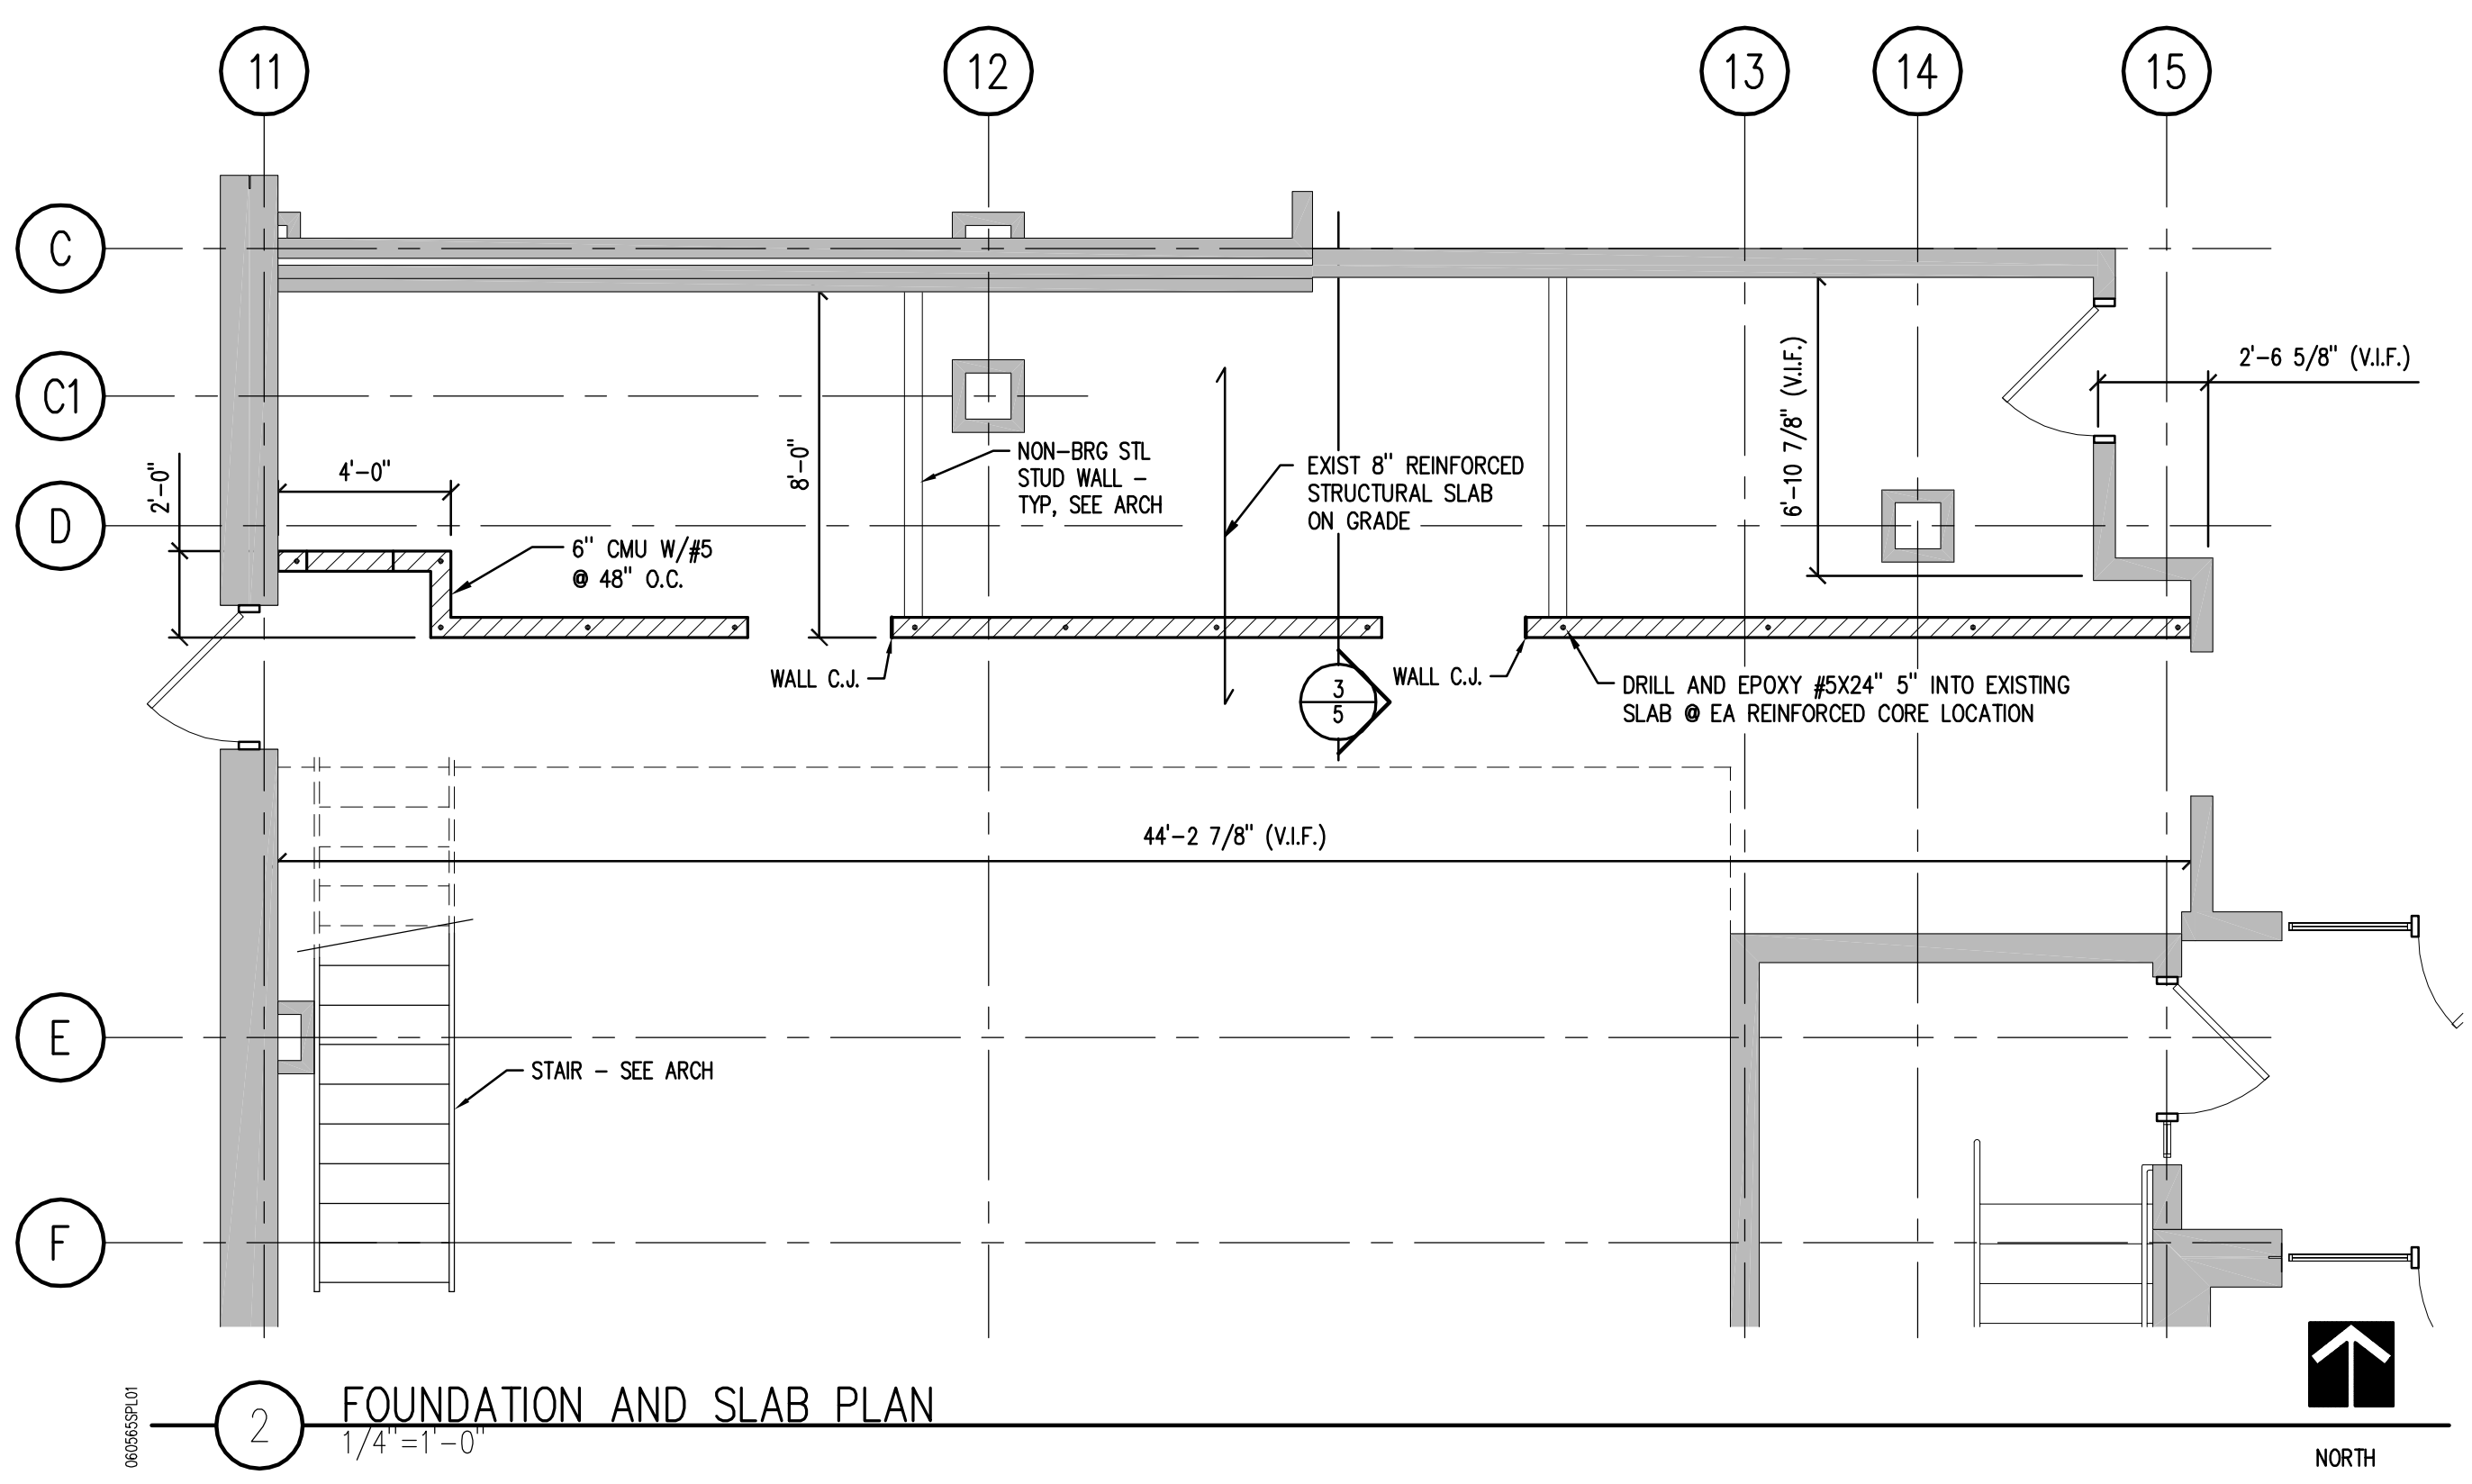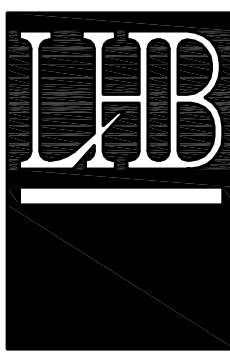


**2 FOUNDATION AND SLAB PLAN**  
 1/4"=1'-0"

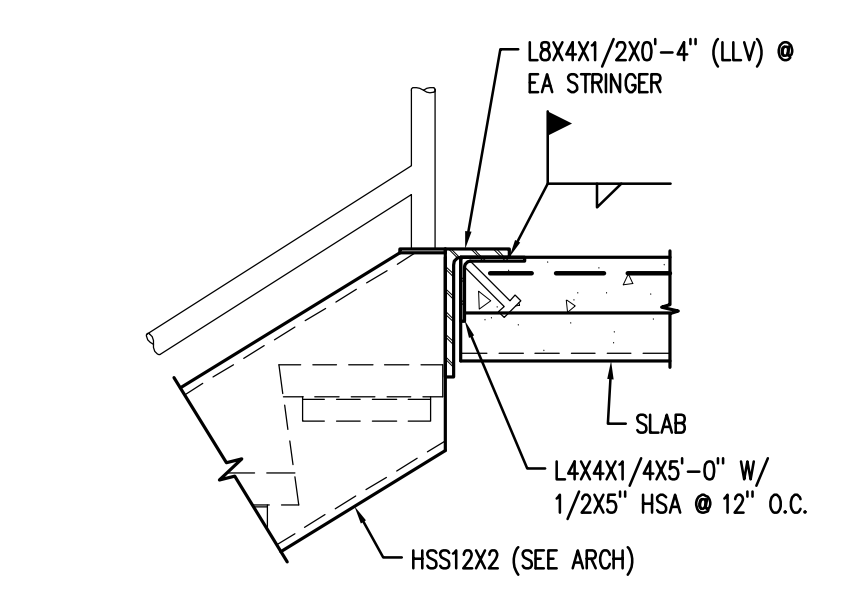


**4 DETAIL - STAIR ATTACHMENT**  
 1"=1'-0"

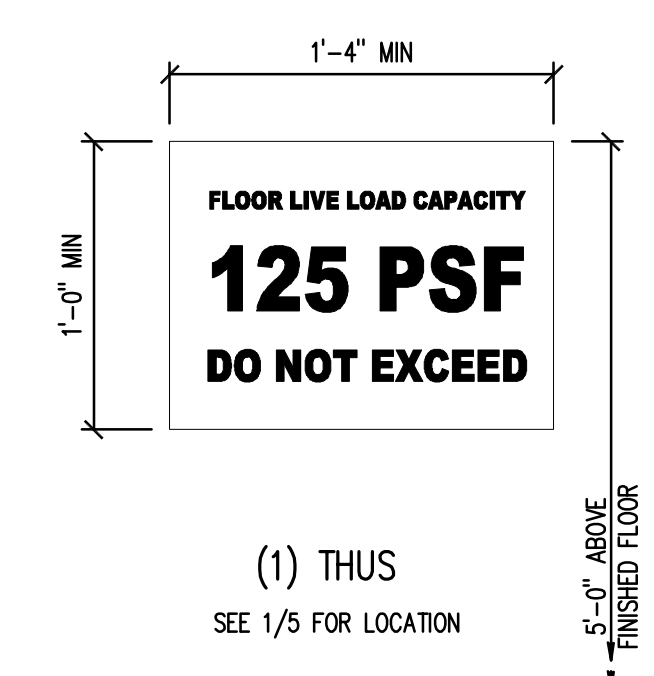


**5 DETAIL - PLACARD**  
 NO SCALE

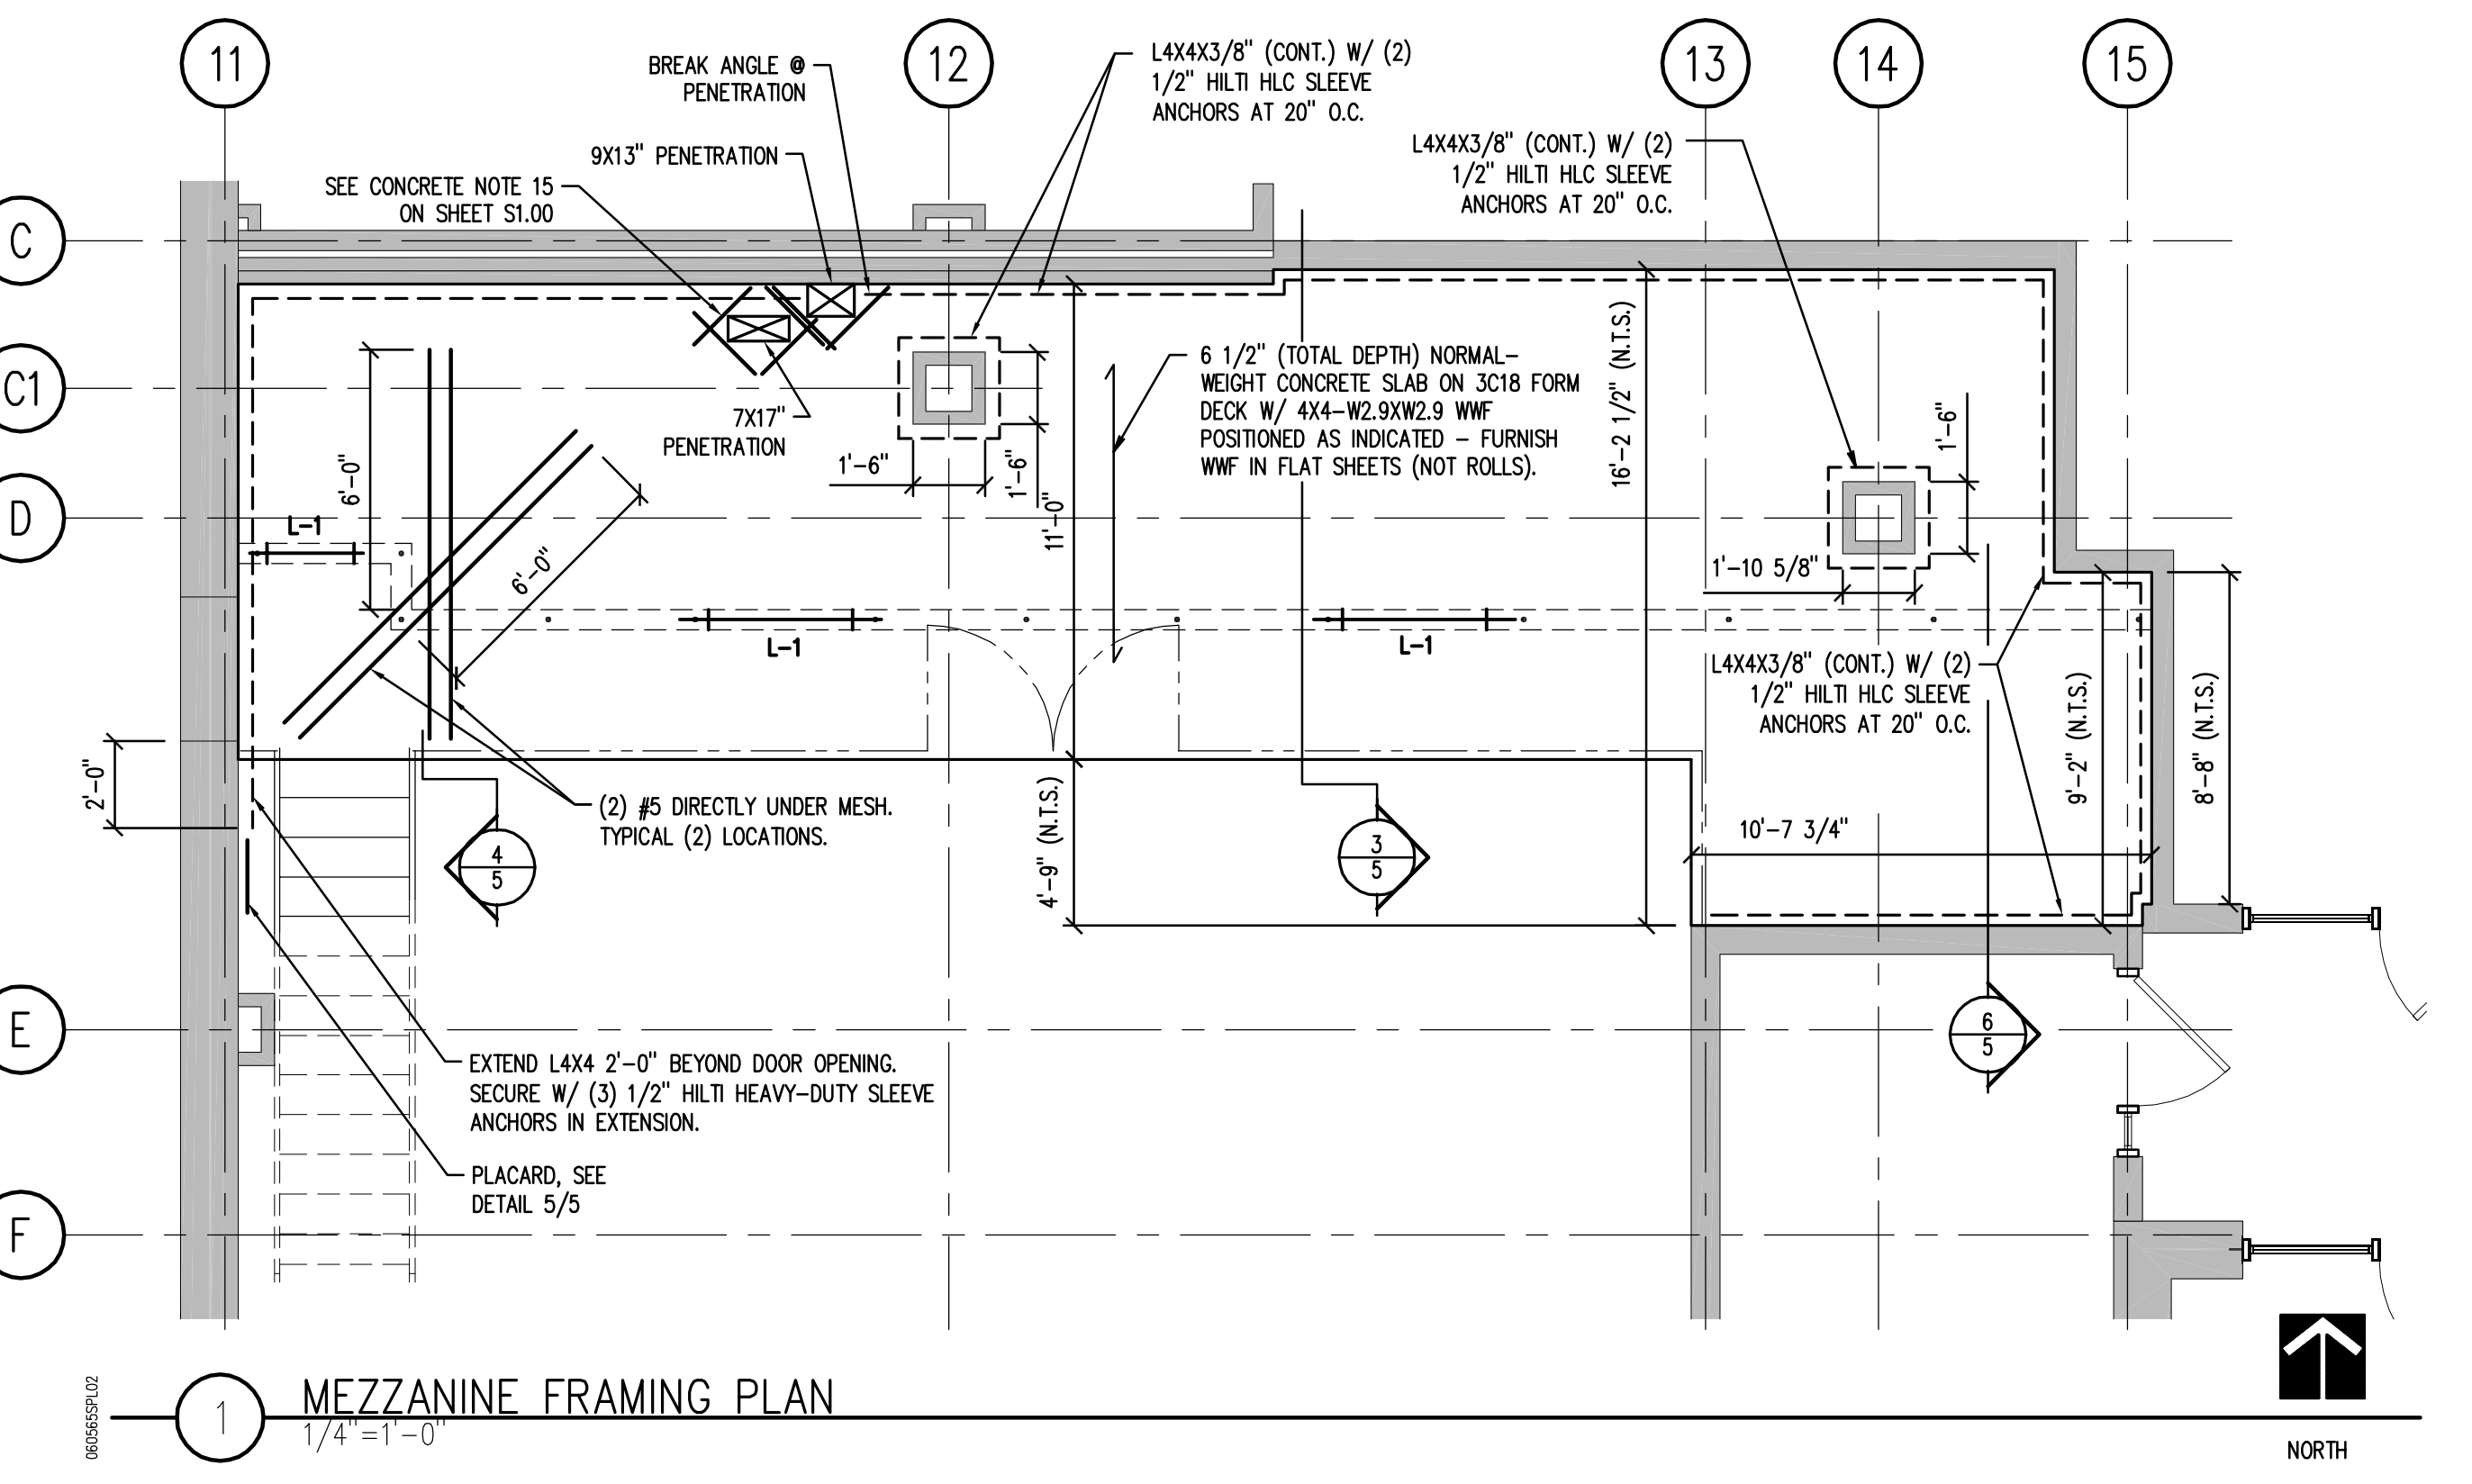

**1 MEZZANINE FRAMING PLAN**  
 1/4"=1'-0"

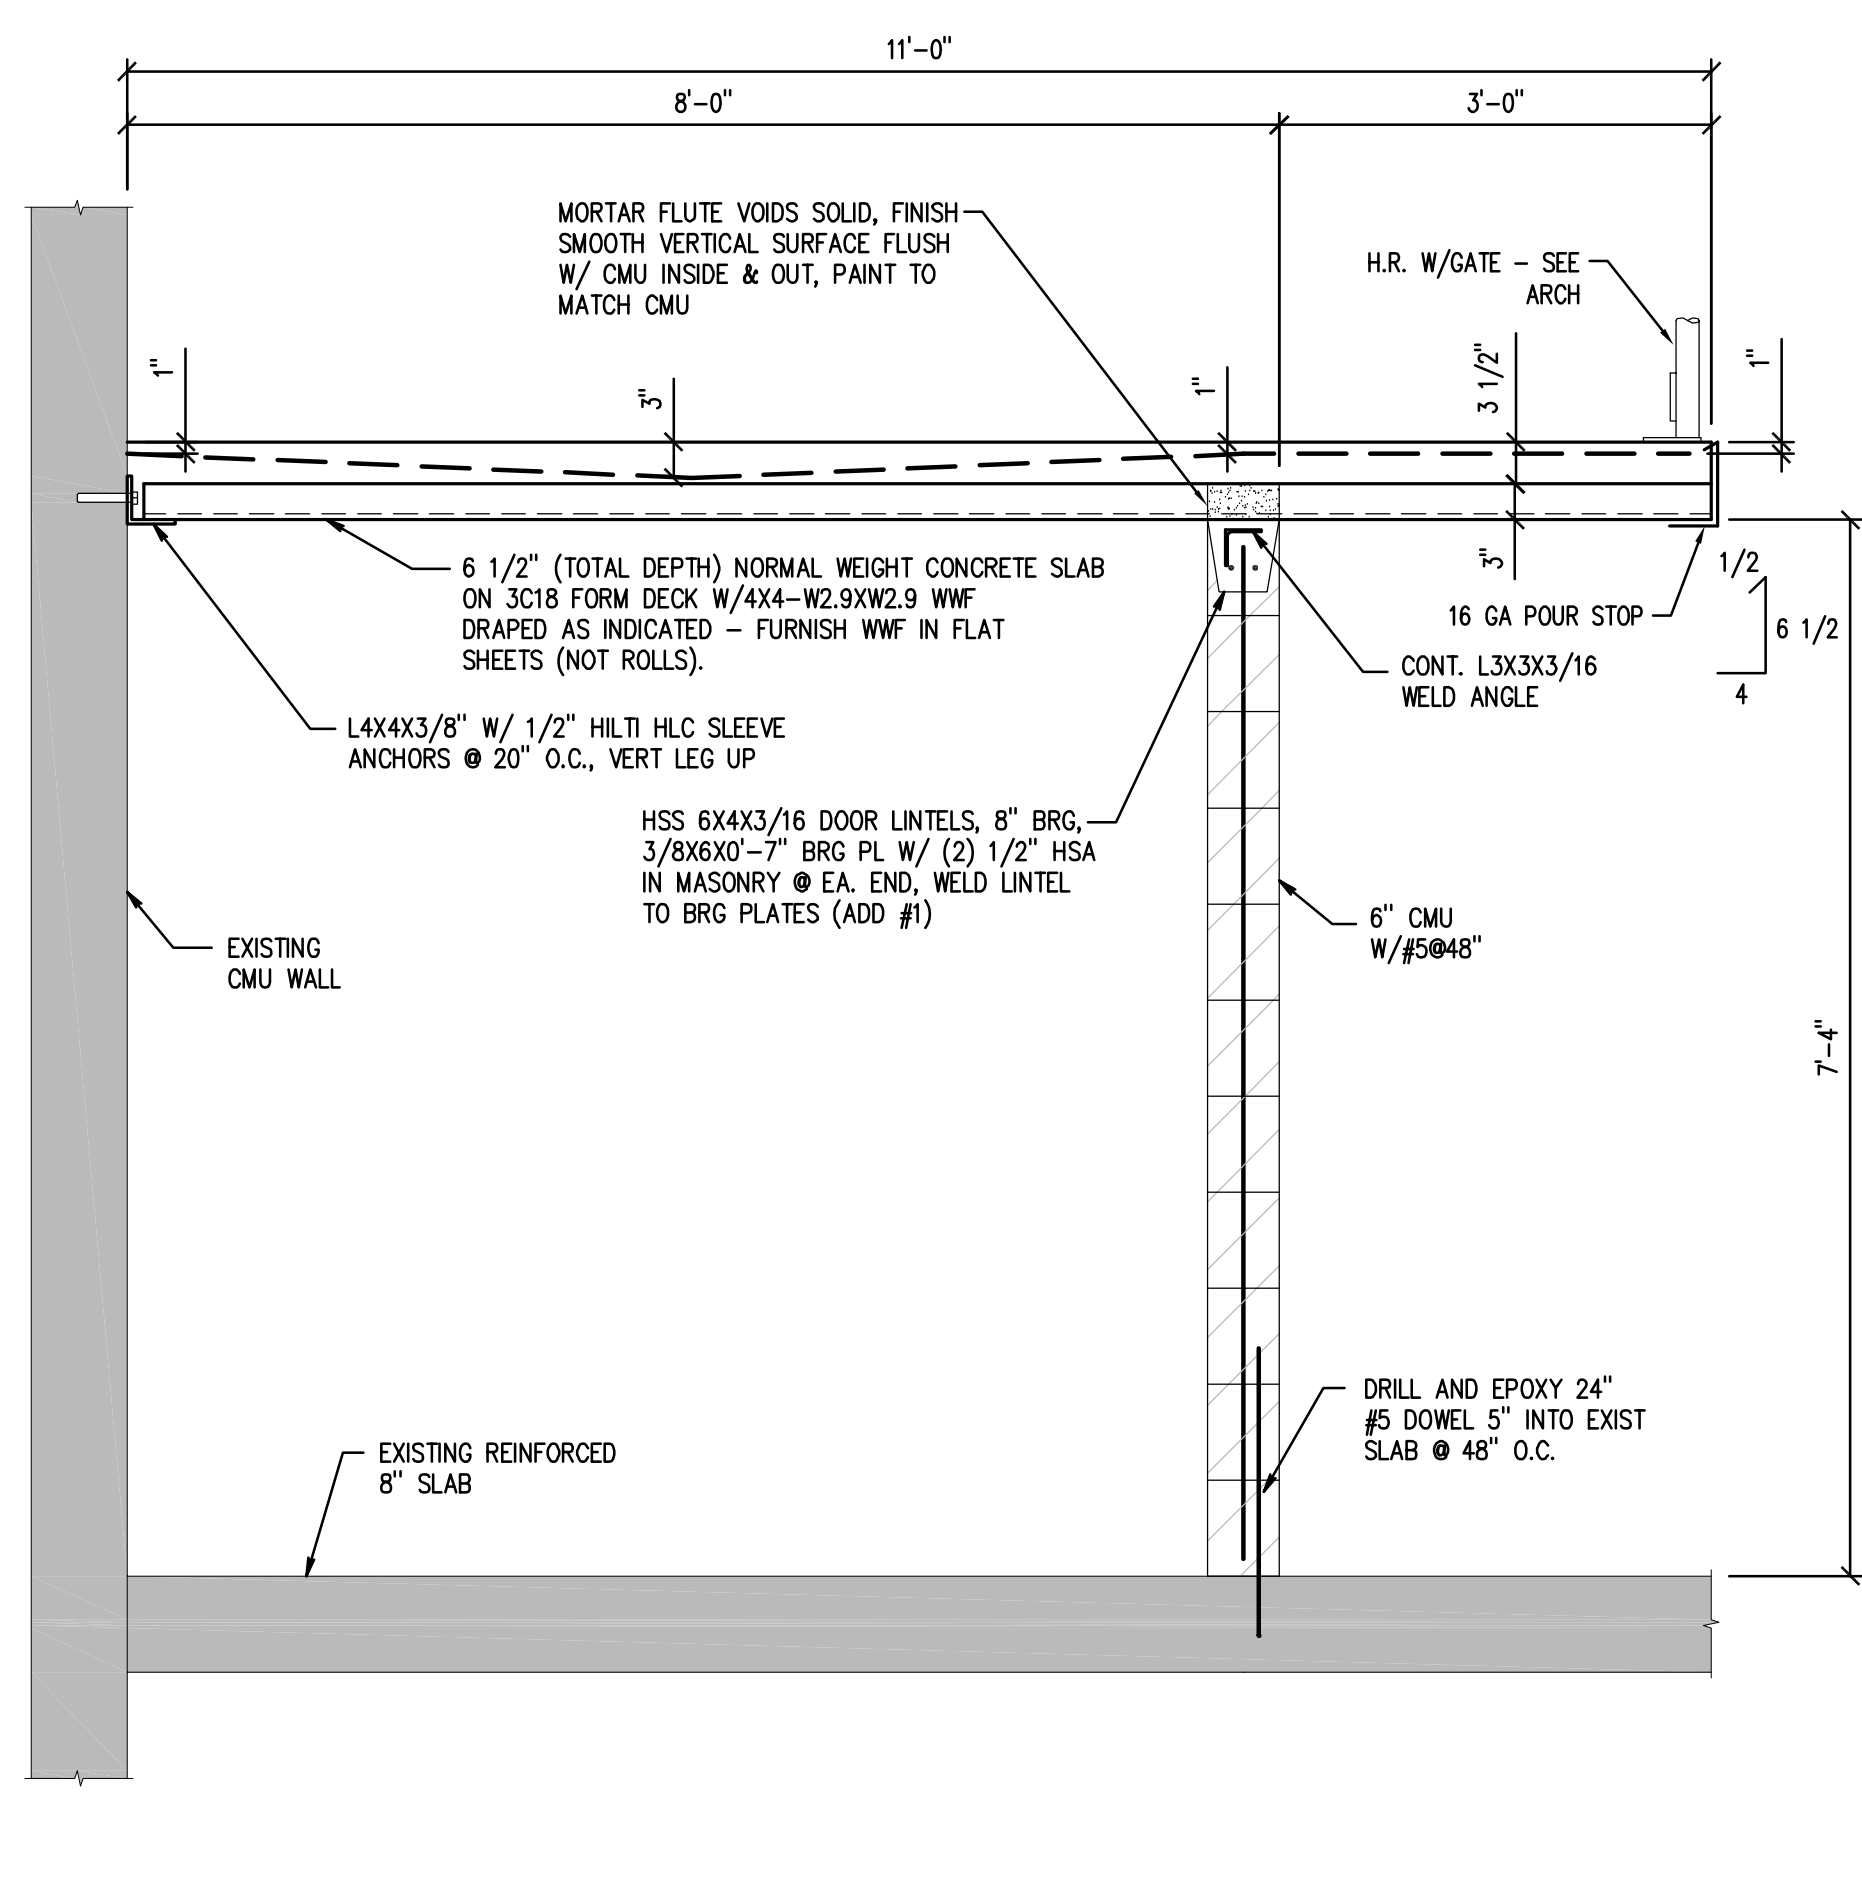

**3 SECTION @ MEZZANINE**  
 3/4"=1'

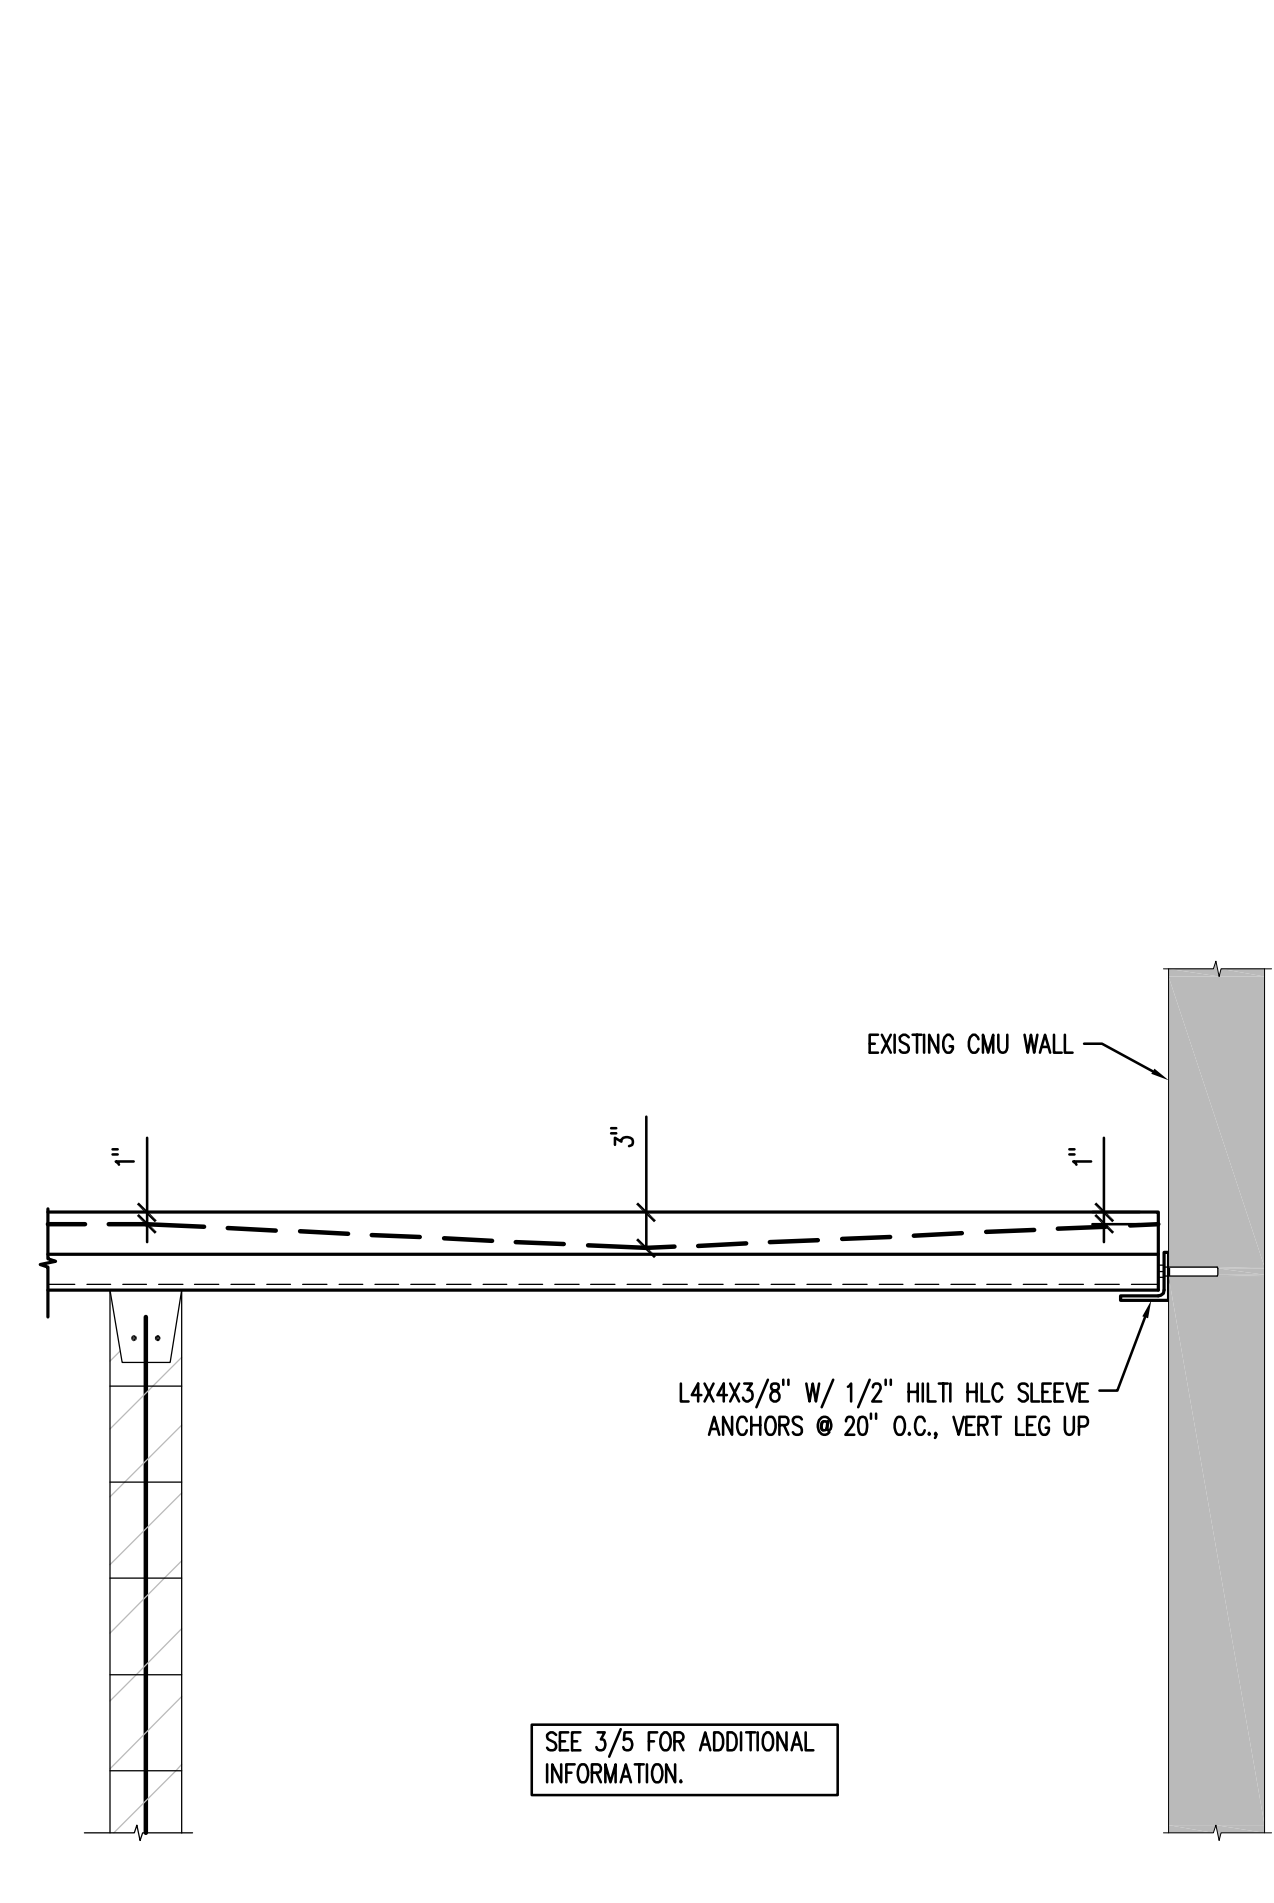

**6 SECTION @ MEZZANINE**  
 3/4"=1'




21 W. Superior Street  
Suite 500  
Duluth, MN 55802

TEL 218/727-8446  
FAX 218/727-8456

http://www.LHBcorp.com


DULUTH • MINNEAPOLIS

LHB PROJECT NO. 060565

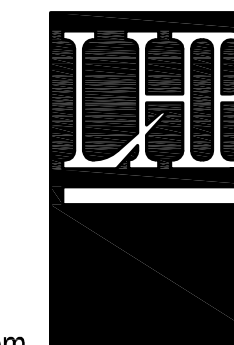

**KEYED SHEET NOTES**

- ① RELOCATE SERVICE FAUCET WITH VACUUM BREAKER, CHECK VALVES, AND HOSE.
- ② PROVIDE PRECAST CONDENSING UNIT PAD.

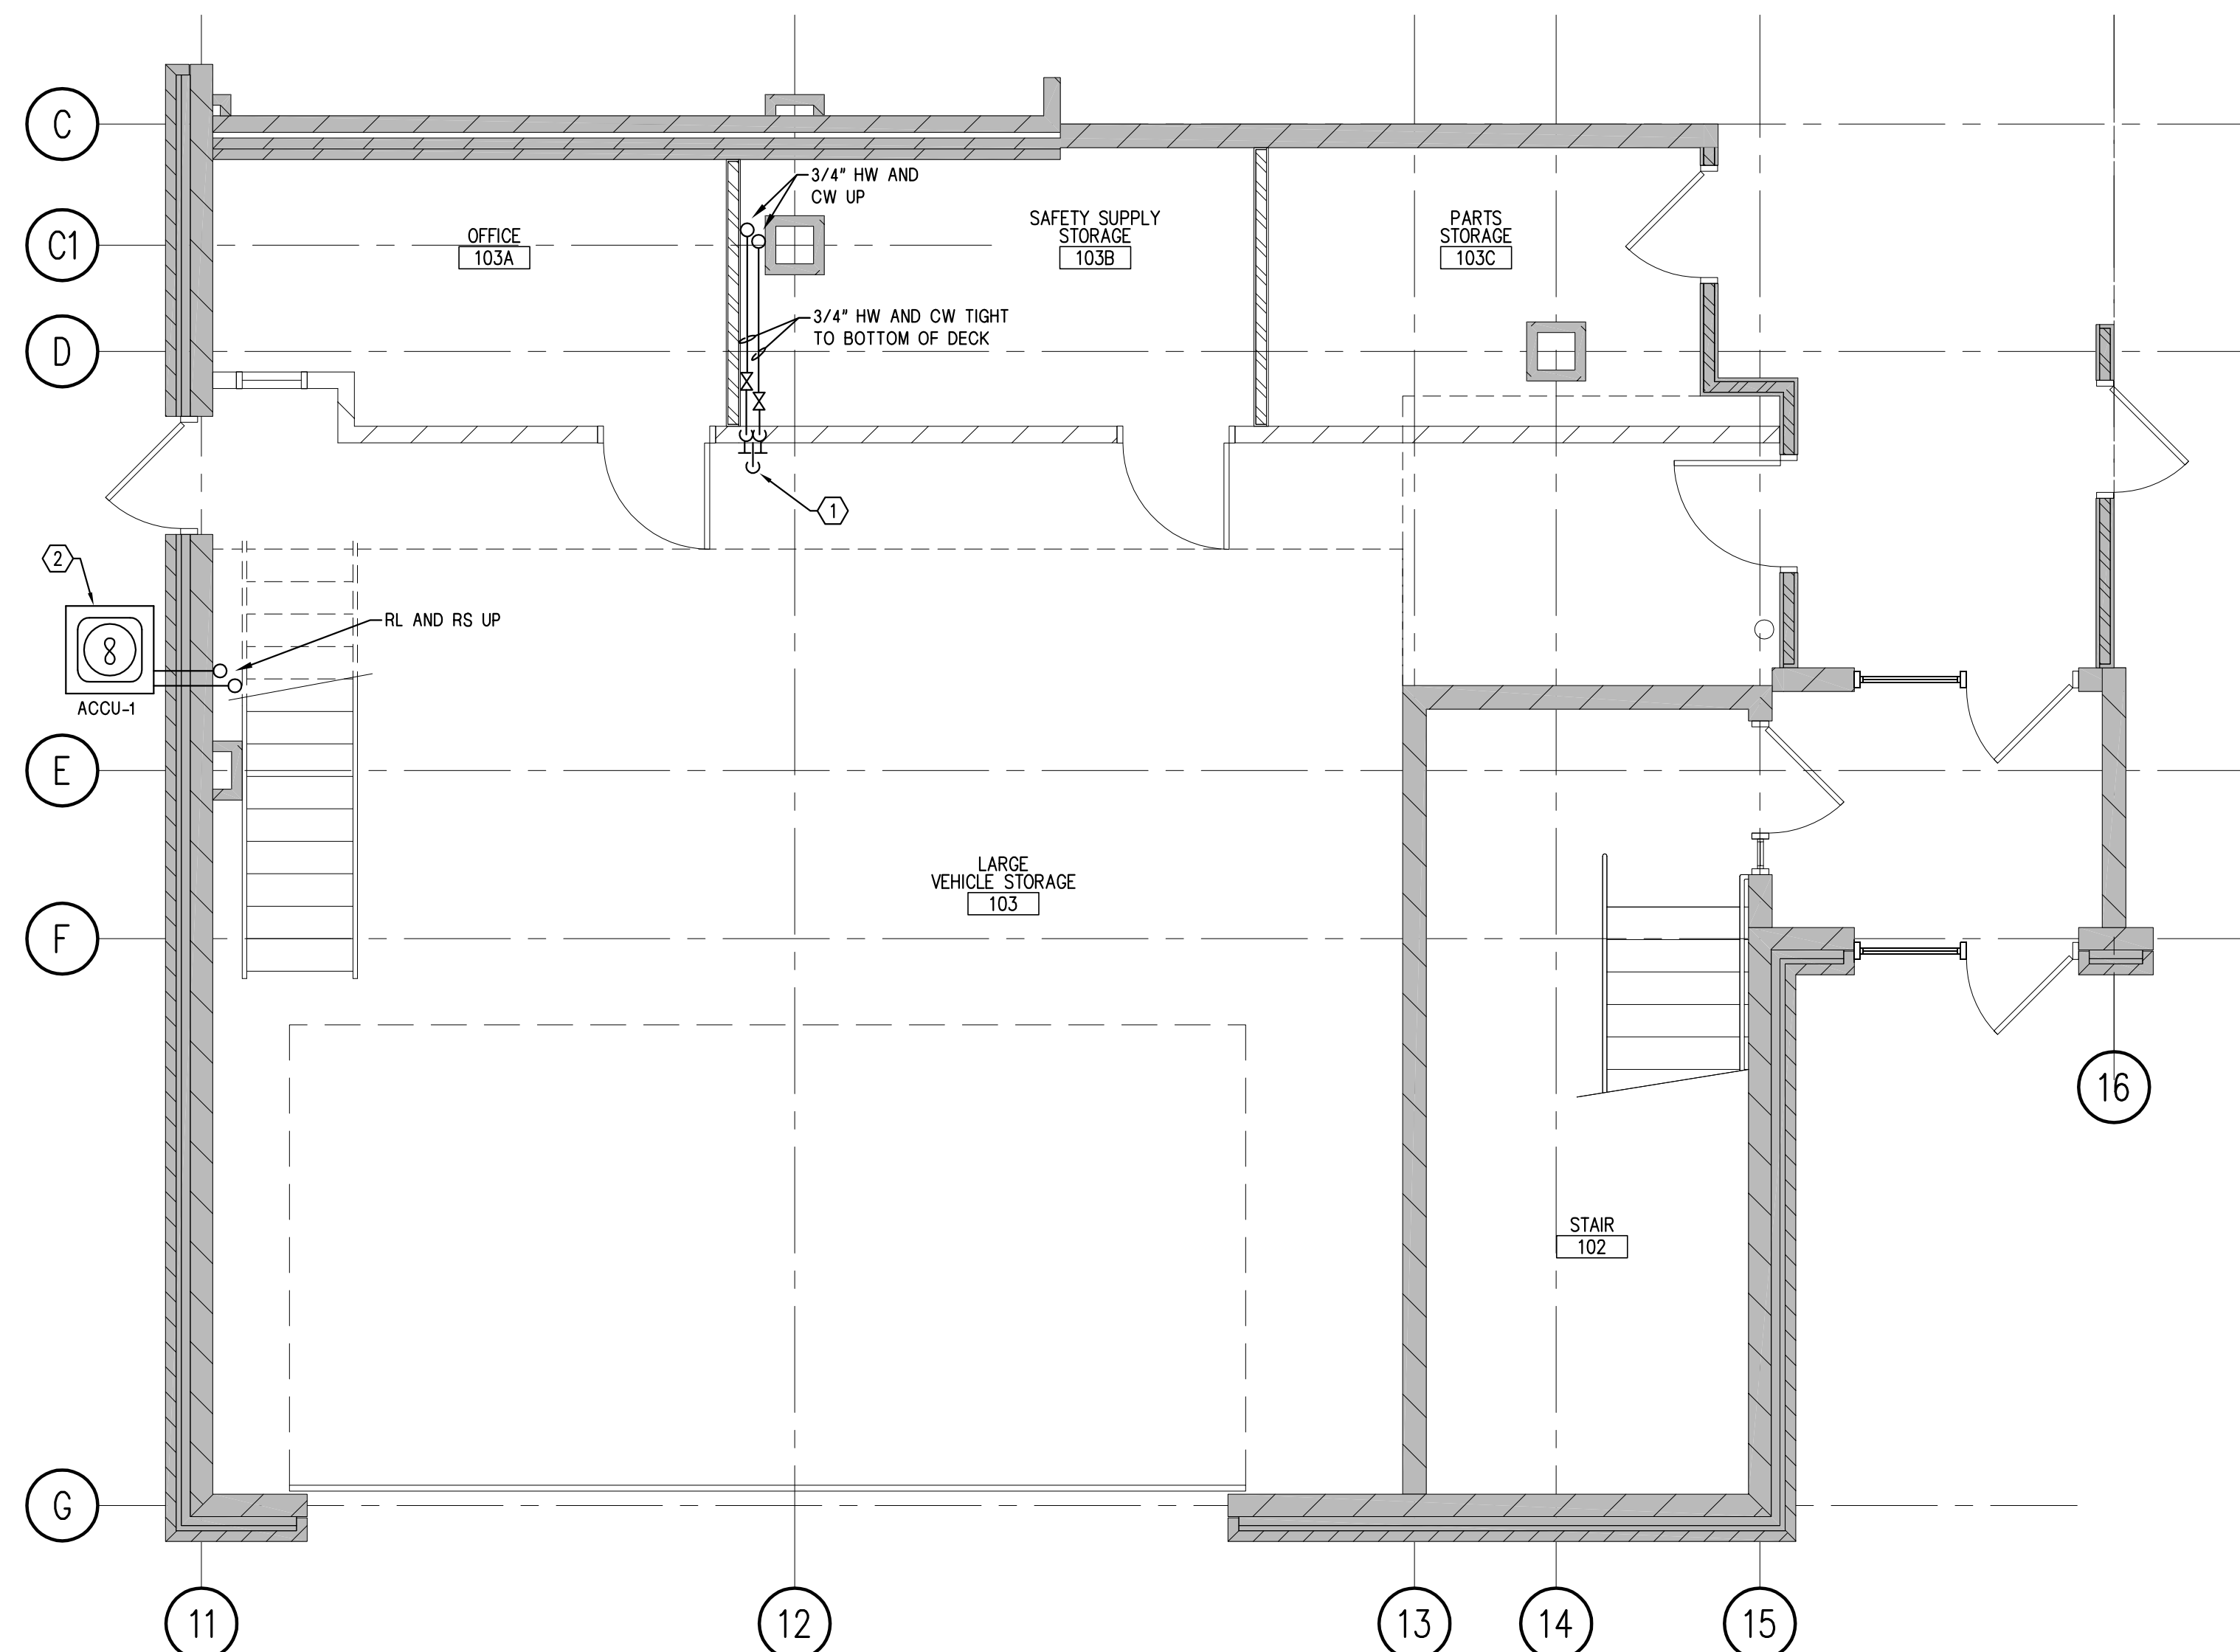


① FIRST FLOOR PIPING PLAN  
1/4" = 1'-0"  
NORTH

**MECHANICAL SPECIFICATIONS**


1. PIPING INSULATION: ASTM C 547; RIGID MOLDED, NONCOMBUSTIBLE.
  - A. MAXIMUM MOISTURE ABSORPTION: 0.2 PERCENT BY VOLUME.
  - B. VAPOR BARRIER JACKET FOR COLD PIPES: WHITE KRAFT PAPER WITH GLASS FIBER YARN BONDED TO ALUMINIZED FILM.
  - C. CANVAS JACKET ON ALL HOT AND COLD PIPES: UL LISTED 6 oz/sq yd PLAIN WEAVE COTTON FABRIC TREATED WITH DILUTE FIRE RETARDANT LAGGING ADHESIVE.
  - D. PAINT ALL NEW INSULATION TO MATCH EXISTING PIPE INSULATION FOR PIPES PROVIDING IDENTICAL SERVICE.
2. DUCT INSULATION: EXPOSED SUPPLY AND RETURN DUCTWORK ON MEZZANINE LEVEL.
  - A. 1" THICK RIGID GLASS FIBER WITH GLASS CLOTH, CANVAS, OR FOIL JACKET.
3. HOT AND COLD DOMESTIC WATER PIPING:
  - A. ASTM B88, TYPE L, HARD DRAWN TUBE.
  - B. FITTINGS: ASME B16.18 CAST COPPER ALLOY OR ASME B16.22 WROUGHT COPPER AND BRONZE.
  - C. JOINTS: SOLDERED ASTM B32 ALLOY SN95 SOLDER.
  - D. INSULATION: 1/2" THICK.
4. EQUIPMENT DRAIN PIPING:
  - A. ASTM B88, TYPE L, HARD TEMPER TUBE.
  - B. FITTINGS: ANSI B16.23 CAST BRONZE AND WROUGHT, DWV FITTINGS.
  - C. JOINTS: SOLDERED ASTM B32 ALLOY SN95 SOLDER.
  - D. INSULATION: 1/2" THICK.
5. HOT WATER HEAT PIPING:
  - A. ASTM B88, TYPE L, HARD DRAWN TUBE.
  - B. FITTINGS: ASME B16.18 CAST COPPER ALLOY OR ASME B16.22 WROUGHT COPPER AND BRONZE.
  - C. JOINTS: SOLDERED ASTM B32 ALLOY SN95 SOLDER.
  - D. INSULATION: 1" THICK.
6. REFRIGERATION PIPING AND SPECIALTIES:
  - A. TUBE: ASTM B88, TYPE K, ANNEALED.
  - B. FITTINGS: ASME B16.26 CAST COPPER.
  - C. JOINTS: FLARED.
  - D. REFRIGERANT: R-22.
  - E. INSULATION: FLEXIBLE ELASTOMERIC CELLULAR INSULATION, 1 INCH THICK. REQUIRED FOR SUCTION LINE.
  - F. EXPANSION VALVE: ANGLE OR STRAIGHT THROUGH TYPE SUITABLE FOR R-22, BRASS BODY, EQUALIZER, BLEED HOLE, ADJUSTABLE SUPERHEAT SETTING, REPLACEABLE INLET STRAINER, WITH NON-REPLACEABLE CAPILLARY TUBE AND REMOTE SENSING BULB AND REMOTE BULB WELL.
7. AIR COOLED CONDENSING UNIT, ACCU-1: 12,000 BTUH TOTAL CAPACITY RATED IN ACCORDANCE WITH ARI STANDARD 110, 208/230/1/60 ELECTRICAL, ROTARY COMPRESSOR, 13 SEER, R-22. YORK AY012MA322 OR EQUIVALENT MANUFACTURED BY CARRIER, TRANE, OR LENNOX.
8. FAN COIL UNIT, FCU-1: 400 CFM AT 0.3 INCHES OF EXTERNAL STATIC PRESSURE, 120/1/60 ELECTRICAL, LOW PROFILE PLENUM STYLE WITH RETURN AND SUPPLY DUCT CONNECTIONS. MAXIMUM HEIGHT OF 12 INCHES. ENVIRO-TEC HLP 40 OR EQUIVALENT MANUFACTURED BY CARRIER OR TRANE.
  - A. HEATING COIL: SINGLE ROW HOT WATER, 15 MBH, 180F EWT, 65F EAT.
  - B. COOLING COIL: 3 OR 4 ROW DX, 12,000 BTUH TOTAL COOLING, 78/65 EAT.
9. DUCTWORK: MINIMUM 26 ga. GALVANIZED FABRICATED AND INSTALLED IN ACCORDANCE WITH SMACNA-HVAC DUCT CONSTRUCTION STANDARDS.
  - A. SUPPLY REGISTERS (S1): 12x8 TITUS 300RL OR EQUIVALENT, DOUBLE DEFLECTION WITH OPPOSED BLADE DAMPER.
  - B. RETURN GRILLES (R1): 12x6 TITUS 350 RL OR EQUIVALENT, 35 DEGREE FIXED WITH OPPOSED BLADE DAMPER.
10. CONTROLS: 7 DAY/ 4 EVENT PROGRAMMABLE THERMOSTAT FOR HEATING AND COOLING. FURNISH AND INSTALL ALL NECESSARY LOW VOLTAGE CONTROL WIRING.



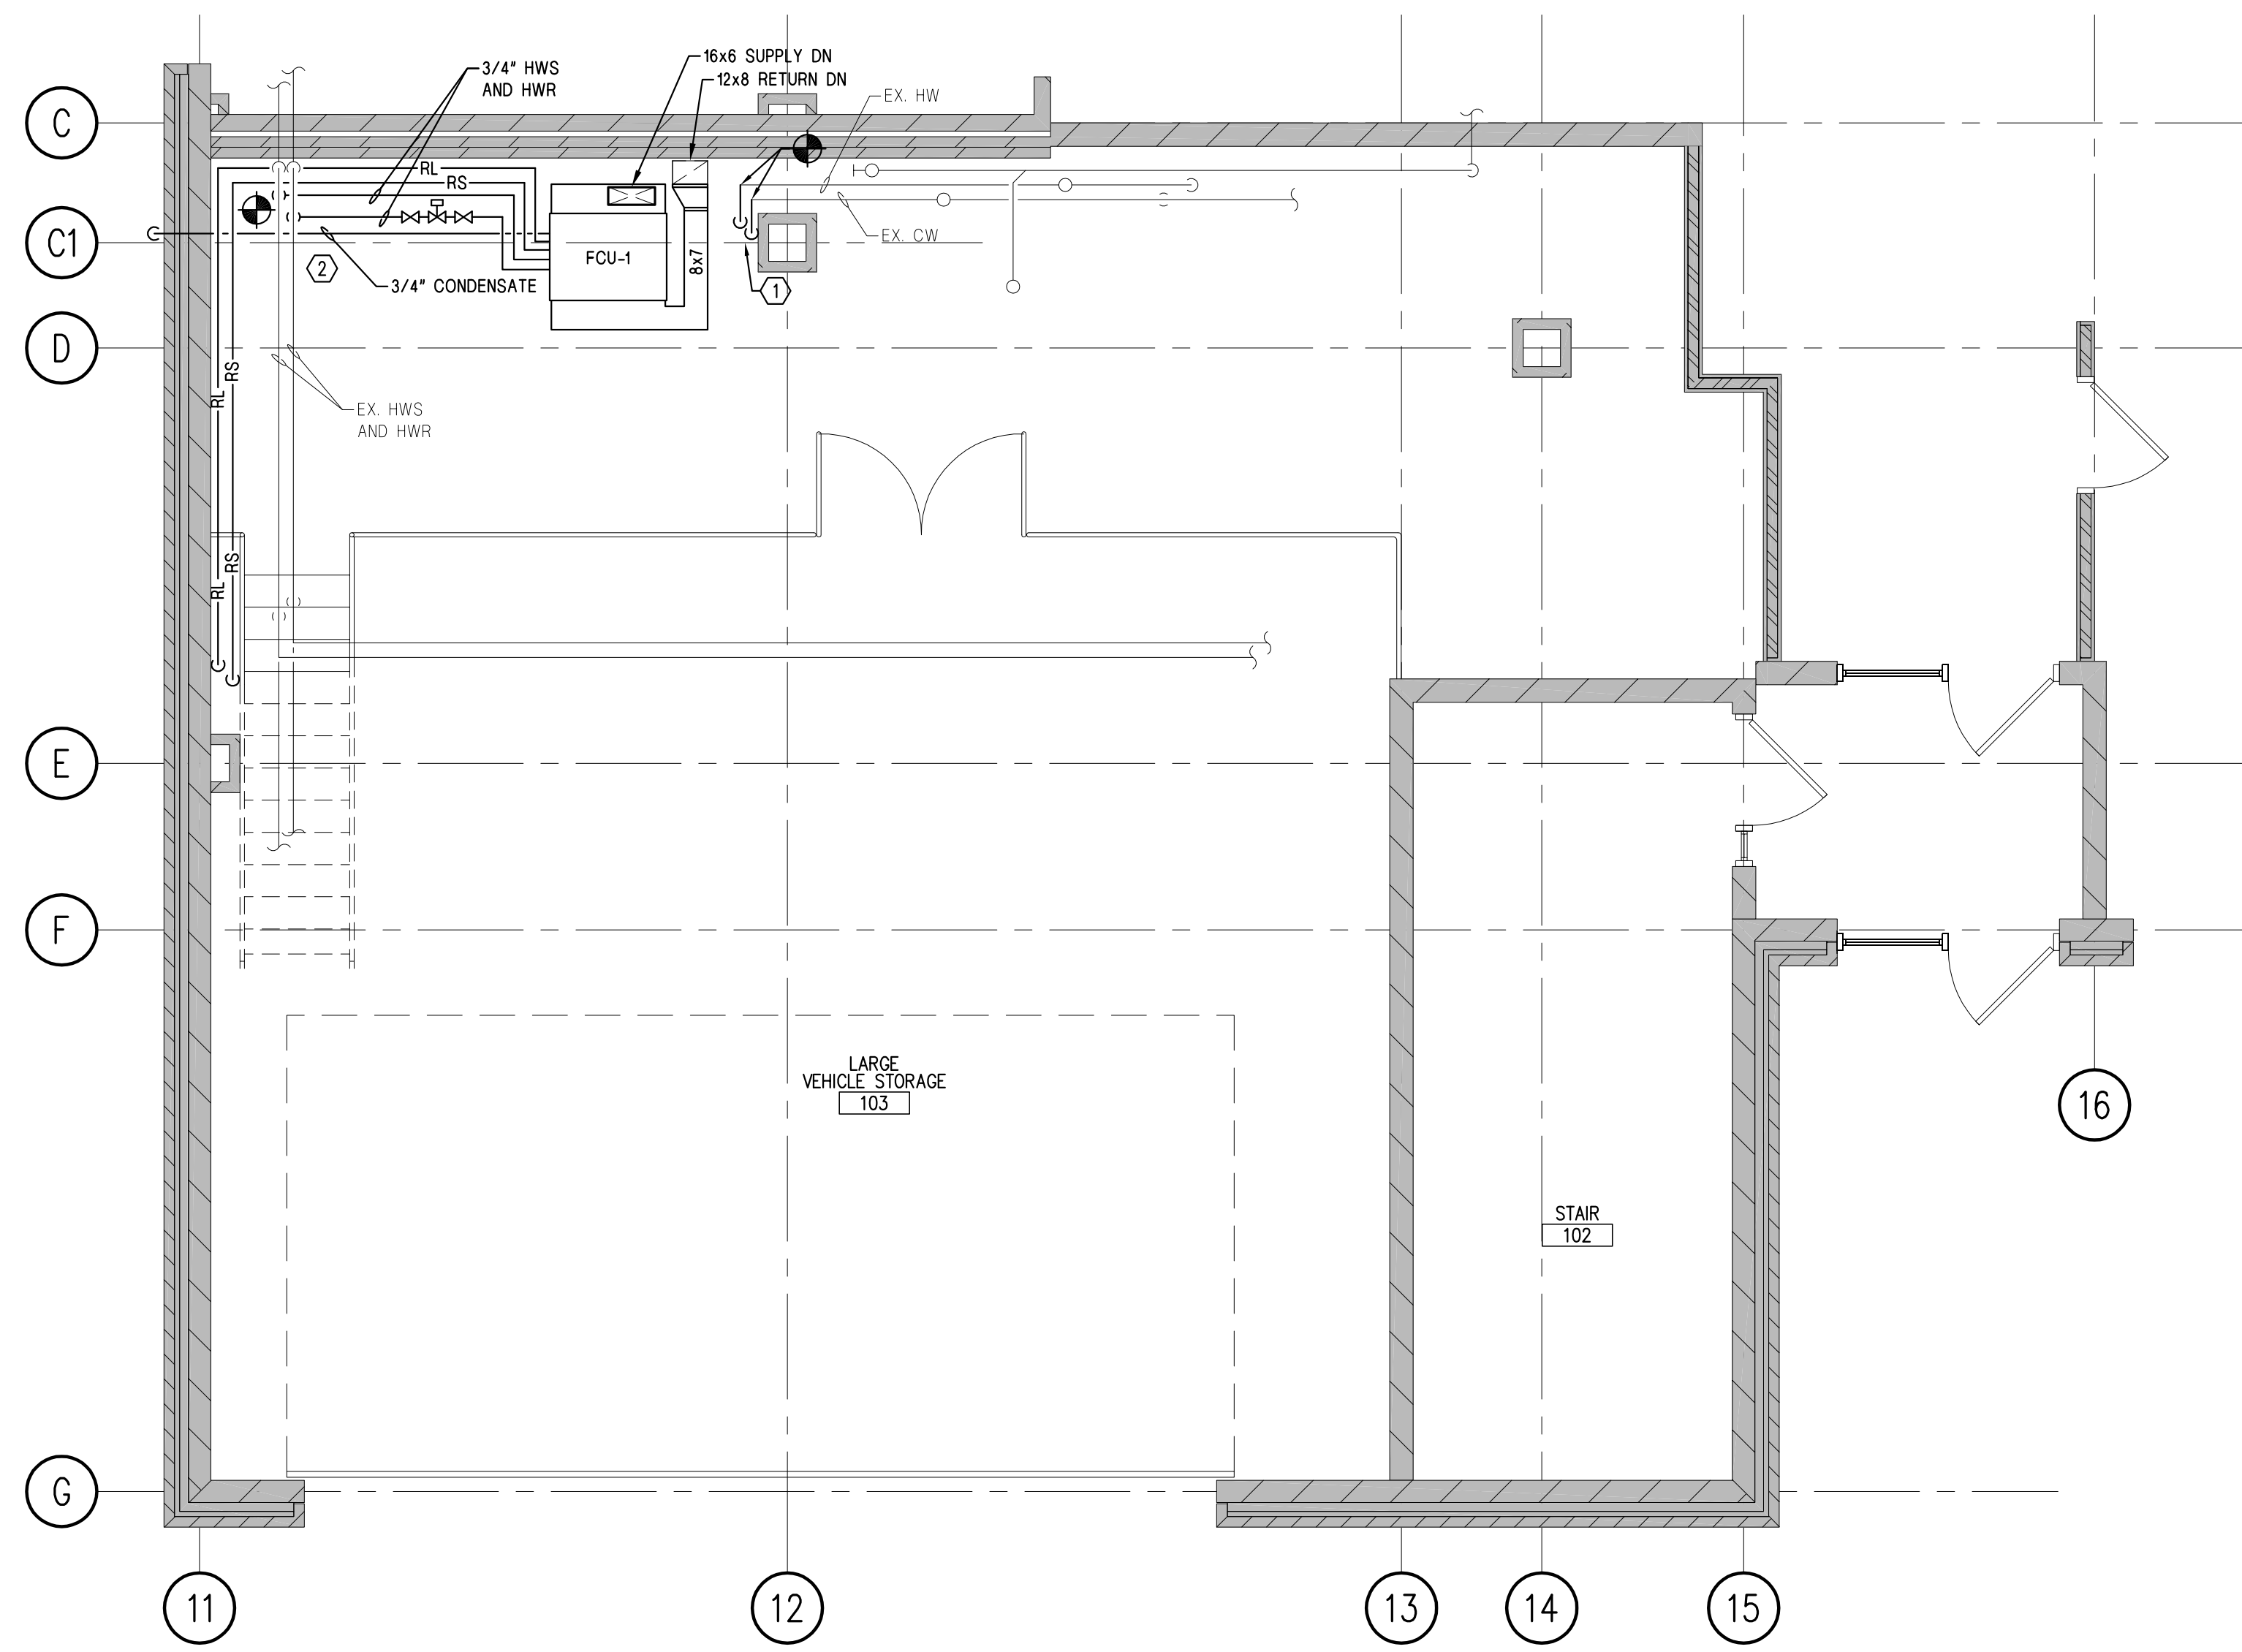

**KEYED SHEET NOTES**

- ① RELOCATE EXISTING VERTICAL HW AND CW PIPING DOWN TO FIRST FLOOR TO ACCOMMODATE FOR NEW DUCTWORK.
- ② ROUTE NEW PIPING ALONG NORTH WALL AND AS HIGH AS POSSIBLE. COORDINATE PIPE ROUTING WITH LIGHTING AND SHELVING LAYOUT.

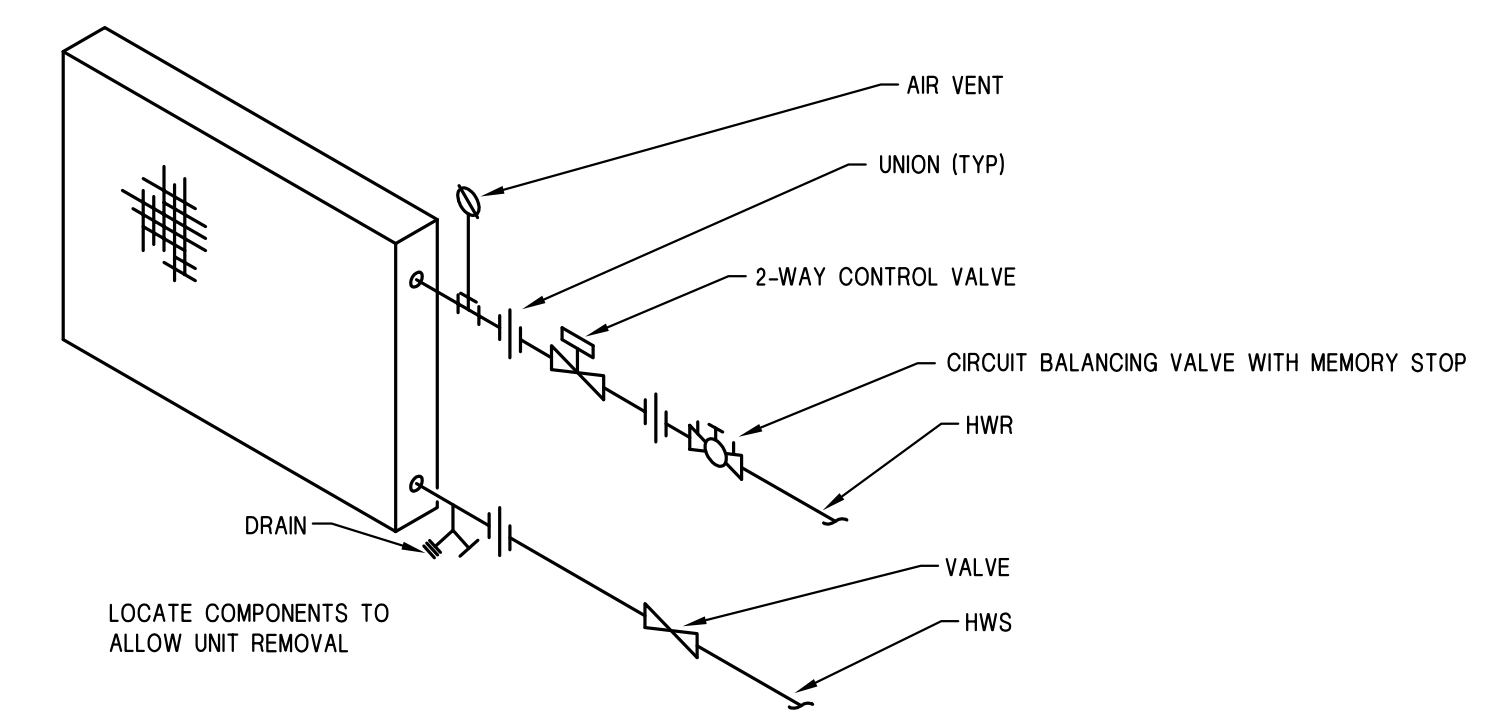

② HOT WATER COIL HOOK-UP DETAIL  
 NO SCALE

① MEZZANINE LEVEL PIPING PLAN  
 1/4" = 1'-0"  
 NORTH





21 W. Superior Street  
 Suite 500  
 Duluth, MN 55802

TEL 218/727-6446  
 FAX 218/727-6456

<http://www.LHBcorp.com>

DULUTH • MINNEAPOLIS

LHB PROJECT NO. 060565

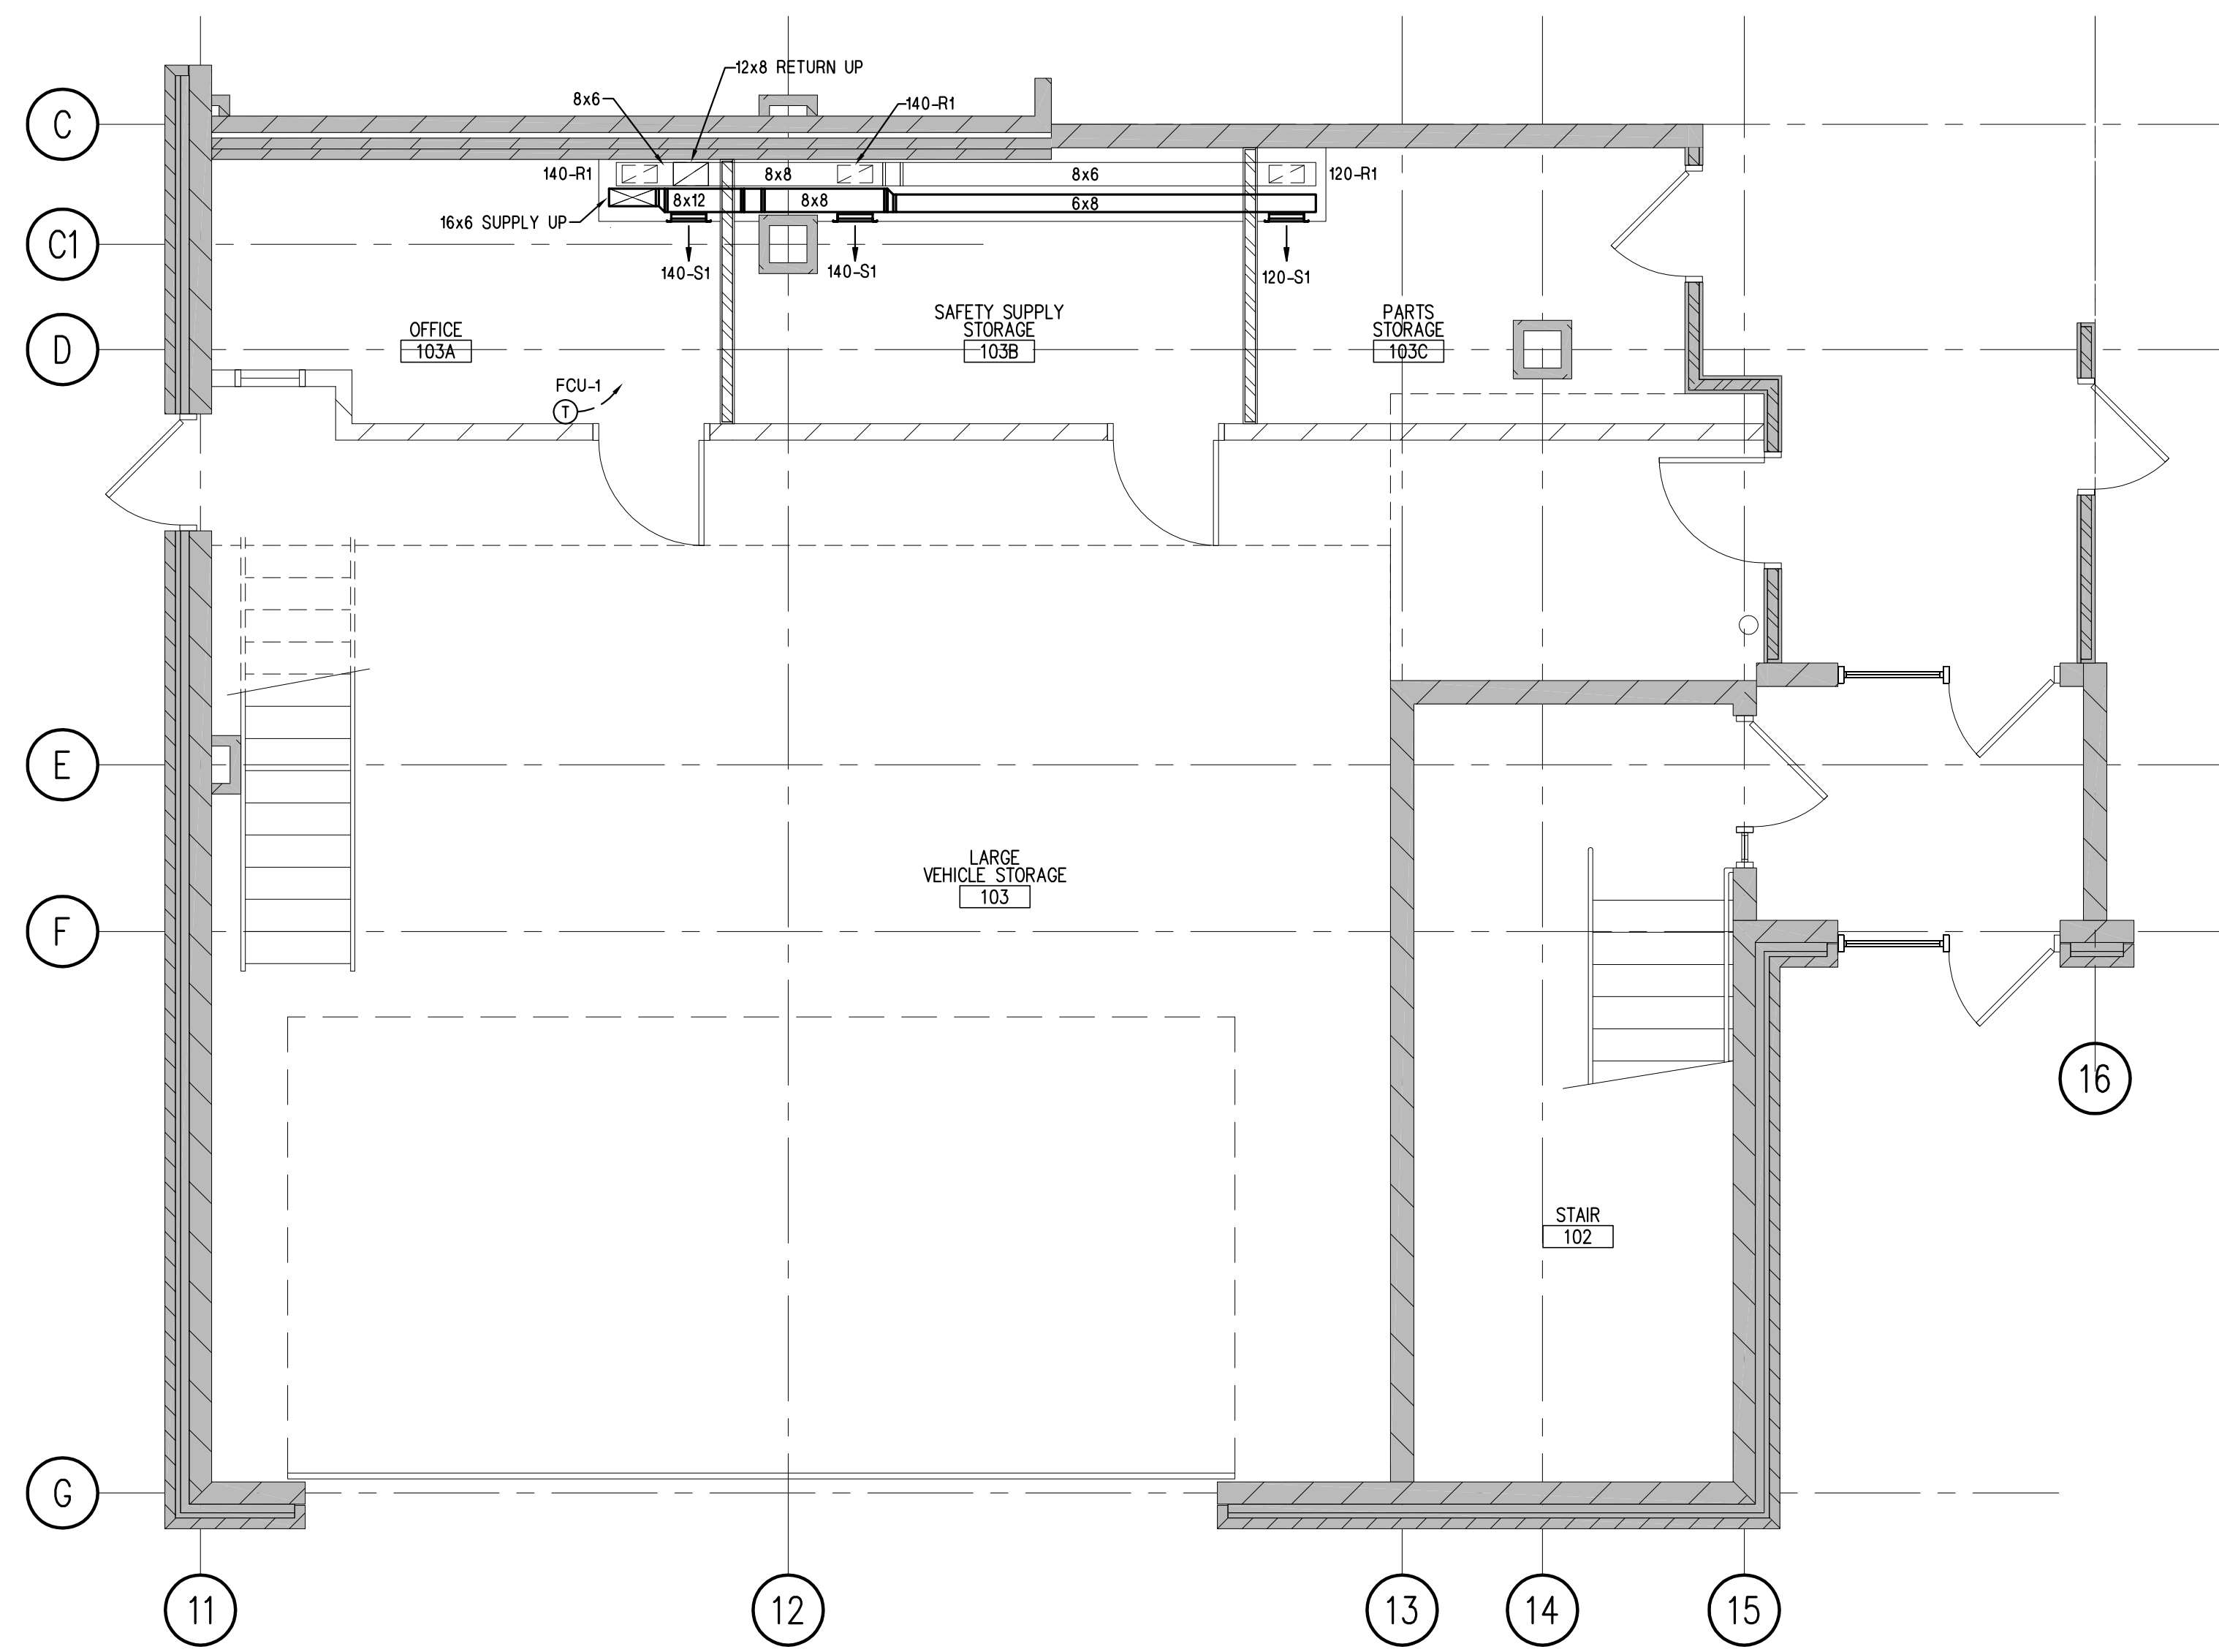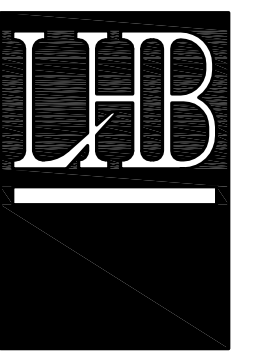

1 FIRST FLOOR VENTILATION PLAN  
 1/4" = 1'-0"



ELECTRICAL SYMBOL LEGEND

Table with 4 columns: HT AFF, SYMBOL, DESCRIPTION, and HT AFF, SYMBOL, DESCRIPTION. Lists symbols for various electrical components like lights, switches, conduits, and equipment.


ELECTRICAL SYMBOL NOTES

THE LIGHTING FIXTURE TYPE IS INDICATED BY AN UPPER CASE LETTER. THE CIRCUIT DESIGNATION IS INDICATED BY A NUMBER. THE SWITCH DESIGNATION IS INDICATED BY A LOWER CASE LETTER.

SPECIFIC CODE NOTES

- FIRE PROTECTION REQUIREMENTS
1. PENETRATIONS IN WALLS REQUIRING PROTECTED OPENINGS MUST BE FIRESTOPPED WITH AN APPROVED MATERIAL.
2. CONDUITS MAY PENETRATE WALLS OR PARTITIONS, PROVIDED THEY ARE FIRE-STOPPED.

PANELBOARD IDENTIFICATION

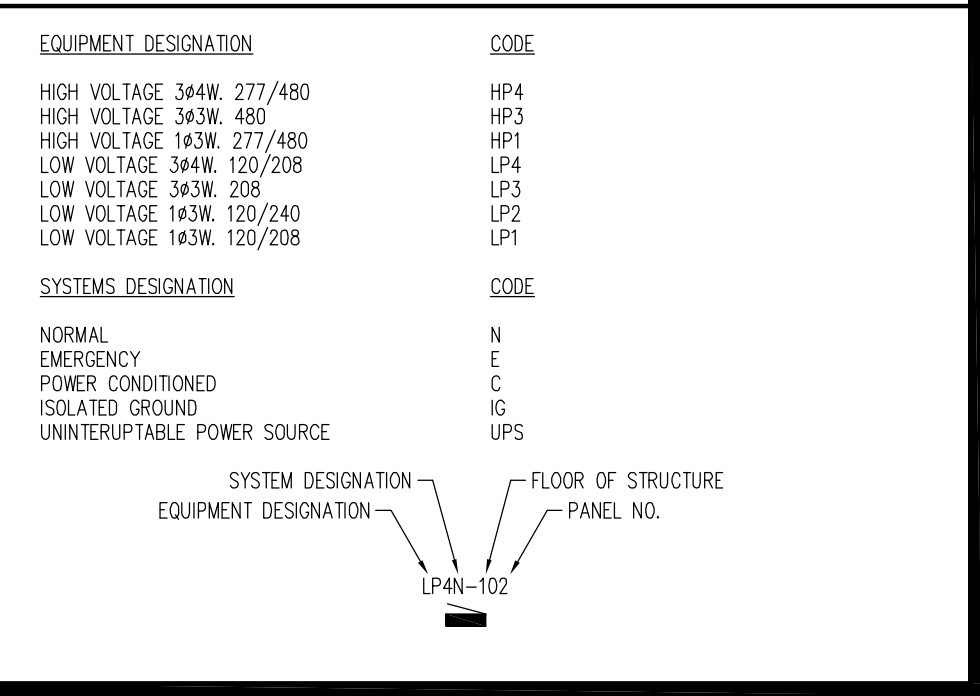

ELECTRICAL ABBREVIATIONS LIST

Table mapping abbreviations (e.g., 1P, A, AC, ACG) to their full descriptions (e.g., 1 POLE (2P, 3P, 4P, ETC.), AMPERE, ABOVE COUNTER OR AIR CONDITIONER).

GENERAL ELECTRICAL NOTES

- A. ALL CONDUCTORS OPERATING AT 50 VOLTS OR GREATER SHALL BE IN RACEWAY. ALL RACEWAY WITHIN THE STRUCTURE ABOVE THE FLOOR SLAB SHALL BE METAL.
B. ALL LOW VOLTAGE CABLES OR CONDUCTORS OPERATING AT LESS THAN 50 VOLTS SHALL BE IN METAL RACEWAY WHERE INSTALLED WITHIN WALLS OR UNACCESSIBLE SPACES.

SHEET DESCRIPTION

Table with 2 columns: SHEET and DESCRIPTION, listing sheets 10 through 14.

SCALE AS NOTED FOR 22"x34" SHEETS

ELECTRICAL SYMBOLS AND ABBREVIATIONS

OFFICE & STORAGE MEZZANINE

SUPERIOR, WISCONSIN

Table for drawing information: SURVEY, DRAWN, DESIGN, APPROVED, RECORD DRAWINGS, DATE, SHEET 10 of 14.


21 W. Superior Street  
Suite 500  
Duluth, MN 55802

TEL 218/727-8446  
FAX 218/727-8456

<http://www.LHBcorp.com>

DULUTH ■ MINNEAPOLIS

LHB PROJECT NO. 060565

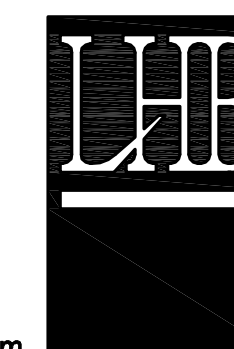


**GENERAL SHEET NOTES**

- A. SEE ARCHITECTURAL DRAWINGS AND SPECIFICATIONS FOR PHASES OF DEMOLITION AND CONSTRUCTION. COORDINATE WITH GENERAL CONSTRUCTION.
- B. DISCONNECT AND REMOVE ALL ELECTRICAL DEVICES IN WALLS TO BE DEMOLISHED. WALLS TO BE DEMOLISHED ARE SHOWN DASHED. DISCONNECT AND REMOVE ASSOCIATED CONDUIT AND WIRE BACK TO LAST REMAINING DEVICE. FURNISH AND INSTALL CONDUIT AND WIRE AS NECESSARY FOR CONTINUITY OF CIRCUIT(S) TO ANY EXISTING DEVICES TO REMAIN. COORDINATE AND VERIFY REQUIREMENTS WITH NEW WORK IN AREA.
- C. FURNISH AND INSTALL CONDUIT AND WIRE AS NECESSARY FOR CONTINUITY OF ANY FEEDERS OR BRANCH CIRCUITS ORIGINATING OUTSIDE THE DEMOLITION AREA THAT SERVES ANY ELECTRICAL EQUIPMENT OR DEVICES TO REMAIN AFTER DEMOLITION. MODIFY OR REPLACE AS REQUIRED.
- D. FURNISH AND INSTALL CONDUIT AND/OR COMMUNICATIONS/ DATA WIRING AS NECESSARY FOR CONTINUITY OF ANY WIRING ORIGINATING OUTSIDE THE DEMOLITION AREA THAT SERVES ANY COMMUNICATIONS/DATA EQUIPMENT OR DEVICES TO REMAIN AFTER DEMOLITION. MODIFY OR REPLACE AS REQUIRED.
- E. DISCONNECT AND REMOVE LIGHT SWITCHES IN PROJECT AS NECESSARY TO ACCOMMODATE NEW DOOR CONFIGURATIONS.
- F. DISCONNECT AND REMOVE ANY EXISTING ELECTRICAL DEVICES AND BACK BOXES AS NECESSARY WHERE NEW WALL CONSTRUCTION WILL INTERSECT AN EXISTING WALL. FURNISH AND INSTALL CONDUIT AND WIRE AS REQUIRED FOR CONTINUITY OF CIRCUIT(S). H. FURNISH AND INSTALL BLANK COVER PLATES OVER ALL EXISTING UNUSED OPENINGS.

**KEYED SHEET NOTES**

- ① RELOCATE FIXTURE. SEE E3.01 FOR NEW LOCATION.
- ② RELOCATE SPEAKER. SEE E4.01 FOR NEW LOCATION. EXTEND WIRING AS REQUIRED TO NEW LOCATION.
- ③ DISCONNECT AND REMOVE DEVICE OR FIXTURE. MAINTAIN LIGHTING CIRCUIT FOR CONNECTION OF NEW LIGHTING FIXTURES.
- ④ EXISTING POWER AND COMMUNICATION WIRING AND DEVICES TO REMAIN.
- ⑤ REPLACE EXISTING SWITCH FEEDING FIXTURES BEING REMOVED WITH A BLANK. REMOVE ASSOCIATED WIRING. FIELD VERIFY.
- ⑥ SALVAGE EXISTING LIGHTING FIXTURE. TURN OVER TO OWNER.

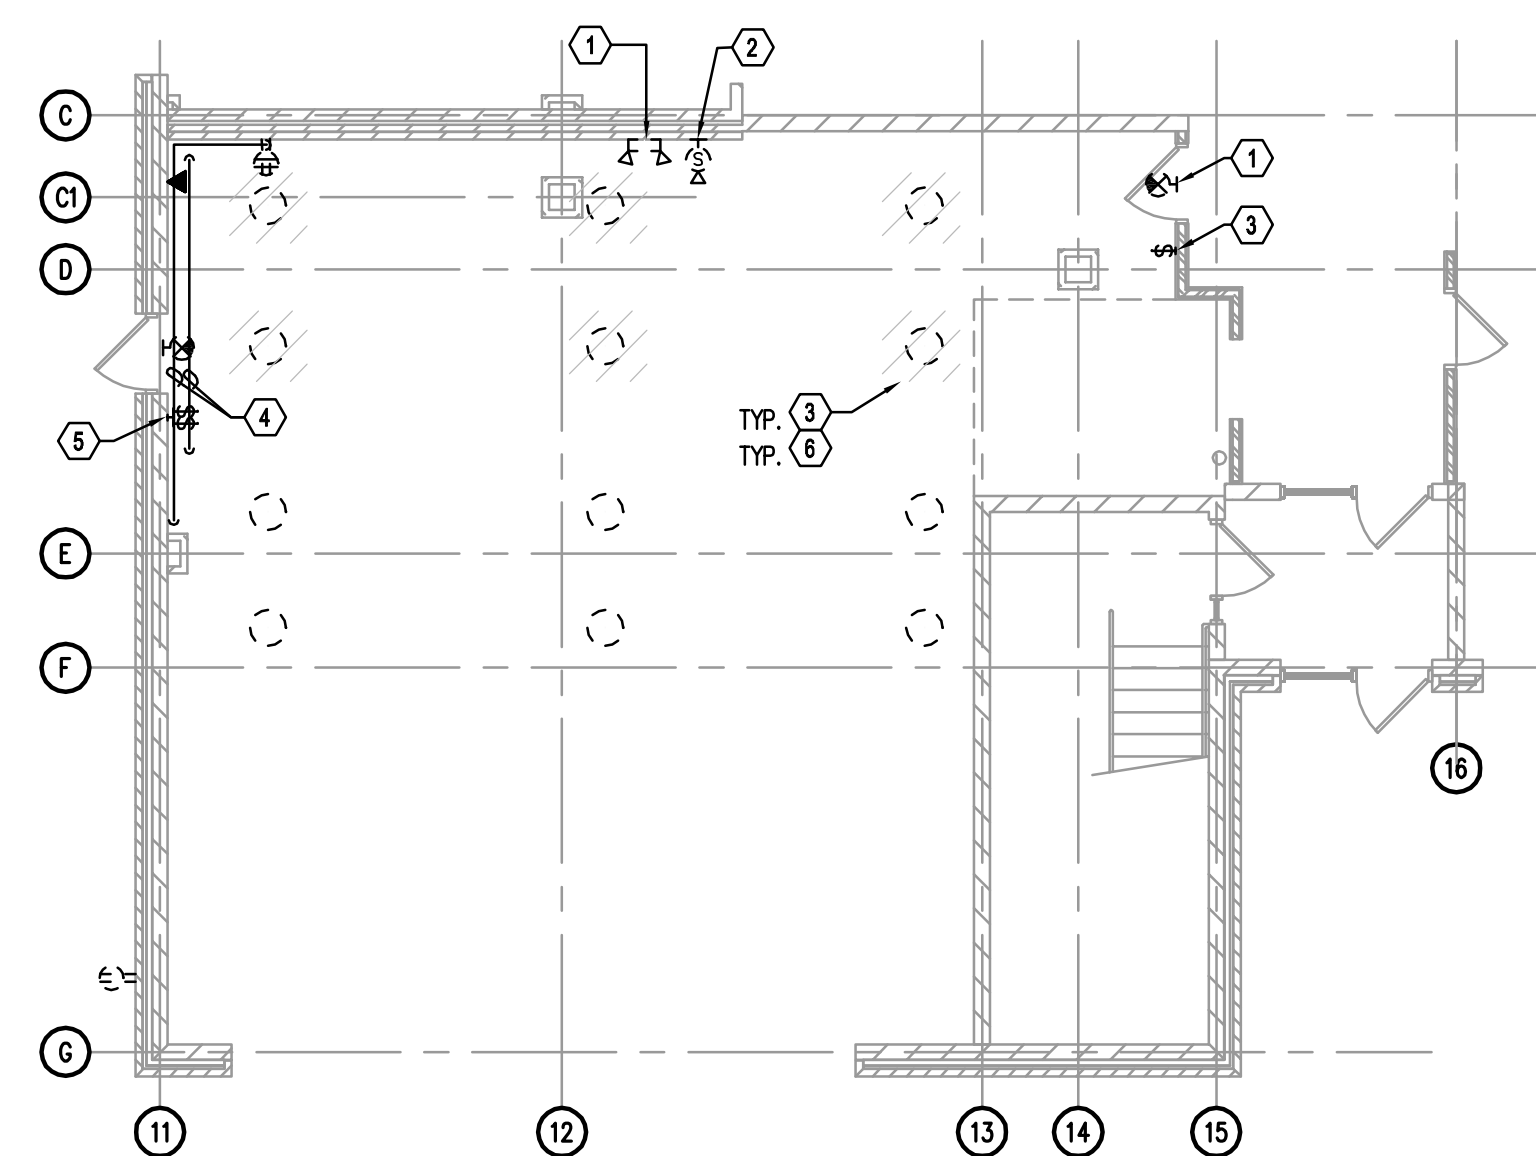

1 ELECTRICAL DEMOLITION PLAN  
1/8" = 1'-0"



| LIGHTING FIXTURE SCHEDULE |   |   |                 |  |  |      |       |                                 |                                     |       |
|---------------------------|---|---|-----------------|--|--|------|-------|---------------------------------|-------------------------------------|-------|
| TYPE                      | DESCRIPTION   | LENS/LOUVER                                 | MOUNTING        | LAMP                                     | BALLAST                                | VOLT | WATTS | MFR.                            | CATALOG SERIES                      | NOTES |
| AM                        | 8.5" X 4' ARCHITECTURAL SURFACE MOUNT FLUORESCENT FIXTURE, WHITE TEXTURE POWDER COAT CROSS BLADE LOUVER, MASTER UNIT WITH (1) 4 LAMP AND (1) 2 LAMP BALLAST FOR MULTI-LEVEL SWITCHING | MATTE WHITE ACRYLIC                         | SURFACE         | (3) F032 T8<br>20,000 HR<br>3500 DEG. K. | ELECTRONIC<br>(1) 4 LAMP<br>(2) 2 LAMP | UNV  | 90    | WILLIAMS<br><br>APPROVED EQUAL  | ASM SERIES                          |       |
| AS                        | 8.5" X 4' ARCHITECTURAL SURFACE MOUNT FLUORESCENT FIXTURE, WHITE TEXTURE POWDER COAT CROSS BLADE LOUVER, SATELLITE UNIT WITHOUT BALLAST FOR MULTI-LEVEL SWITCHING                     | MATTE WHITE ACRYLIC                         | SURFACE         | (3) F032 T8<br>20,000 HR<br>3500 DEG. K. | ---                                    | UNV  | 90    | WILLIAMS<br><br>APPROVED EQUAL  | ASM SERIES                          |       |
| C                         | 4' X 10" FLUORESCENT WRAPAROUND WITH WHITE HOUSING, INJECTION MOLDED END CAPS, AND SPRING LATCHES.  | FLAT BOTTOM PRISMATIC ACRYLIC .125" NOMINAL | CHAIN SUSPENDED | (2) F032 T8<br>3500 DEG. K.              | ELECTRONIC<br>(1) 2 LAMP               | UNV  | 60    | WILLIAMS<br>METALUX<br>LITHONIA | 23 SERIES<br>WB SERIES<br>BW SERIES |       |
| D                         | 4' LONG FLUORESCENT WALL MOUNT WITH 8" X 5" PROFILE.  | PRISMATIC ACRYLIC                           | WALL SURFACE    | (2) F032 T8<br>3500 DEG. K.              | ELECTRONIC<br>(1) 2 LAMP               | UNV  | 60    | WILLIAMS<br><br>APPROVED EQUAL  | 29 SERIES                           |       |

**GENERAL NOTES:**  
A. EC SHALL REFER TO SPECIFICATIONS REGARDING PROVIDING ADDITIONAL SPARE LAMPS, LENSES AND GLOBES.

**SCHEDULE NOTES:**

- GENERAL SHEET NOTES**
- ELECTRICAL CONTRACTOR SHALL BE RESPONSIBLE FOR WIRING ALL ELECTRICAL ITEMS SHOWN ON THIS DRAWING.
  - ALL MOUNTING HEIGHTS FOR LIGHTING FIXTURES ARE TO THE BOTTOM OF THE FIXTURES UNLESS INDICATED OTHERWISE.
  - CIRCUIT WIRING IS NOT SHOWN EXCEPT FOR SWITCHING INTENT OF FIXTURES AND CONTROL OF DEVICES.
  - PROVIDE PROPER NUMBER OF CONDUCTORS TO ACHIEVE CIRCUITING AND SWITCHING SHOWN.
  - CIRCUIT NUMBERS AT DEVICES DO NOT CORRESPOND TO PANELBOARD BREAKERS. BRANCH CIRCUITS SHALL BE SIZED ACCORDING TO THE CIRCUIT BREAKER RATING, UNLESS INDICATED OTHERWISE ON THE ELECTRICAL EQUIPMENT SCHEDULE.
  - USE #10 AWG CONDUCTORS FOR 20 AMPERE, 120 VOLT BRANCH CIRCUITS LONGER THAN 75 FEET, UNLESS SPECIFICALLY INDICATED OTHERWISE. THIS SHALL BE REQUIRED FOR THE ENTIRE LENGTH OF THE CIRCUIT.
- KEYED SHEET NOTES**
- WALL MOUNT TYPE "D" LIGHTING FIXTURE TIGHT TO BOTTOM OF MEZZANINE.
  - MOUNT TYPE "C" LIGHTING FIXTURE WITH BOTTOM OF FIXTURE FLUSH WITH BOTTOM OF BEAMS. FIELD COORDINATE LOCATIONS WITH MECHANICAL AND SHELVING UNITS.
  - RELOCATE EXISTING FIXTURE TO THIS LOCATION. CONNECT INTO UNSWITCHED LEG OF NEW LIGHTING CIRCUIT INDICATED.
  - CONNECT TO EXISTING UNSWITCHED LIGHTING CIRCUIT.
  - CONNECT TO SPARE CIRCUIT IN PANEL LP1-L.
  - ADJUST OCCUPANCY SENSOR SWITCH TO 10 MIN. DELAY PRIOR TO LIGHTS TURNING OFF.



21 W. Superior Street  
Suite 500  
Duluth, MN 55802

TEL 218/727-8446  
FAX 218/727-8456


<http://www.LHBcorp.com>

DULUTH ■ MINNEAPOLIS

LHB PROJECT NO. 060565

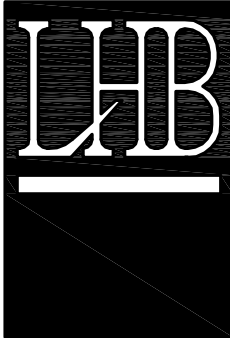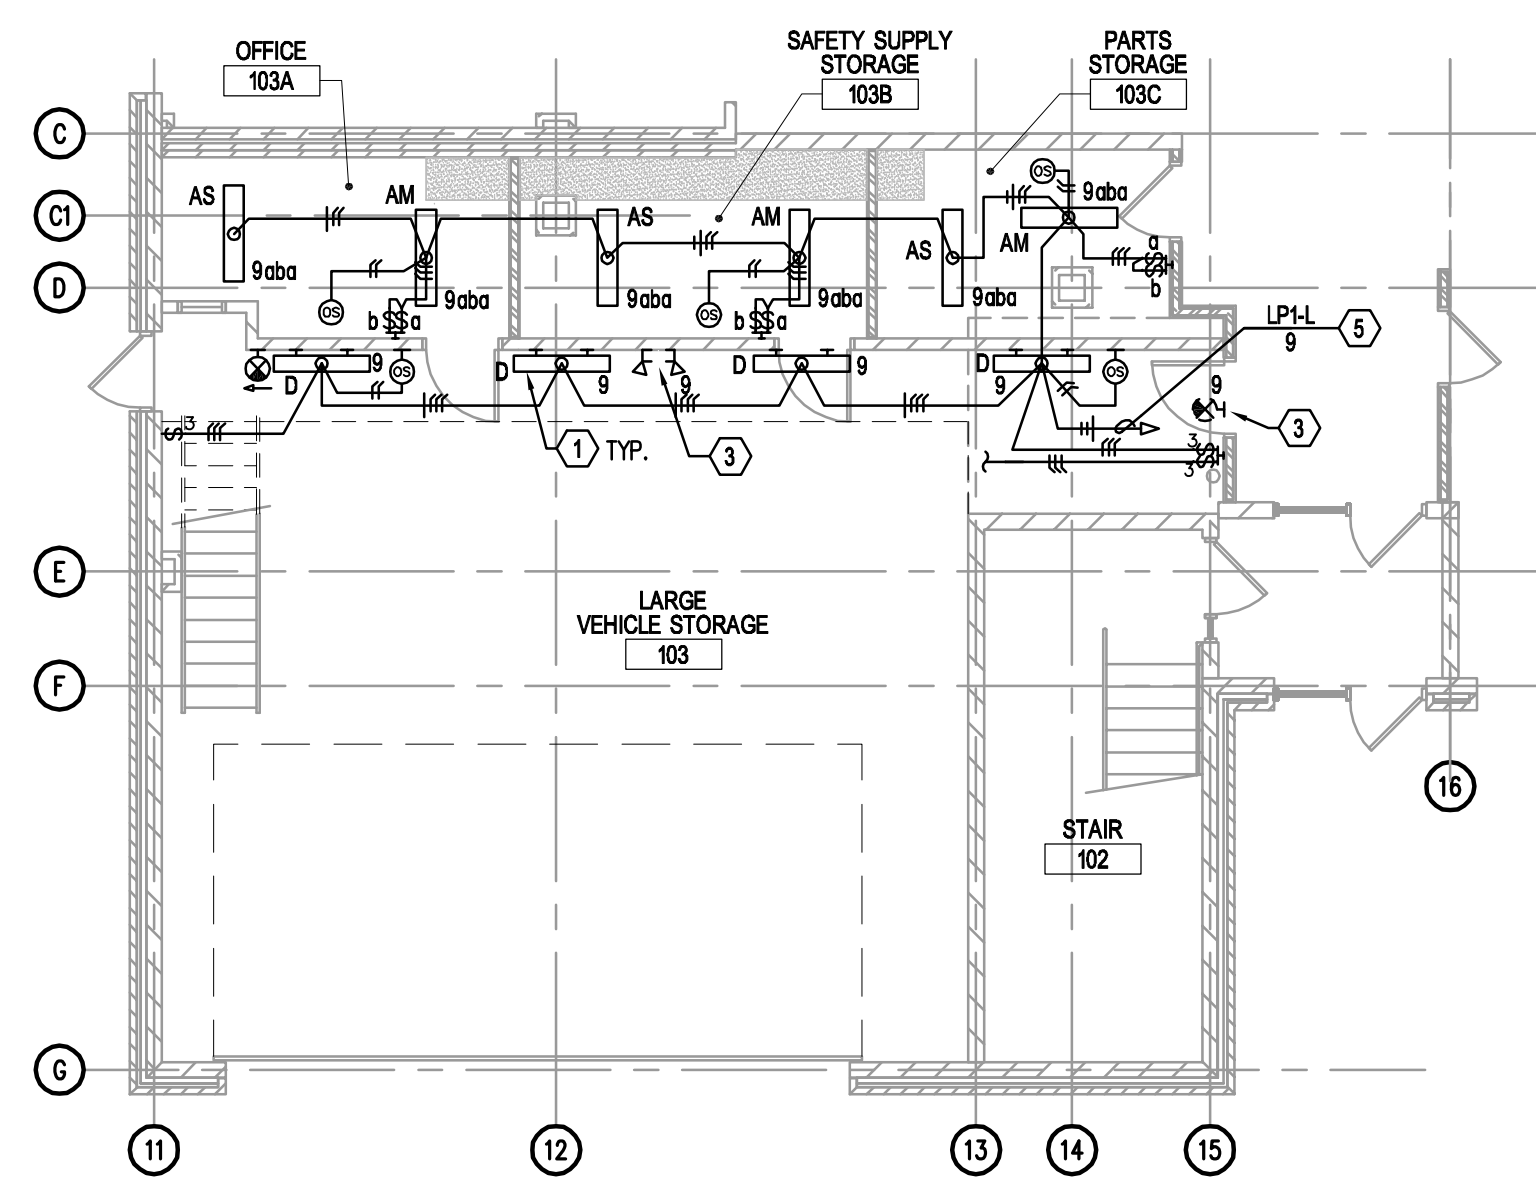1 ELECTRICAL LIGHTING MAIN LEVEL  
1/8" = 1'-0"

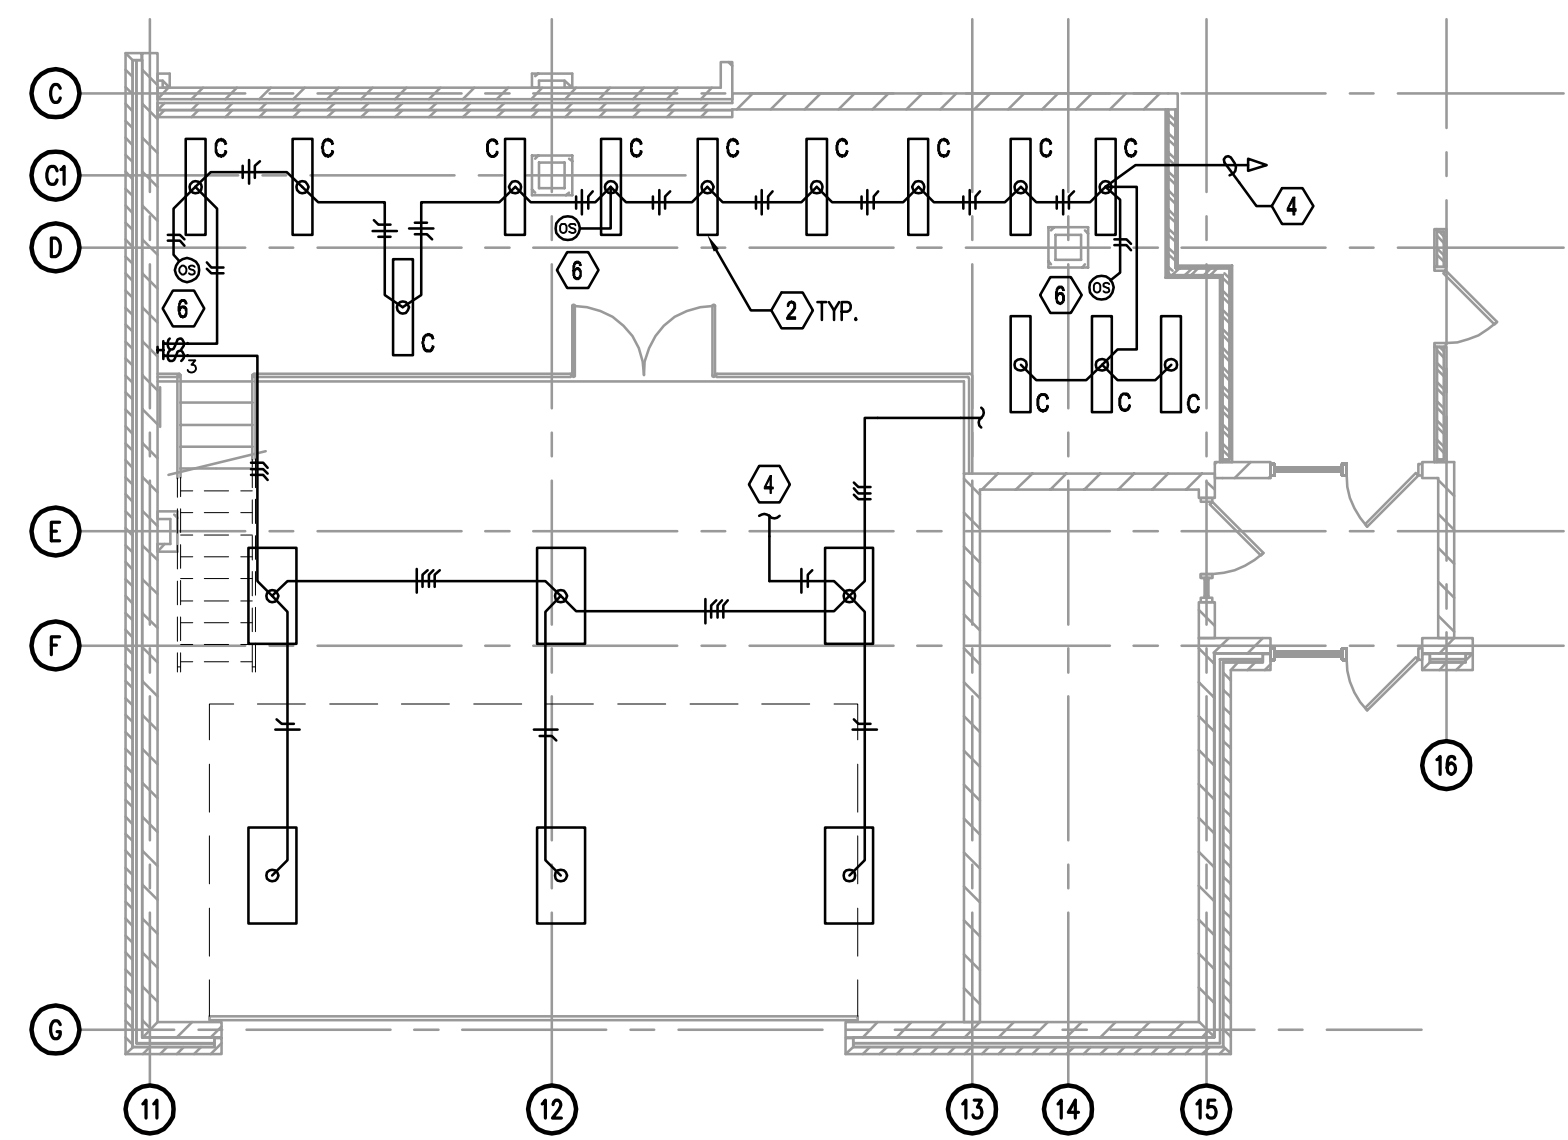

1 ELECTRICAL LIGHTING MEZZANINE LEVEL  
1/8" = 1'-0"



| ELECTRICAL EQUIPMENT SCHEDULE |                 |      |         |      |   |                         |                    |         |                |       |                        |       |       |
|-------------------------------|-----------------|------|---------|------|---|-------------------------|--------------------|---------|----------------|-------|------------------------|-------|-------|
| No.                           | DESCRIPTION     | ROOM | LOAD    | VOLT | # | CONDUIT & WIRE SIZE     | STARTER            |         | CONTROL DEVICE |       | DISCONNECT             |       | NOTES |
|                               |                 |      |         |      |   |                         | COMPONENT          | FURN.   | COMPONENT      | FURN. | COMPONENT              | FURN. |       |
| FCU-1                         | FAN COIL UNIT   |      | 2.5 A   | 120  | 1 | 16(1/2)"C-2#12          | 1P, 120 V. RELAY   | TC      | TEMP. CONTROL  | TC    | 1P HP RATED            | EC    |       |
| ACCU-1                        | CONDENSING UNIT | EXT. | 8.8 MCA | 208  | 1 | 16(1/2)"C-2 #12 #12 GND | PACKAGED EQUIPMENT | W/EQUIP | TEMP. CONTROL  | TC    | WP 30A, 2P FUSE AT 15A | EC    |       |

|  |   |   |   |
|--|---|---|---|
| <b>STARTER TYPES:</b><br>FVNR FULL VOLTAGE NON-REVERSING<br>FVR FULL VOLTAGE REVERSING<br>2-SPD TWO SPEED<br>VFD VARIABLE FREQUENCY DRIVE<br>RVS REDUCED VOLTAGE | <b>COMBINATION DISC. TYPES:</b><br>FS FUSED SWITCH<br>NFS NON-FUSED SWITCH<br>MCP MOTOR CIRCUIT PROTECTOR<br>CB CIRCUIT BREAKER | <b>CONTROL DEVICES:</b><br>HOA HAND-OFF-AUTO SWITCH<br>RP RED (RUN) PILOT LT.<br>GP GREEN (POWER) PILOT LT.<br>O/O ON-OFF SELECTOR SWITCH<br>S/S STOP-START PUSHBUTTONS | <b>ABBREVIATIONS:</b><br>EC ELEC. CONTR.<br>MC MECH. CONTR.<br>GC GENERAL CONTR.<br>TC TEMP. CONTROL<br>OWN OWNER |
|--|---|---|---|

**GENERAL NOTES:**  
A. VERIFY ROUGH-IN LOCATIONS AND EQUIPMENT REQUIREMENTS WITH EQUIPMENT SUPPLIER SHOP DRAWINGS PRIOR TO INSTALLATION OF WIRING, BOXES, OR ELECTRICAL COMPONENTS.

- GENERAL SHEET NOTES**
- ELECTRICAL CONTRACTOR SHALL BE RESPONSIBLE FOR WIRING ALL ELECTRICAL ITEMS SHOWN ON THIS DRAWING.
  - WHERE CONNECTED TO A 20A. BRANCH CIRCUIT SUPPLYING AN INDIVIDUAL RECEPTACLE (SIMPLEX OR DUPLEX), THE RECEPTACLE SHALL BE RATED AT 20A.
  - VERIFY LOCATIONS AND ROUGH-IN REQUIREMENTS OF ALL OWNER FURNISHED EQUIPMENT PRIOR TO ROUGH-IN.
  - CIRCUIT WIRING IS NOT SHOWN EXCEPT FOR SWITCHING INTENT OF FIXTURES AND CONTROL OF DEVICES.
  - PROVIDE PROPER NUMBER OF CONDUCTORS TO ACHIEVE CIRCUITING AND SWITCHING SHOWN.
  - CIRCUIT NUMBERS AT DEVICES DO NOT CORRESPOND TO PANELBOARD BREAKERS AND ARE GIVEN ONLY TO INDICATE NUMBER OF CIRCUITS NEEDED. BRANCH CIRCUITS SHALL BE SIZED ACCORDING TO THE CIRCUIT BREAKER RATING, UNLESS INDICATED OTHERWISE ON THE ELECTRICAL EQUIPMENT SCHEDULE.
  - USE #10 AWG CONDUCTORS FOR 20 AMPERE, 120 VOLT BRANCH CIRCUITS LONGER THAN 75 FEET, UNLESS SPECIFICALLY INDICATED OTHERWISE. THIS SHALL BE REQUIRED FOR THE ENTIRE LENGTH OF THE CIRCUIT.
- KEYED SHEET NOTES**
- REPLACE 2 EXISTING SPARE 20A, 1P BREAKERS IN PANEL LB2-P WITH NEW, 20A 2P HACR RATED BREAKER. ADJUST LOCATION OF OTHER BREAKERS IN PANEL AS REQUIRED TO ALLOW ROOM FOR 2 POLE ADJACENT TO EACH OTHER. CONNECT CIRCUIT TO NEW BREAKER. FIELD COORDINATE.
  - CONNECT TO AVAILABLE 120V, 20A SPARE CIRCUIT BREAKER(S) IN PANEL LP2-L.
  - RELOCATE EXISTING SPEAKER TO THIS LOCATION. EXTEND WIRING. MOUNT AT CEILING, ABOVE MEZZANINE FOR ACCESS. FIELD COORDINATE.
  - PROVIDE ADDITIONAL SWITCH TO SWITCH BOTTOM HALF OF DUPLEX RECEPTACLE.
  - RELOCATE EXISTING GARAGE DOOR OPENER SWITCH TO THIS LOCATION.


21 W. Superior Street  
Suite 500  
Duluth, MN 55802

TEL 218/727-8446  
FAX 218/727-8456


<http://www.LHBcorp.com>

**DULUTH ■ MINNEAPOLIS**

LHB PROJECT NO. 060565

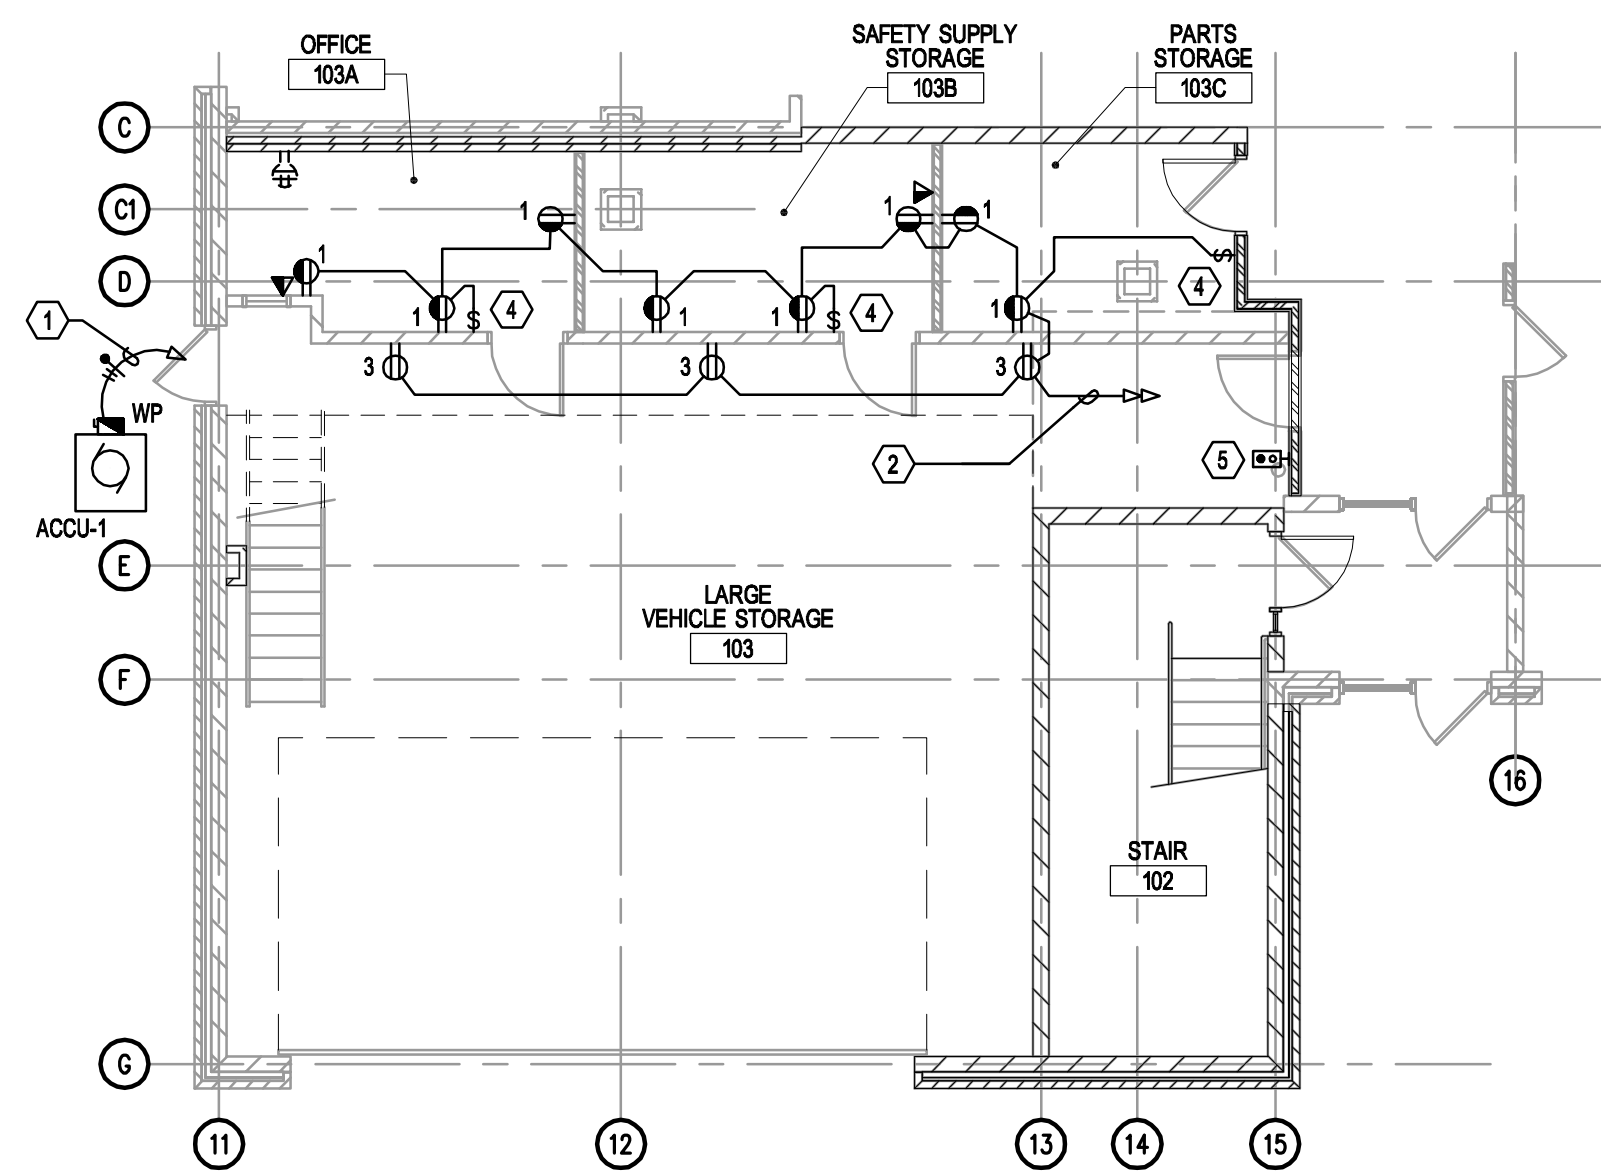

1 ELECTRICAL POWER AND SYSTEMS PLAN MAIN LEVEL  
1/8" = 1'-0"

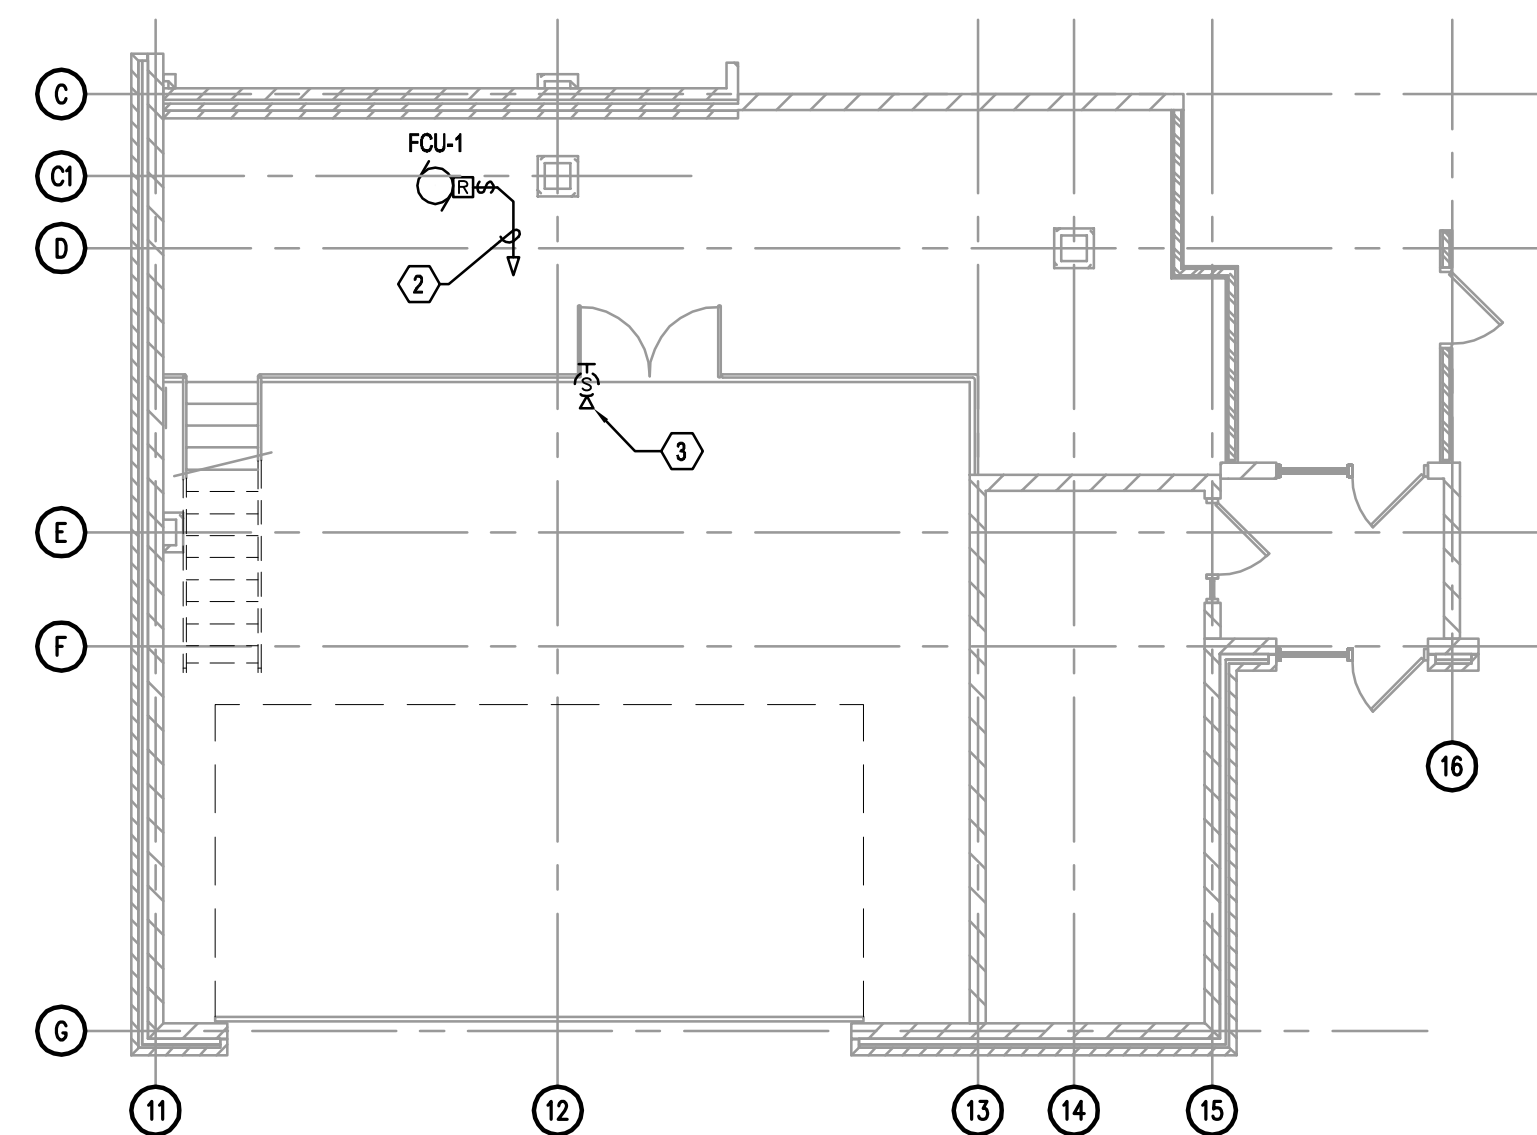


1 ELECTRICAL POWER AND SYSTEMS PLAN MEZZANINE LEVEL  
1/8" = 1'-0"



**ELECTRICAL SPECIFICATIONS**

1. NOT USED.
2. **DRAWINGS AND MEASUREMENTS:**  
THE DRAWINGS ARE NOT INTENDED TO BE SCALED FOR ROUGHING-IN MEASUREMENTS NOR TO SERVE AS SHOP DRAWINGS.
3. **ORDINANCES AND CODES:**  
ALL WORK SHALL BE EXECUTED IN ACCORDANCE WITH THE CURRENT EDITION OF THE NATIONAL, STATE, AND LOCAL CODES. ALL FEES, PERMITS, LICENSES, ETC., NECESSARY IN ORDER TO COMPLETE THE WORK OF THIS SECTION SHALL BE PAID BY THIS CONTRACTOR.
4. **GUARANTEE:**  
THIS CONTRACTOR SHALL ASSUME RESPONSIBILITY FOR ANY DEFECTS WHICH MAY DEVELOP IN ANY PART OF HIS WORK FOR A PERIOD OF ONE YEAR.
5. **QUALITY ASSURANCE:**  
ALL MATERIALS AND EQUIPMENT SHALL BE NEW AND OF BEST QUALITY, OF THE TYPE BEST SUITED FOR THE PURPOSE INTENDED, AND BE MADE BY NATIONALLY RECOGNIZED AND SUBSTANTIALLY ESTABLISHED MANUFACTURERS.
6. **SHOP DRAWINGS:**  
SHOP DRAWING SUBMITTALS SHALL CONTAIN SIX (6) COPIES OF EACH DRAWING. SHOP DRAWINGS SHALL BE SUBMITTED FOR ALL MAJOR PIECES OF EQUIPMENT.
7. **DEMOLITION AND DISPOSAL:**  
EXISTING EQUIPMENT REMOVED AND NOT SPECIFICALLY CALLED OUT TO BE RE-USED SHALL BECOME THE PROPERTY OF THE CONTRACTOR. THE CONTRACTOR SHALL REMOVE FROM THE SITE AND DISPOSE OF ALL ITEMS NOT TO BE RE-USED OR SALVAGED. FLUORESCENT LAMPS, OTHER HID LAMPS AND PCB BALLASTS SHALL BE PROPERLY DISPOSED BY THIS CONTRACTOR IN ACCORDANCE WITH THE APPLICABLE LAWS AND REGULATIONS PERTAINING TO THE DISPOSAL OF HAZARDOUS WASTE.
8. **CUTTING AND PATCHING:**  
IN EXISTING CONSTRUCTION THIS CONTRACTOR SHALL PERFORM ALL CUTTING REQUIRED AND ALL NECESSARY PATCHING AFTER COMPLETION TO RESTORE THE SURFACE TO ITS ORIGINAL CONDITION, UNLESS OTHERWISE INDICATED. THIS CONTRACTOR SHALL NOT ENDANGER THE STABILITY OF THE STRUCTURE BY CUTTING, DIGGING OR OTHERWISE, AND SHALL NOT AT ANY TIME CUT OR ALTER WORK OF ANY OTHER CONTRACTOR.
9. **ELECTRICAL METALLIC TUBING:**  
EMT MAY BE USED IN FURRED CEILING AREAS, INTERIOR PARTITIONS, AND SURFACE MOUNTED IN EQUIPMENT ROOMS. EMT SHALL NOT BE USED IN SLAB ON GRADE OR WHERE EXPOSED TO MOISTURE OR EARTH.
10. **IMC CONDUIT:**  
IMC MAY BE USED IN UNDERGROUND INSTALLATIONS, AND IN SLAB ON GRADE. USE IMC IN EXTERIOR LOCATIONS AND WHERE EXPOSED TO MOISTURE OR EARTH.
11. **FLEXIBLE METAL CONDUIT:**  
FLEXIBLE METAL CONDUIT SHALL BE USED FOR CONNECTIONS TO MOTORS, FIXED AND APPLIANCES, RECESSED LUMINAIRES WHERE REQUIRED. IN KITCHENS, WELLS, SUMP PITS, TRANSFORMER CONNECTIONS AND AREAS OF HIGH MOISTURE CONTENT, LIQUID-TIGHT CONDUIT WITH LIQUID-TIGHT FITTINGS SHALL BE USED.
12. **FITTINGS:**  
FITTINGS FOR EMT SHALL BE DIE-CAST SET SCREW TYPE.
13. **GENERAL INSTALLATION:**  
CONDUITS SHALL BE SIZED AS NOTED OR AS REQUIRED BY NEC FOR NUMBER AND SIZE OF CONDUCTORS INSTALLED.
14. **BOXES:**  
OUTLET BOXES SHALL BE AT LEAST 1-1/2 INCHES DEEP, SINGLE OR GANG STYLE TYPE OF SIZE TO ACCOMMODATE DEVICES NOTED.
15. **WIRE AND CABLE (600 VAC):**  
ALL WIRE AND CABLE FOR FEEDER AND BRANCH CIRCUITS SHALL BE COPPER AND CONFORM TO THE REQUIREMENTS OF THE CURRENT EDITION OF THE NEC. MINIMUM CONDUCTOR SIZE BE NO. 12 UNLESS OTHERWISE NOTED. WIRE SHALL BE TYPE THIN OR THIN.
16. **REMODELING WORK:**  
THIS CONTRACTOR SHALL VISIT EXISTING BUILDING BEFORE STARTING THE PROJECT AND BECOME FAMILIAR WITH EXISTING CONDITIONS. ANY ABANDONED WIRING SHALL BE REMOVED.
17. **WIRING DEVICES:**  
DUPLEX RECEPTACLES SHALL BE SPECIFICATION GRADE, 15 AMPS, 120 VOLT, 2 WIRE GROUNDING TYPE WITH GROUNDING TERMINAL. RECEPTACLES SHALL BE IVORY COLOR. EACH SWITCH OUTLET SHALL BE EQUIPPED WITH A TOGGLE SWITCH, 20 AMP, 120/277 VOLT A.C. RATED, QUIET TYPE. SWITCHES SHALL BE IVORY COLOR. (DEVICES IN REMODELED AREAS SHALL MATCH COLOR AND TYPE OF EXISTING DEVICES IN THE AREA BEING REMODELED.) ALL OUTLET PLATES IN FINISHED AREAS SHALL BE BRUSHED ALUMINUM STYLE WITH OPENINGS FOR DEVICES INTENDED. PLATES IN UNFINISHED AREAS MAY BE CADMIUM PLATED STEEL.
18. **MOTORS & EQUIPMENT:**  
THIS CONTRACTOR SHALL MAKE CONNECTIONS TO ALL MOTORS AND EQUIPMENT SHOWN ON THE DRAWINGS. DISCONNECT SWITCHES SHALL BE GENERAL DUTY NON-FUSED TYPE UNLESS NOTED OTHERWISE. FINAL CONNECTION TO MOTORS AND EQUIPMENT SHALL BE WITH FLEXIBLE METAL CONDUIT OR LIQUID-TIGHT.
19. **TELEPHONE AND DATA CONDUIT AND OUTLET SYSTEM:**  
THE CONTRACTOR SHALL FURNISH AND INSTALL PHONE AND DATA OUTLETS WITH 3/4" CONDUIT STUBBED INTO ACCESSIBLE CEILING SPACE. OUTLET SYSTEM SHALL BE A TWO GANG BOX TO TERMINATE CONDUIT. PROVIDE SINGLE GANG MUD RING AND BLANK COVERPLATE.
20. **LIGHTING FIXTURES:**  
FURNISH AND INSTALL ALL LIGHTING FIXTURES, INCLUDING LAMPS AND MOUNTING EQUIPMENT, AS SHOWN ON THE DRAWINGS. SEE LIGHTING FIXTURE SCHEDULE FOR TYPES.

21 W. Superior Street  
Suite 500  
Duluth, MN 55802  
TEL 218/727-8446  
FAX 218/727-8456

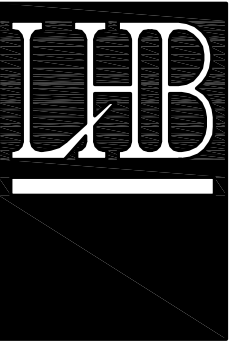

<http://www.LHBcorp.com>

DULUTH □ MINNEAPOLIS

LHB PROJECT NO. 060565