


N. FIRST ST.



36-IN. SEWER

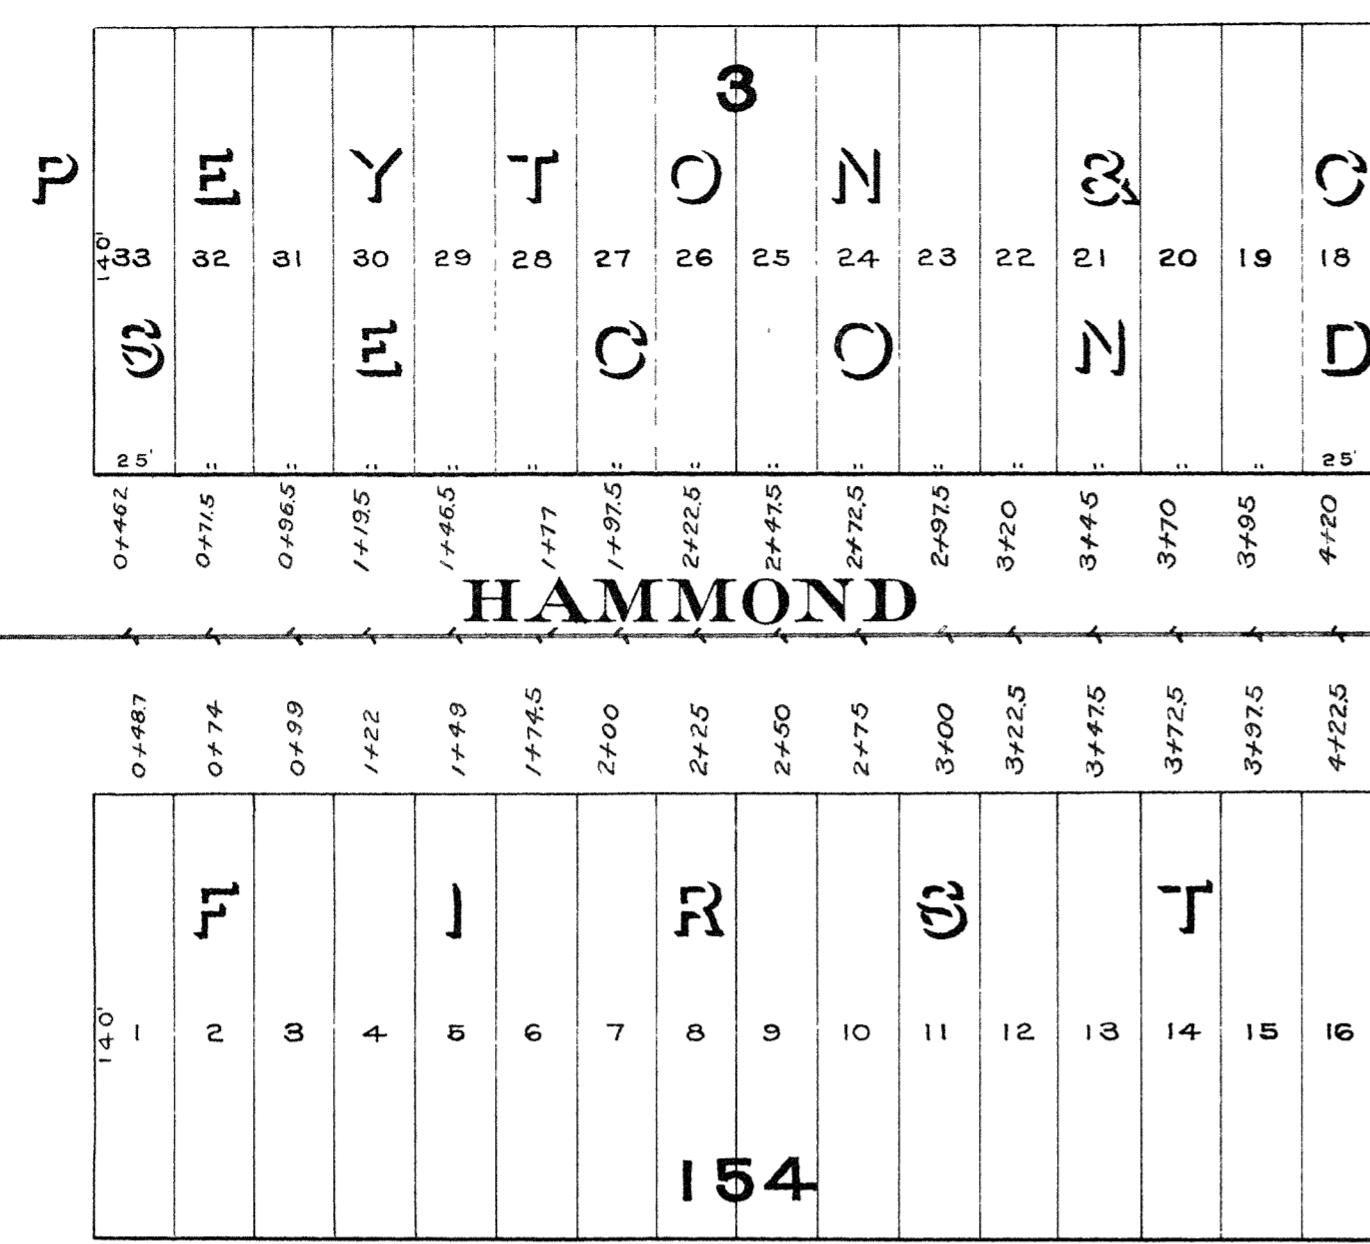

N. SECOND ST.

ST.

T.

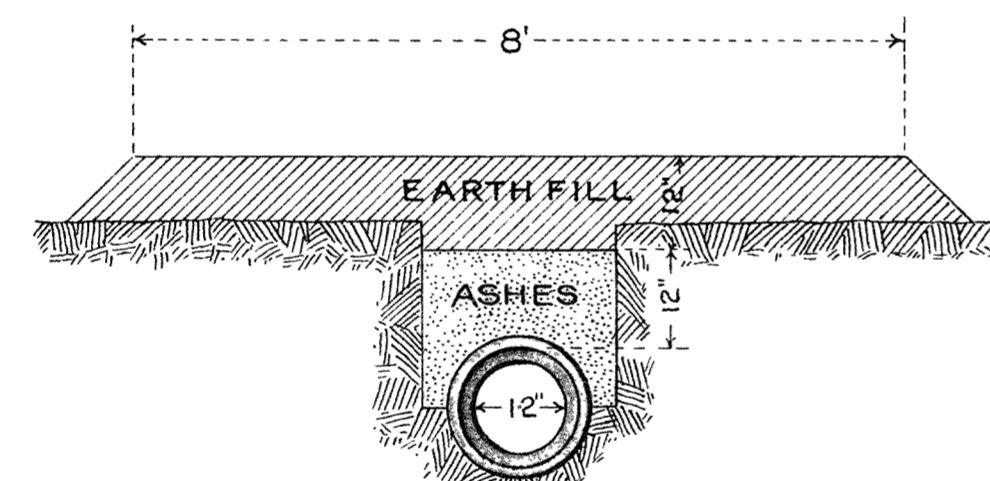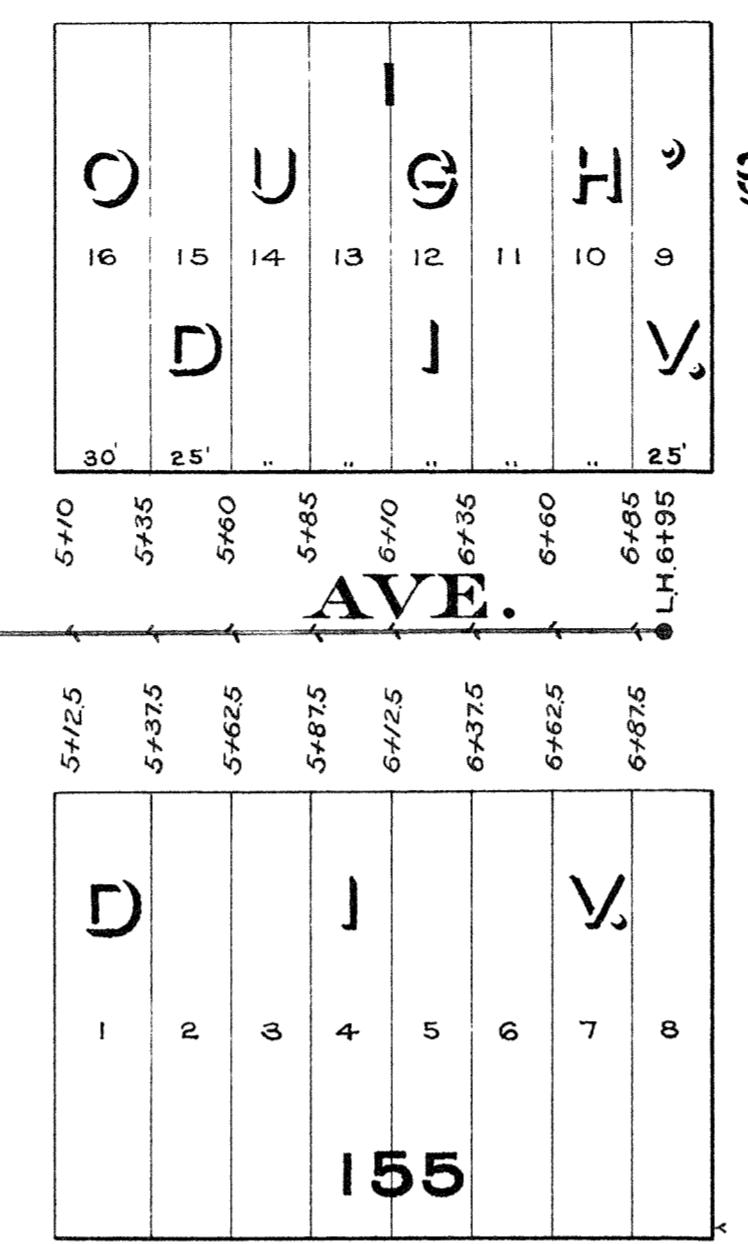

SECTION OF SEWER AT STA. 2.

SCALE $\frac{1}{2}$ IN.=1 FT.

CITY OF SUPERIOR SEWER PLAN

Horizontal Scale: 1 inch = 60 feet.
Vertical Scale: 1 inch = 4 feet.

CONTRACT NO. 1310
 Contract let Sept. 5, 1911.
 Contract completed Sept. 28, 1911.
 Swan Holmquist Contractor.
 W. H. Johnson Inspector.
 E. B. Banks City Engineer.

