



**CITY OF SUPERIOR
SEWER PLAN**

Contract let April 1, 1890
 Completed Apr. 28, 1891
 Kirkland & Starkey, Contractor
 M. Conroy, Inspector
 E. B. Banks, City Engineer

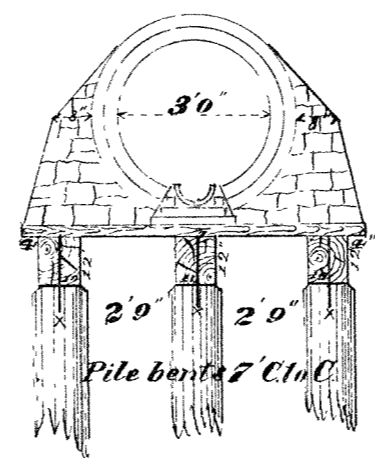

Section of 3' Sewer on Piles

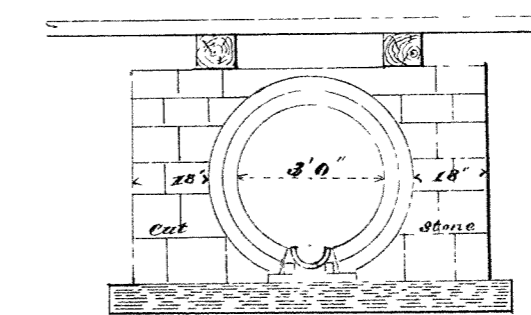

Section of 3' Sewer in cut stone masonry under rail road

Scale: { Horizontal 1 inch = 60 ft.
 Vertical 1" = 4'
 Section 1" = 2'

