


HUGHITT

AVE.

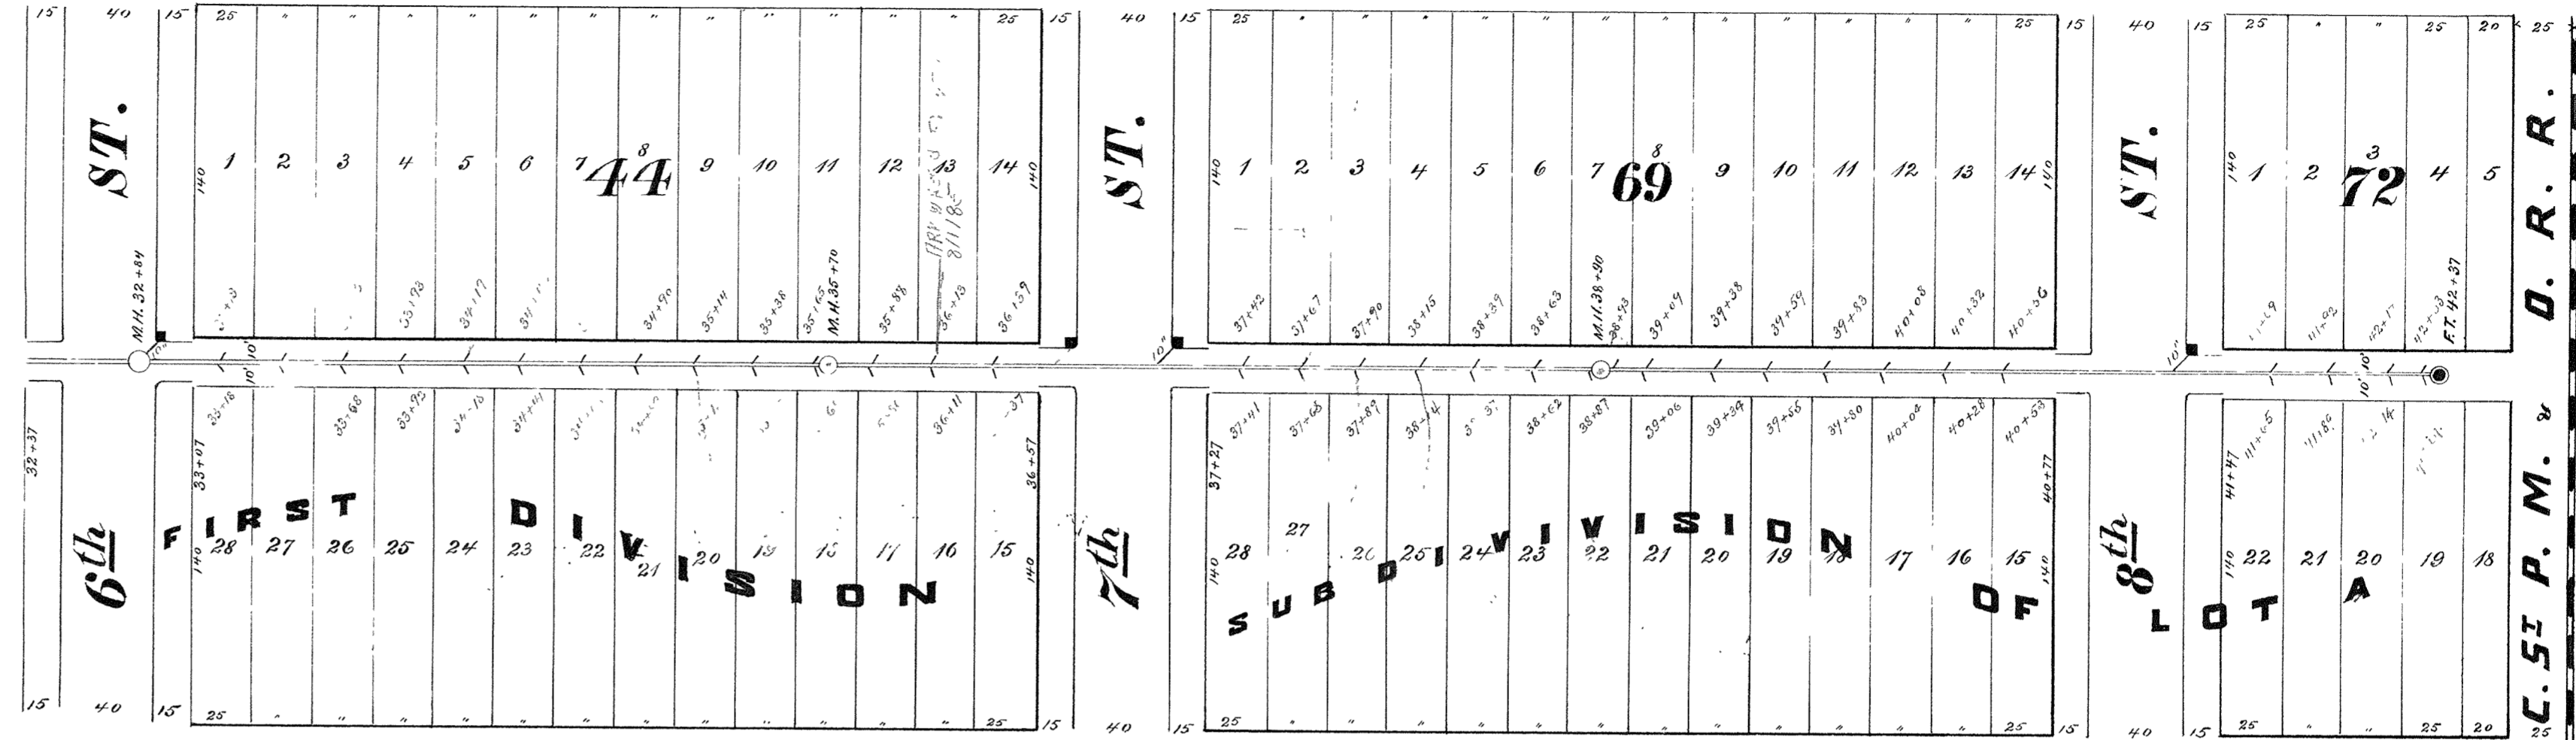


JOHN

AVE.


CITY OF SUPERIOR SEWER PLAN

Contract let April 4, 1890
 " completed April 28, 1891
 Kirkland & Starkey, Contractor
 M. Conroy, Inspector
 E. B. Banks, City Engineer


Scale: Horizontal $\frac{1\text{ inch}}{60\text{ feet}}$
 Vertical $\frac{1\text{ inch}}{4\text{ feet}}$
 Section $\frac{1\text{ inch}}{2\text{ feet}}$

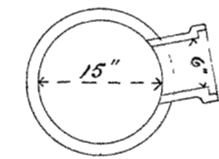


Section of 15" Pipe

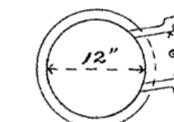

Section of 12" Pipe

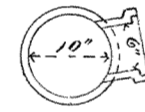

Section of 10" Pipe

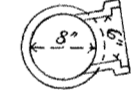

Section of 8" Pipe

