

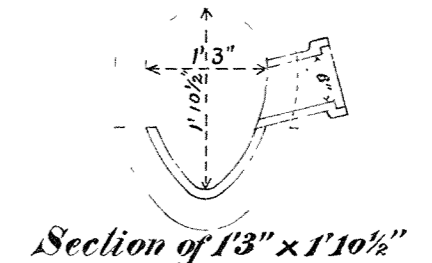
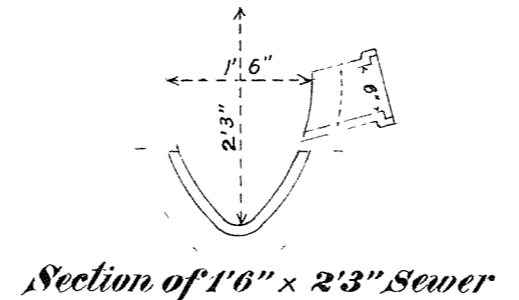
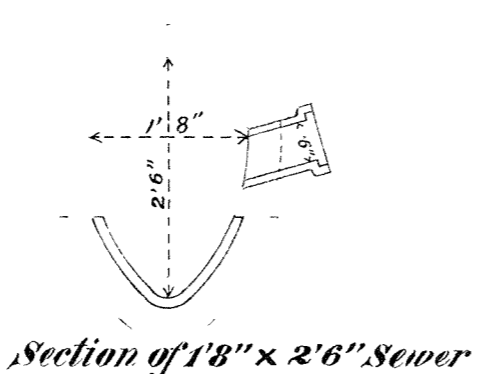
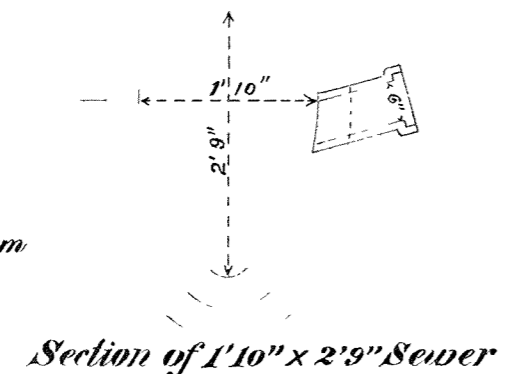
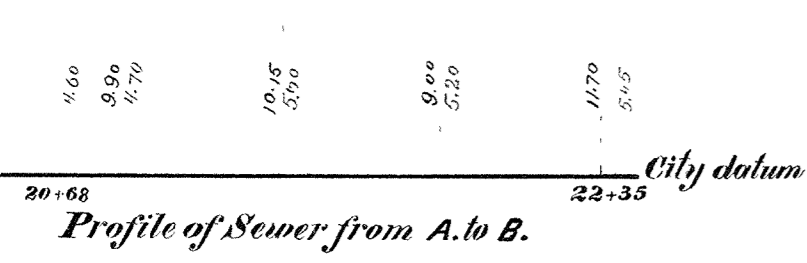


### CITY OF SUPERIOR SEWER PLAN

Contract let April 4, 1890  
 completed Apr. 28, 1891  
 Kirkland & Starke, Contractor  
 M. Conroy, Inspector  
 E. B. Banks, City Engineer

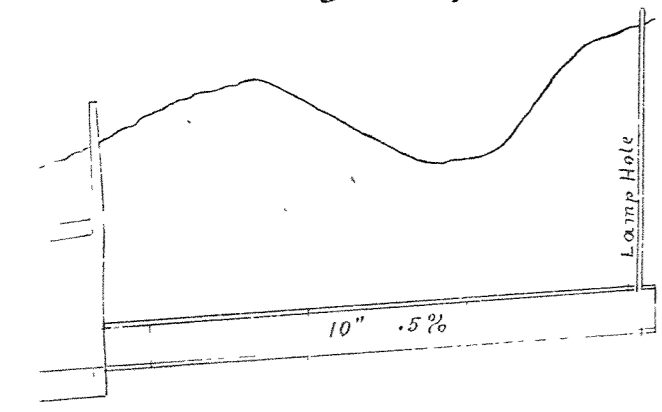

(Horizontal 1 inch to 60 feet  
 Vertical 1 " = 4 "  
 Section 1 " = 2 "

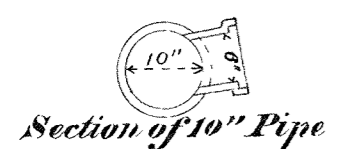