

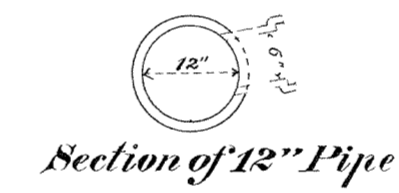
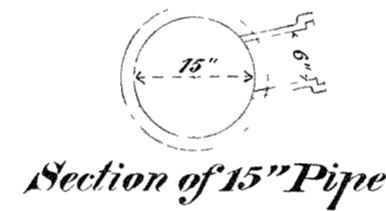


CITY OF SUPERIOR SEWER PLAN

Contract let April 4, 1890
 Completed Apr. 28, 1891
 Kirkland & Starkey, Contractor
 M. Conroy, Inspector
 E. B. Banks, City Engineer

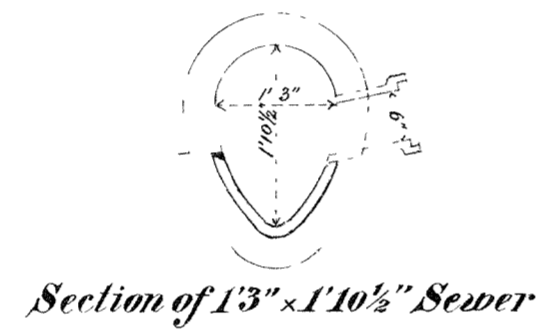

Scale: (Horizontal: 60 feet to inch
 Vertical: 4" = 1'
 Section: 2" = 1')

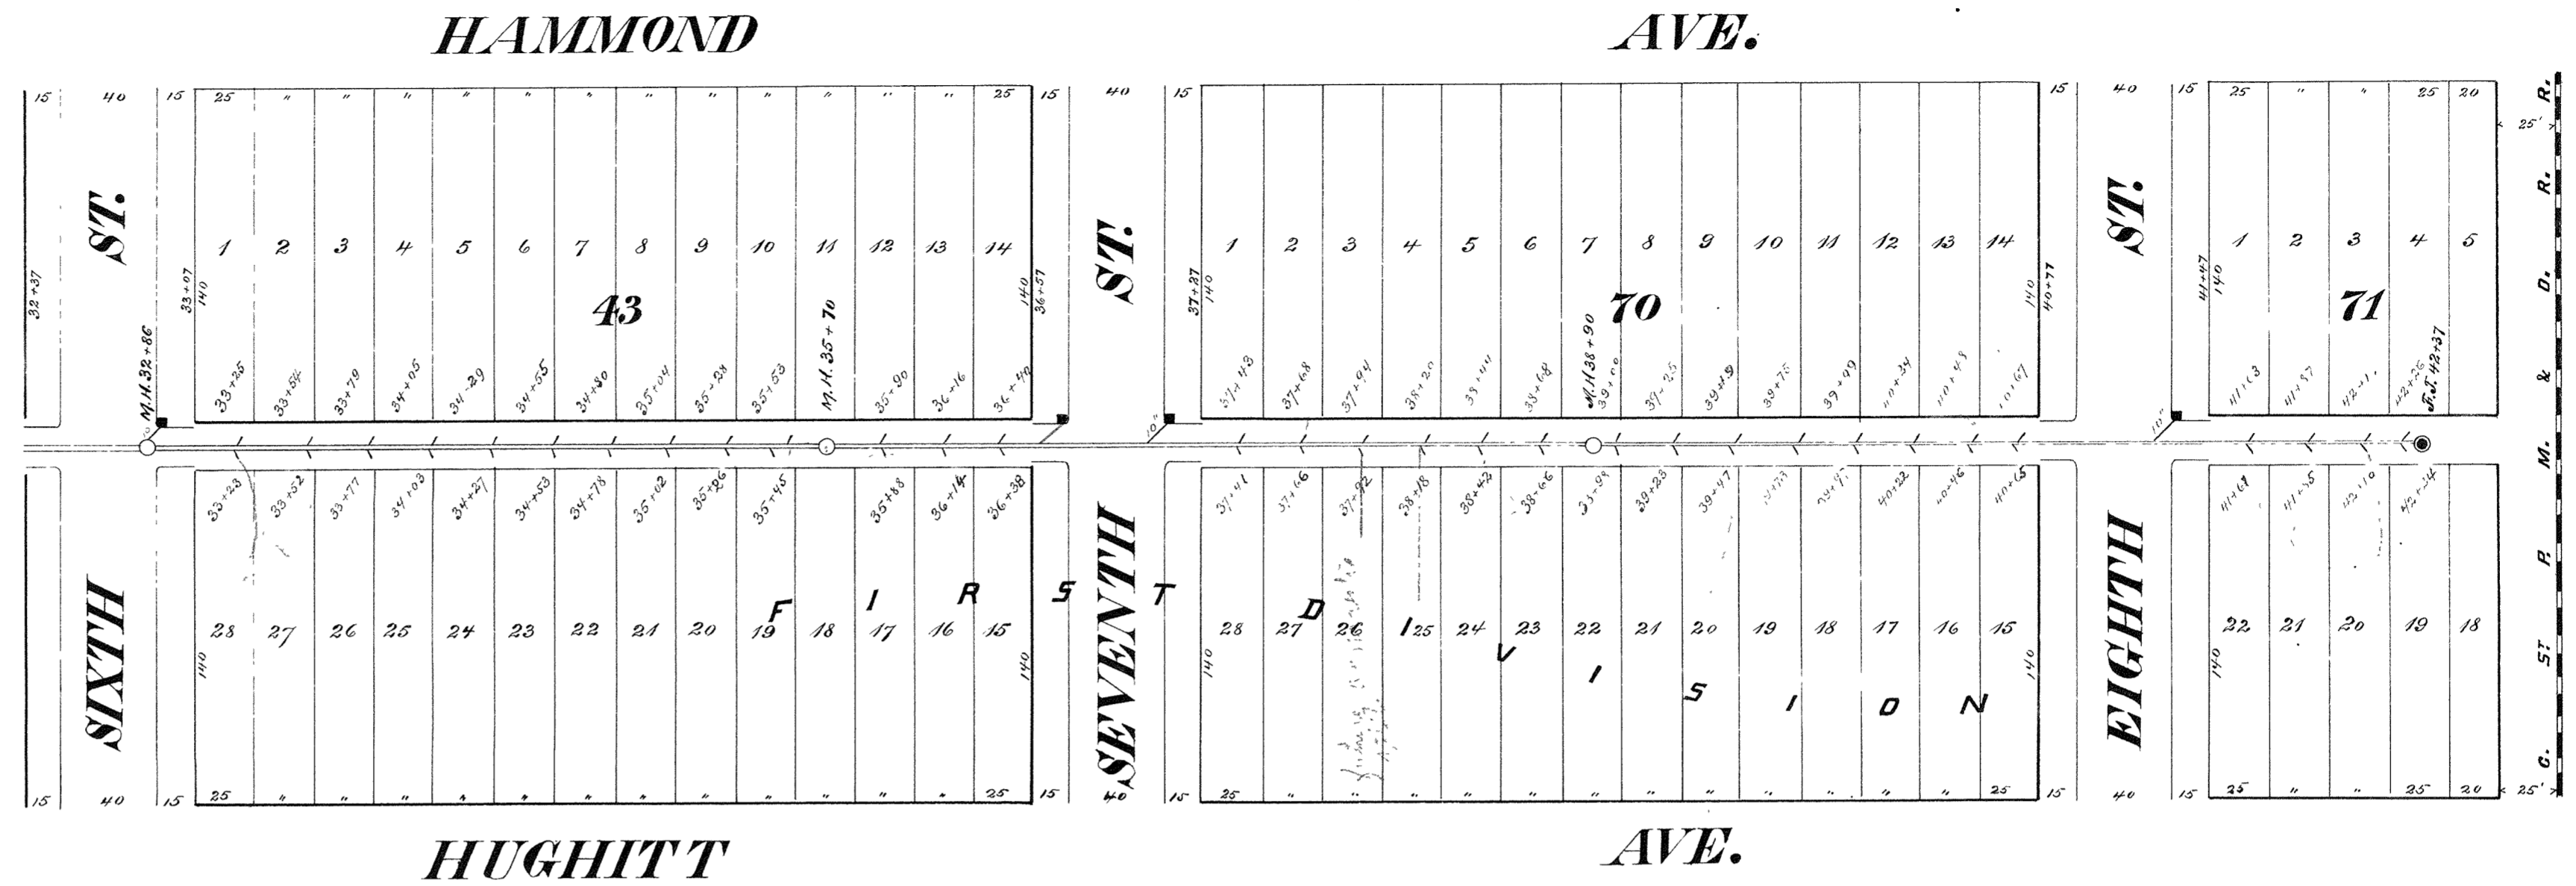