



### CITY OF SUPERIOR SEWER PLAN

Contract let April 3, 1890  
 " completed Sept. 15, 1890  
 Forrestal Bros., Contractor  
 John Daily, Inspector  
 E. Banks, City Engineer


Scale { Horizontal 1 inch = 60 ft.  
 Vertical 1 " = 4 "  
 Sectional 1 " = 2 "

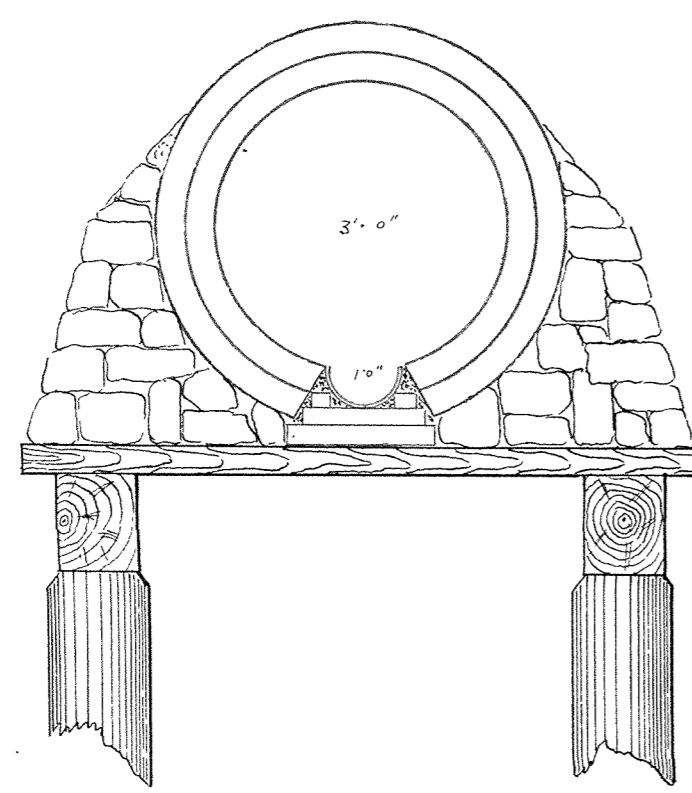


Section of 3' Sewer on Piles from 0+22 to 0+36

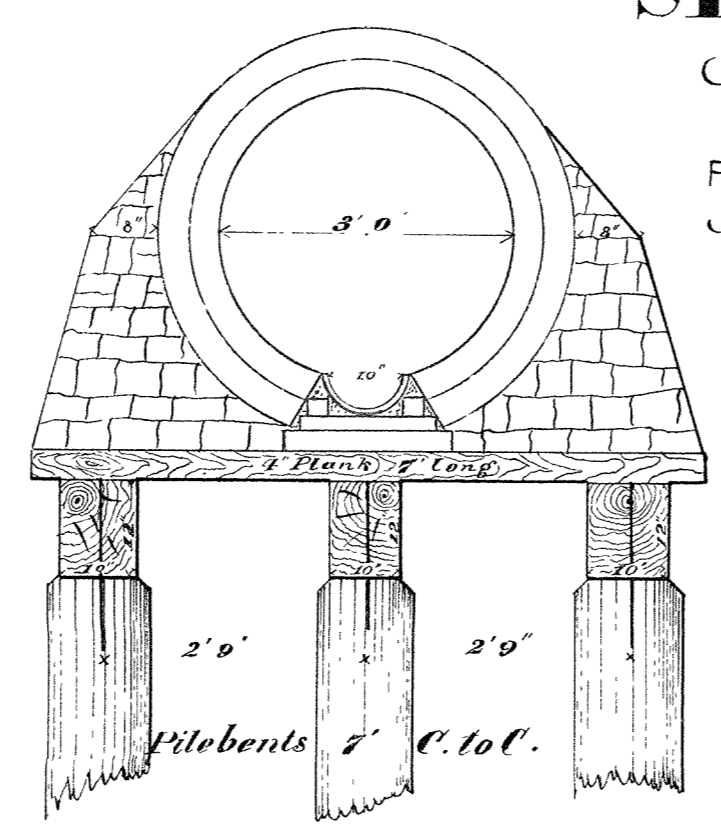

Section of 3' Sewer on Piles from 0+70 to 0+72

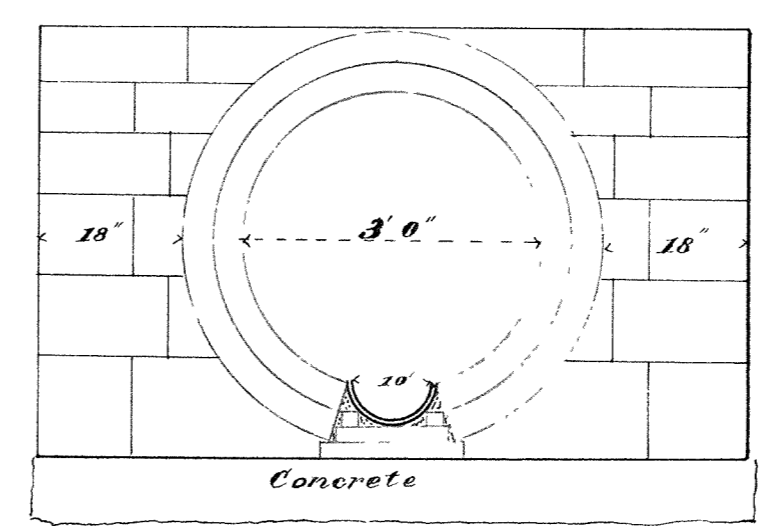

Section of 3' Sewer in cut stone masonry under railway

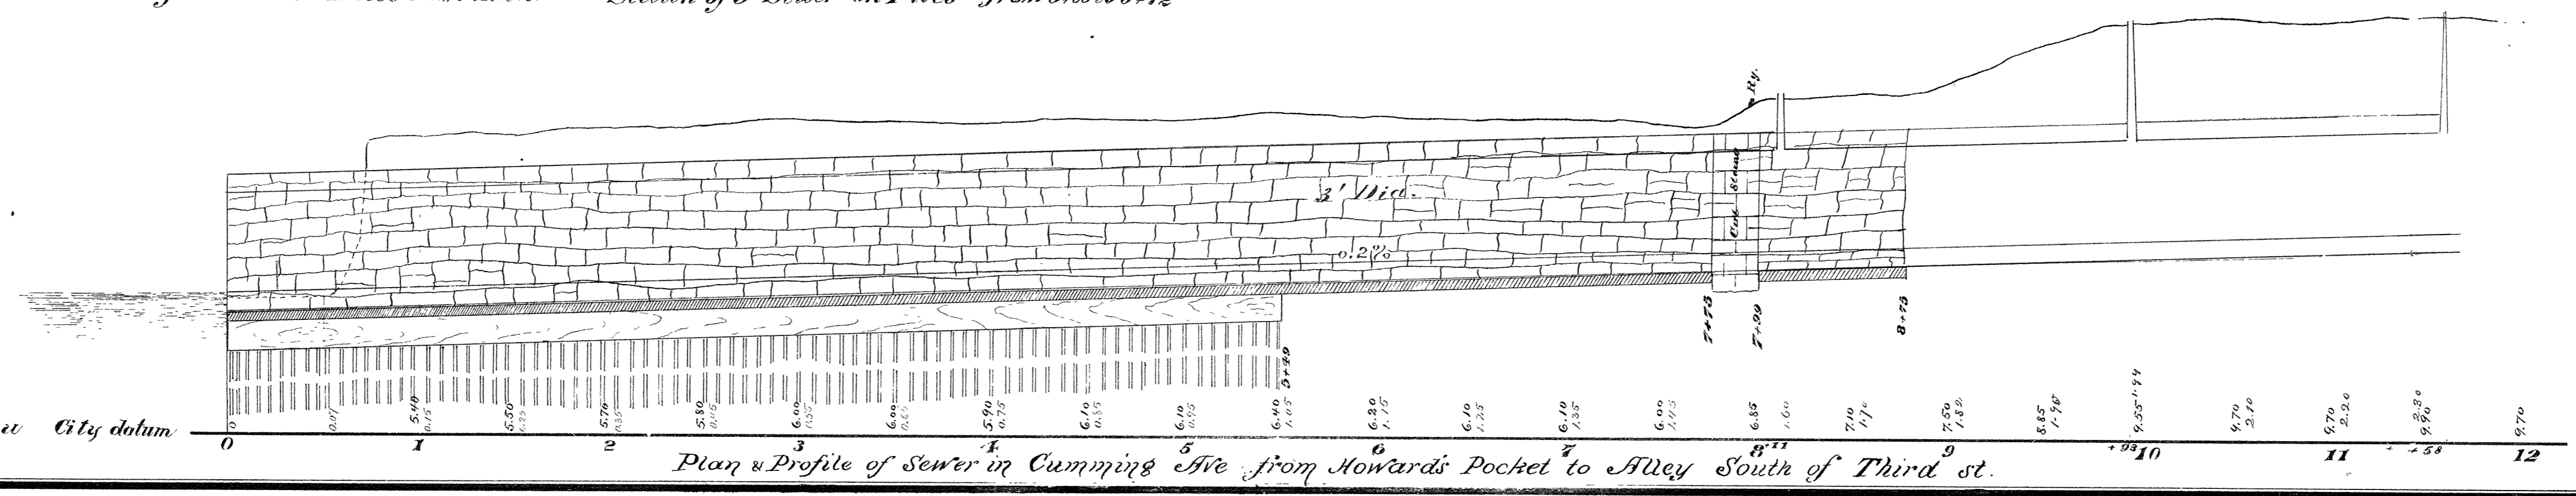

Plan & Profile of Sewer in Cumming Ave from Howard's Pocket to Alley South of Third St.