


# CITY OF SUPERIOR SEWER PLAN

Contract let April 3, 1890  
 Completed Sept. 15, 1890  
 Forrestal Bros. Contractor  
 John Daley & M. Conroy, Inspectors  
 E. B. Banks City Engineer



Scale: (Horizontal 1 inch to 60 feet.  
 Vertical 1 " " 4 "  
 Section 1 " " 2 "

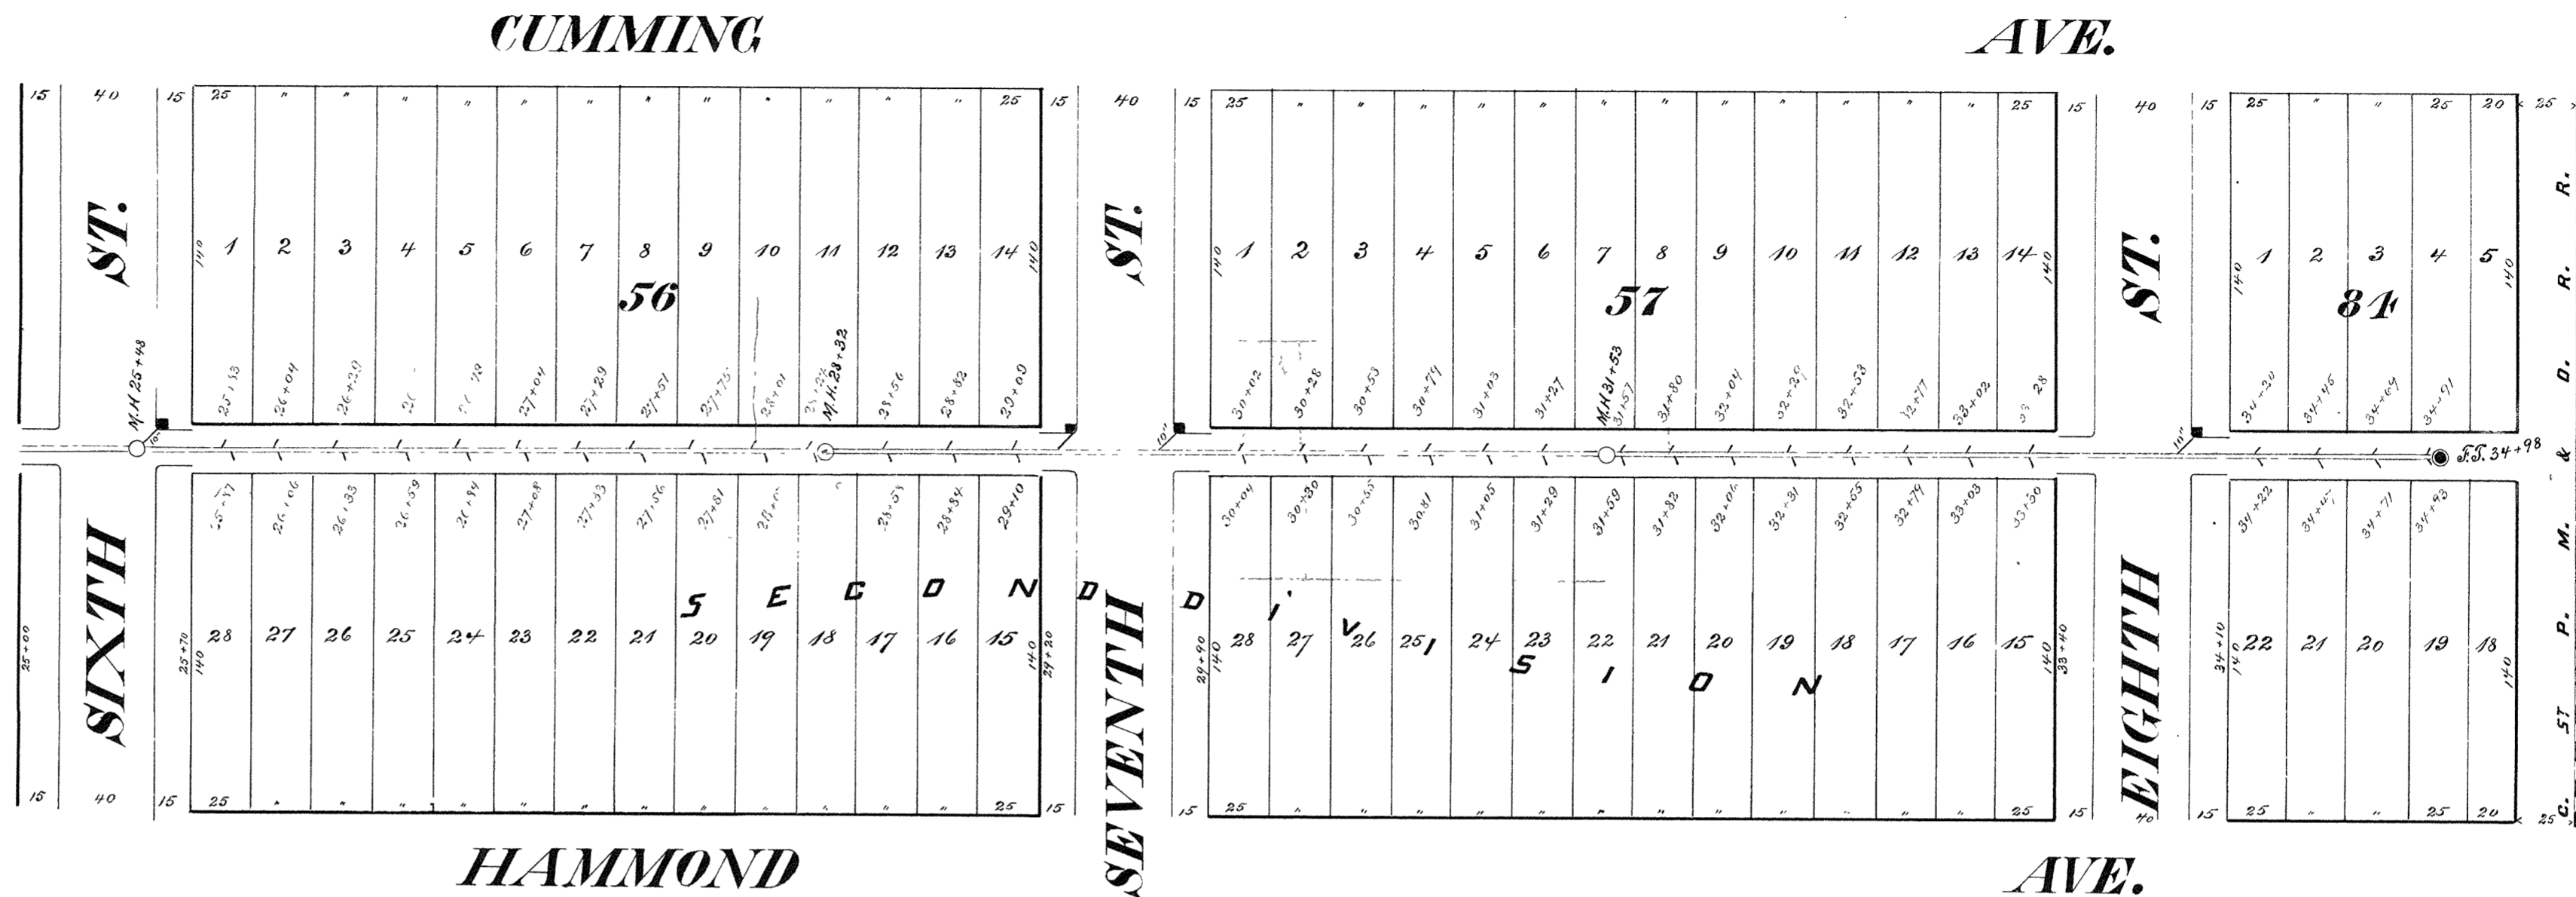