


CITY OF SUPERIOR SEWER PLAN

Contract let April 3, 1890
 Completed Sept. 15, 1890
 Forrestal Bros. Contractor
 John Bailey & Sturgeon, Inspectors
 E. B. Banks, City Engineer

Scale: (Horizontal: Inch to 60 feet
 Vertical: 1 " = 4 "
 Section 1 " = 2 "

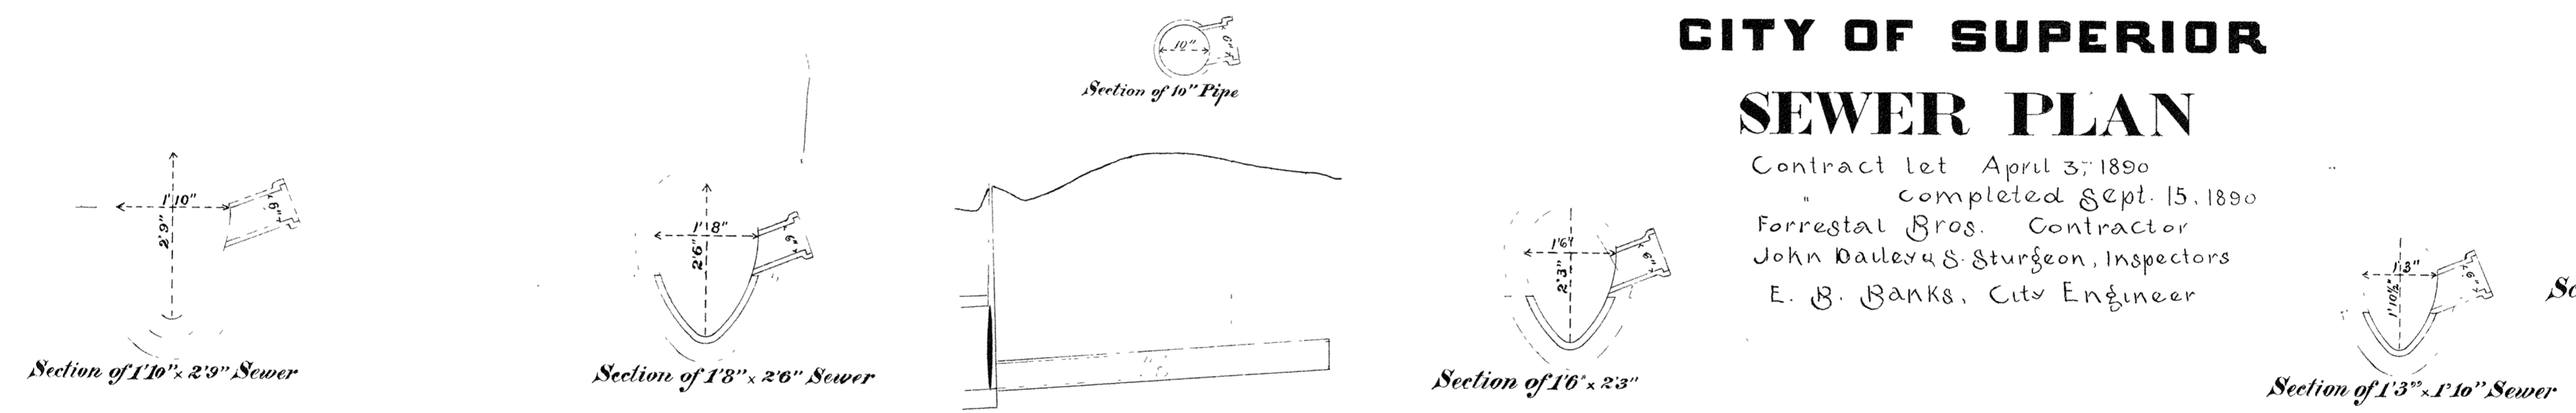

City datum 13-31
 Profile of Sewer from A to B.

