



Horizontal Scale: 1 in. = 60 ft.  
 Vertical Scale: 1 in. = 4 ft.  
**CONTRACT NO. 1493.**  
 Contract let Aug 4. 15.  
 Contract completed Oct. 1. 15.  
 Andrew Johnson Contractor.  
 Graham Inspector.  
 E.B. Banks City Engineer.

THIS SEWER EXTENDED TO STA. 9+85 IN 1923 WITH WYS. ON W. SIDE AT STA. 8+03-8+33-8+55, 8+81-9+07-9+32-9+69 AND 9+81. 10" PIPE G.D. 0.50. SEWER ENDS 7 FT SOUTH OF LINE BET. LOTS 7 & 8 BLK. 166 EL. 7.30 @ S. END

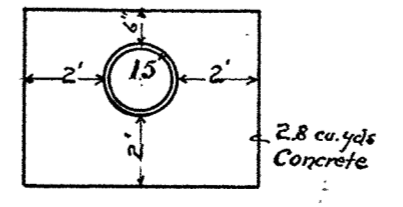

Plan showing proposed Catch Basins  
 Scale 1 inch = 50 ft. May 1893  
 Q. L. Brown  
 City Engineer.

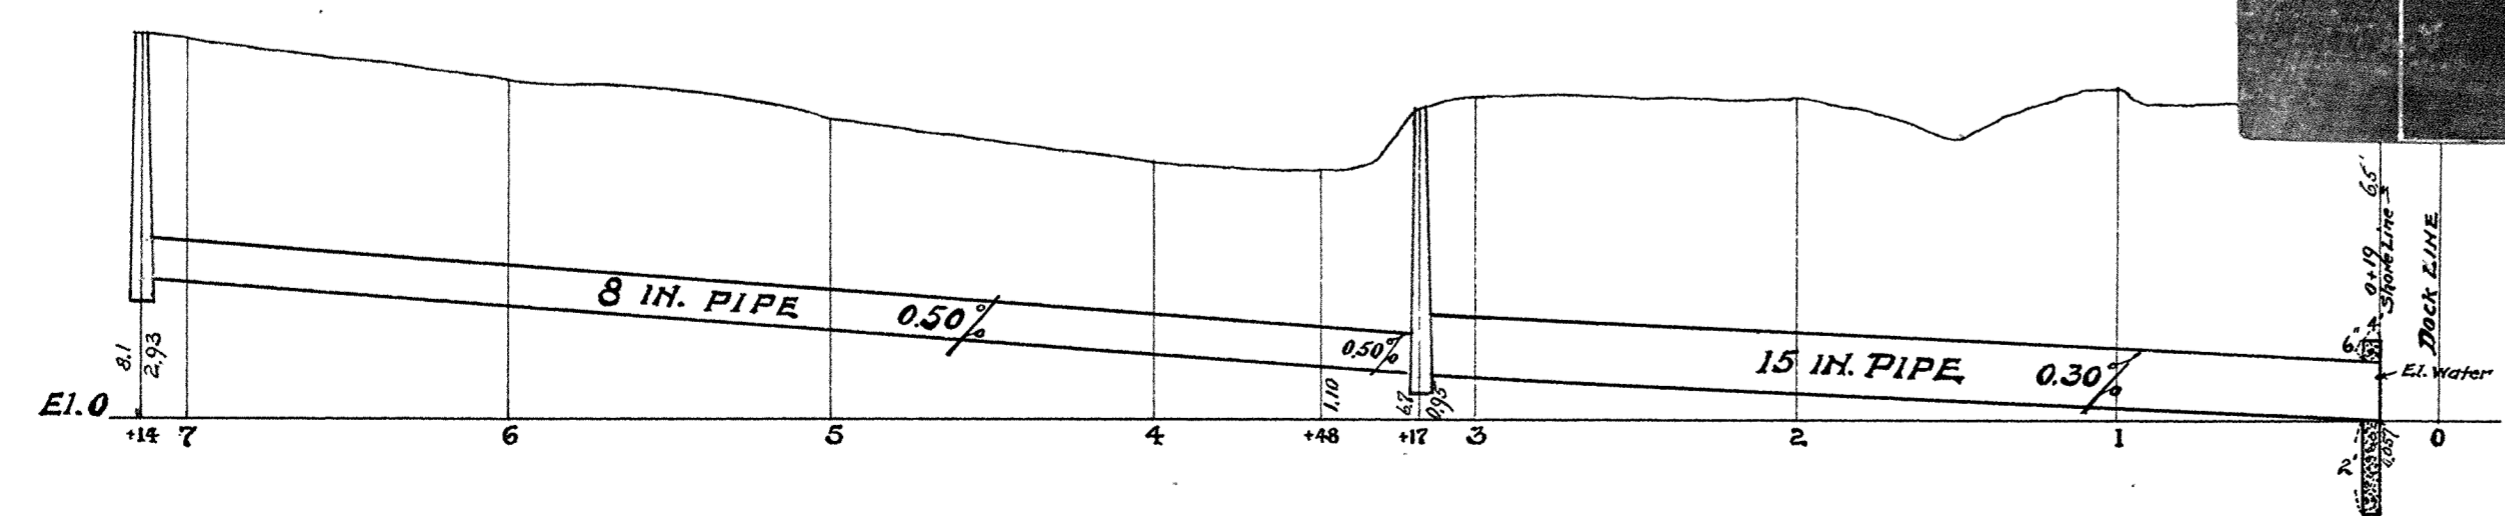