


CITY OF SUPERIOR SEWER PLAN

Contract let April 3, 1890
 " completed Sept. 15, 1890
 Forrestal Bros., Contractor
 John Dailey & S. Sturgeon, Inspector
 E. B. Banks, City Engineer



Scale: { Horizontal: 1 inch to 60 feet.
 Vertical: 1 " " " "
 Section: 1 " " " "

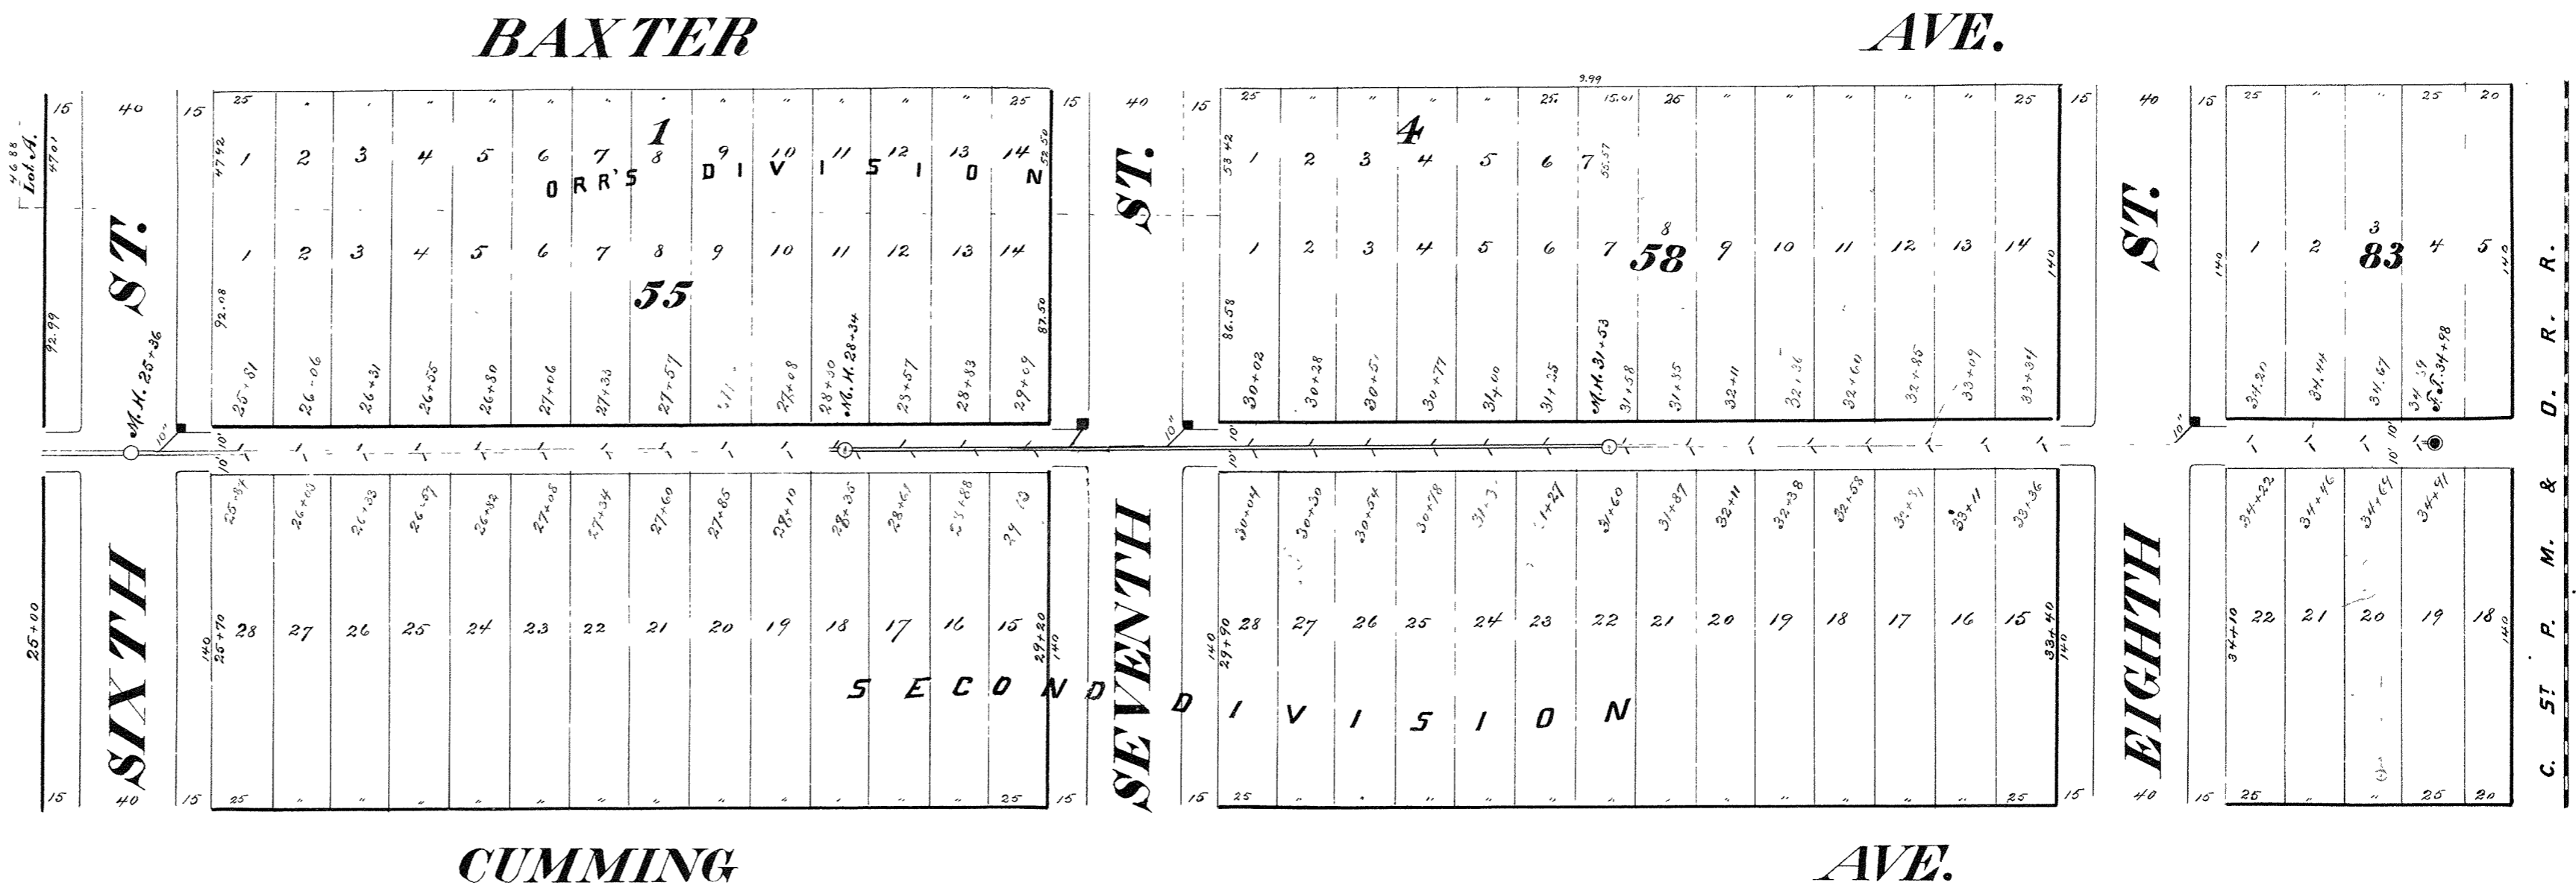