


**CITY OF SUPERIOR
SEWER PLAN**

Contract let Sept. 1, 1890
 completed Dec. 1, 1890
 Joseph Wolf, Contractor
 I. C. Grant & J. H. Little, Inspectors
 E. B. Banks, City Engineer

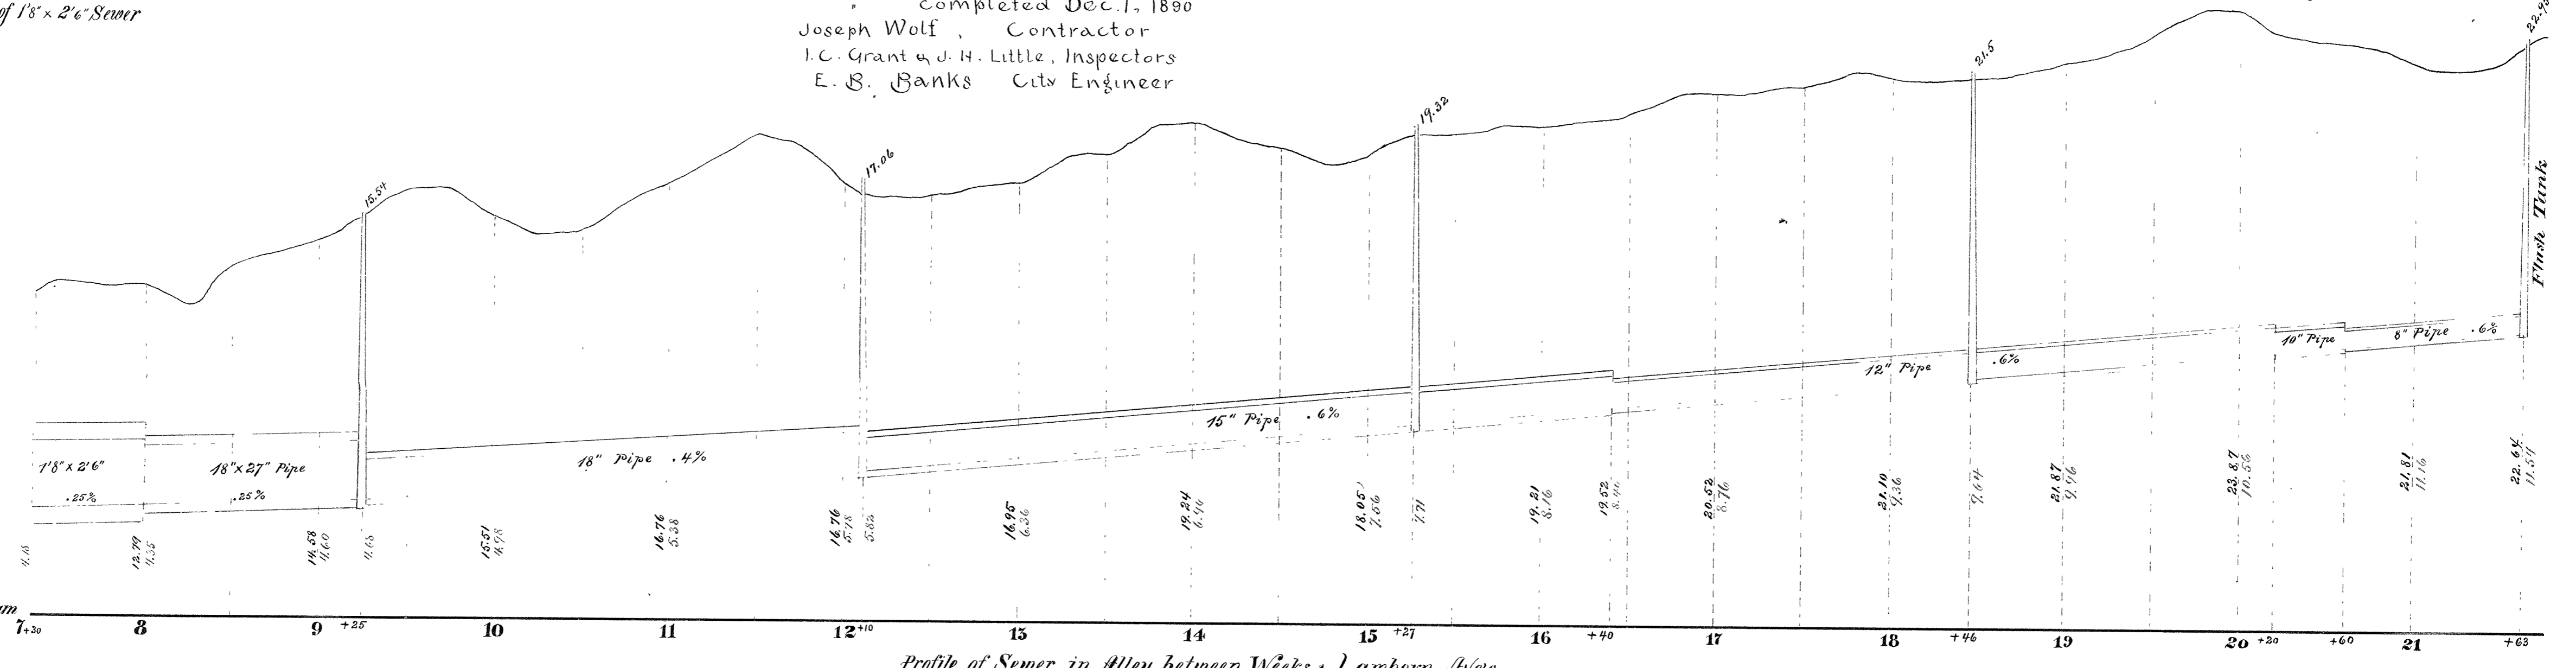

Profile of Sewer in Alley between Weeks & Lamborn Aves