
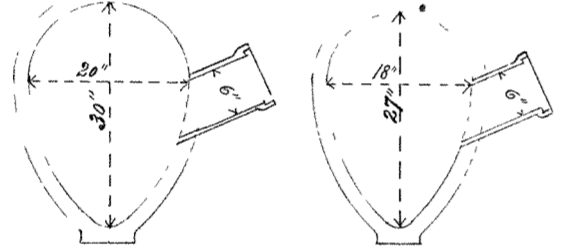



CITY OF SUPERIOR
SEWER PLAN

Contract let Sept. 1, 1890
 completed Dec. 1, 1890
 Joseph Wolf, Contractor
 I. C. Grant & J. H. Little, Inspectors
 E. B. Banks, City Engineer


Scale: Horizontal 1 inch to 60 feet
 Vertical 1 " 4 "
 Section 1 " 2 "

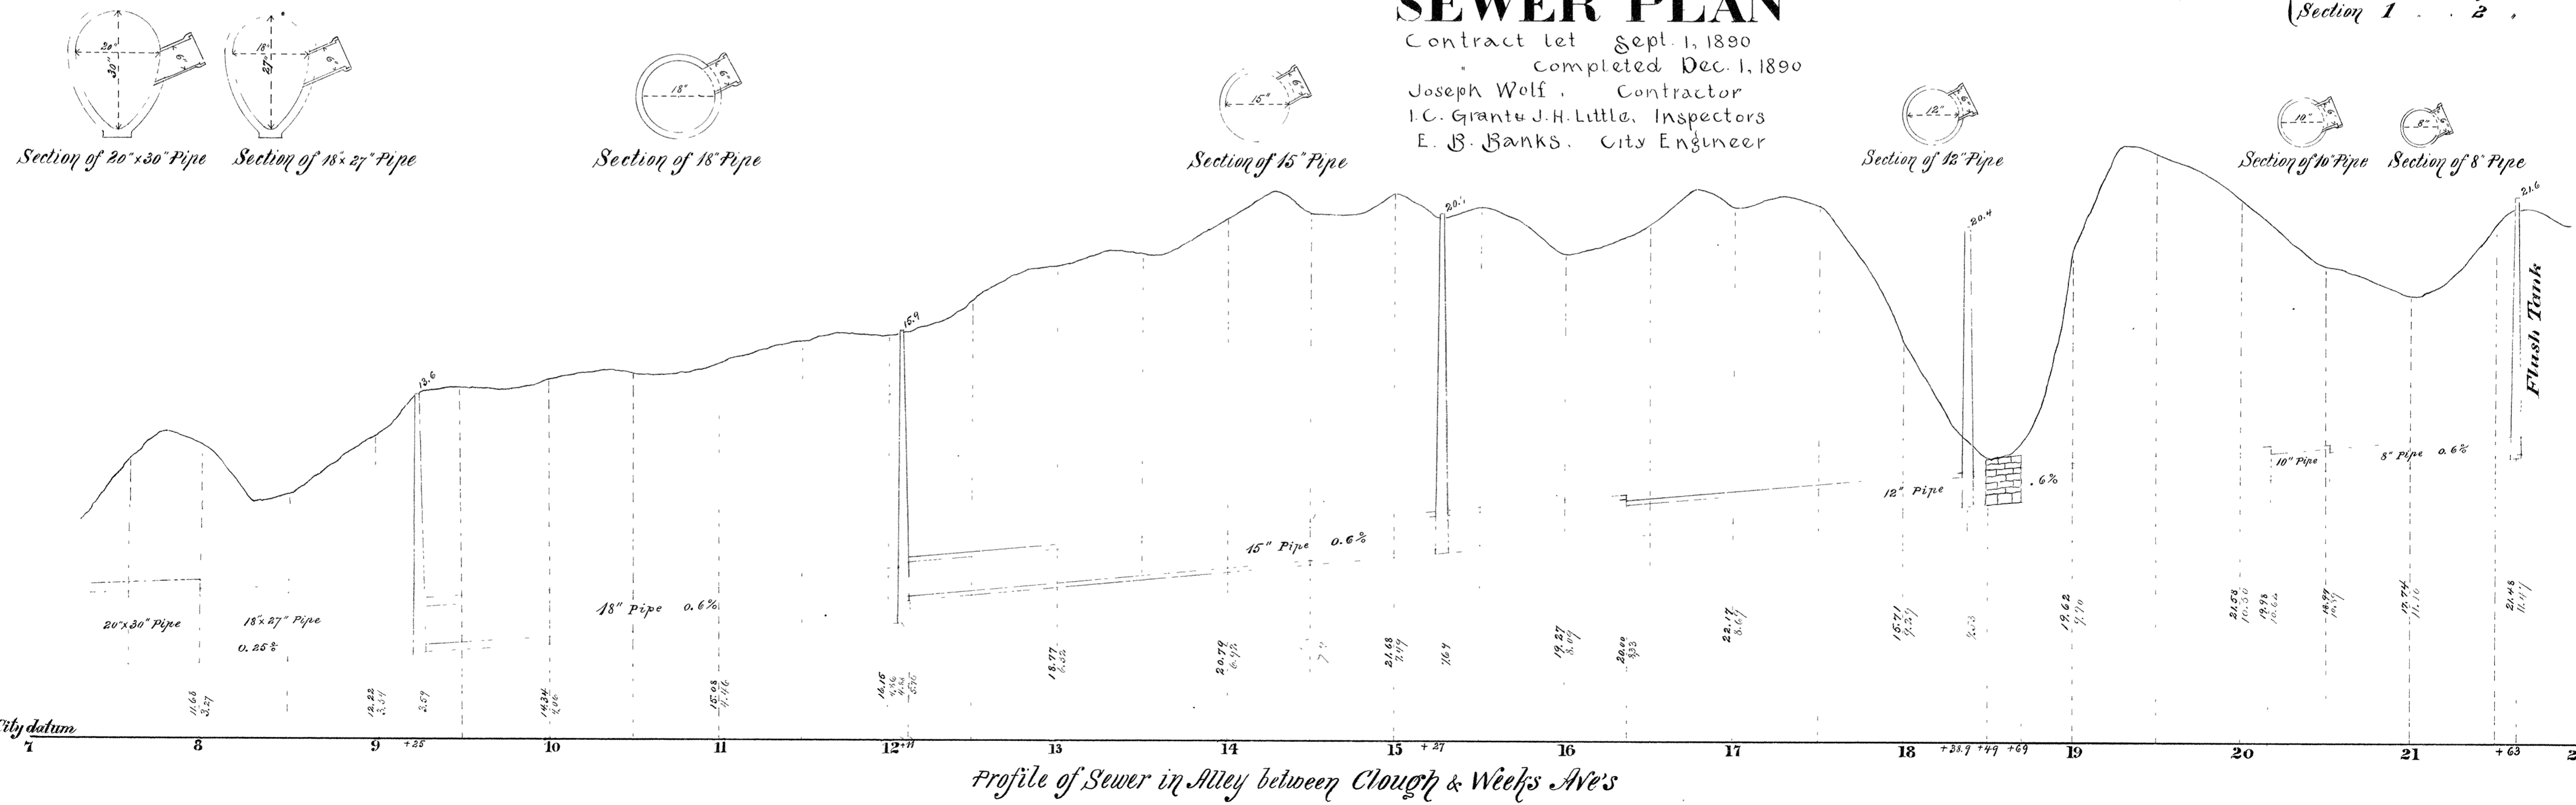


Section of 20x30" Pipe

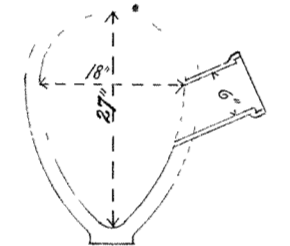


Section of 18x27" Pipe

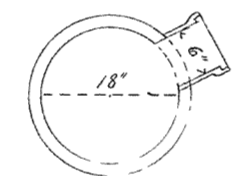

Section of 18" Pipe

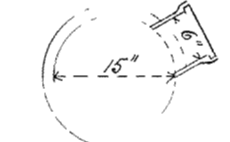

Section of 15" Pipe

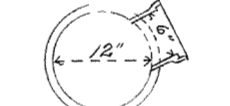

Section of 12" Pipe



Section of 10" Pipe



Section of 8" Pipe

Profile of Sewer in Alley between Clough & Weeks Aves

1-26