
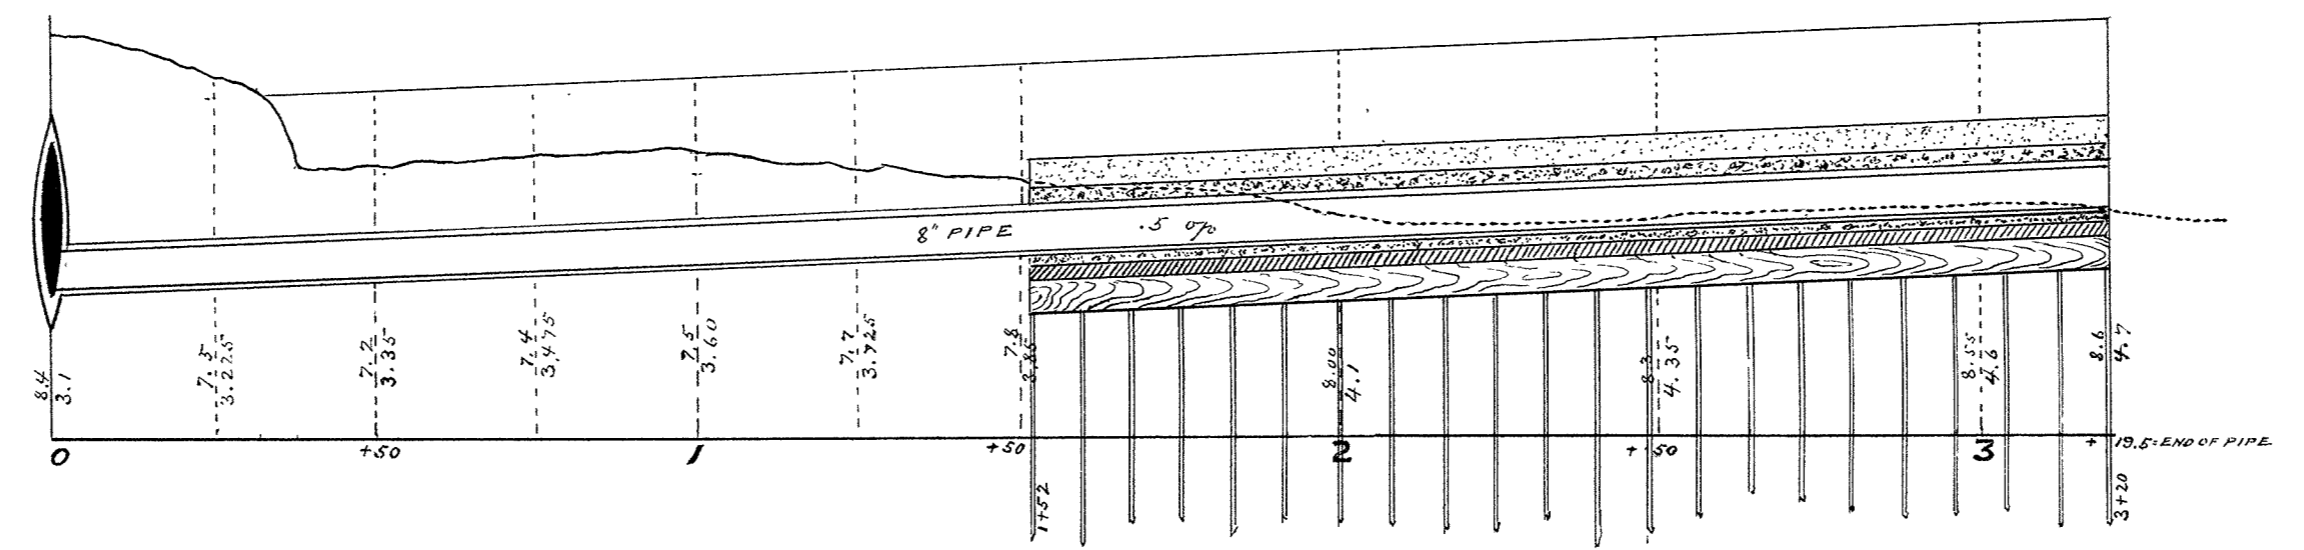
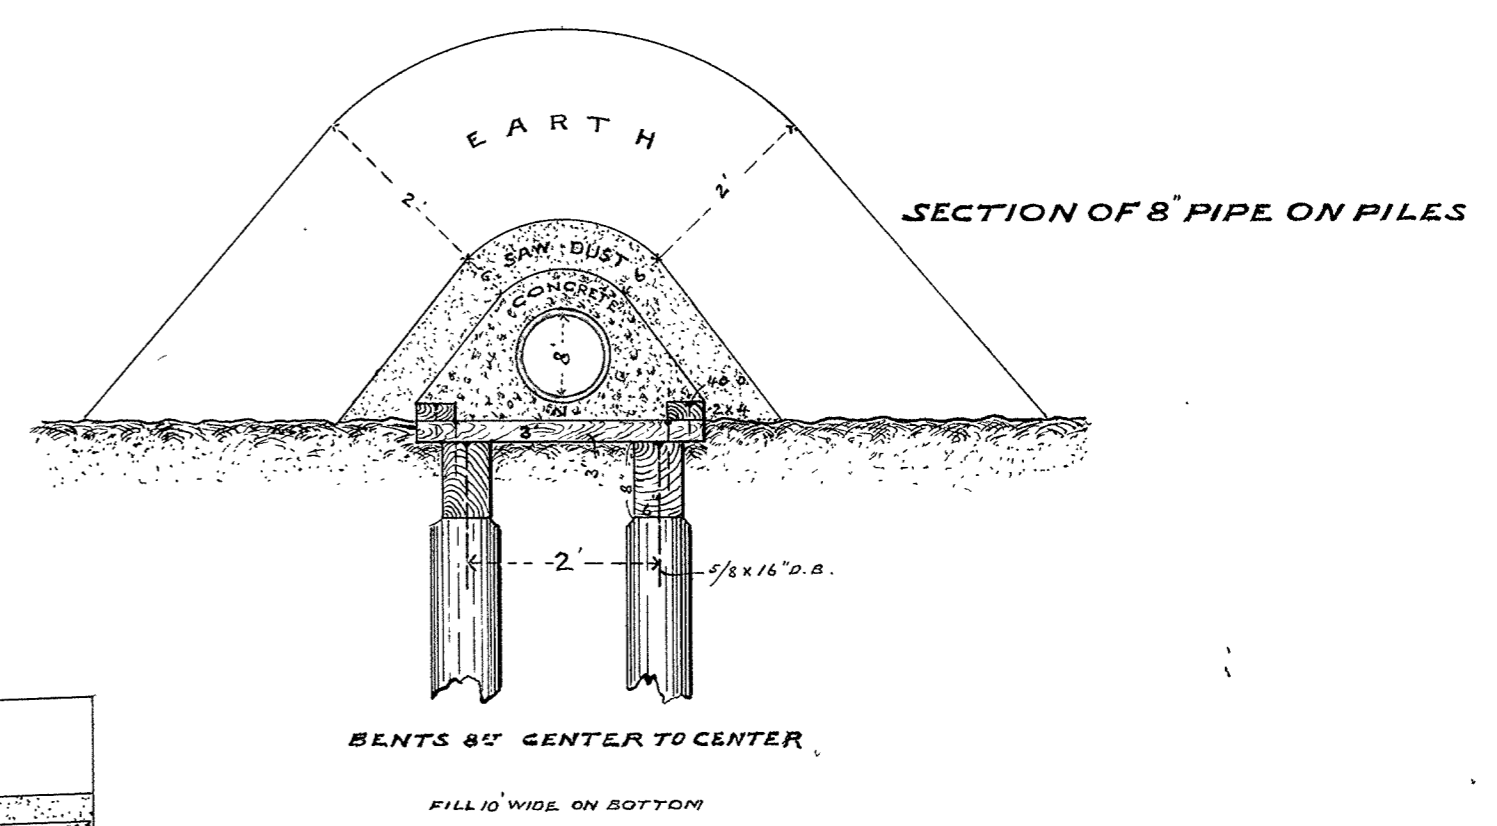


1902  
CITY OF SUPERIOR  
**SEWER PLAN**  
CONTRACT LET APRIL 25<sup>TH</sup> 1902  
COMPLETED JUN. 2<sup>ND</sup> 1902  
CONTR. BY PETERSON, HOLM  
CONTR. BY FRANK RICHARDSON  
INSPECTOR  
HOWARD THOMAS  
CITY ENGR

SCALE: HORIZONTAL 1" = 30 FT.  
VERTICAL 1" = 4 "  
SECTION 1" = 2 "

SECTION OF 8" PIPE

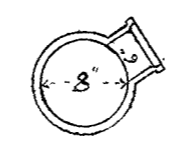

1-31