



Scale: { Horizontal : 1" = 80'  
 Vertical : 1" = 4'  
 Section : 3/4" = 1'.

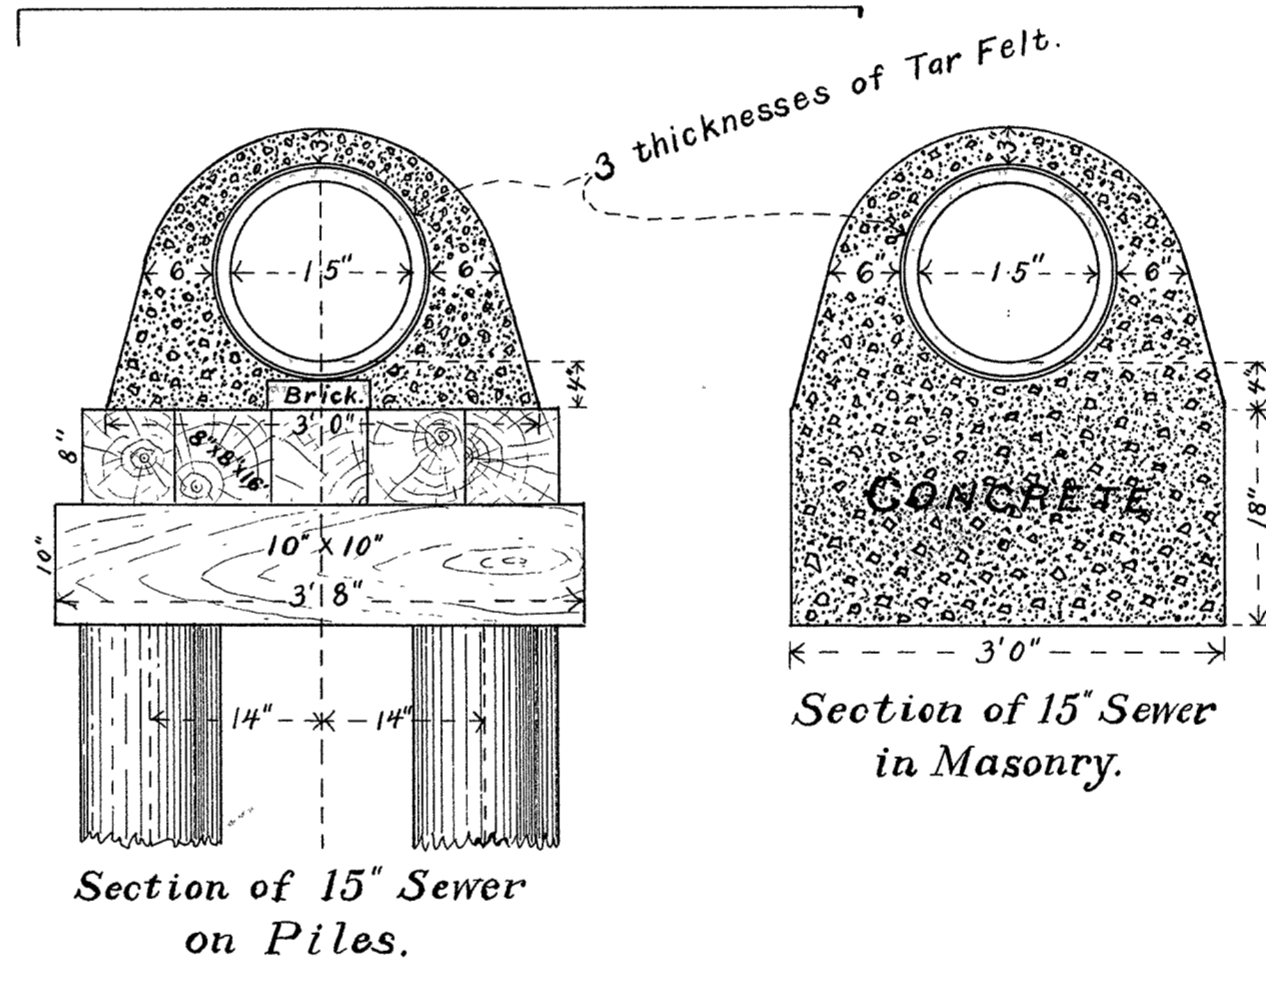

**CITY OF SUPERIOR  
 SEWER PLAN**  
 Contract let Aug. 13, 1904.  
 " completed Nov. 5, "  
 Stack Bros., Contractors.  
 V. Cournoyer, Inspector.  
 Howard Thomas, City Engineer.

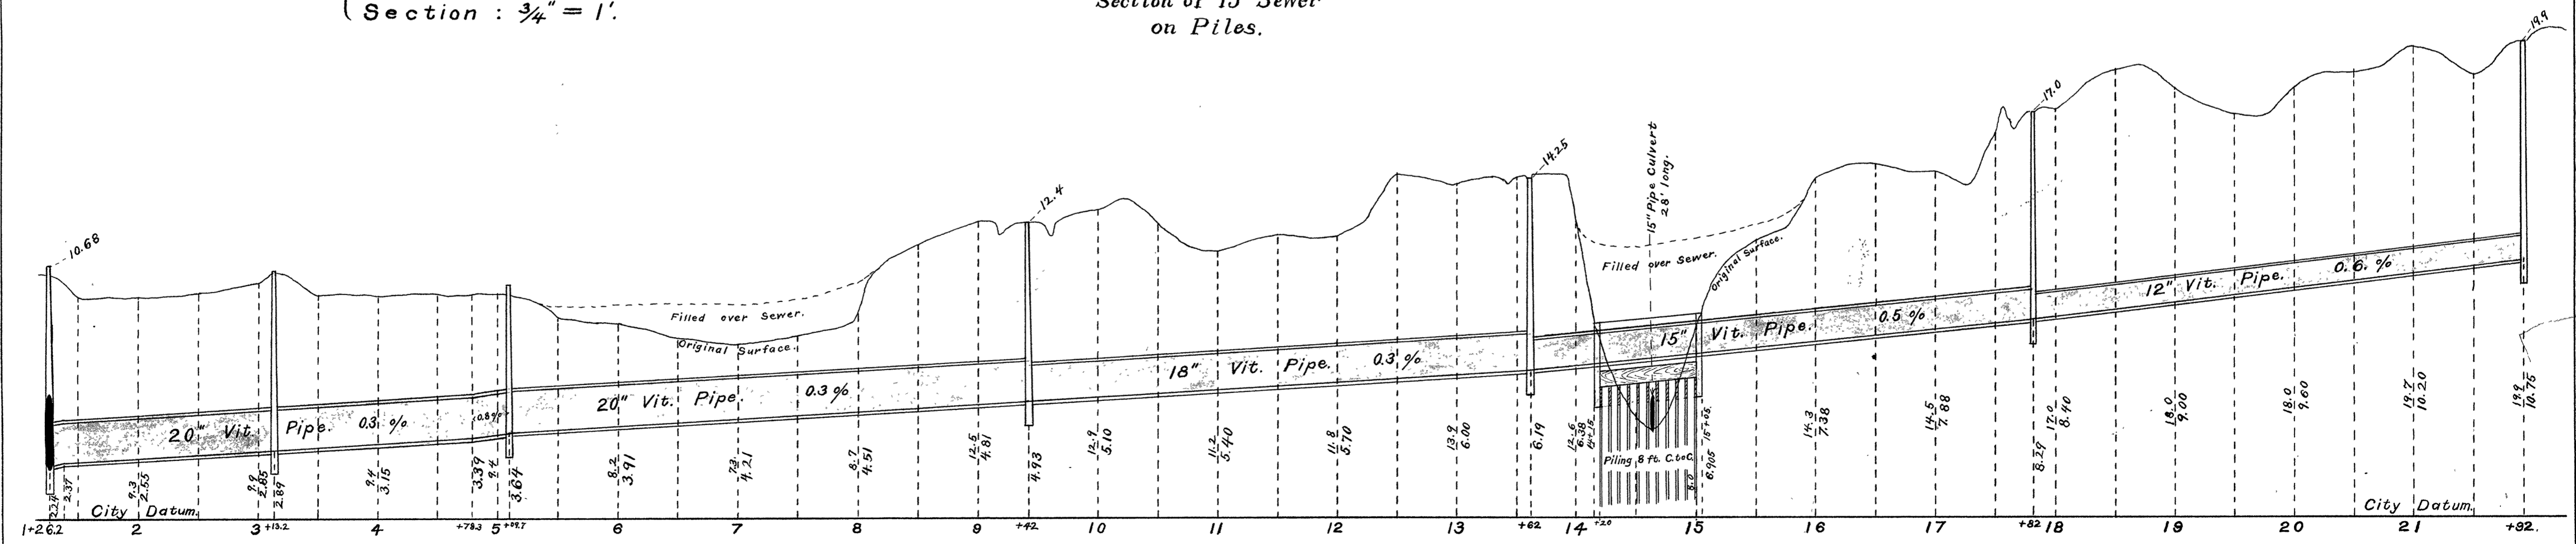

PROFILE OF SEWER IN N. FOURTH ST. AND ALLEY BETWEEN CATLIN AND FISHER AVES. TO N. EIGHTH ST.