


Note: Figures in blue, placed opposite the breeches, show the elevation of same above datum

VILLAGE OF SUPERIOR SEWER PLAN


Contract let Feb. 3, 1888
completed

Youngren & Gleason, Contractor
Frank Grace, Inspector
E. B. Banks, Village Engineer

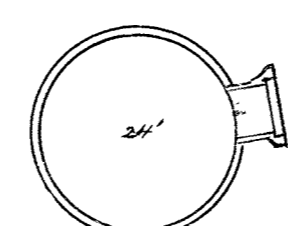

Section of 24" Pipe

Scale: { Horizontal 1" = 60'
Vertical 1" = 40'
Section 1" = 2'

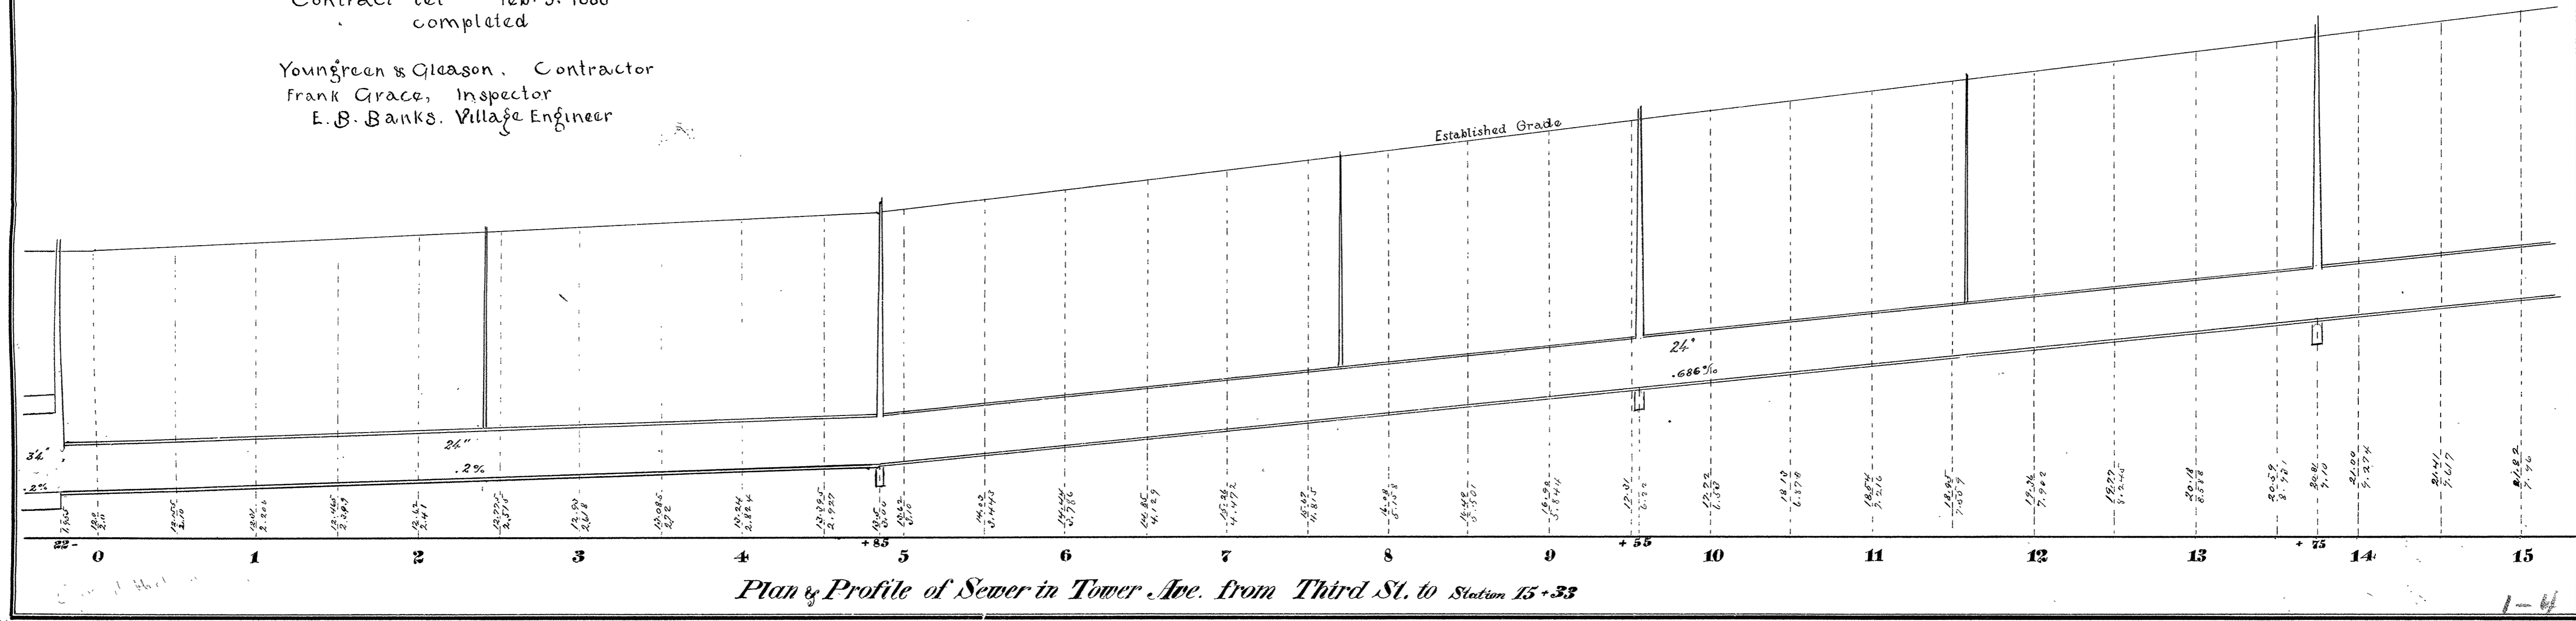

Plan & Profile of Sewer in Tower Ave. from Third St. to Station 15+33