
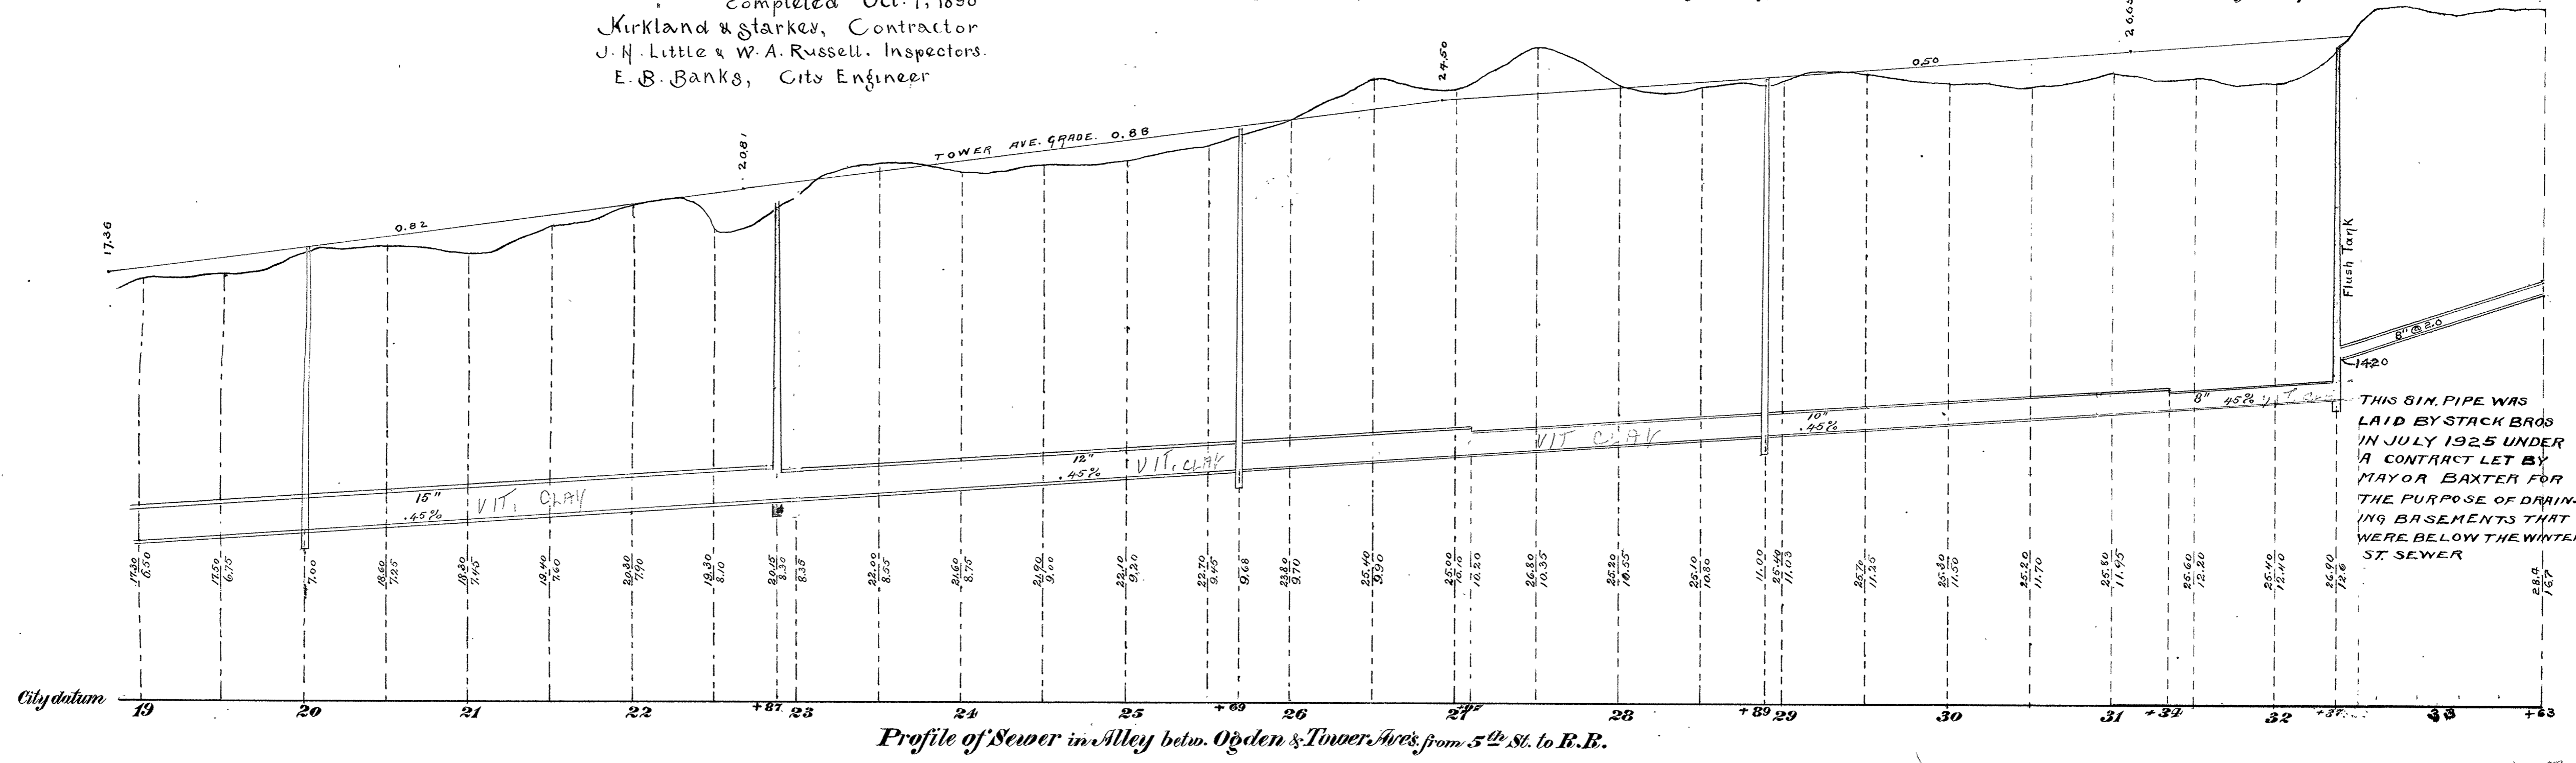
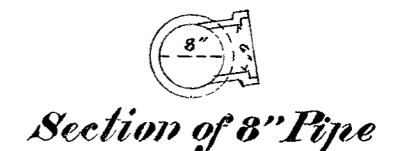
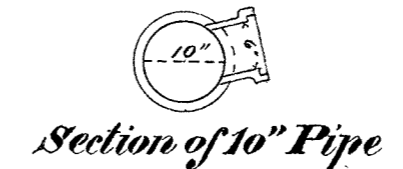
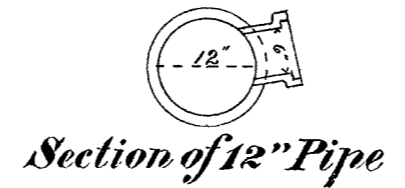


CITY OF SUPERIOR

SEWER PLAN

Contract let April 4, 1890
 completed Oct. 1, 1890
 Kirkland & Starkey, Contractor
 J. N. Little & W. A. Russell, Inspectors
 E. B. Banks, City Engineer

Scale: { Horizontal: 1 inch to 60 feet
 Vertical: 1" = 4'
 Section: 1" = 2'

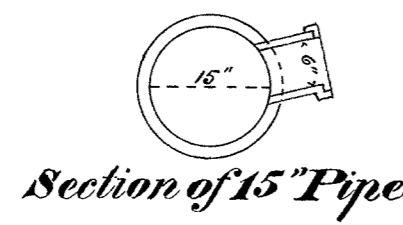

THIS 8 IN. PIPE WAS LAID BY STACK BROS IN JULY 1925 UNDER A CONTRACT LET BY MAYOR BAXTER FOR THE PURPOSE OF DRAINING BASEMENTS THAT WERE BELOW THE WINTER ST. SEWER