

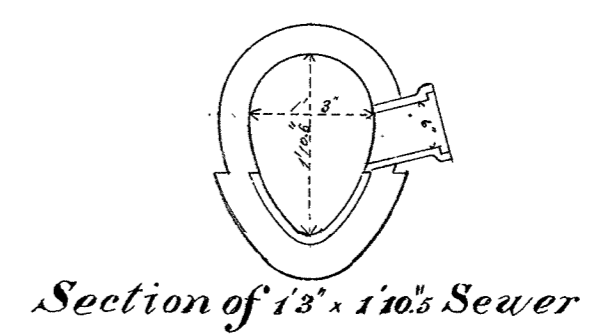
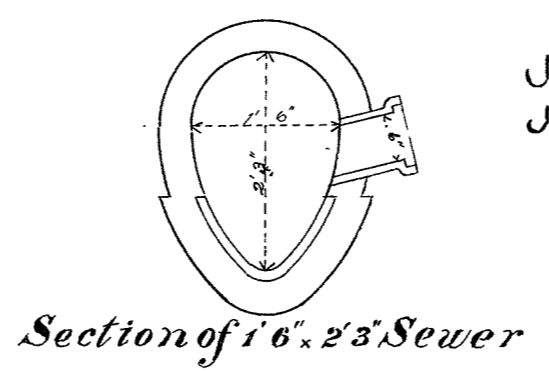
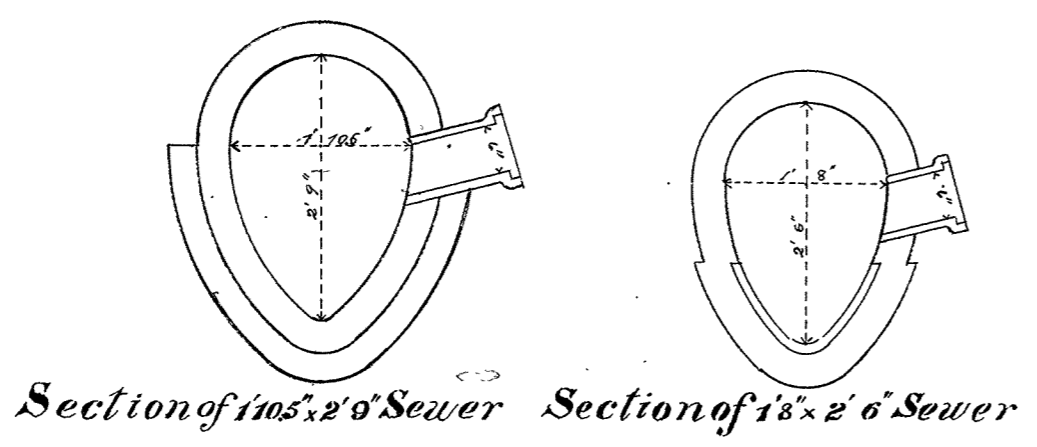


Note: No connections reported from A to B. and for lots 13 & 20

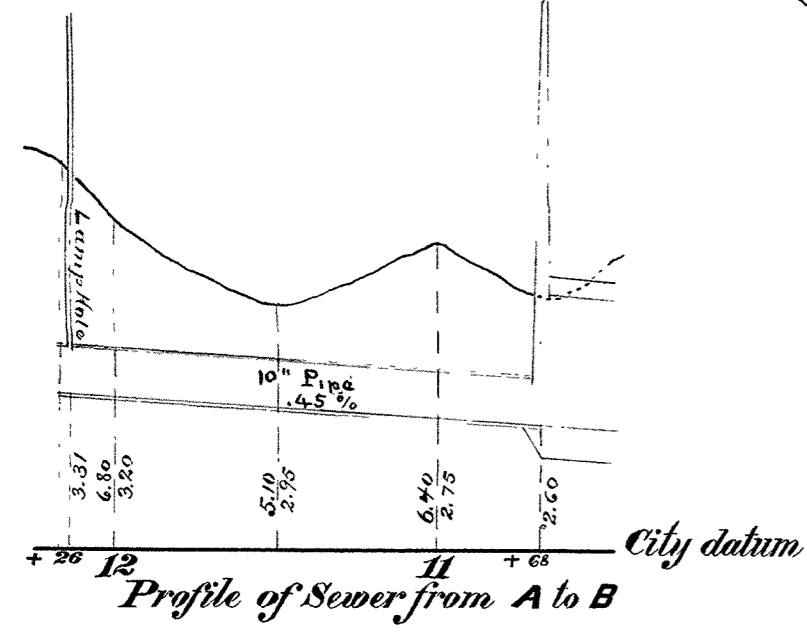

CITY OF SUPERIOR
SEWER PLAN
 Contract let April 4, 1890
 completed Oct. 1, 1890
 Kirkland & Starkey, Contractor.
 J. H. Little & M. Conroy, Inspectors.
 E. B. Banks, City Engineer

Scale { Horizontal 60ft. = 1 inch
 Vertical 4" = 1"
 Sectional 2" = 1"

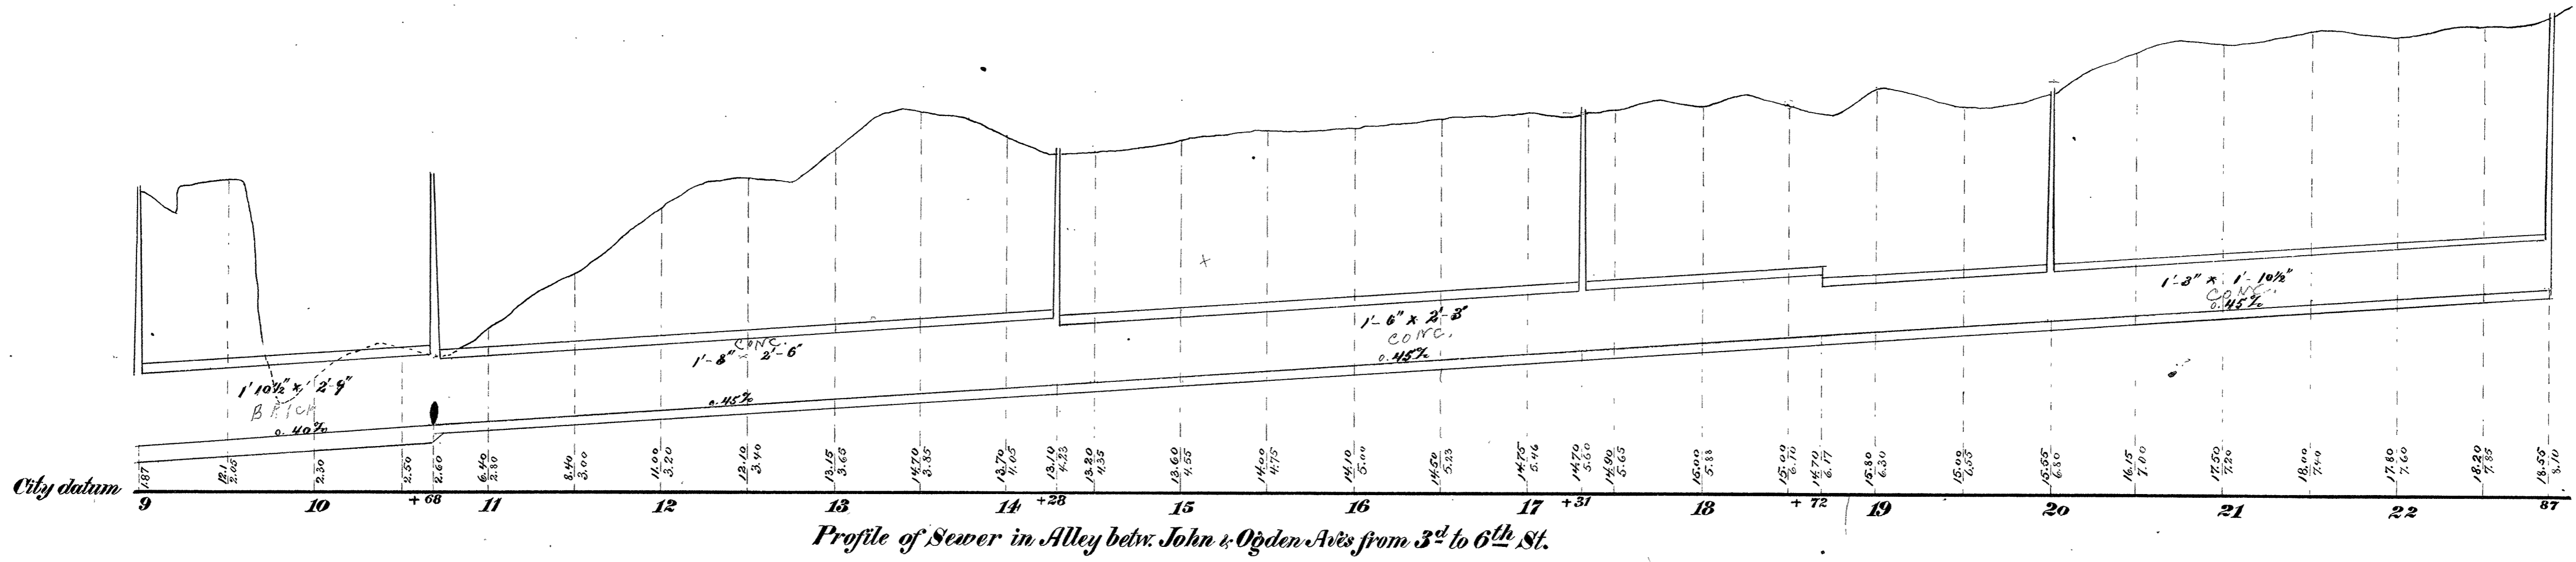

1-8