


1894

CITY OF SUPERIOR

SEWER PLAN

Contract let June 13, 1890
 Completed June 1, 1891
 Kirkland & Starkey, Contractor
 James Nelson & John Dailey, Inspectors
 E. B. Banks, City Engineer

Scale: { Horizontal 60 ft. = 1 inch
 Vertical 4" = 1"
 Section 4" = 1"

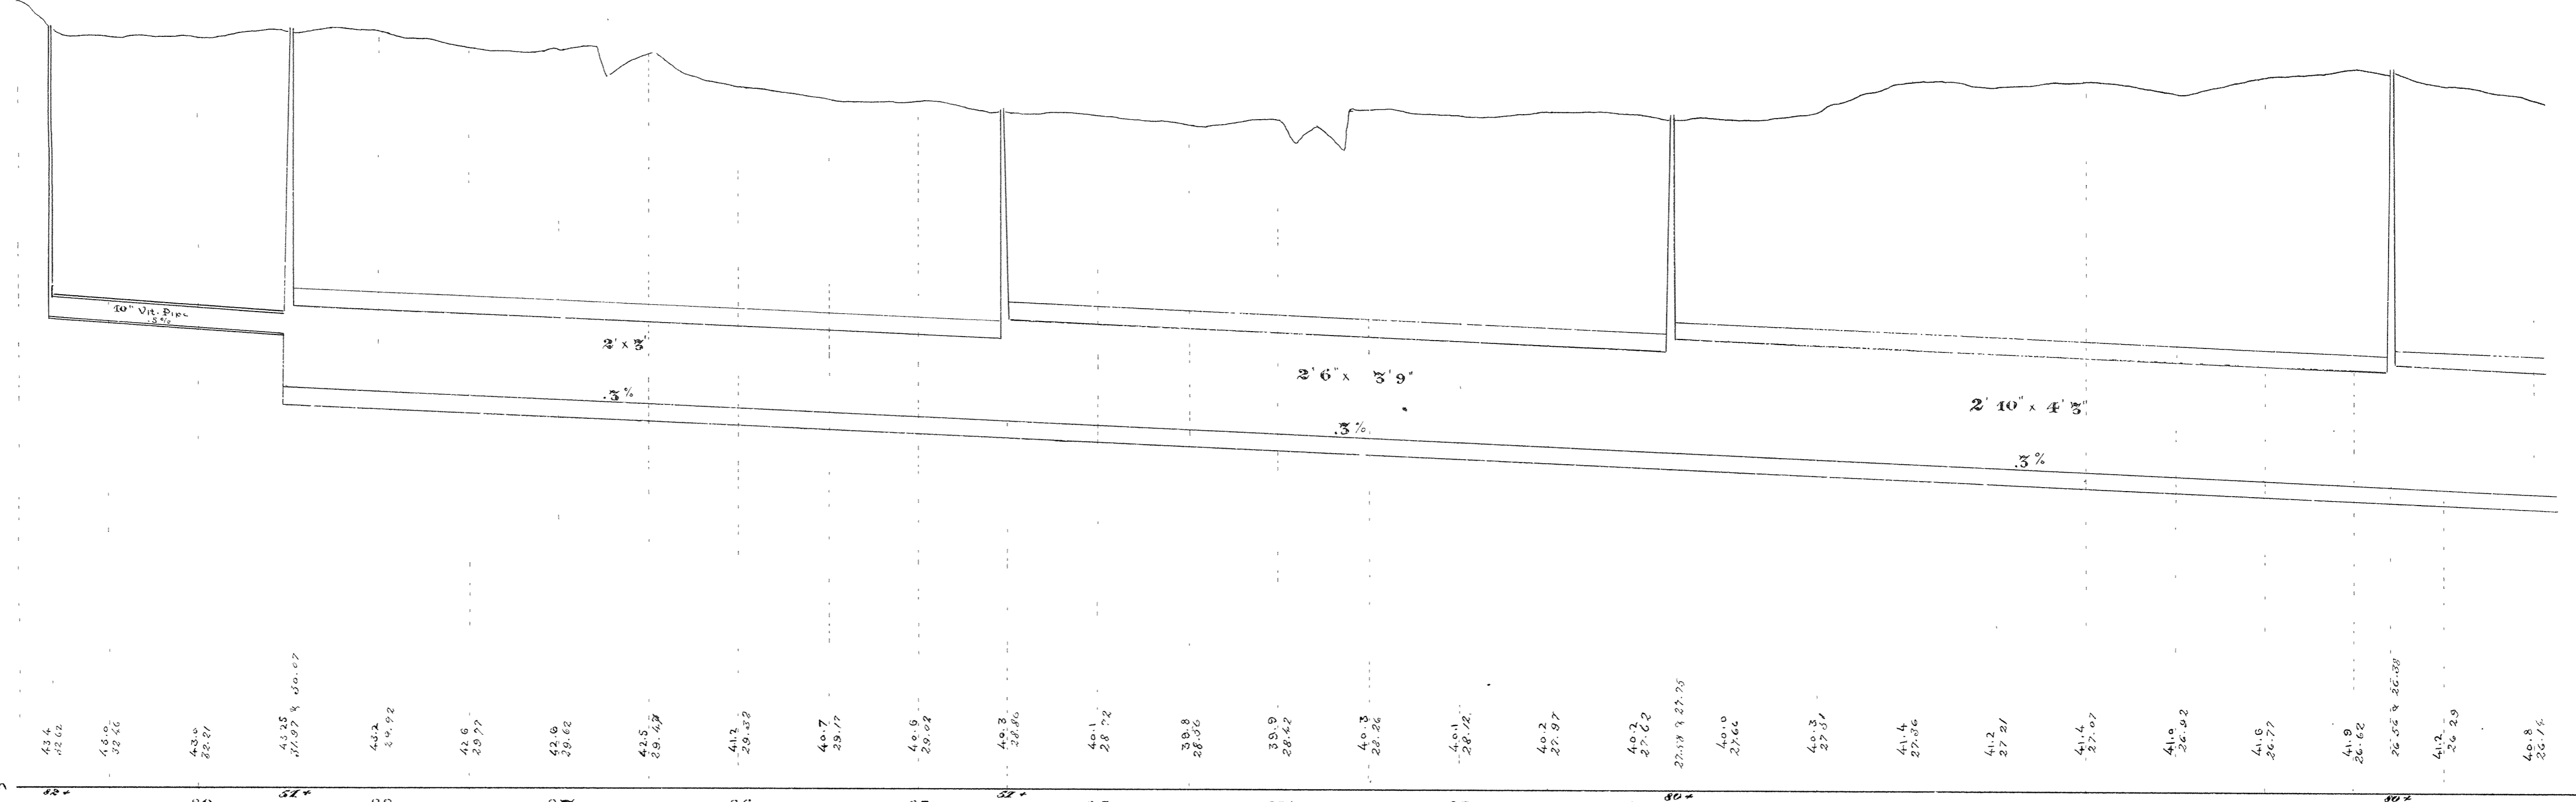

Base line 15' above Datum

43.4	44.2	45.2	46.2	47.2	48.2	49.2	50.2	51.2	52.2	53.2	54.2	55.2	56.2	57.2	58.2	59.2	60.2	61.2	62.2	63.2	64.2	65.2	66.2	67.2	68.2	69.2	70.2	71.2	72.2	73.2	74.2	75.2	76.2
------	------	
Plan & Profile of Sewer in Alley South of Belknap St. from Ogden Ave. to Ry.

2A-14