



**CITY OF SUPERIOR**

**SEWER PLAN**

Contract let April 3, 1894  
 completed Aug. 20, 1891  
 Joseph Wolf, Contractor  
 P. J. McHugh & M. W. Moore, Inspectors  
 E. B. Banks, City Engineer.

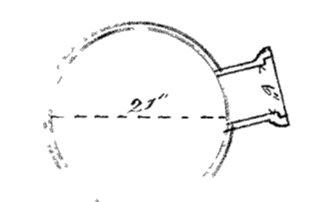


Section of 21 inch Pipe

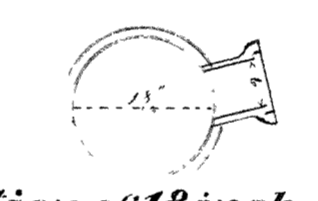

Section of 18 inch Pipe

Scale { Horizontal 1 inch = 60 ft.  
 Vertical 1 inch = 4 "  
 Section 1 inch = 2 "

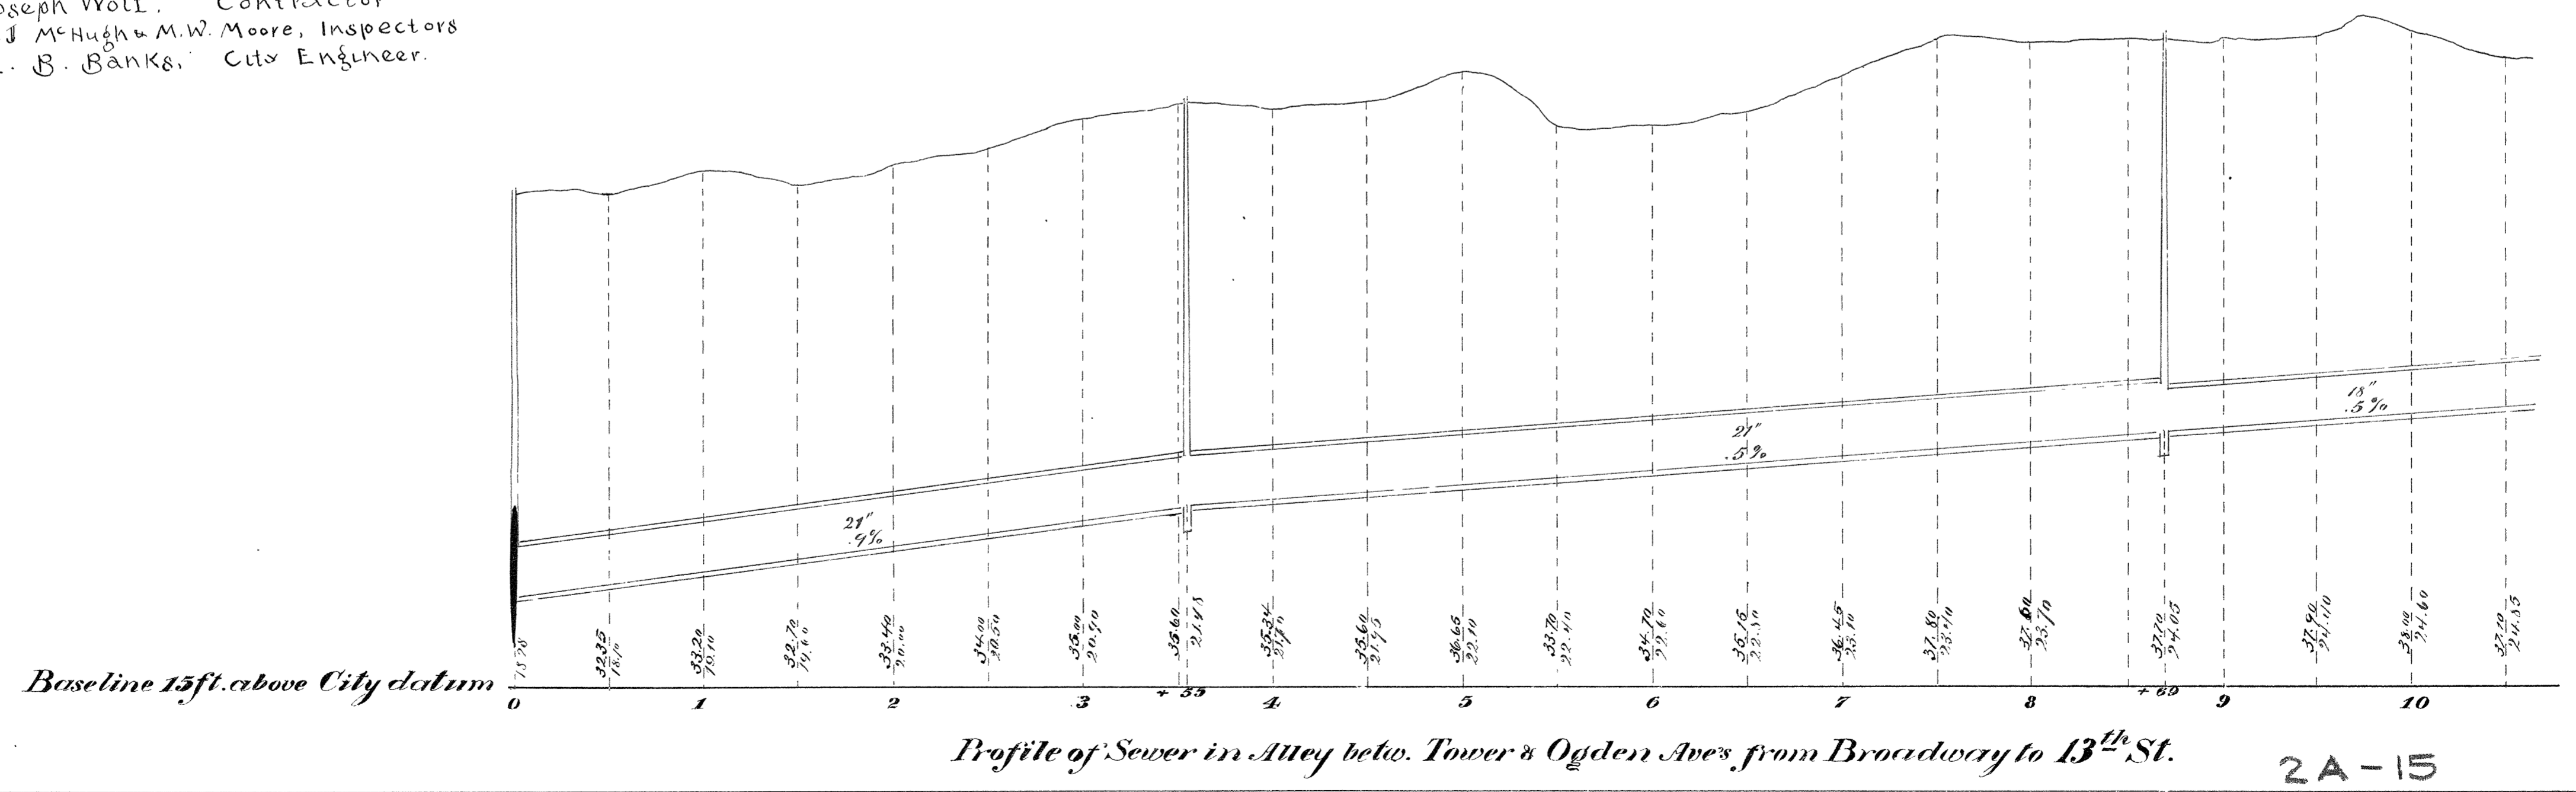

Baseline 15ft. above City datum

Profile of Sewer in Alley betw. Tower & Ogden Aves from Broadway to 13<sup>th</sup> St.

2A-15