



**CITY OF SUPERIOR
SEWER PLAN**


Contract let June 13, 1890
 completed Aug. 11, 1891
 D. C. Sullivan, Contractor
 John Dailey, F. A. Grace, I. C. Grant, Inspectors
 E. B. Banks City Engineer

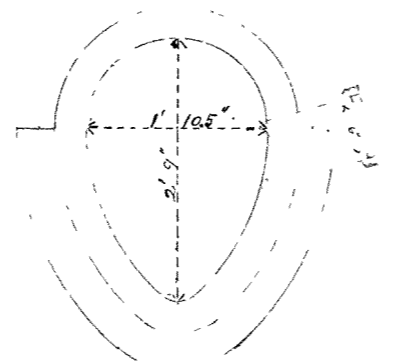

Section of 105' x 2' 9" Sewer

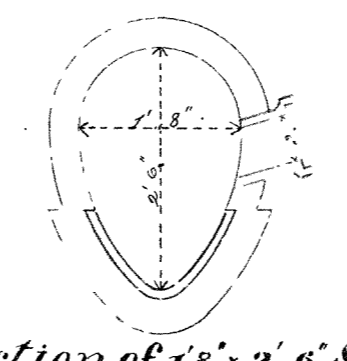

Section of 18' x 2' 6" Sewer

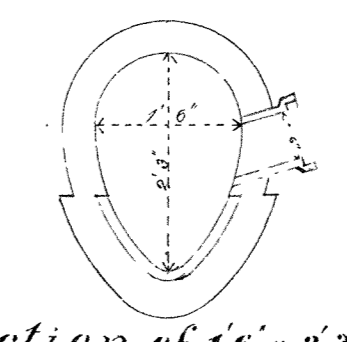

Section of 16' x 2' 3" Sewer

Scale { Horizontal 1/4" = 1' - 1/2"
 Vertical 1/4" = 1' - 1/2"
 Sectional 2" = 1' - 1/2"

