
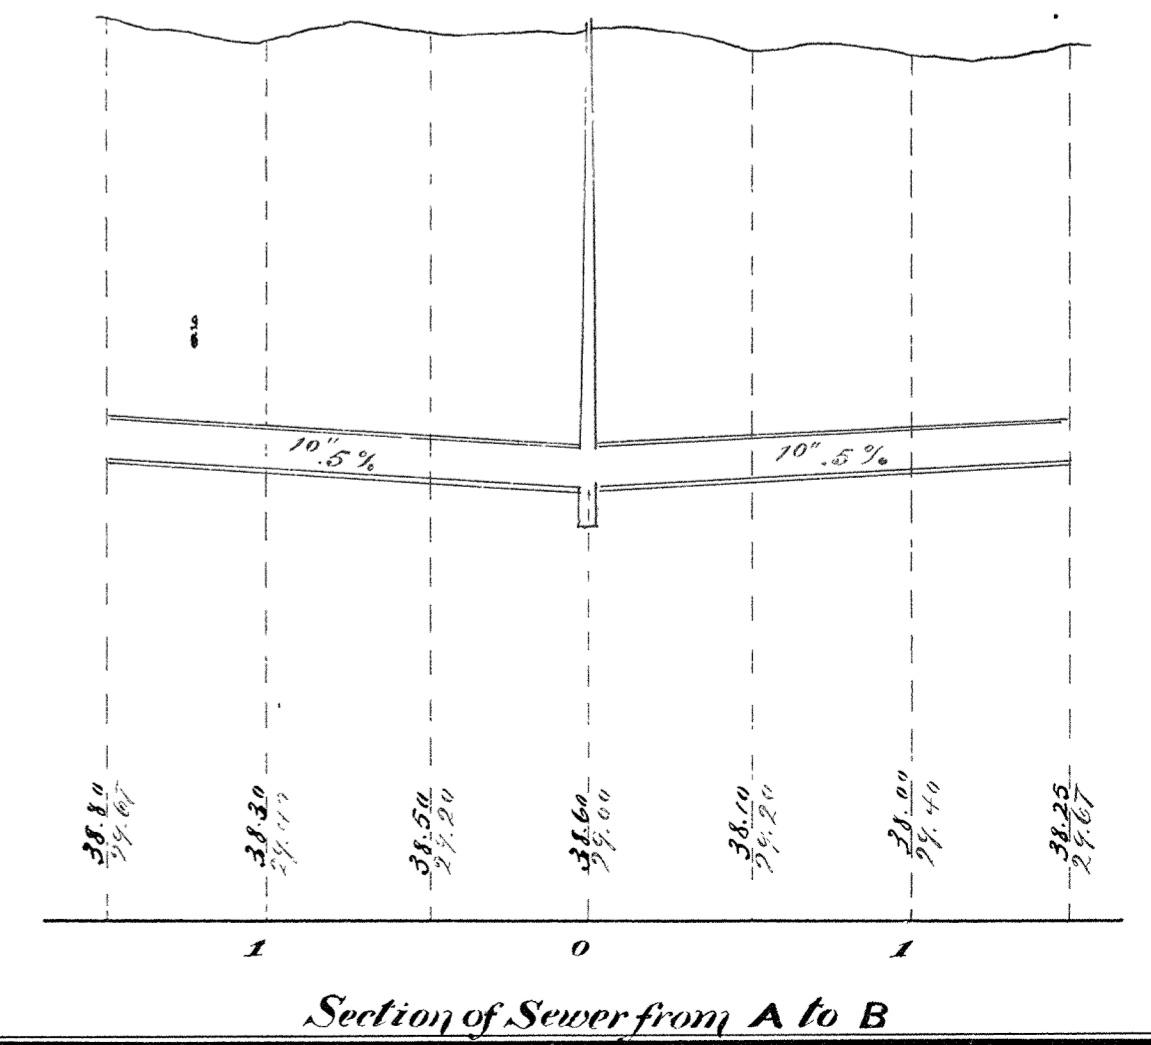
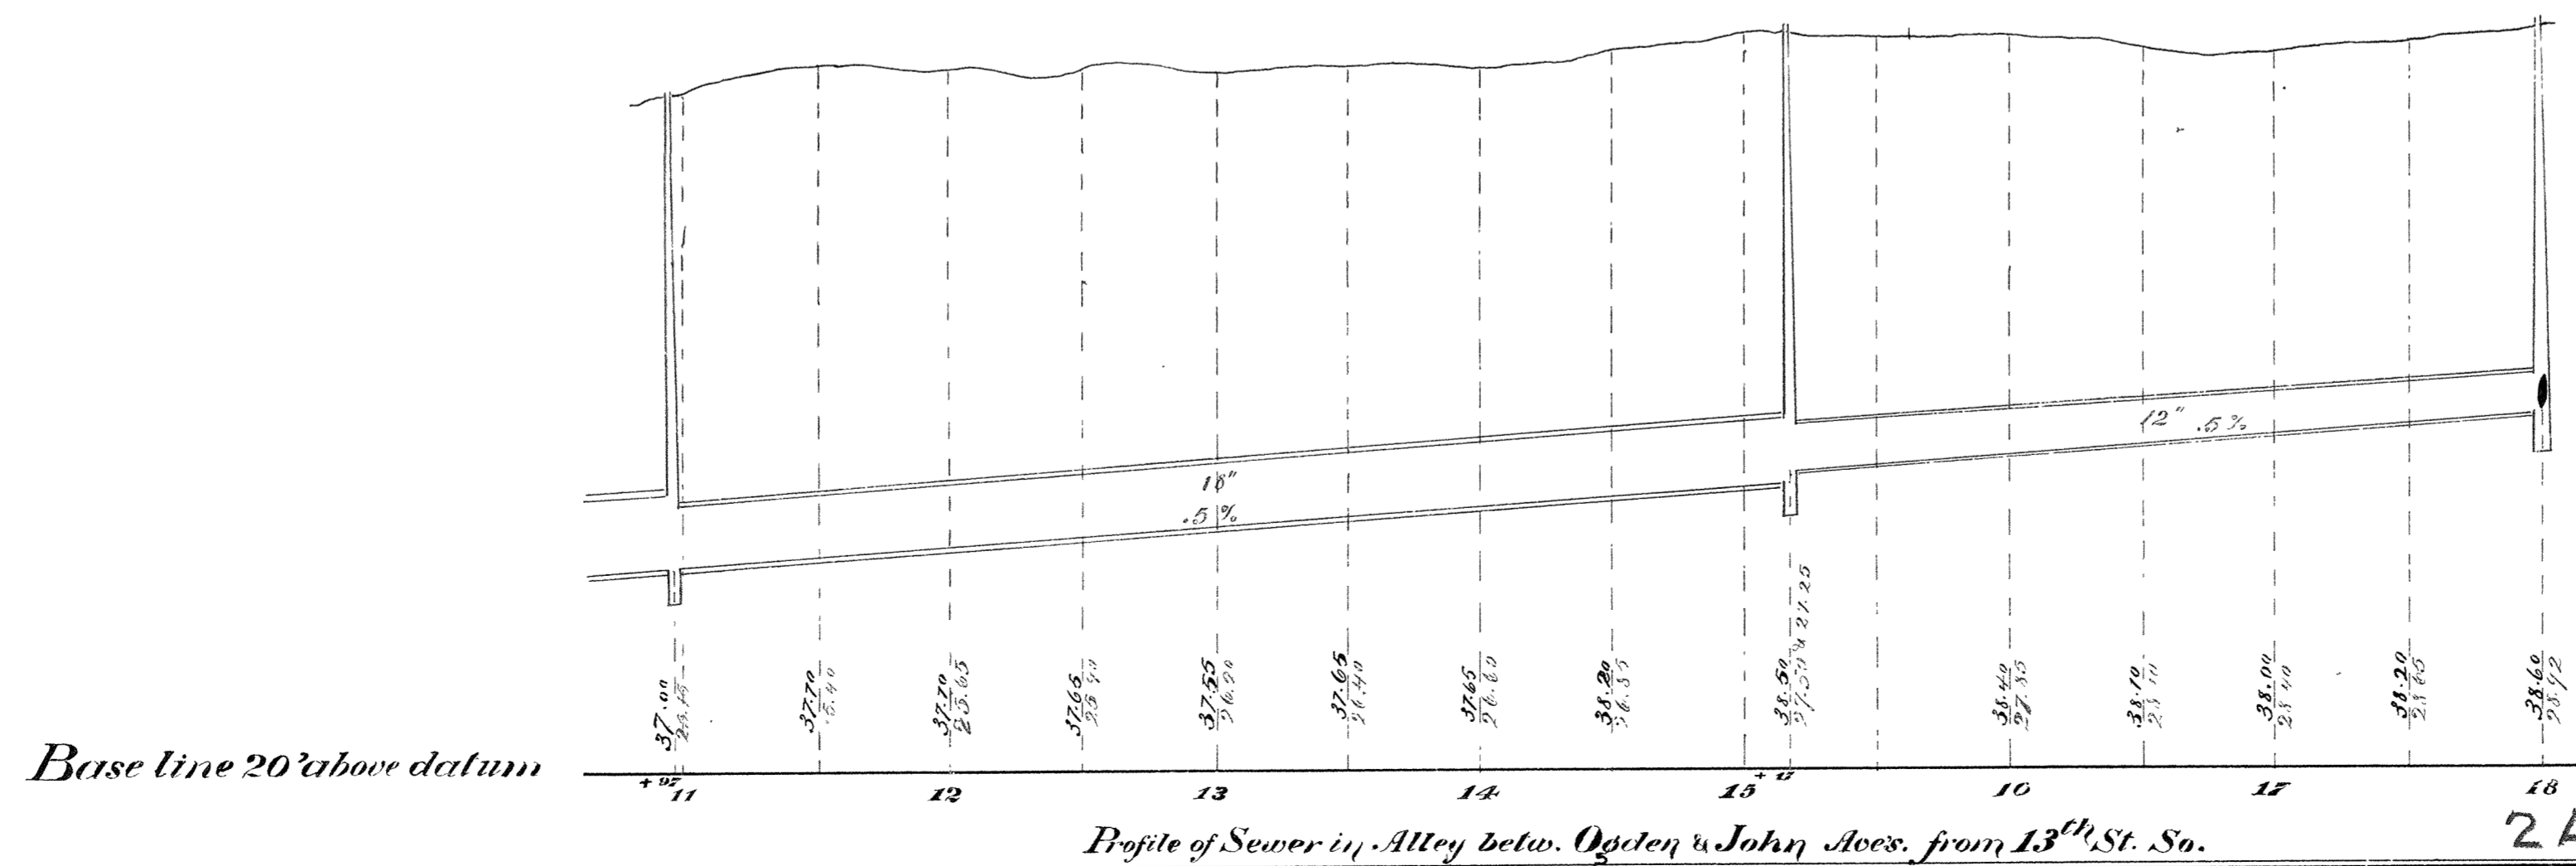
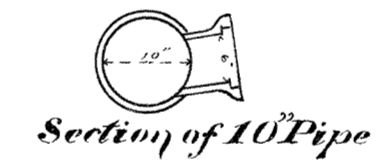
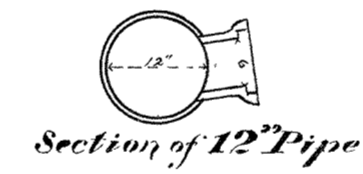


CITY OF SUPERIOR

SEWER PLAN

Contract let April 3, 1891
 completed Aug. 20, 1891
 Joseph Wolf, Contractor
 I. J. Cummins, Finlay McKenzie, Inspectors
 E. B. Banks City Engineer

Scale { Horizontal 1 inch = 60 ft.
 Vertical 1 " = 4 "
 Section 1 " = 2 "

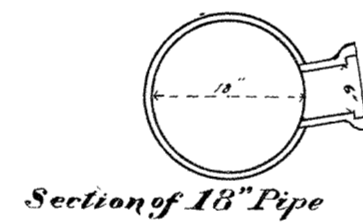

2A-21