



**CITY OF SUPERIOR  
SEWER PLAN**

Contract Let April 3, 1891  
completed Sept. 14, 1891  
Joseph Wolf, Contractor  
J. H. Cummins, Inspector  
E. B. Banks, City Engineer

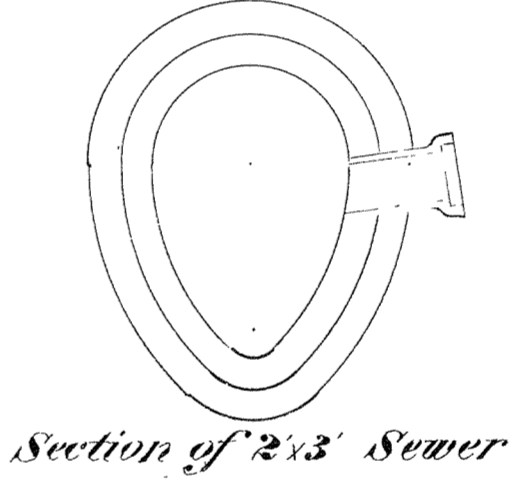

Scale: { Horizontal 60' = 1"  
Vertical 4' = 1"  
Section 2" = 1"

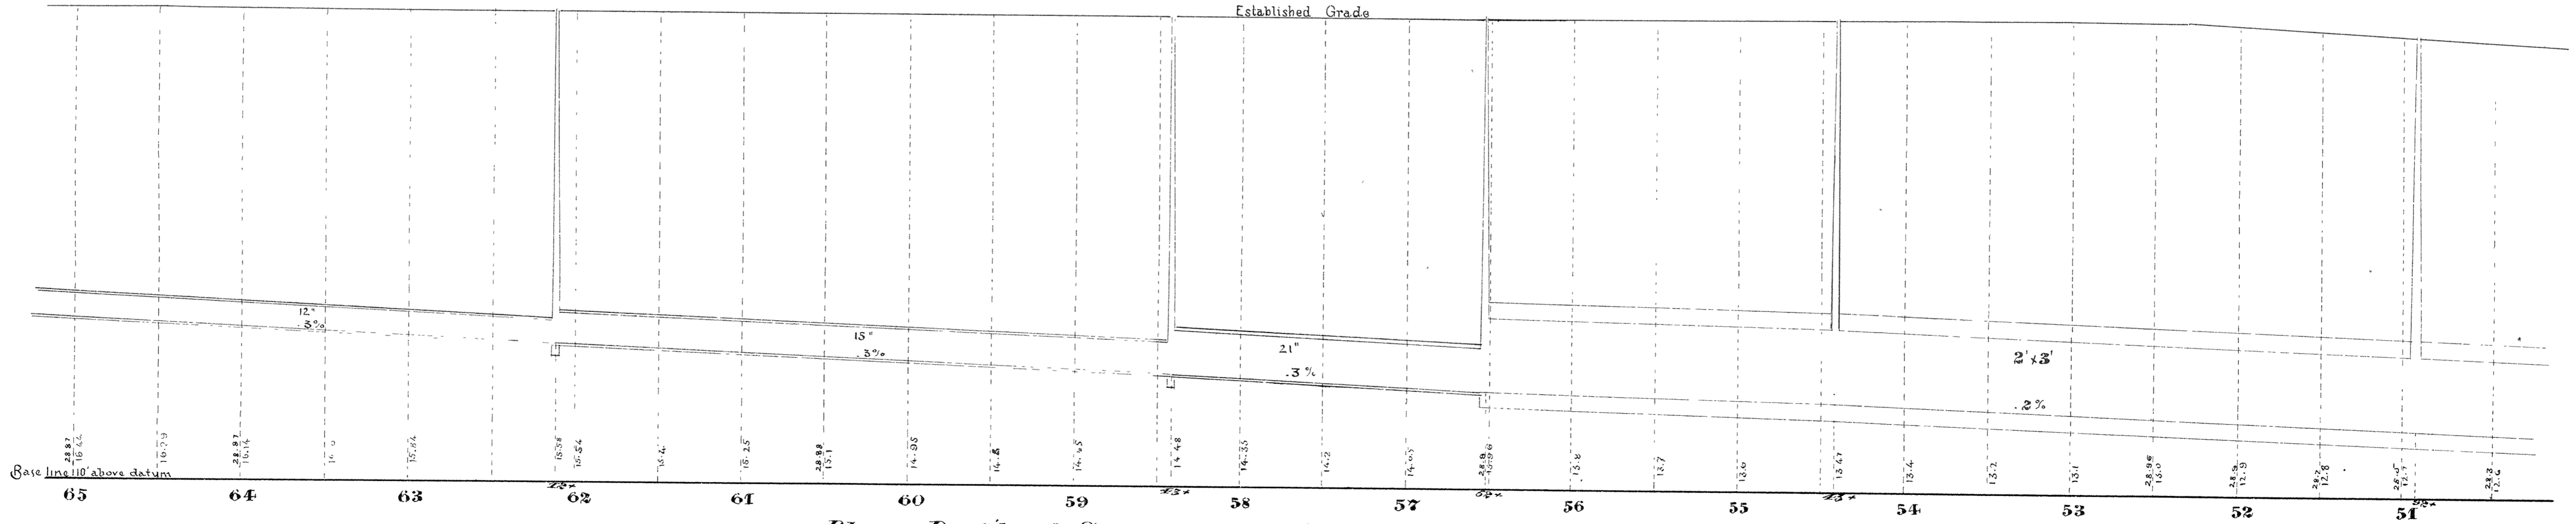

Plan & Profile of Sewer in Winter St. from Baxter to John Ave.