


**CITY OF SUPERIOR
SEWER PLAN**


Contract let April 3, 1891
completed Aug 20, 1891
Joseph Wolf, Contractor
A. Carlson, Inspector
E. B. Banks, City Engineer

Scale: { Horizontal 1 inch = 60 ft.
Vertical 1 inch = 4 ft.
Section 1 inch = 2 ft.

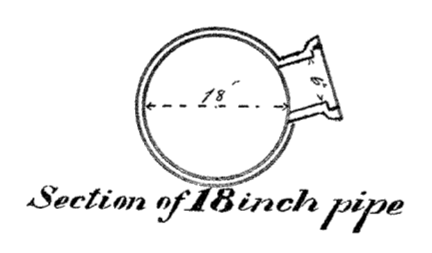

JOB COMPLETED JULY 1970
ASSOCIATED BUILDERS - CONTRACTOR
R.H. DANN CITY ENGINEER
GEODETIC DATUM

NOTE: THIS PORTION OF SEWER HAS BEEN REMOVED. SEE NEW PLAN AND PROFILE THIS SHEET FOR NEW SEWER

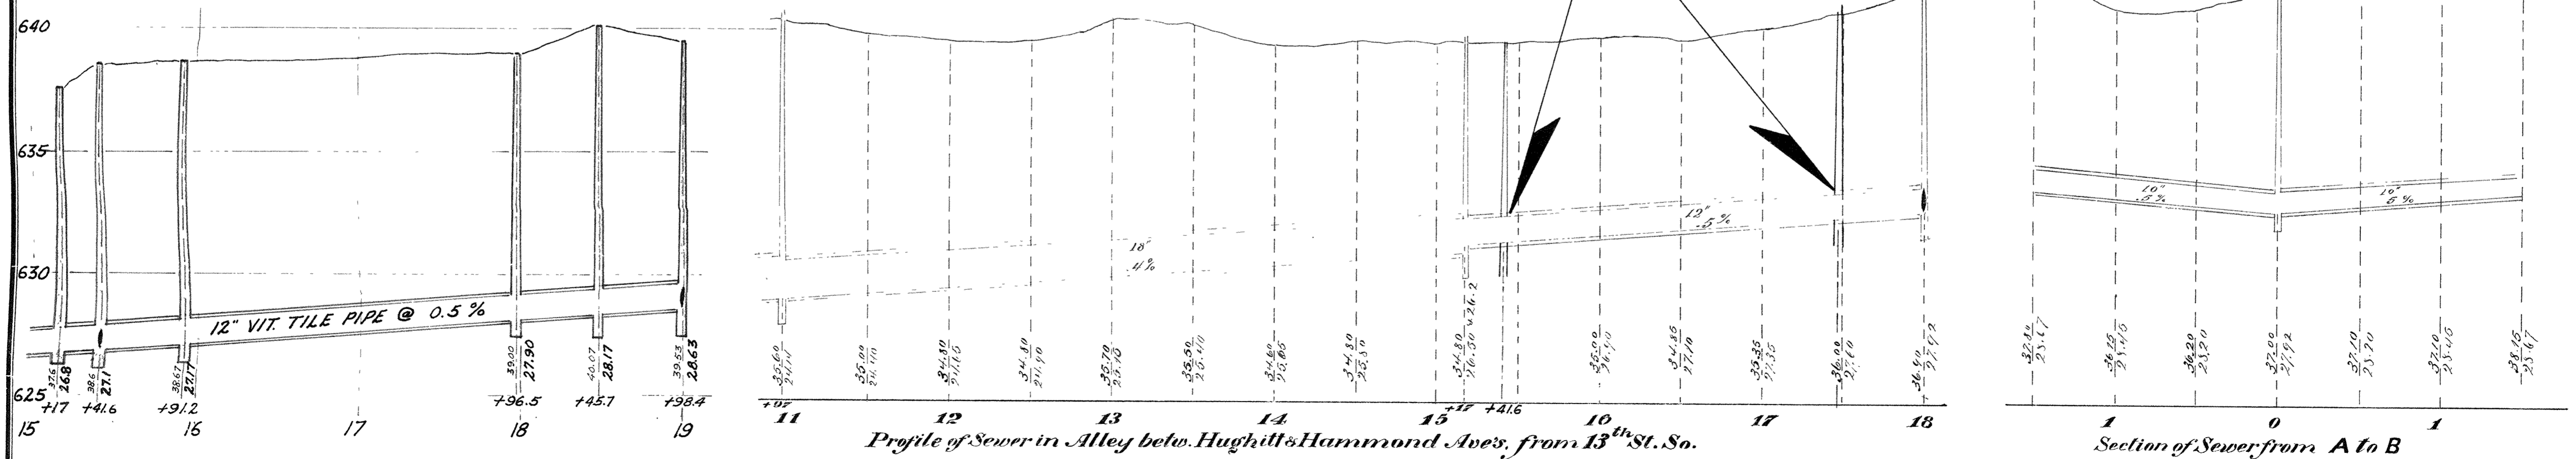

Profile of Sewer in Alley below Hughitt's Hammond Ave's, from 13th St. So. BASE LINE - 20 FT. ABOVE CITY DATUM

Section of Sewer from A to B

2A-31