
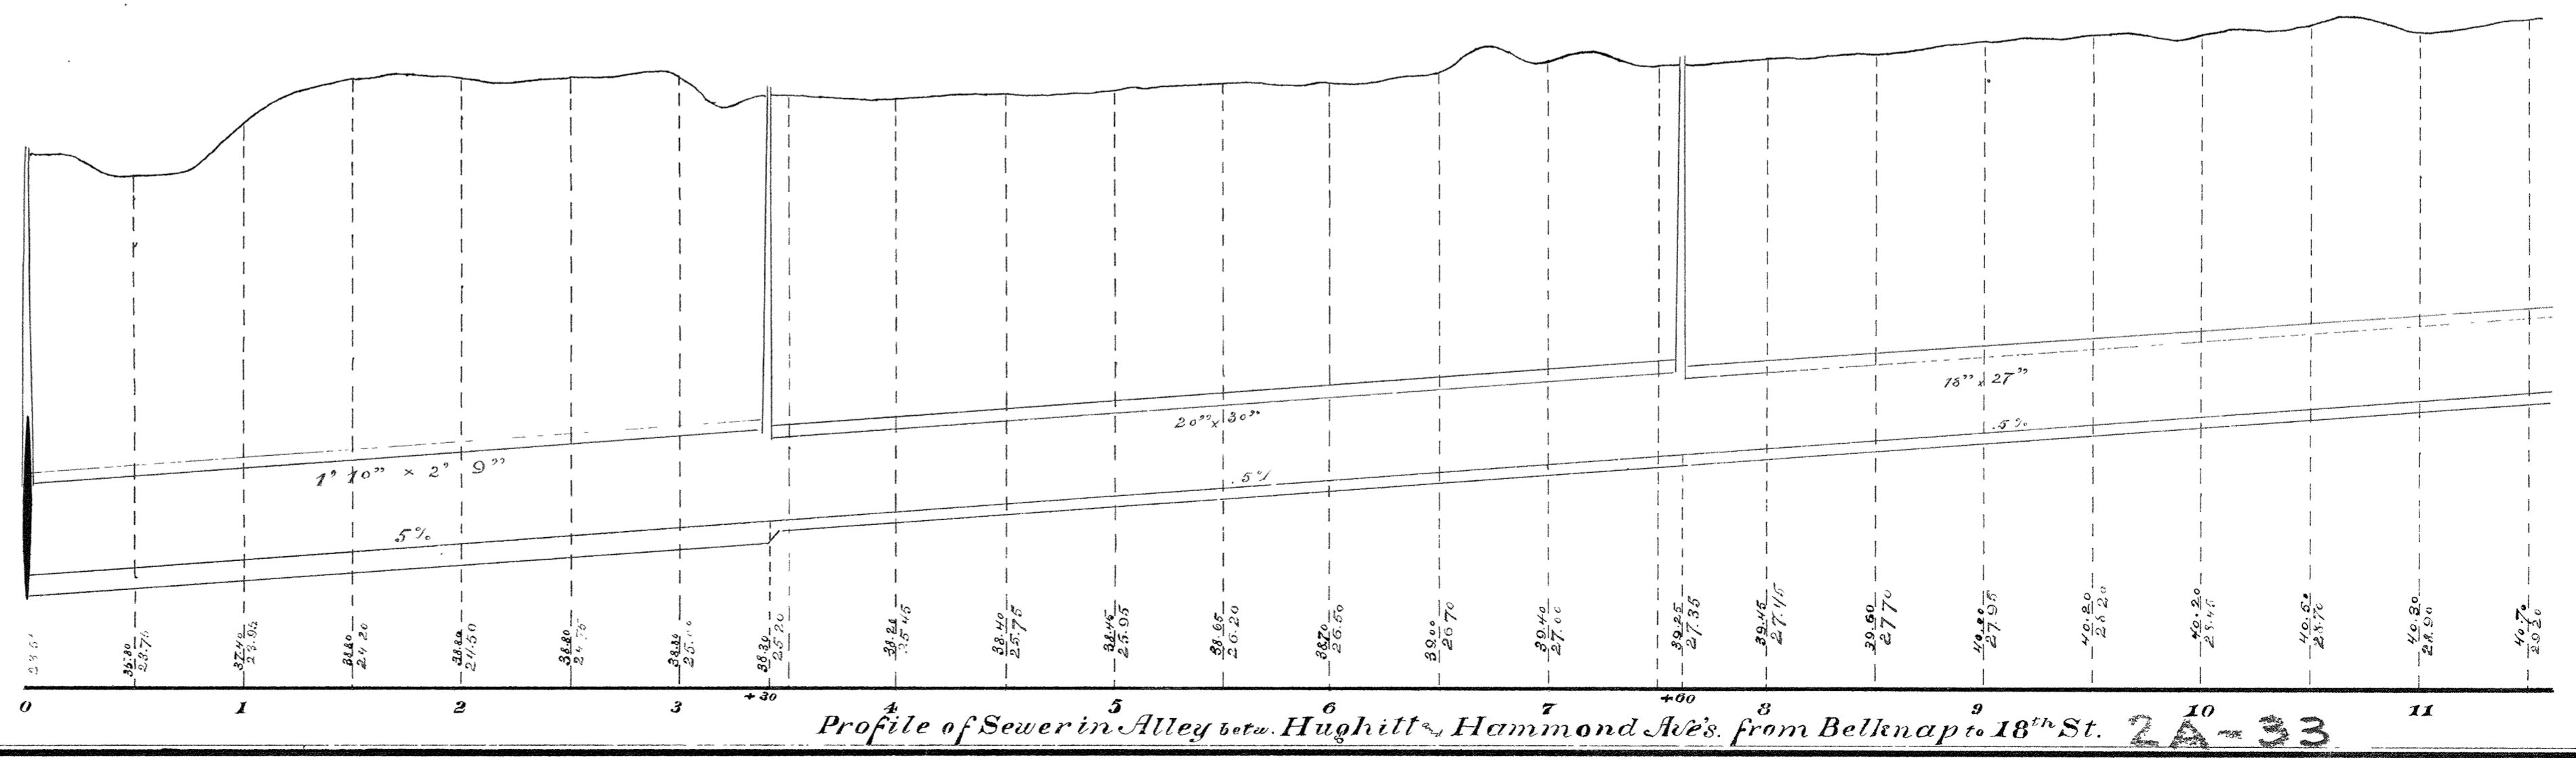
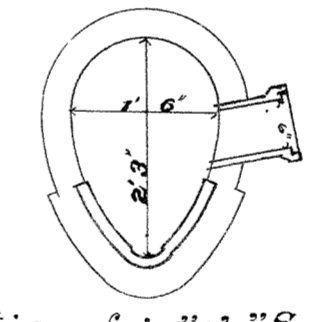
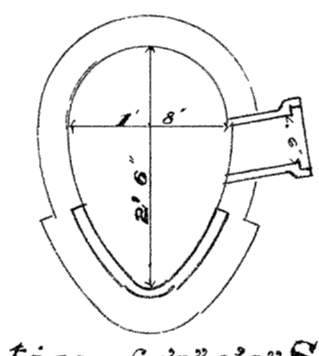


**CITY OF SUPERIOR  
SEWER PLAN**

Contract let June 13, 1890  
 " completed Aug. 11, 1891  
 D. C. Sullivan, Contractor  
 John Bailey & E. A. Henderson, Inspls.  
 E. B. Banks, City Engineer

Scale { Horizontal 1 inch = 60 Ft.  
 Vertical 1 " = 4 "  
 Sectional 1 " = 2 "

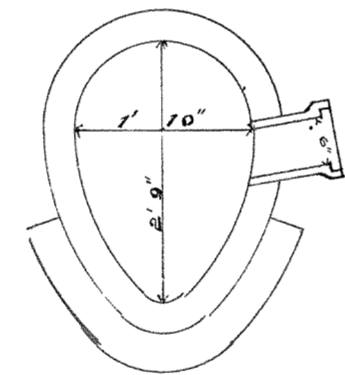

Baseline 20ft. above datum