



**CITY OF SUPERIOR  
SEWER PLAN**

Contract let April 3, 1891  
completed Aug 20, 1891  
Joseph Wolf, Contractor  
R. J. McHugh & Finlay McKinzie, Jr. spt.  
E. B. Banks, City Engineer

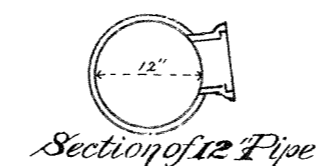

Scale { Horizontal 1" = 60'  
Vertical 1" = 4"  
Section 1" = 2"

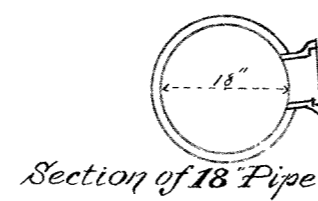