

Note: No connections are reported for lots 1 & 2, Block 288



**CITY OF SUPERIOR**  
**SEWER PLAN**

Contract let June 13, 1890  
" completed Aug. 11, 1891  
R. C. Sullivan Contractor  
E. A. Henderson, Ispl.  
E. B. Banks, City Engr.

*Elevation of Lateral Sewer*

At Main S.W.M.	At Alley Curving
Harrison St.	26.875
Seventeenth St.	26.307
Eighteenth St.	25.856
Nineteenth St.	25.125

Scale { Horizontal 1" = 60'  
Vertical 1" = 4'  
Section 1" = 24"

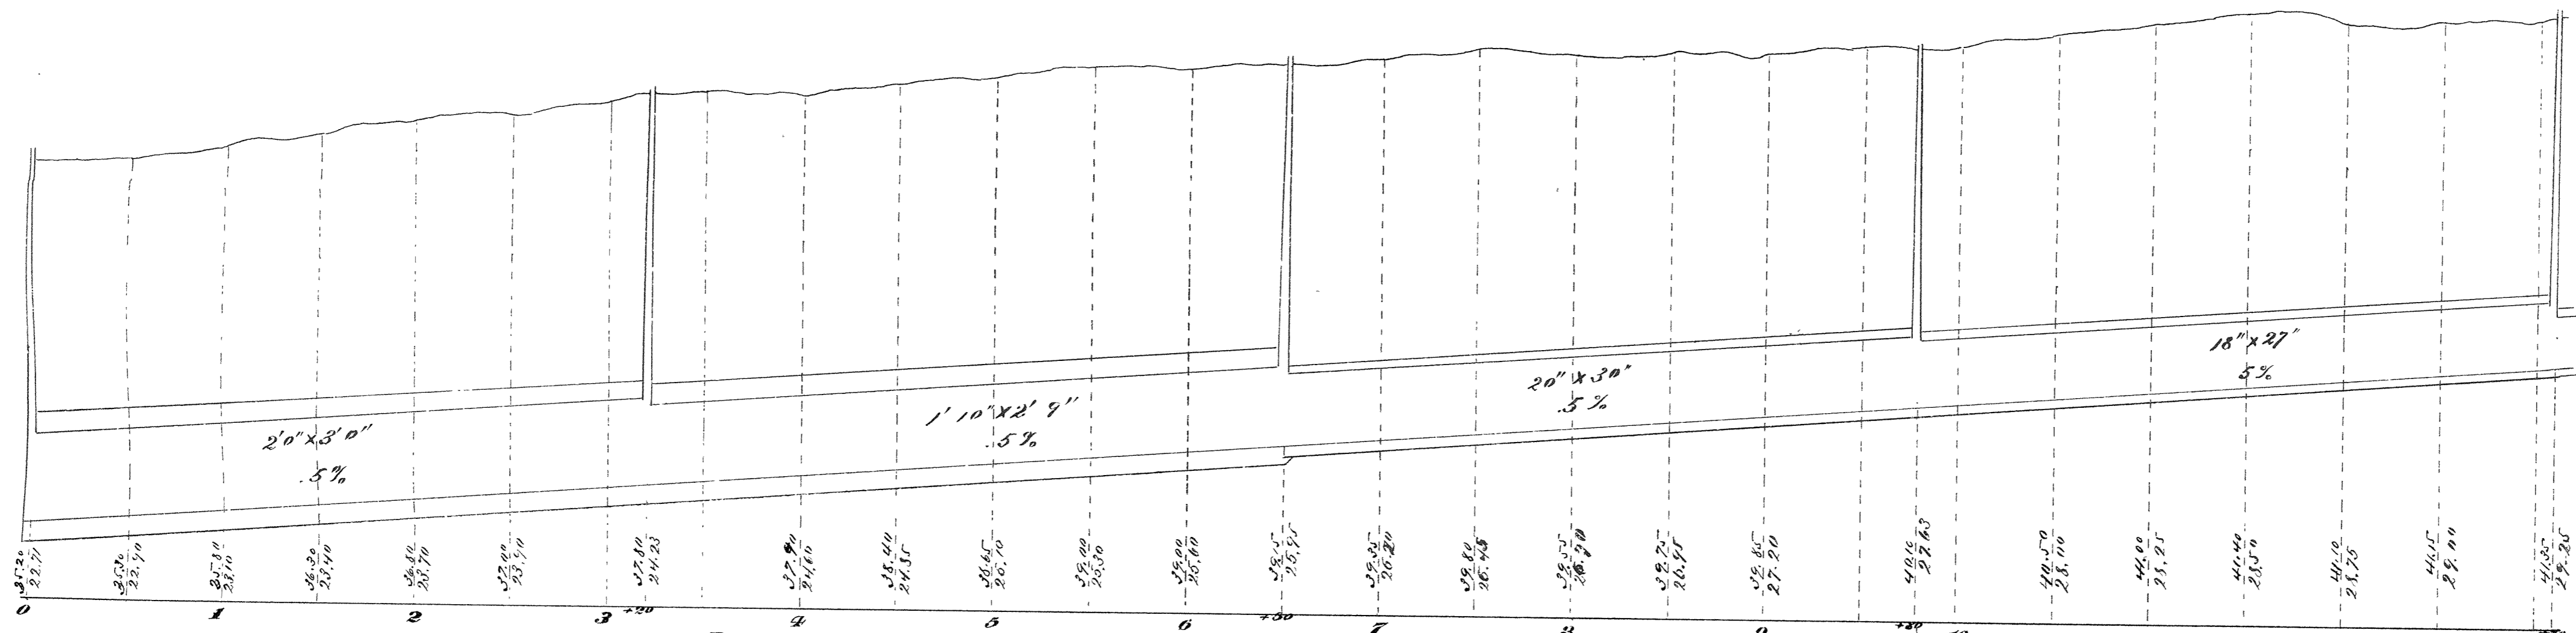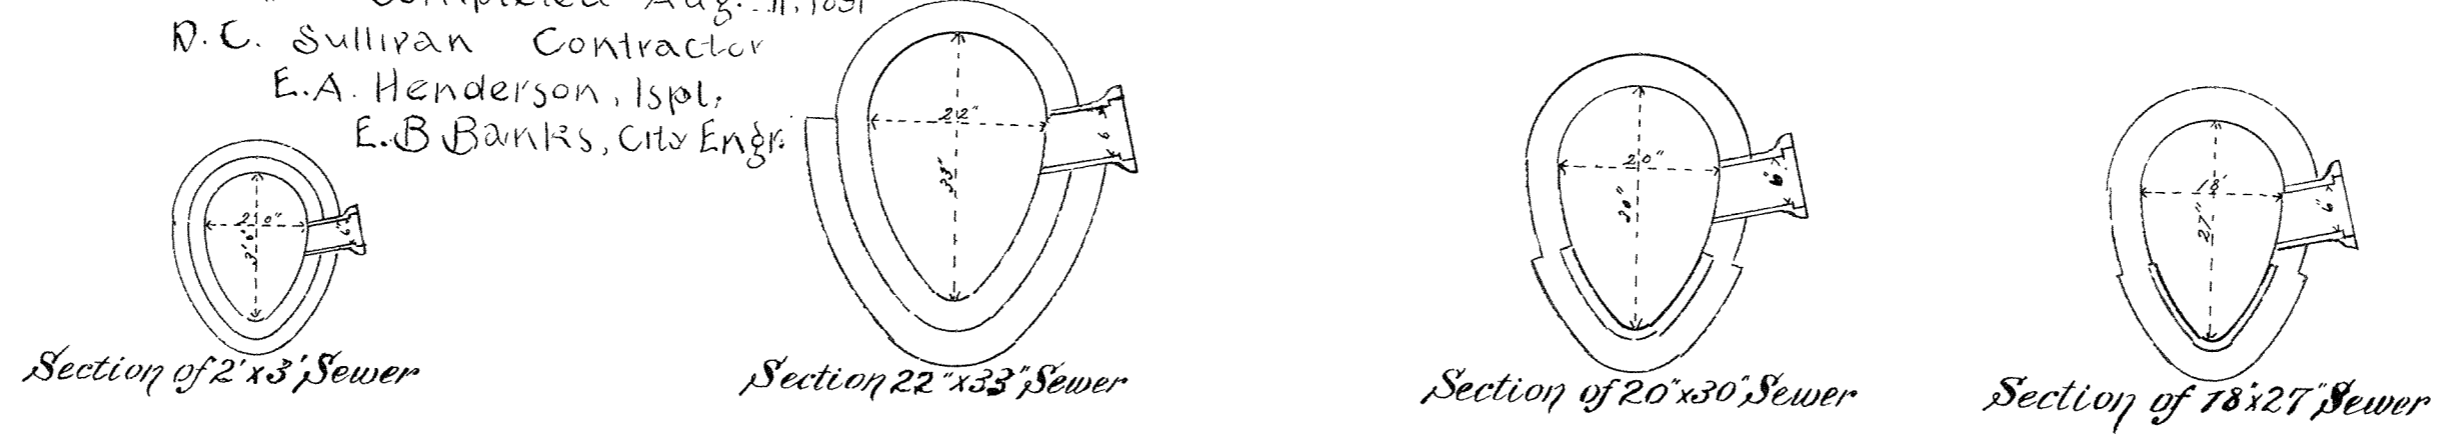

Profile of Sewer up Alley betw. Hammond & Cumming from 16<sup>th</sup> St. to 19<sup>th</sup> St.

Baseline 20' above City datum  
2A-37