
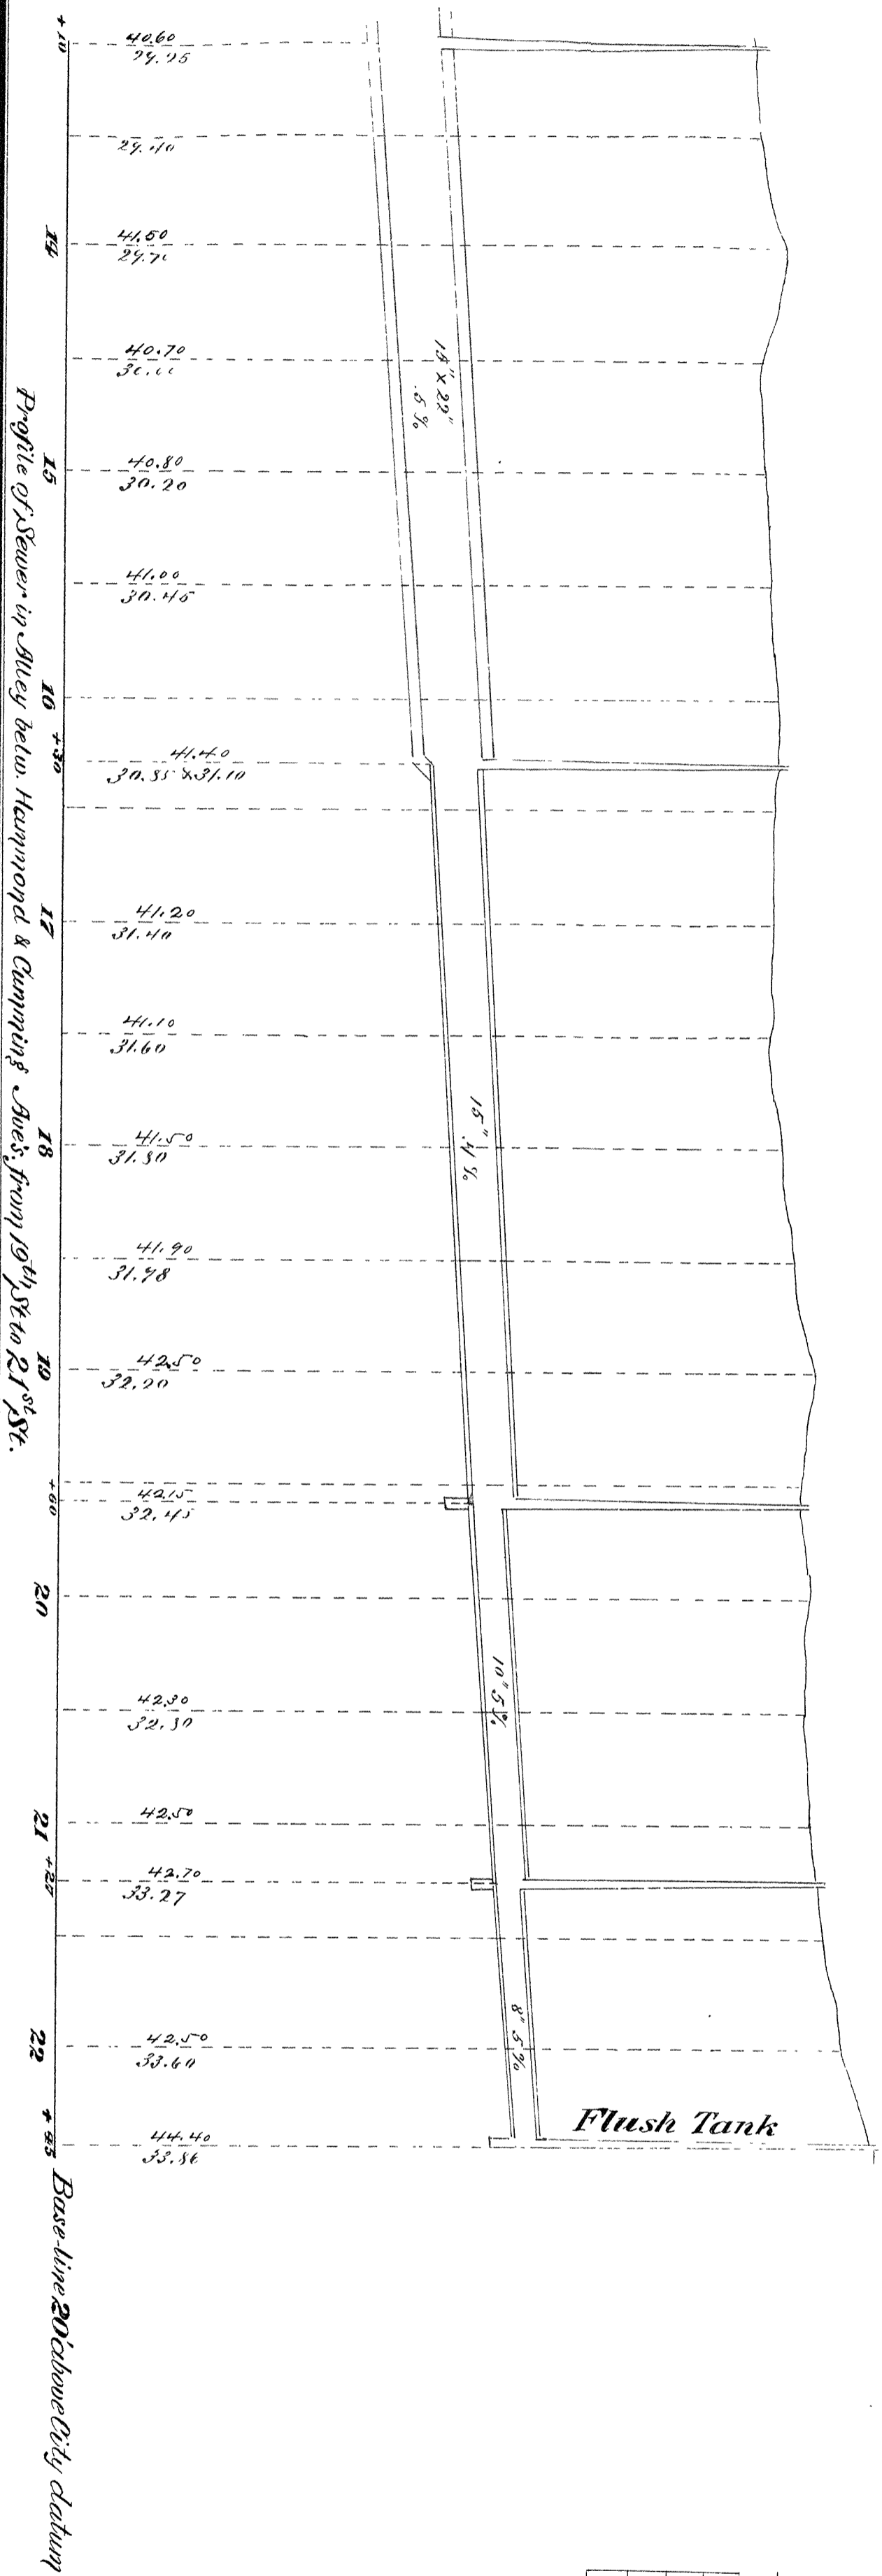
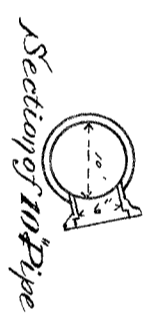
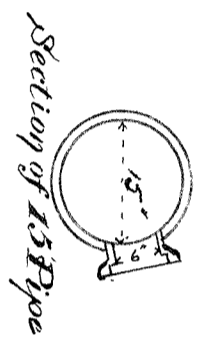


**CITY OF SUPERIOR**

**SEWER PLAN**

Contract let June 13, 1890  
 Completed Aug 11, 1891  
 D. C. Sullivan, Contractor  
 E. A. Henderson, Inspector  
 E. B. Banks, City Engineer

Scale { Horizontal 1" = 60'  
 Vertical 1" = 4'  
 Section 1" = 2"

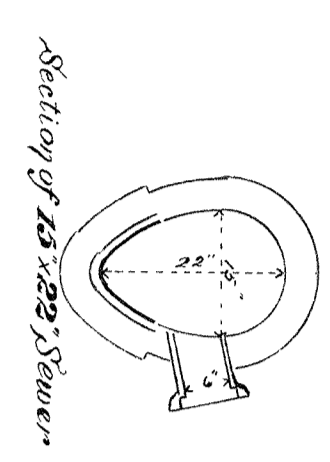

**Elevation of Lateral Sewer**

Manhole No.	Station	Elevation	Notes
1	19+00	40.60	
2	19+25	41.20	
3	19+50	41.80	
4	19+75	42.40	
5	20+00	43.00	
6	20+25	43.60	
7	20+50	44.20	
8	20+75	44.80	
9	21+00	45.40	
10	21+25	46.00	
11	21+50	46.60	
12	21+75	47.20	
13	22+00	47.80	
14	22+25	48.40	
15	22+50	49.00	
16	22+75	49.60	
17	23+00	50.20	
18	23+25	50.80	
19	23+50	51.40	
20	23+75	52.00	
21	24+00	52.60	
22	24+25	53.20	
23	24+50	53.80	
24	24+75	54.40	
25	25+00	55.00	

2A-38